



BANKING DIAGRAM

HORIZONTAL SCALE 1" = 20'-0"
 VERTICAL SCALE 1" = 10'-0"

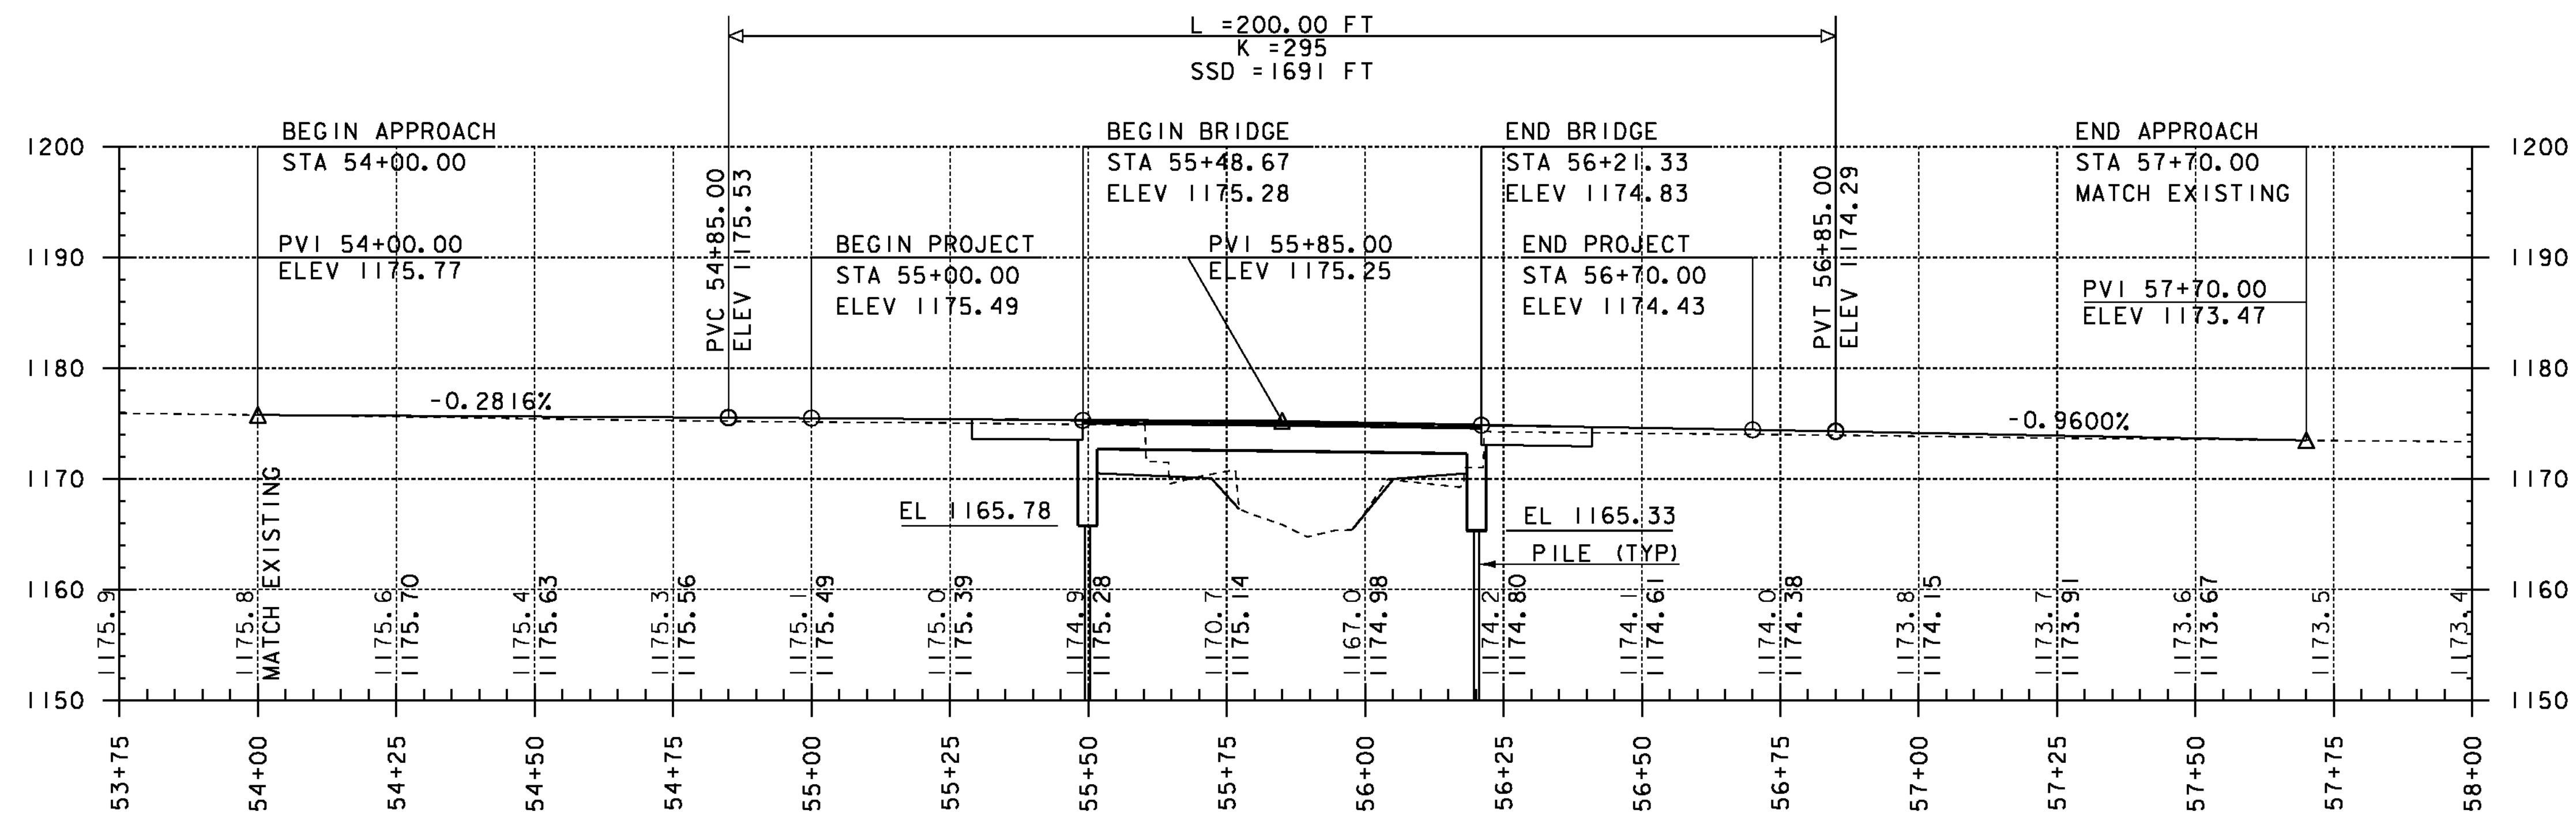

MAINLINE PROFILE

HORIZONTAL SCALE 1" = 20'-0"
 VERTICAL SCALE 1" = 10'-0"

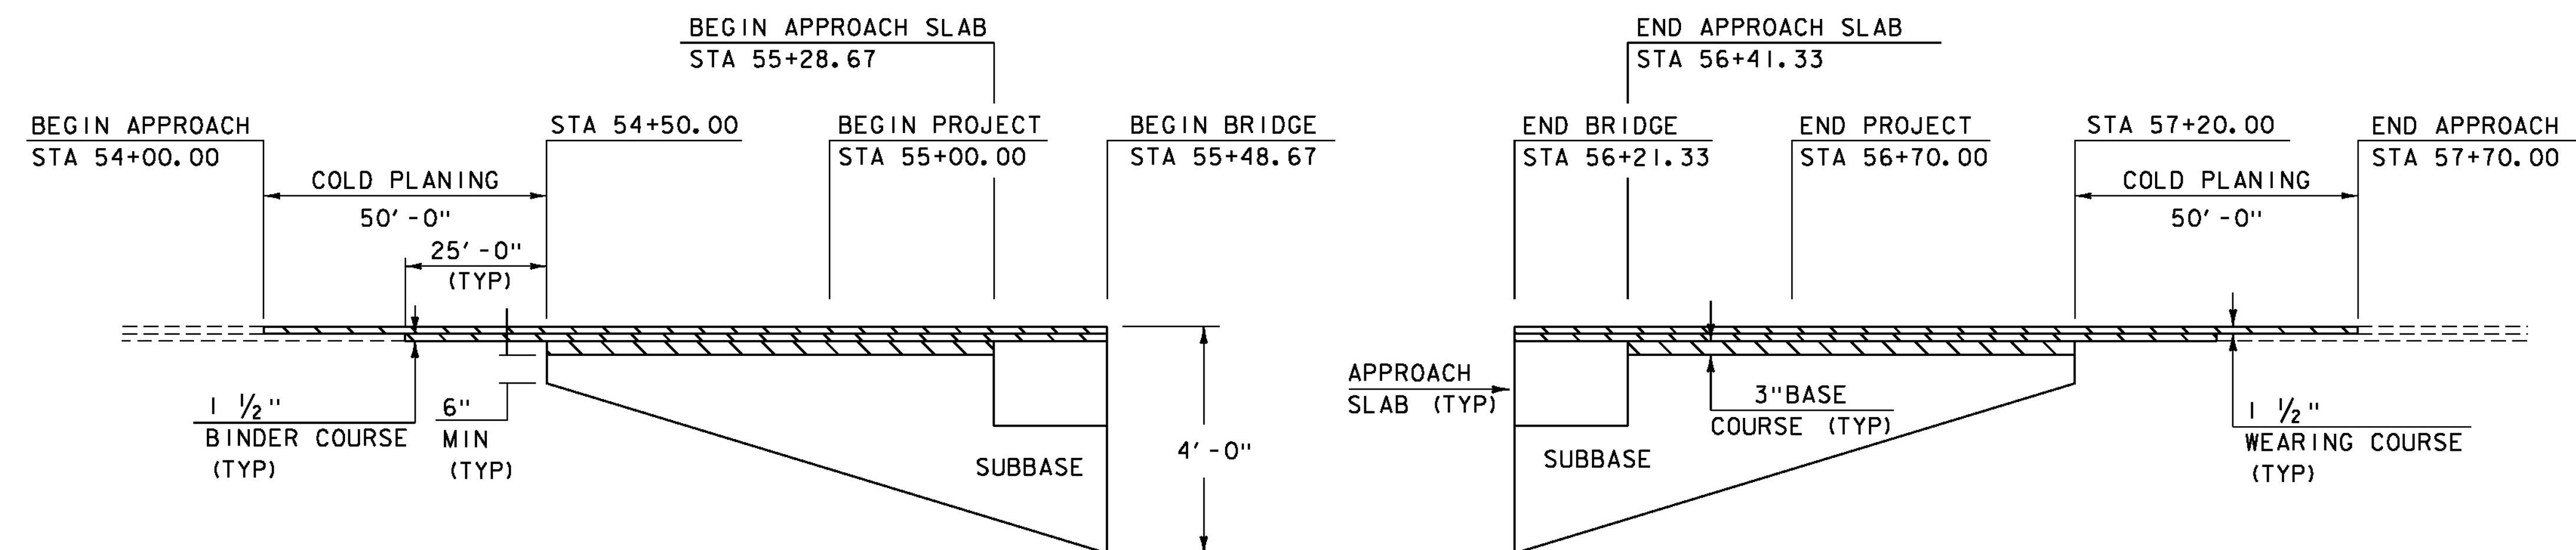

MATERIAL TRANSITION

HORIZONTAL SCALE 1" = 20'-0"
 VERTICAL SCALE 1/2" = 1'-0"

PROJECT NAME: BRIGHTON	PLOT DATE: 12-SEP-2012
PROJECT NUMBER: ER STP 034-3(25)	DRAWN BY: J. SALVATORI
FILE NAME: sllb208pro.dgn	CHECKED BY: W. LAMMER
DESIGNED BY: J. SALVATORI	SHEET 10 OF 36
MAINLINE PROFILE	