




54+00
BEGIN APPROACH

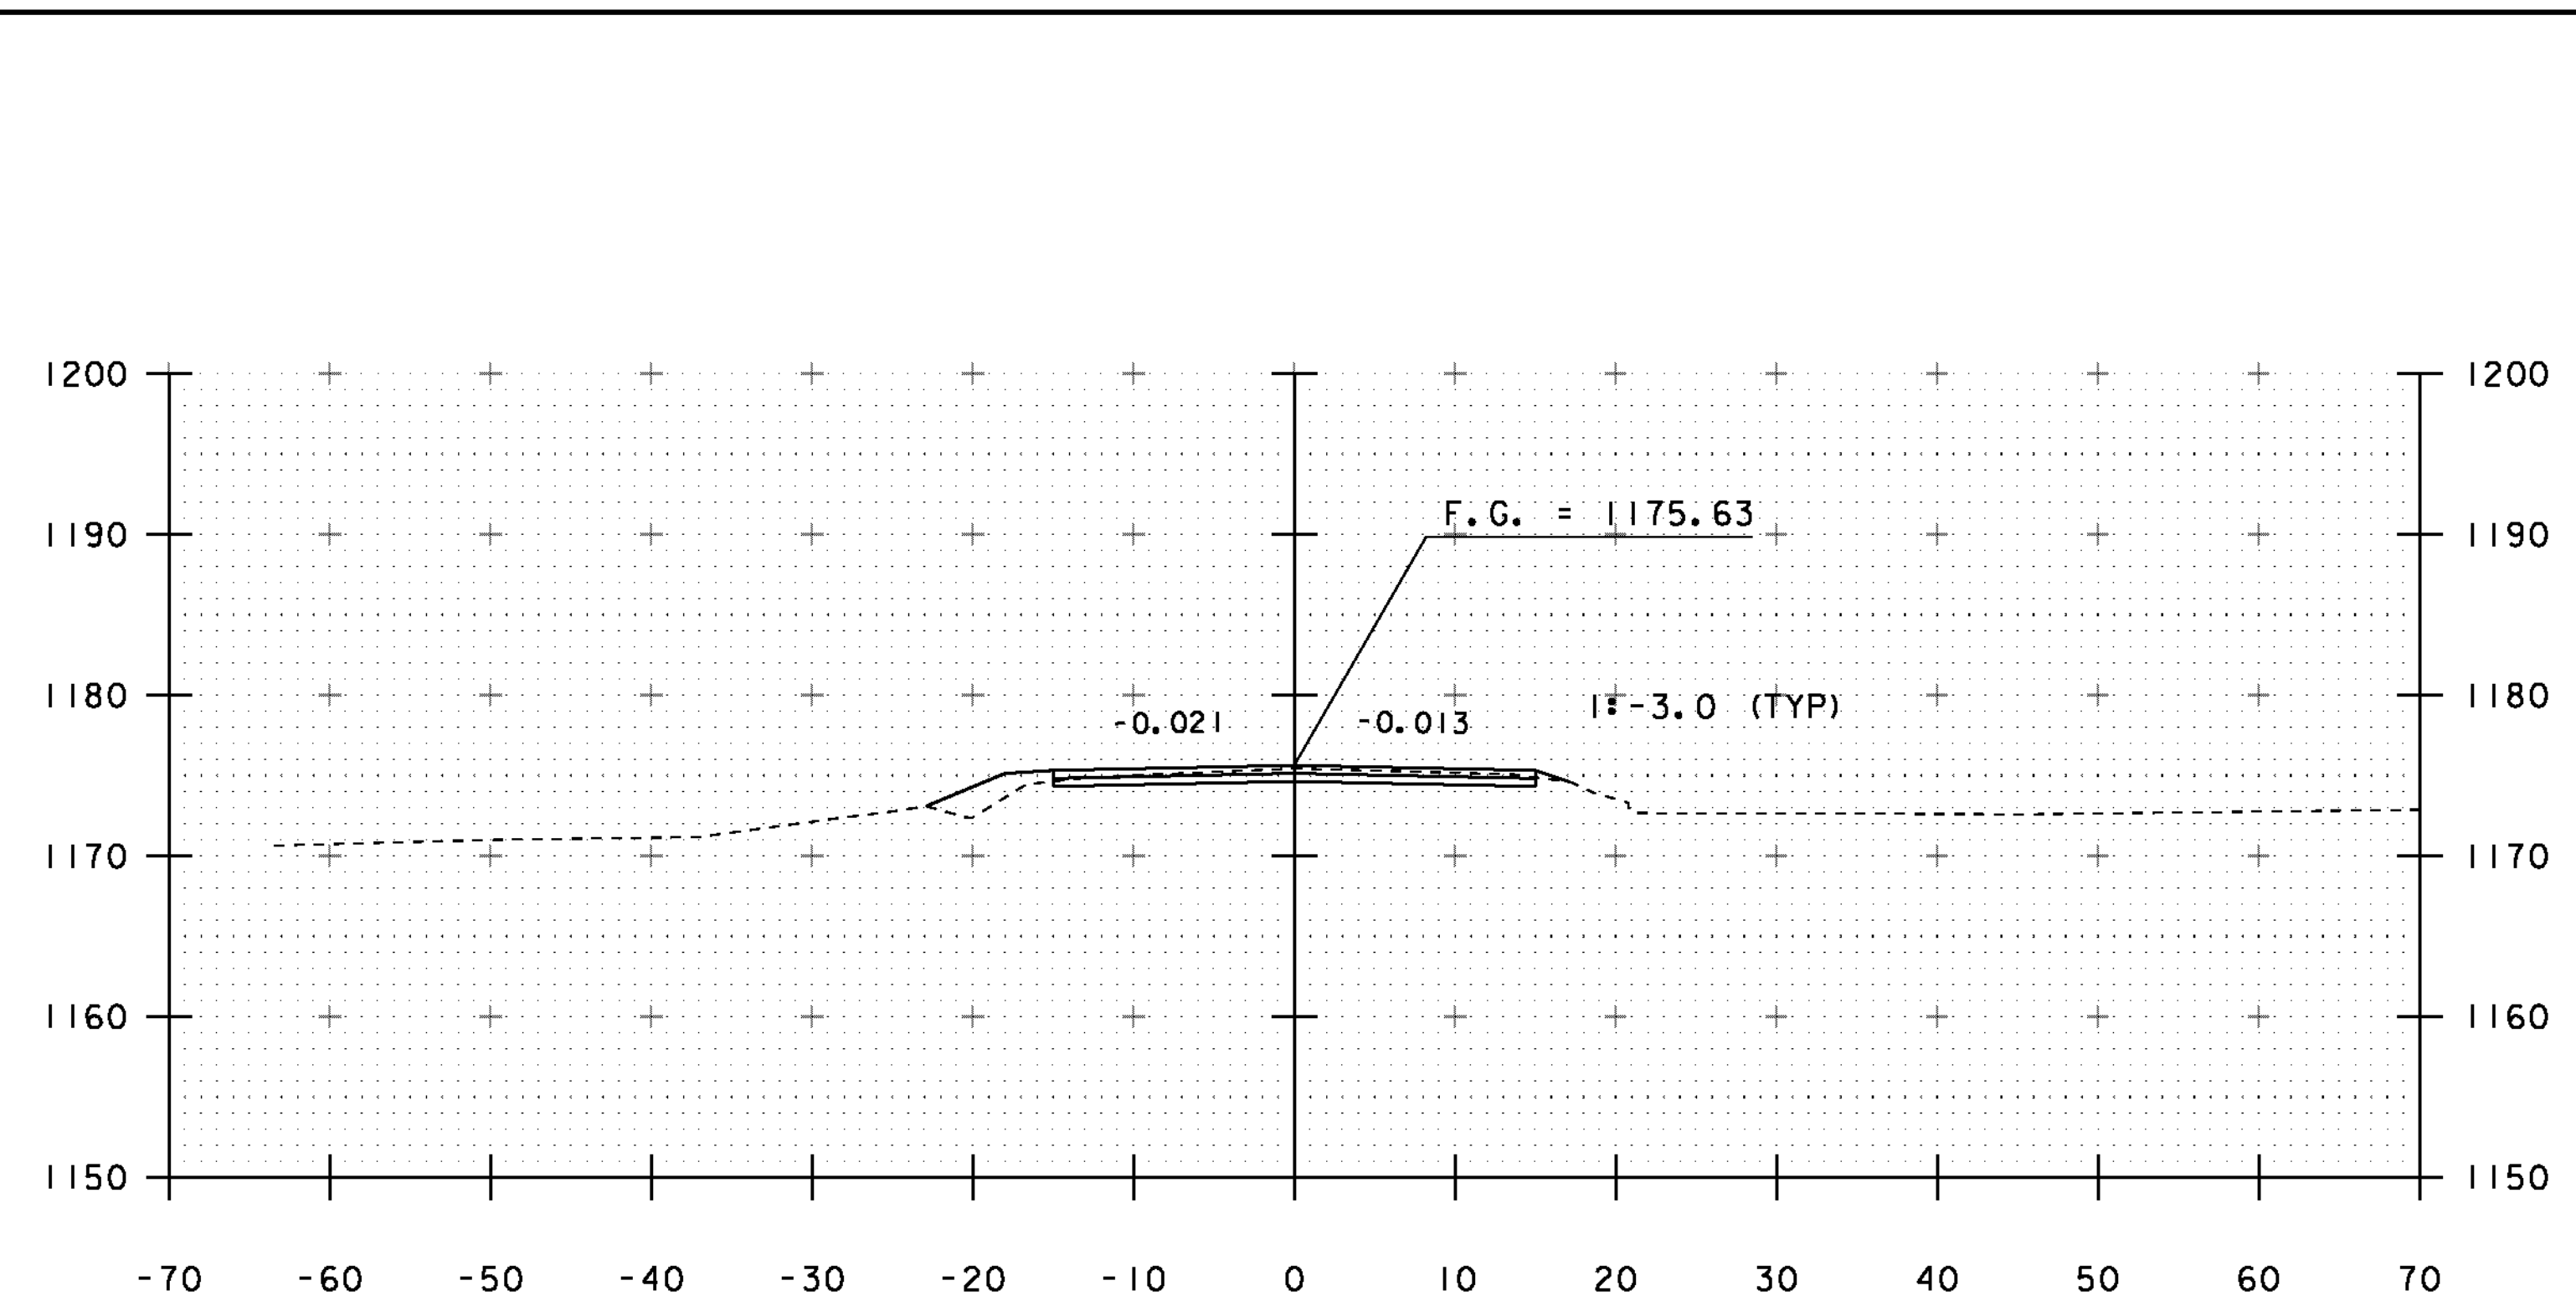

54+50

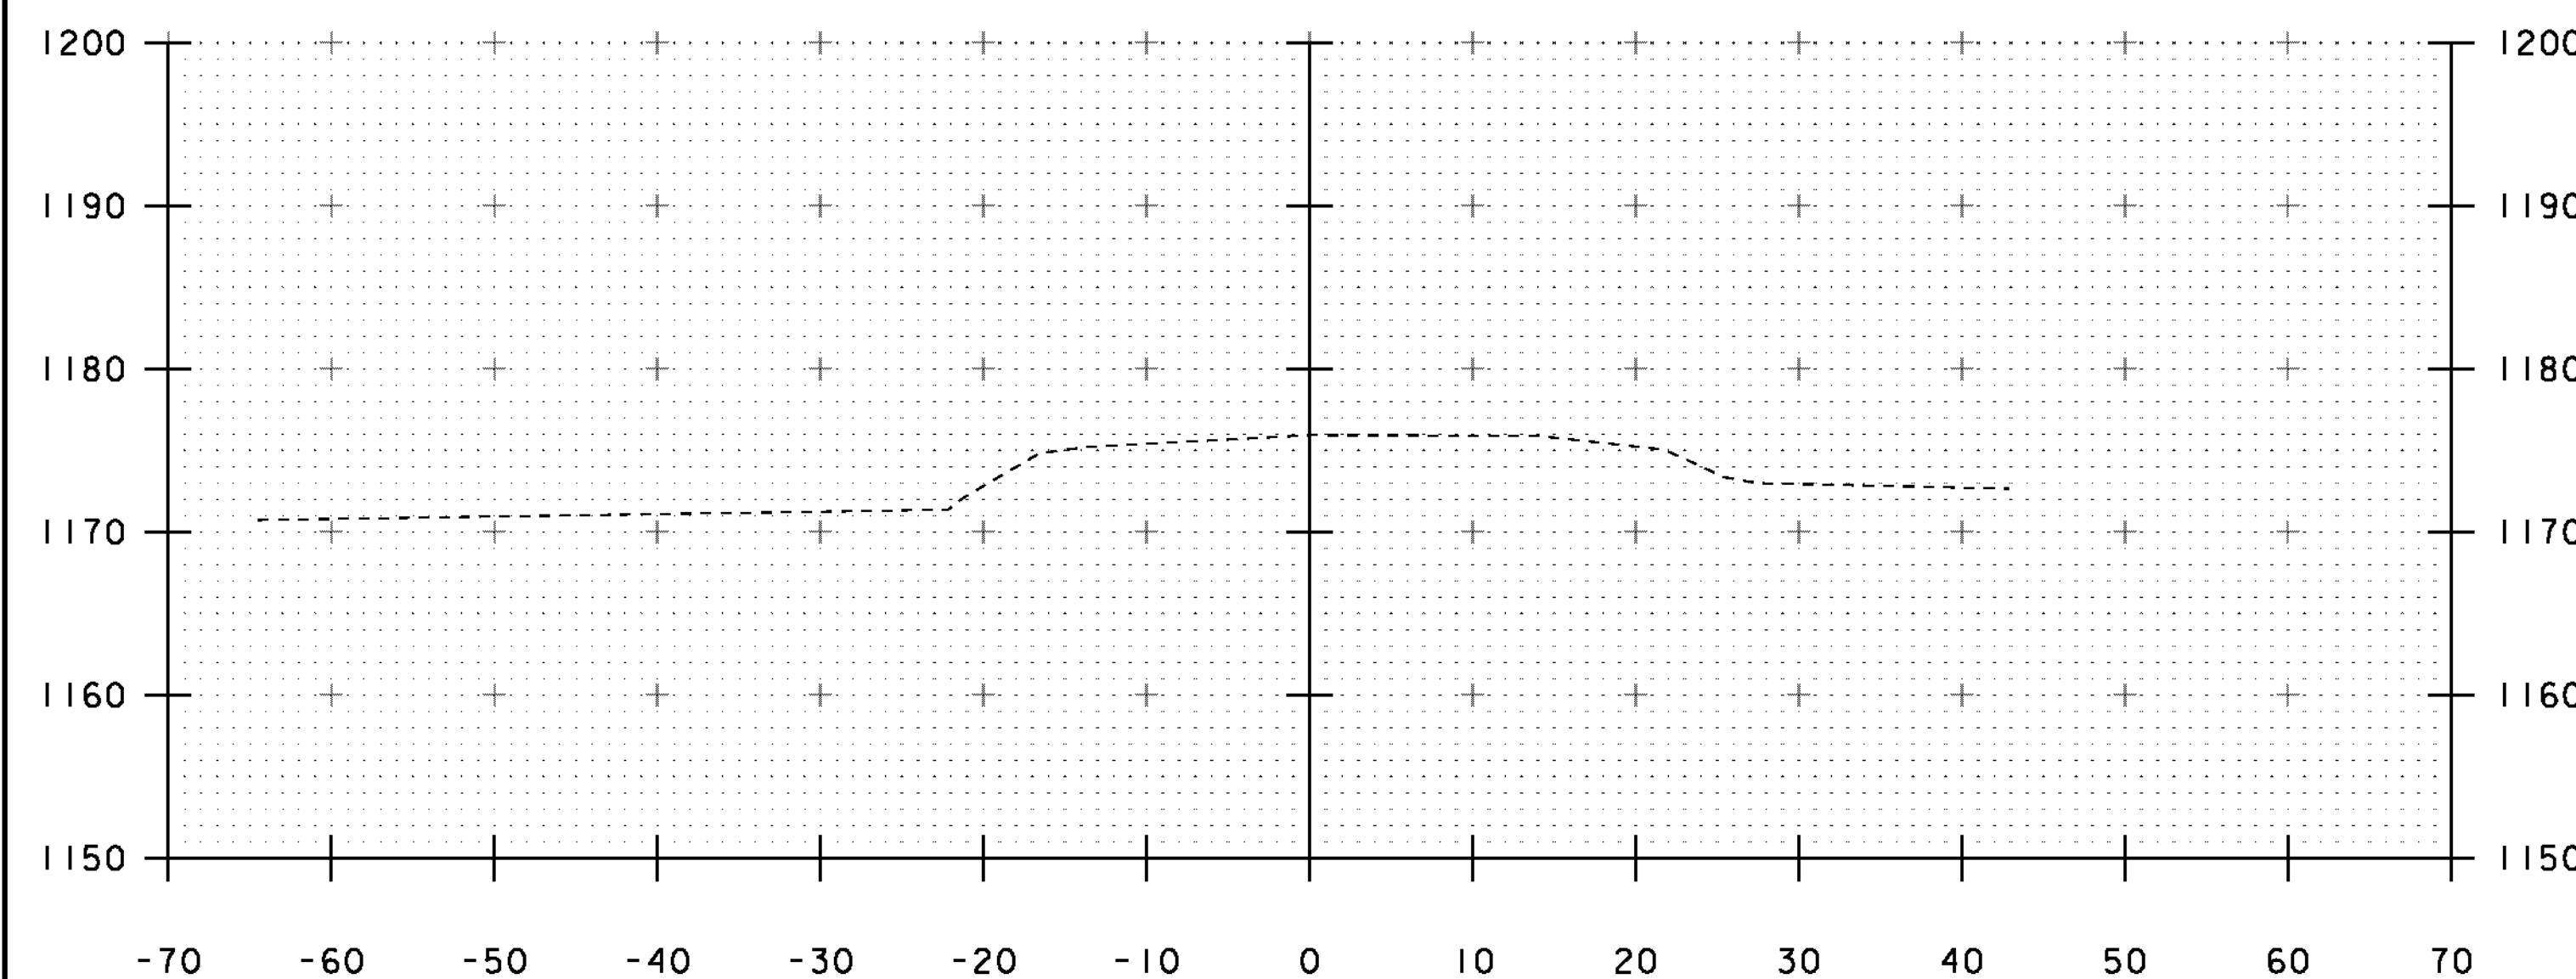

53+75

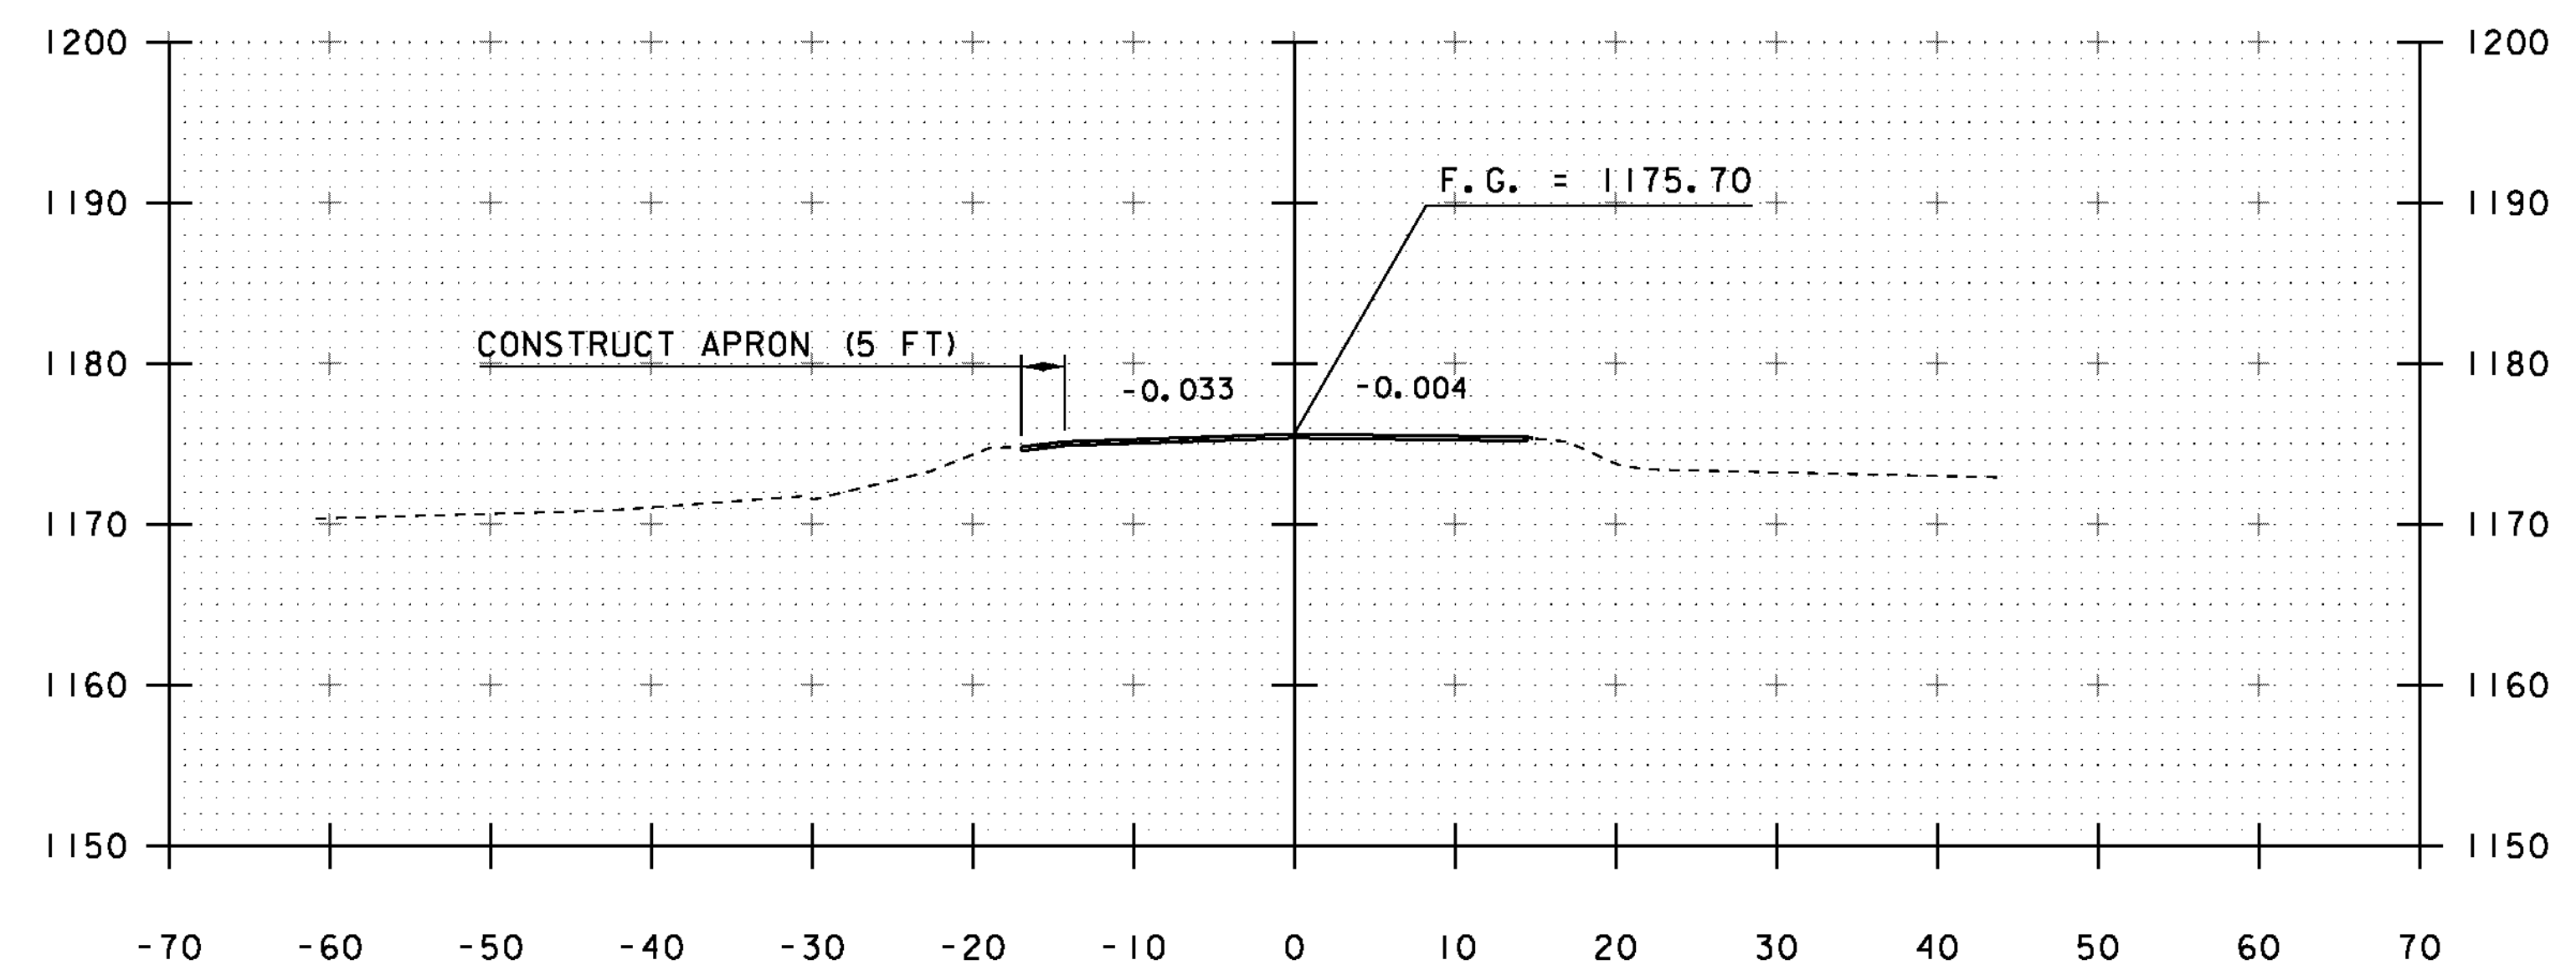

54+25

STA. 53+75 TO STA. 54+50

PROJECT NAME: BRIGHTON	
PROJECT NUMBER: ER STP 034-3(25)	
FILE NAME: s1b208xs.dgn	PLOT DATE: 12-SEP-2012
PROJECT LEADER: K. HIGGINS	DRAWN BY: J. SALVATORI
DESIGNED BY: J. SALVATORI	CHECKED BY: W. LAMMER
MAINLINE SECTIONS	SHEET 29 OF 36