




55+00
BEGIN PROJECT
END APPROACH

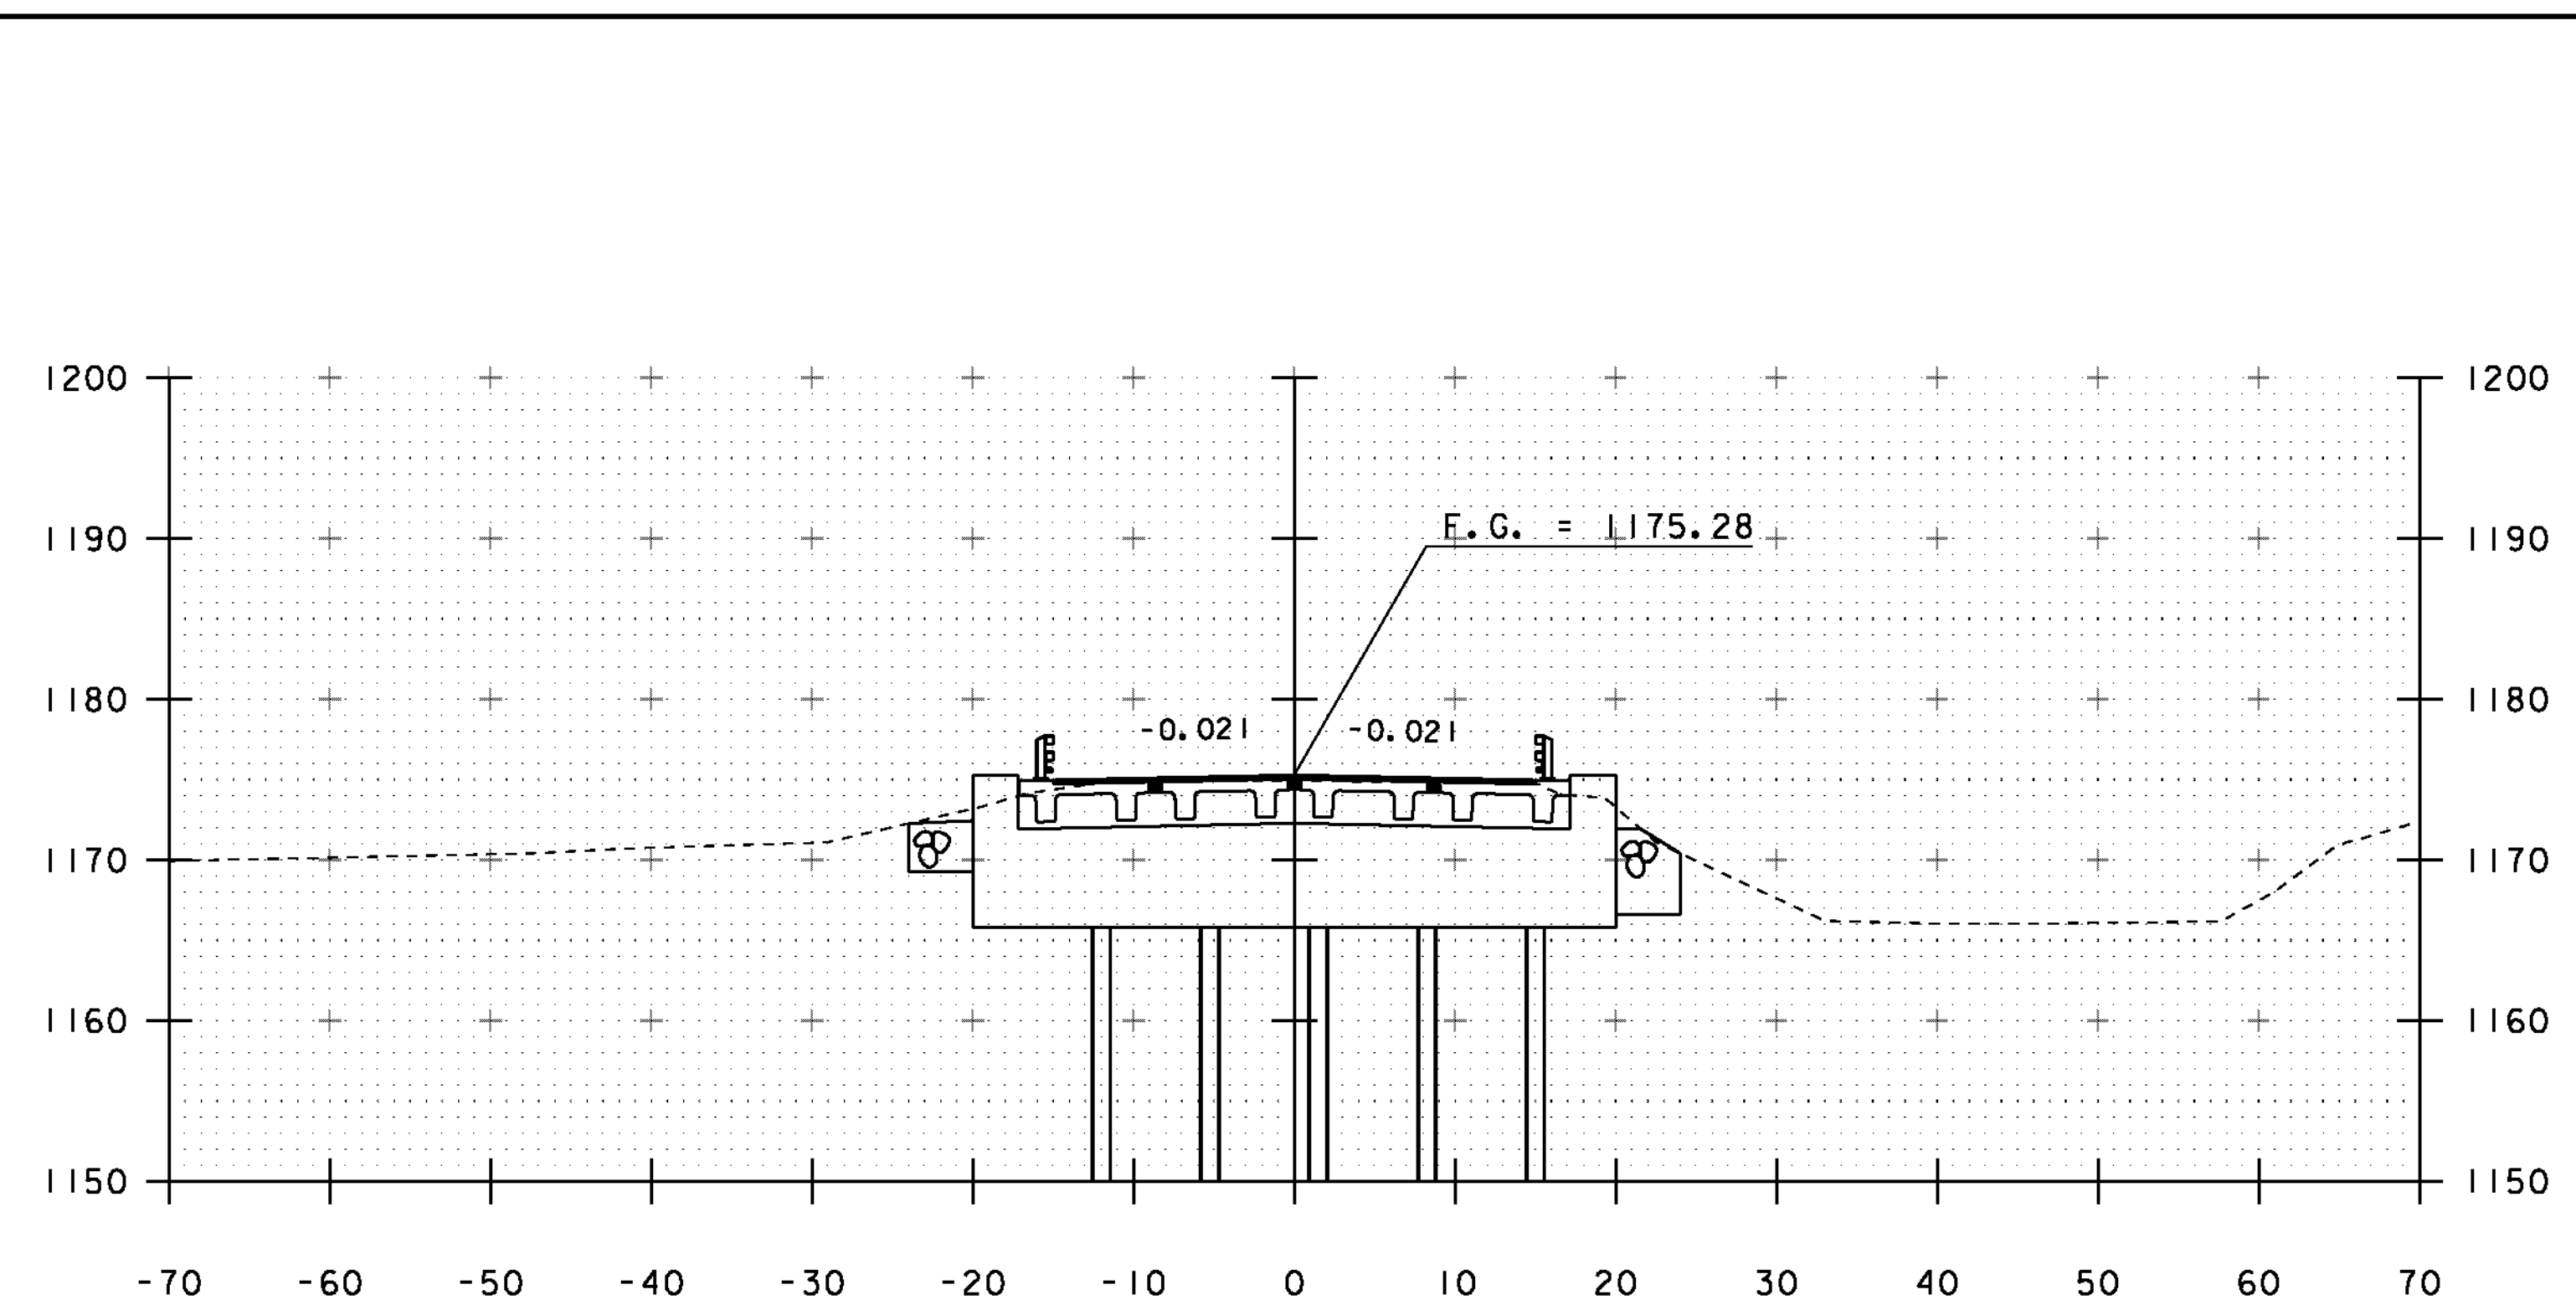

55+50
BEGIN BRIDGE STA 55+48.67

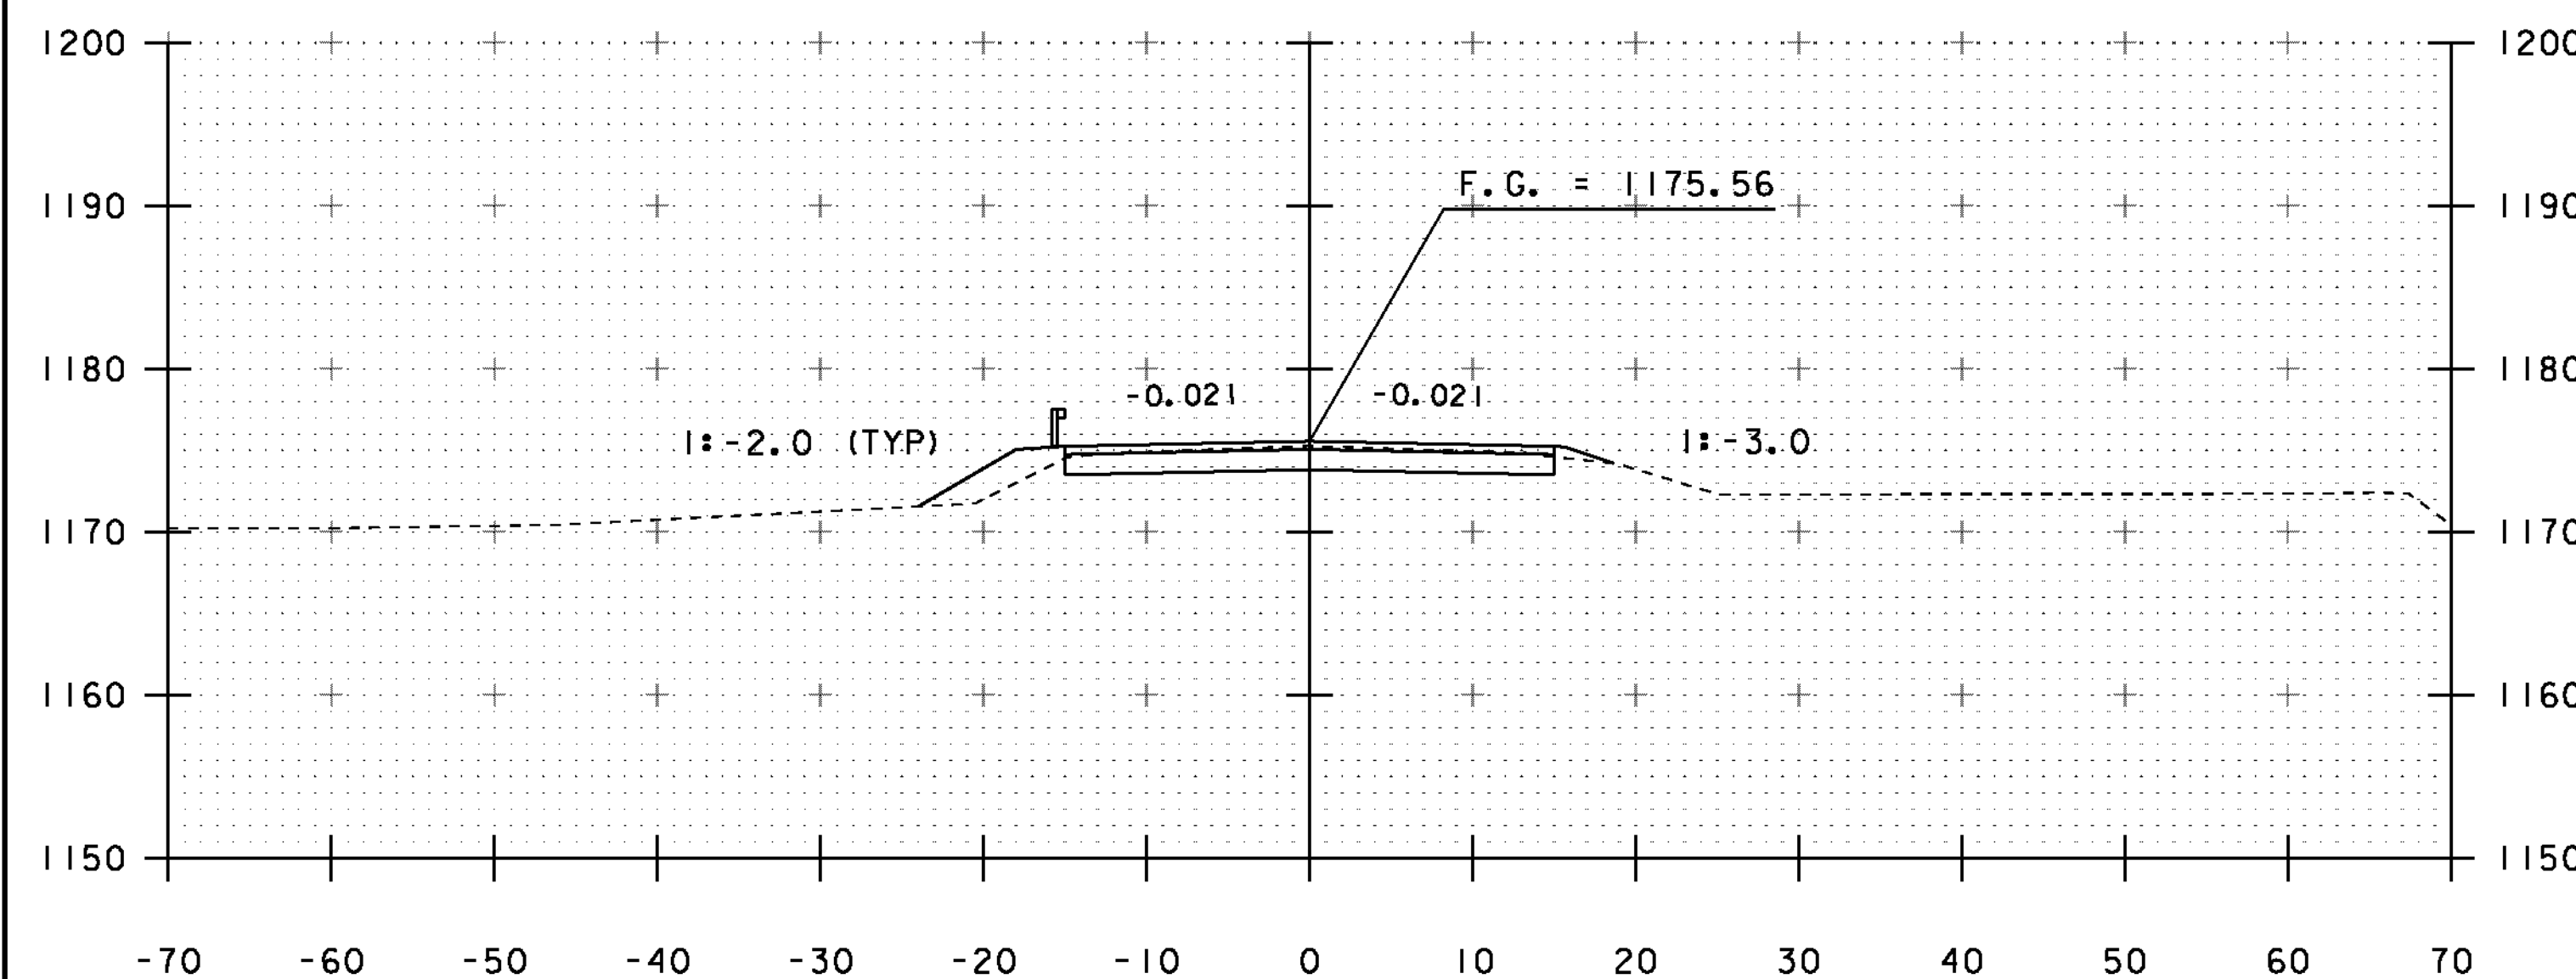

54+75

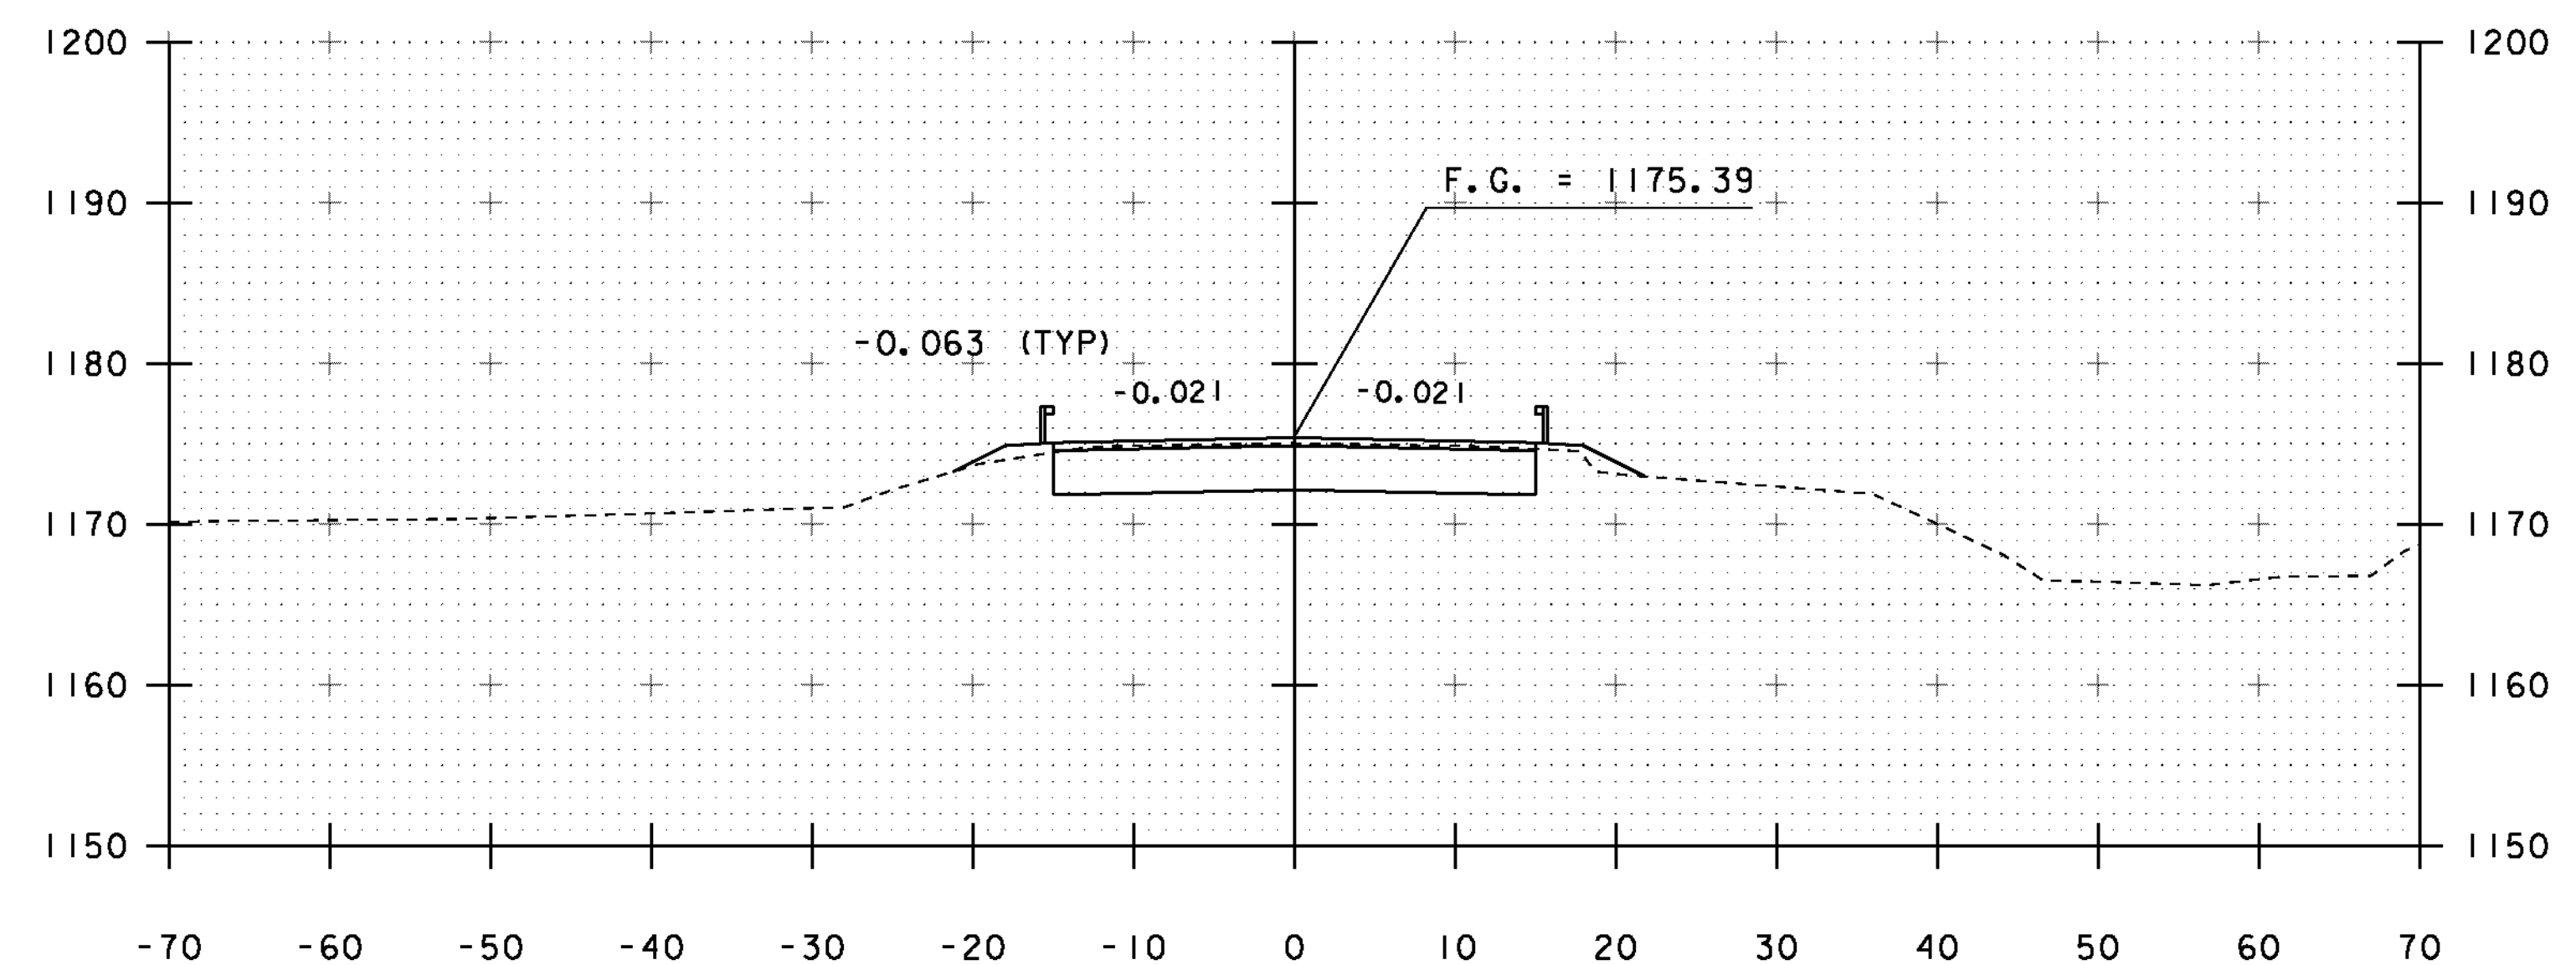

55+25

PROJECT NAME: BRIGHTON	PLOT DATE: 12-SEP-2012
PROJECT NUMBER: ER STP 034-3(25)	DRAWN BY: J. SALVATORI
FILE NAME: s11b208xs.dgn	CHECKED BY: W. LAMMER
PROJECT LEADER: K. HIGGINS	SHEET 30 OF 36
DESIGNED BY: J. SALVATORI	
MAINLINE SECTIONS	

STA. 54+75 TO STA. 55+50