



57+00

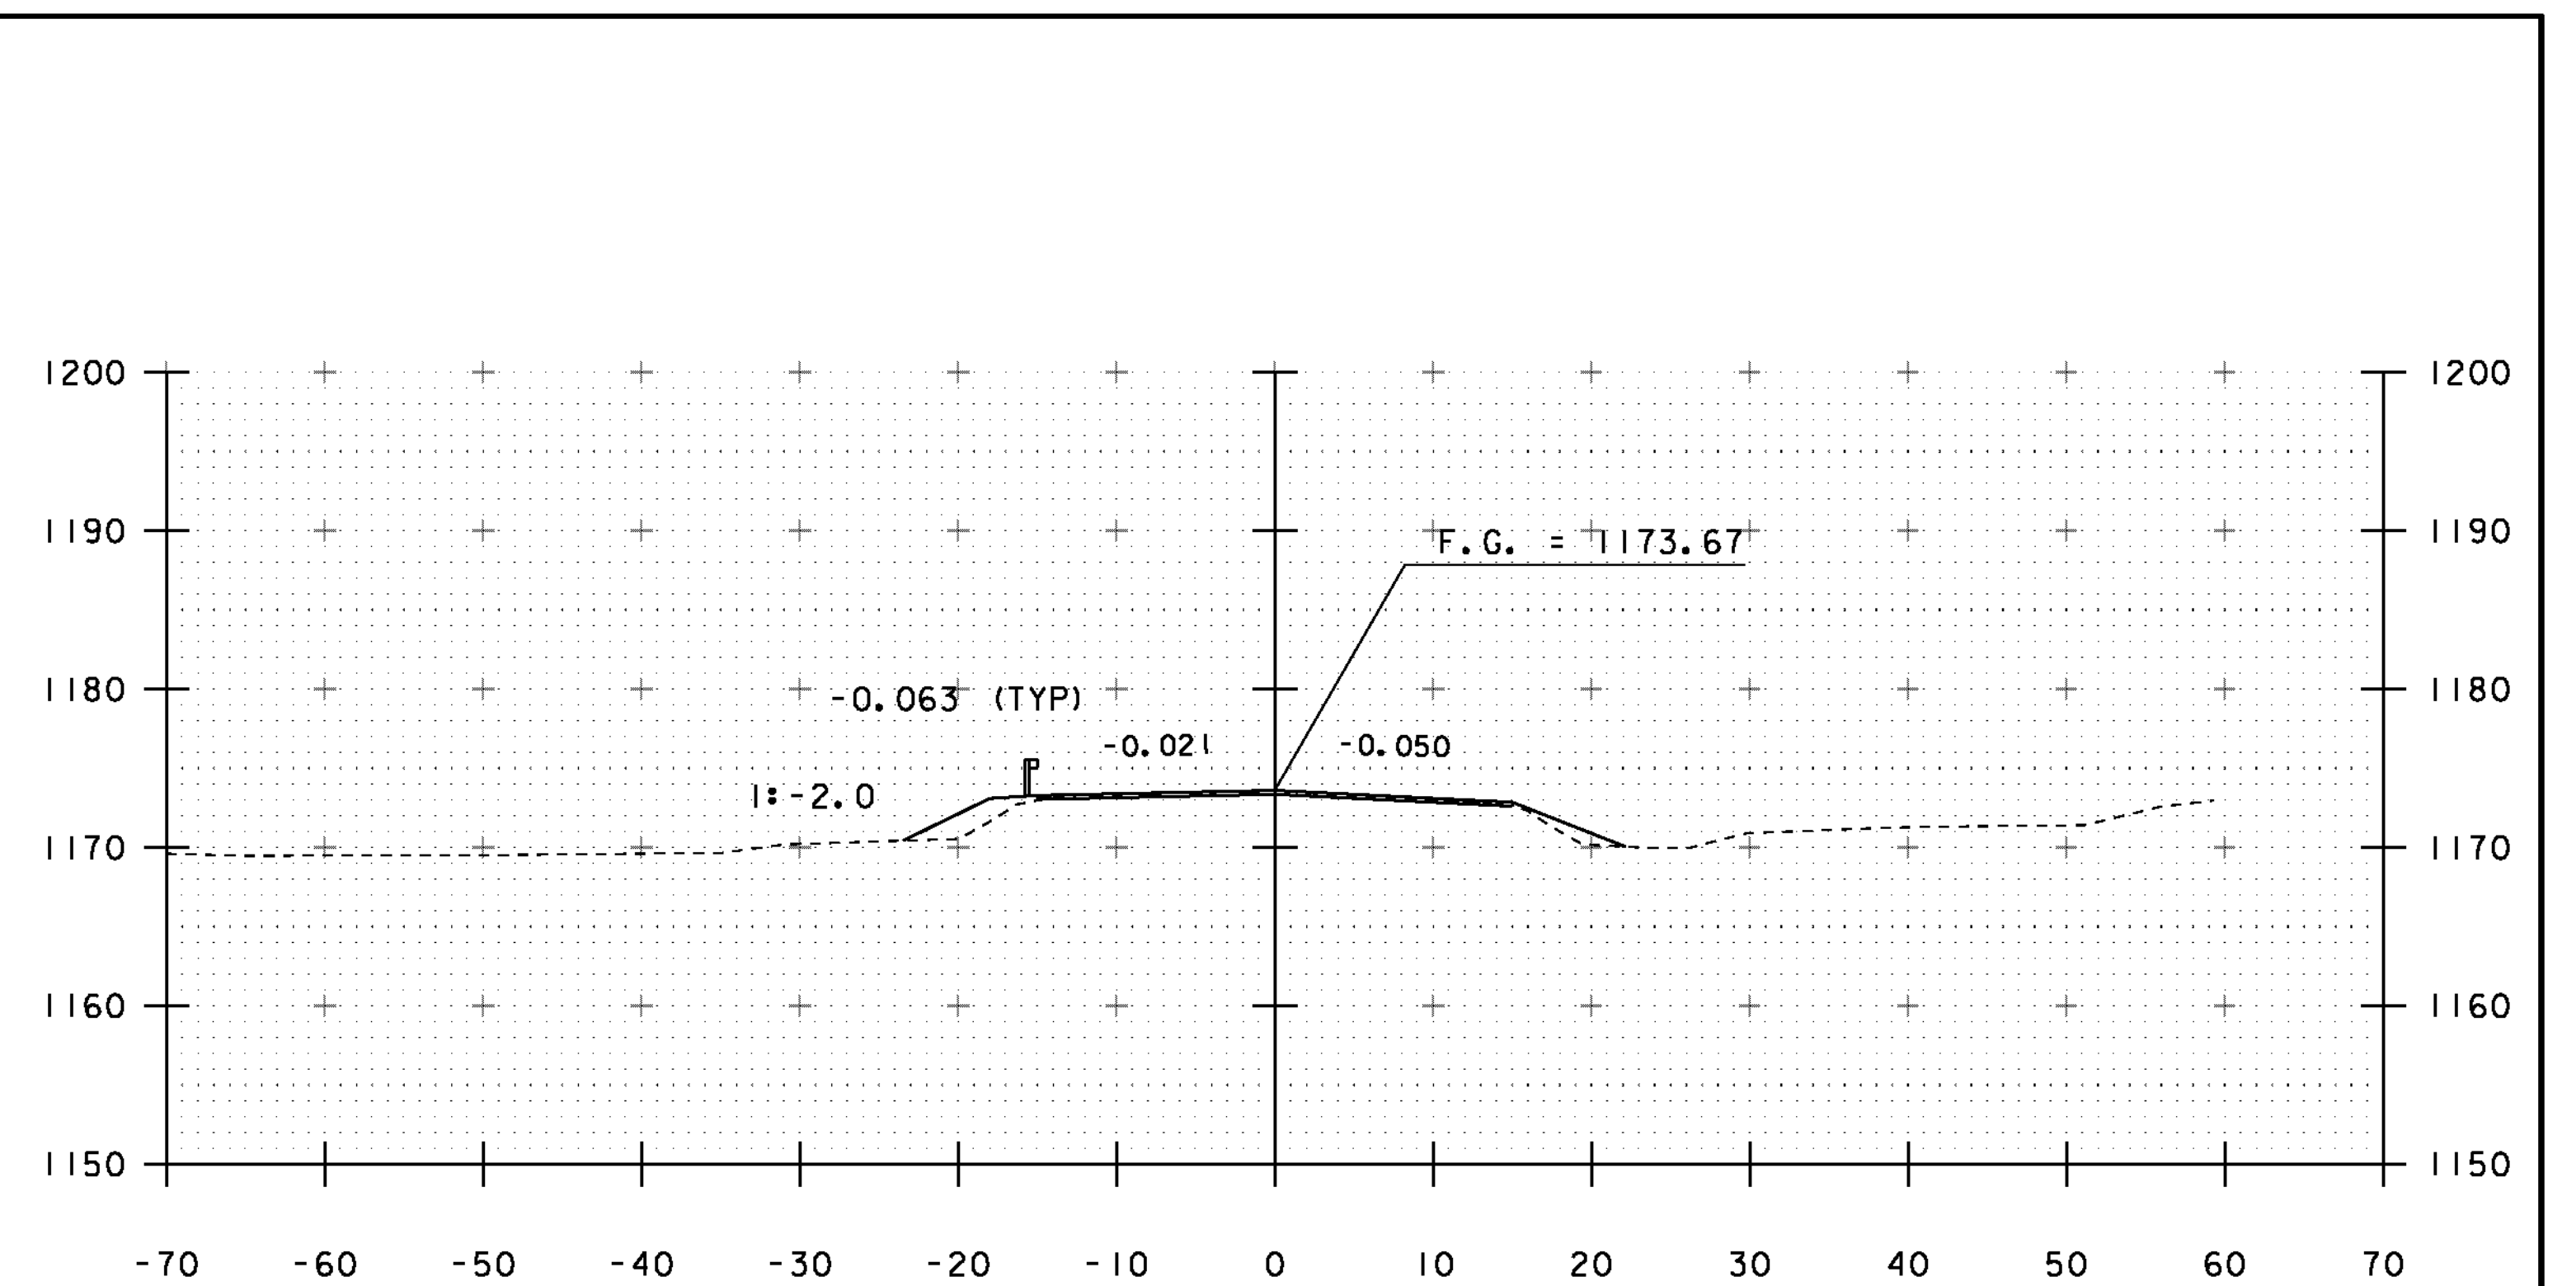


57+50

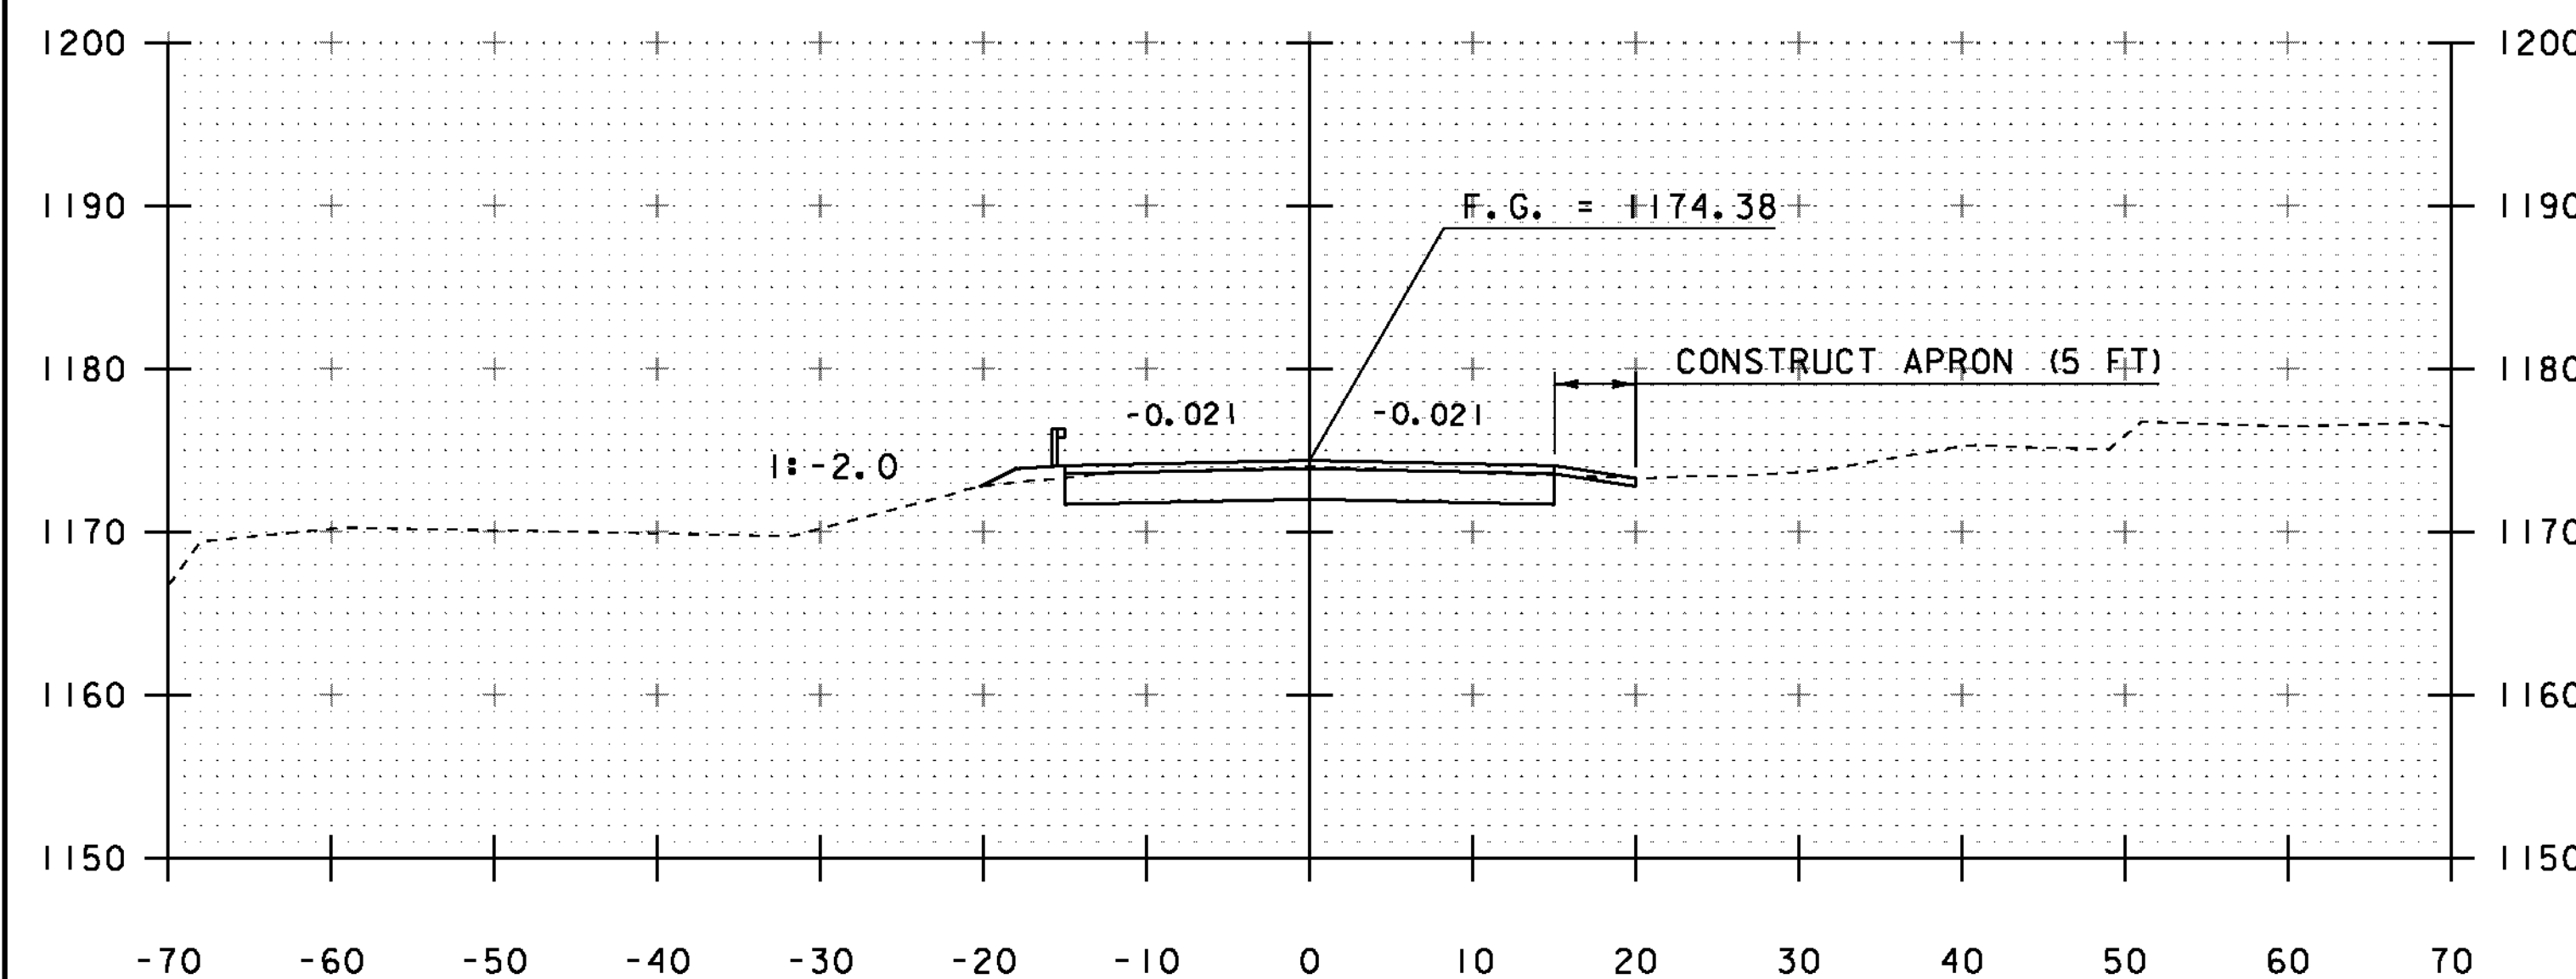

56+75

END PROJECT 56+70
BEGIN APPROACH

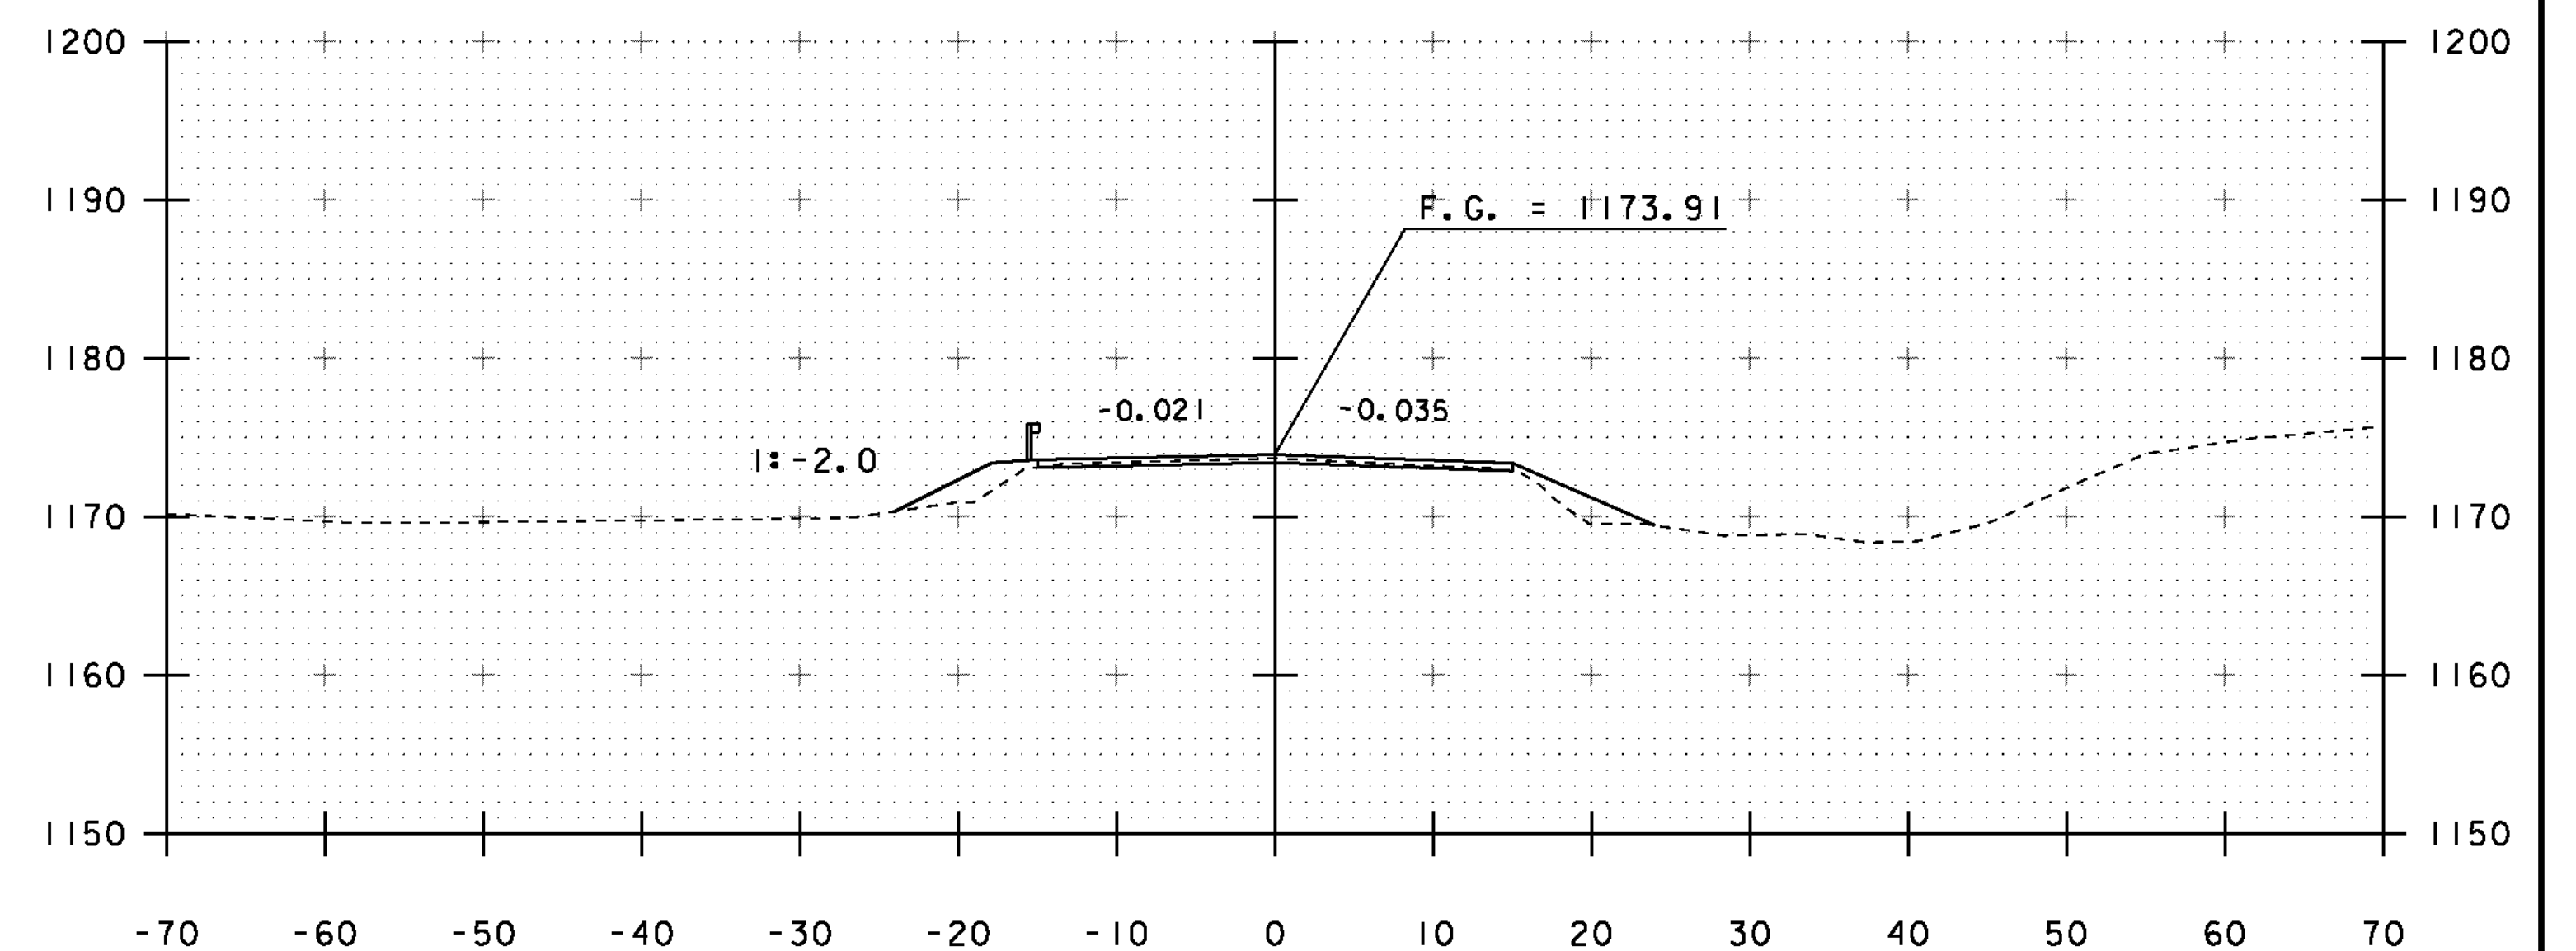

57+25

PROJECT NAME: BRIGHTON	PLOT DATE: 12-SEP-2012
PROJECT NUMBER: ER STP 034-3(25)	DRAWN BY: J. SALVATORI
FILE NAME: s11b208xs.dgn	CHECKED BY: W. LAMMER
PROJECT LEADER: K. HIGGINS	SHEET 32 OF 36
DESIGNED BY: J. SALVATORI	
MAINLINE SECTIONS	

STA. 56+75 TO STA. 57+50