



STA 10+56 LT  
 BEGIN CHANNEL EXCAVATION  
 BEGIN GEOTEXTILE FABRIC UNDER STONE FILL  
 BEGIN STONE FILL, TYPE III  
 BEGIN GRUBBING MATERIAL

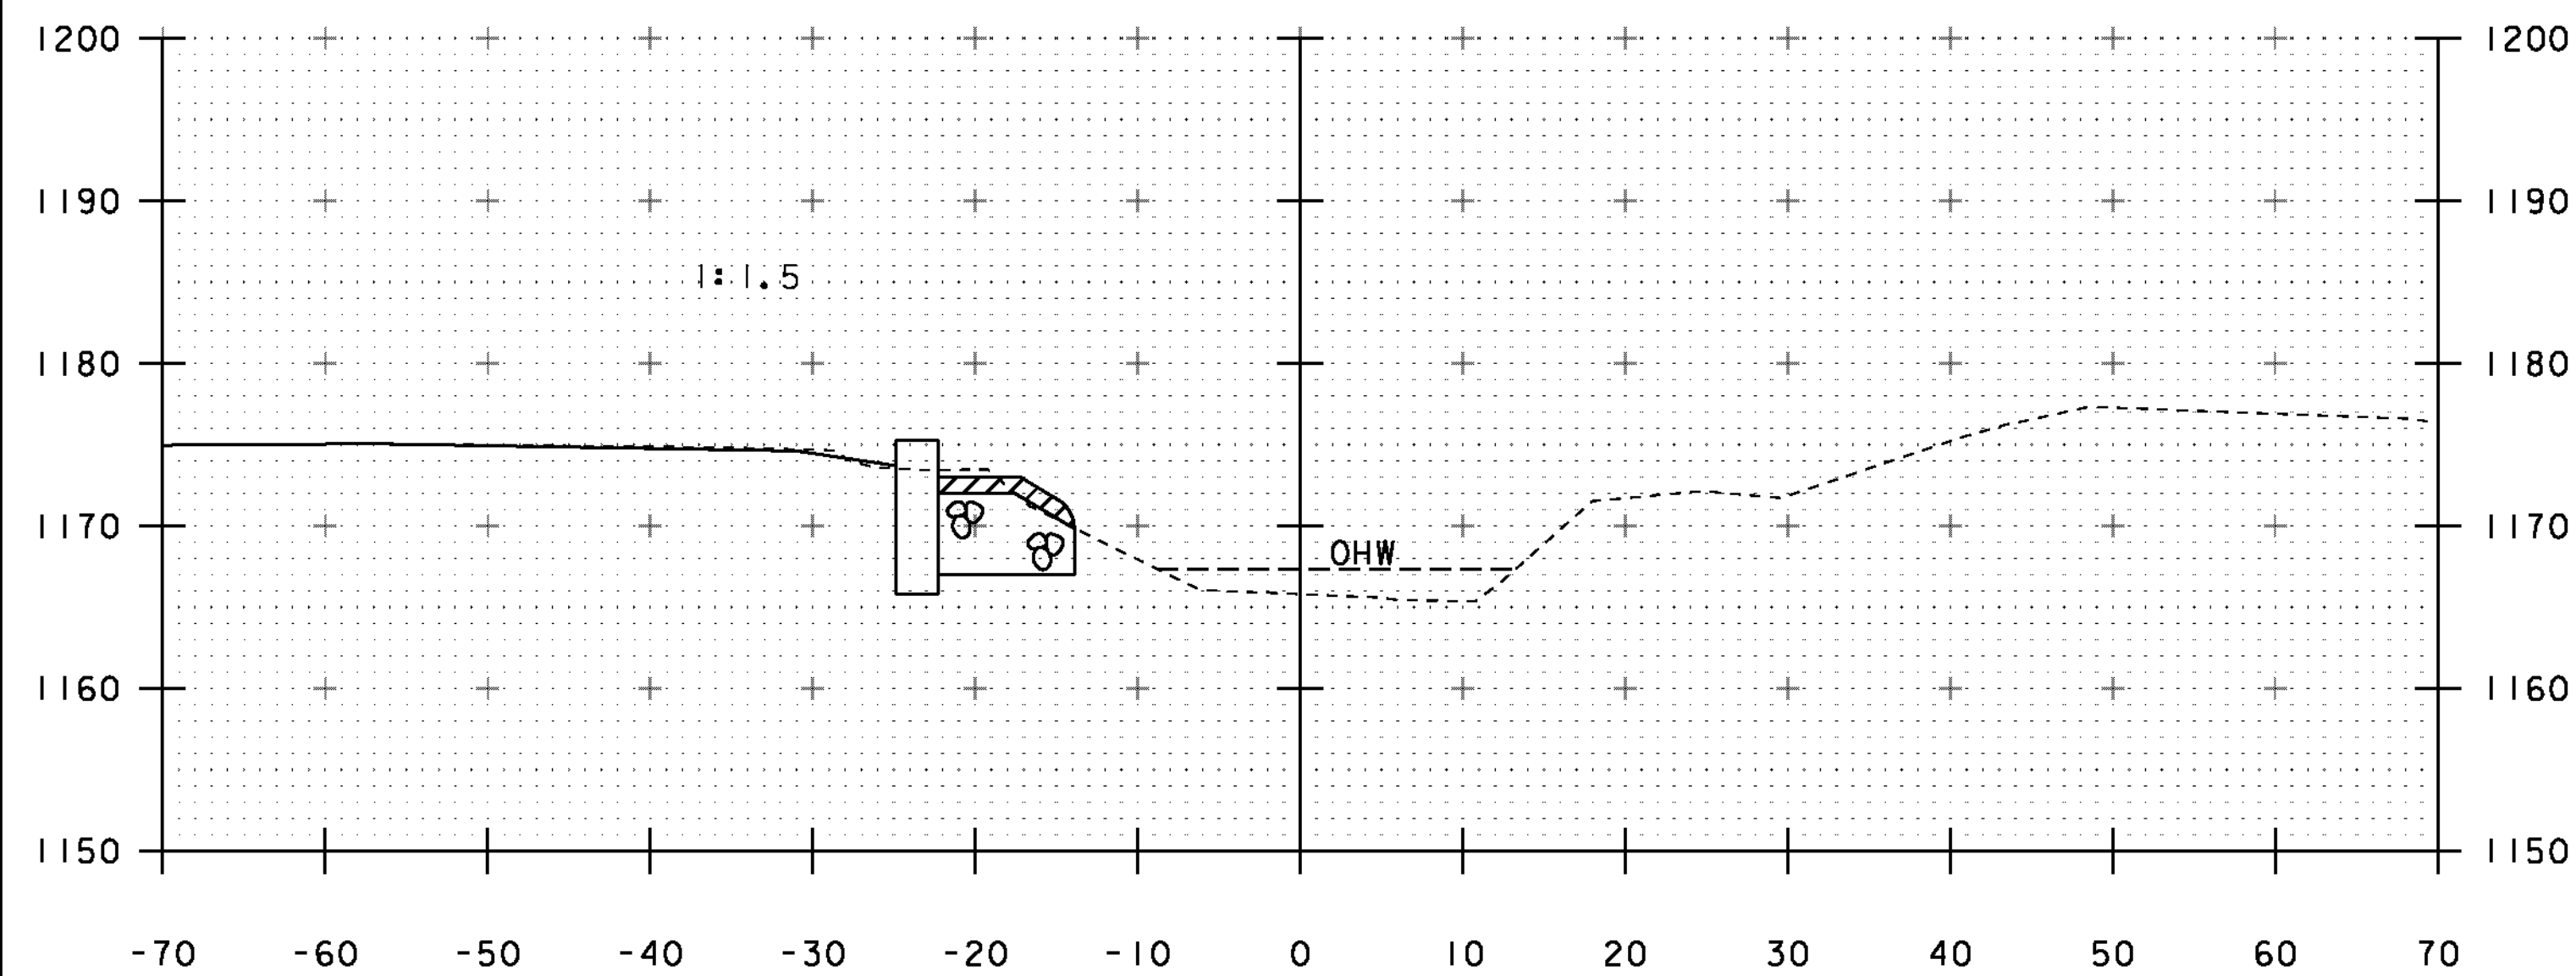


10+60

STA 10+81 RT  
 BEGIN CHANNEL EXCAVATION  
 BEGIN GEOTEXTILE FABRIC UNDER STONE FILL  
 BEGIN STONE FILL, TYPE III  
 BEGIN GRUBBING MATERIAL

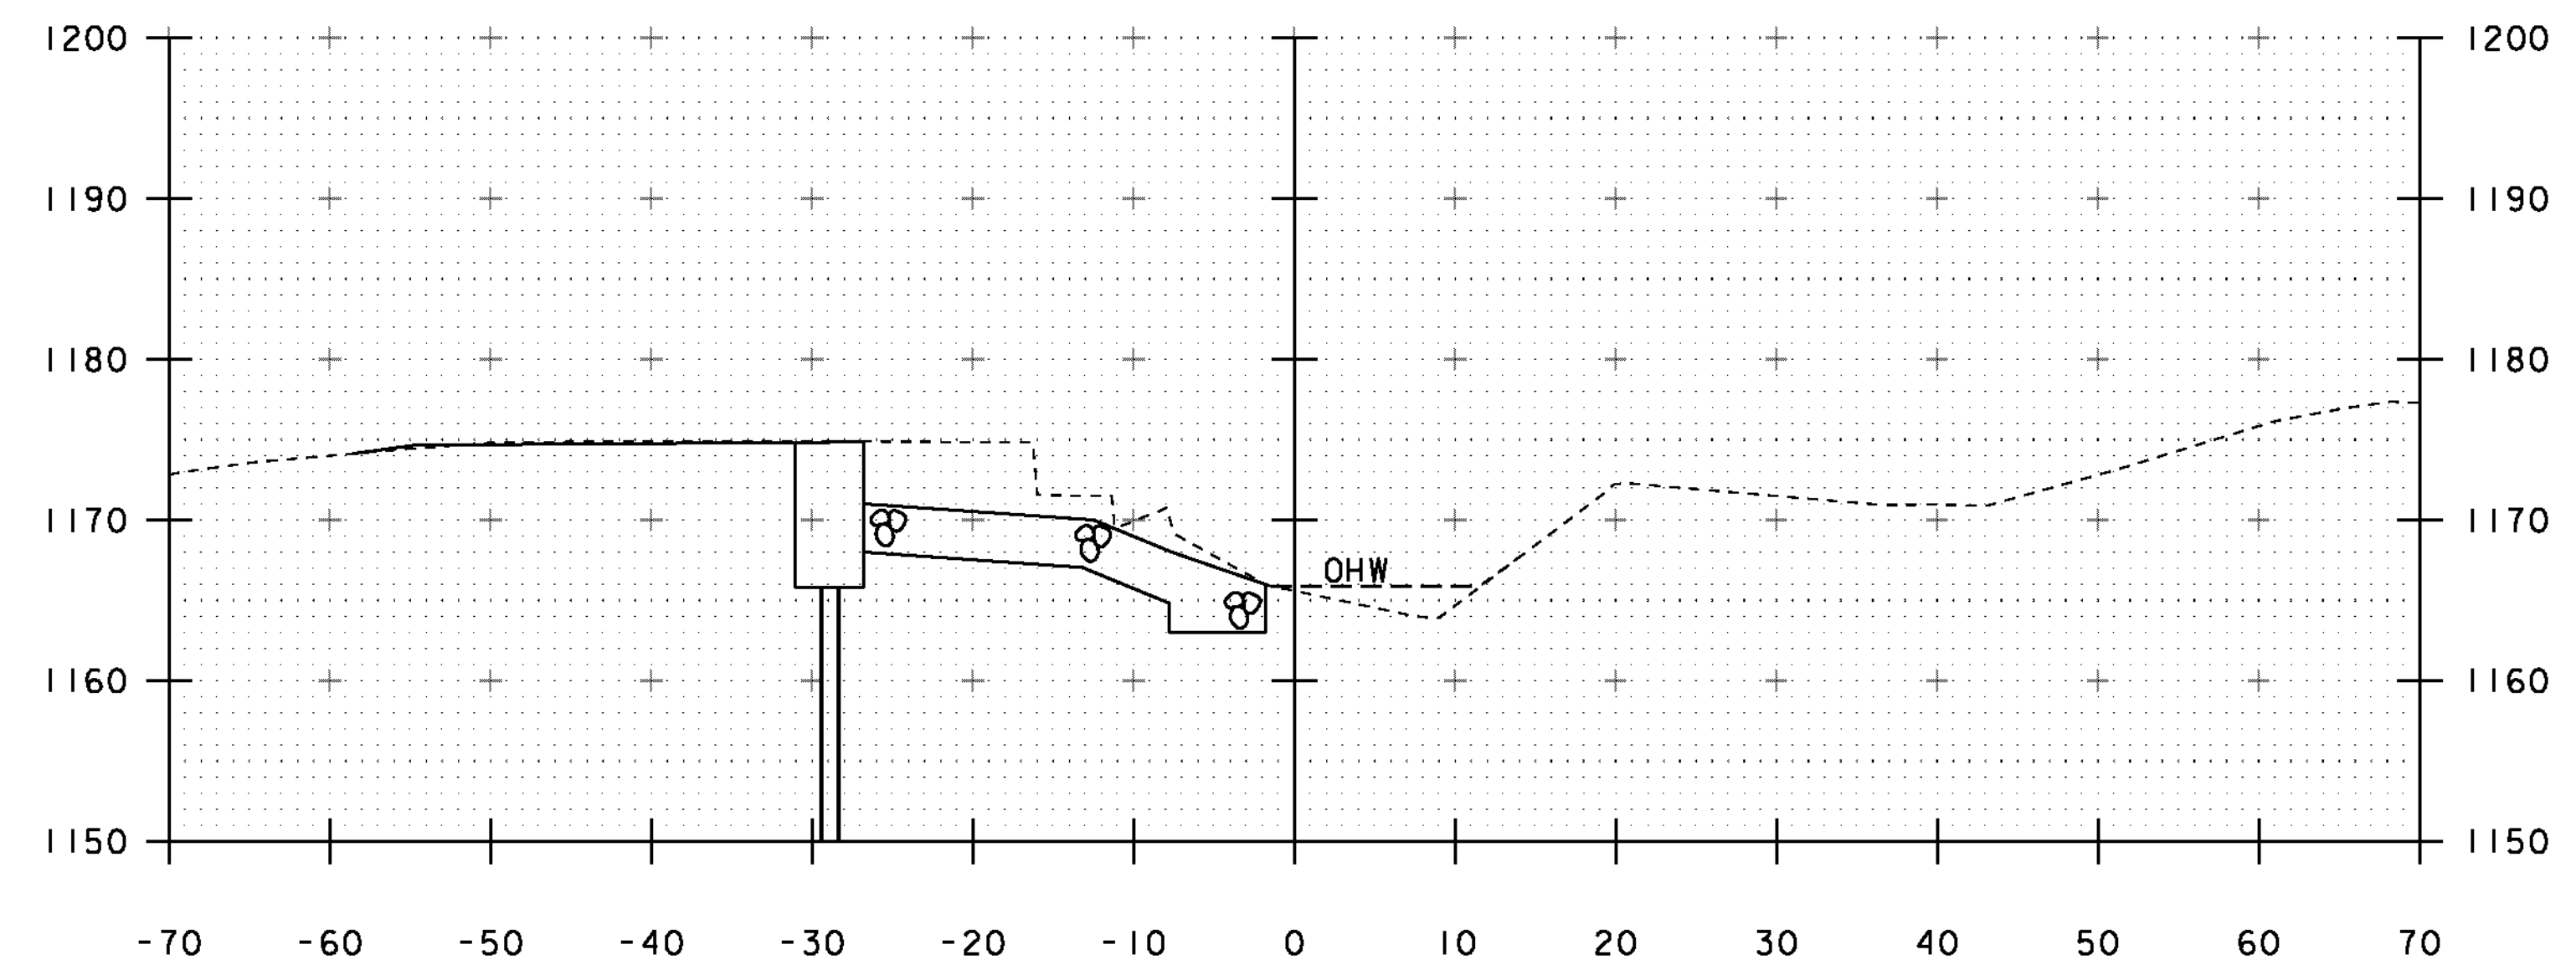


10+80

STA 10+74 LT  
 END GRUBBING MATERIAL

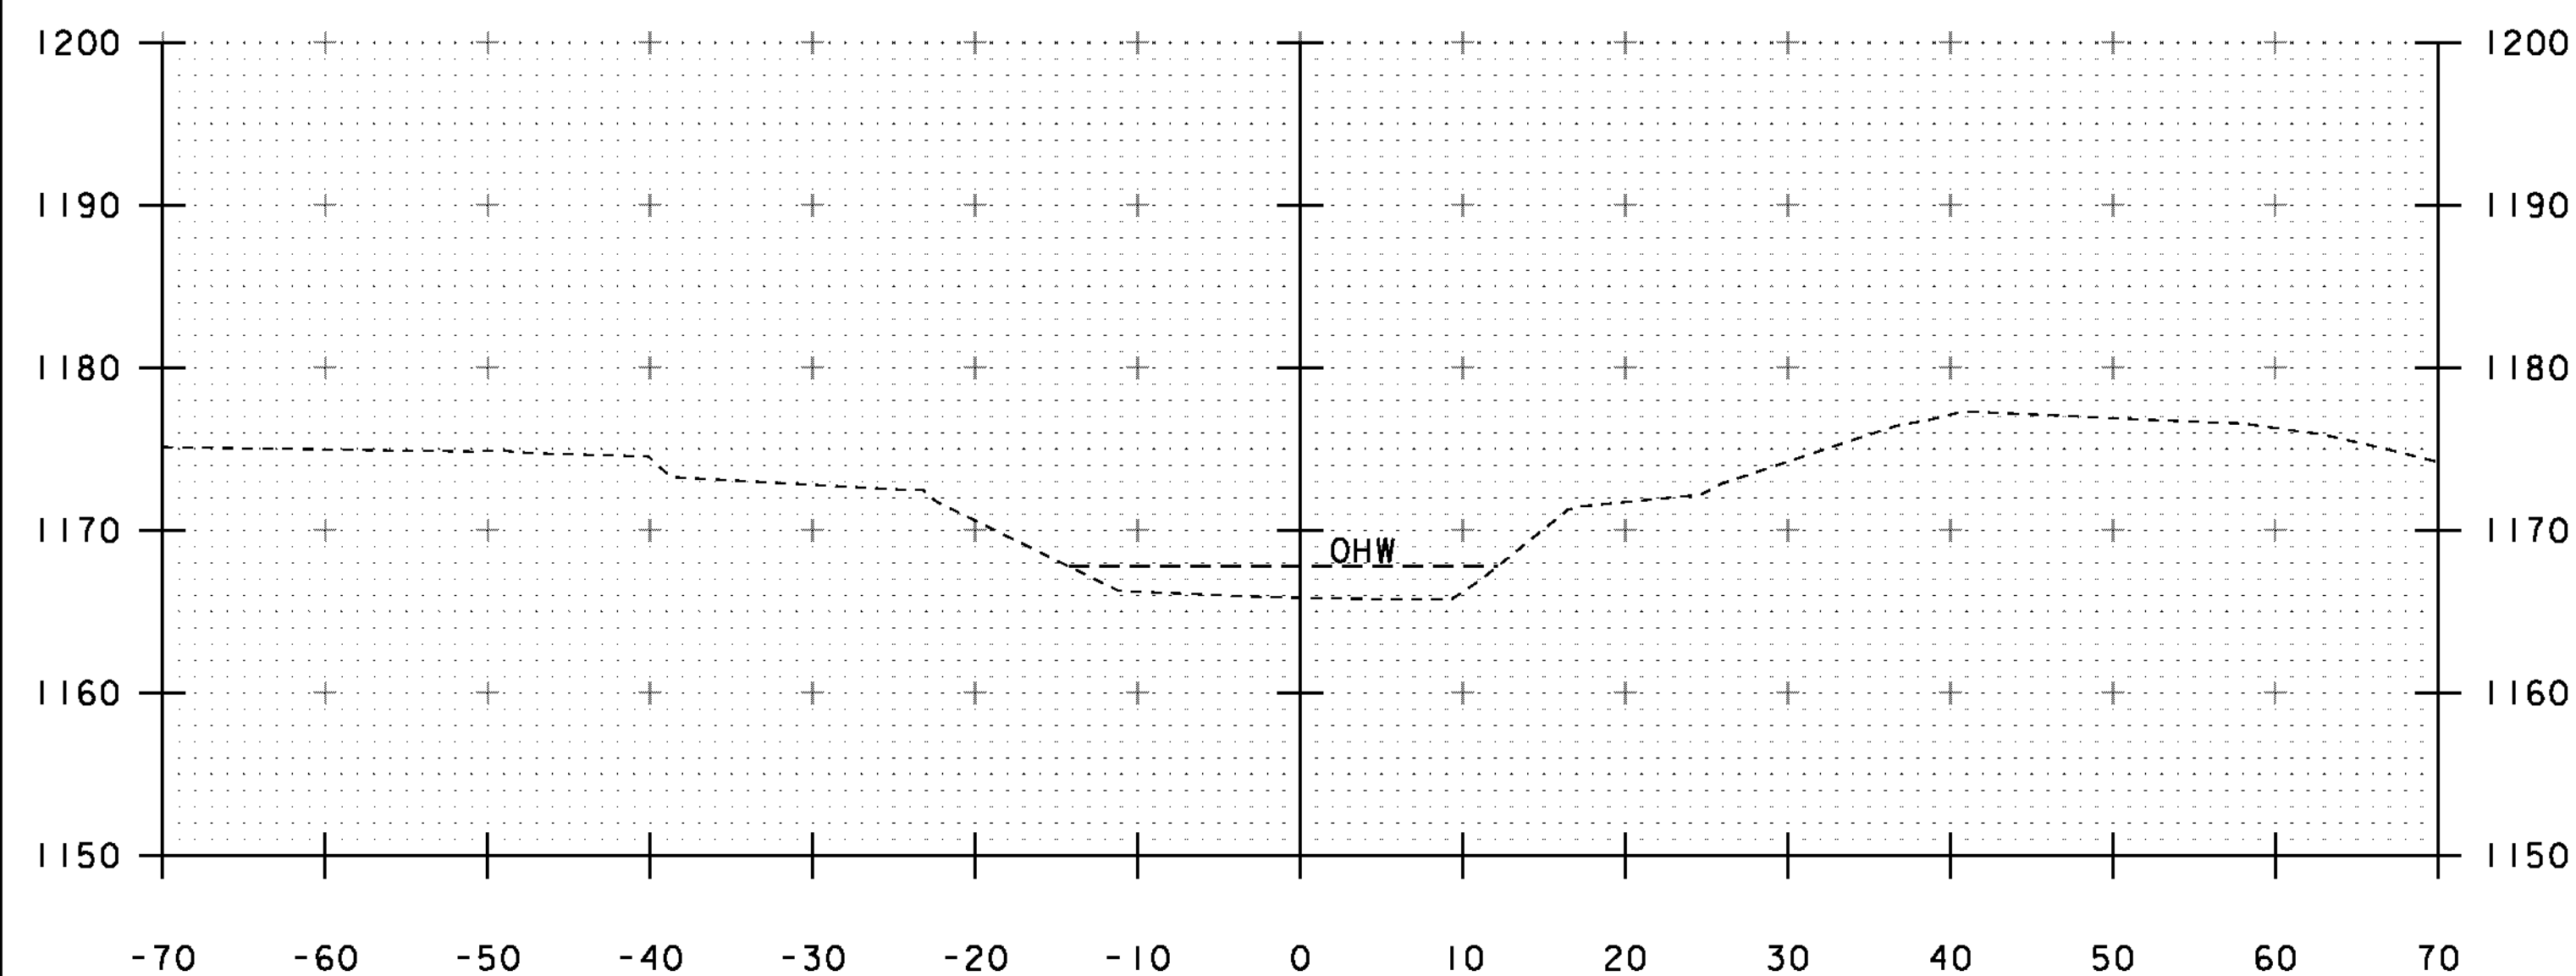

10+50

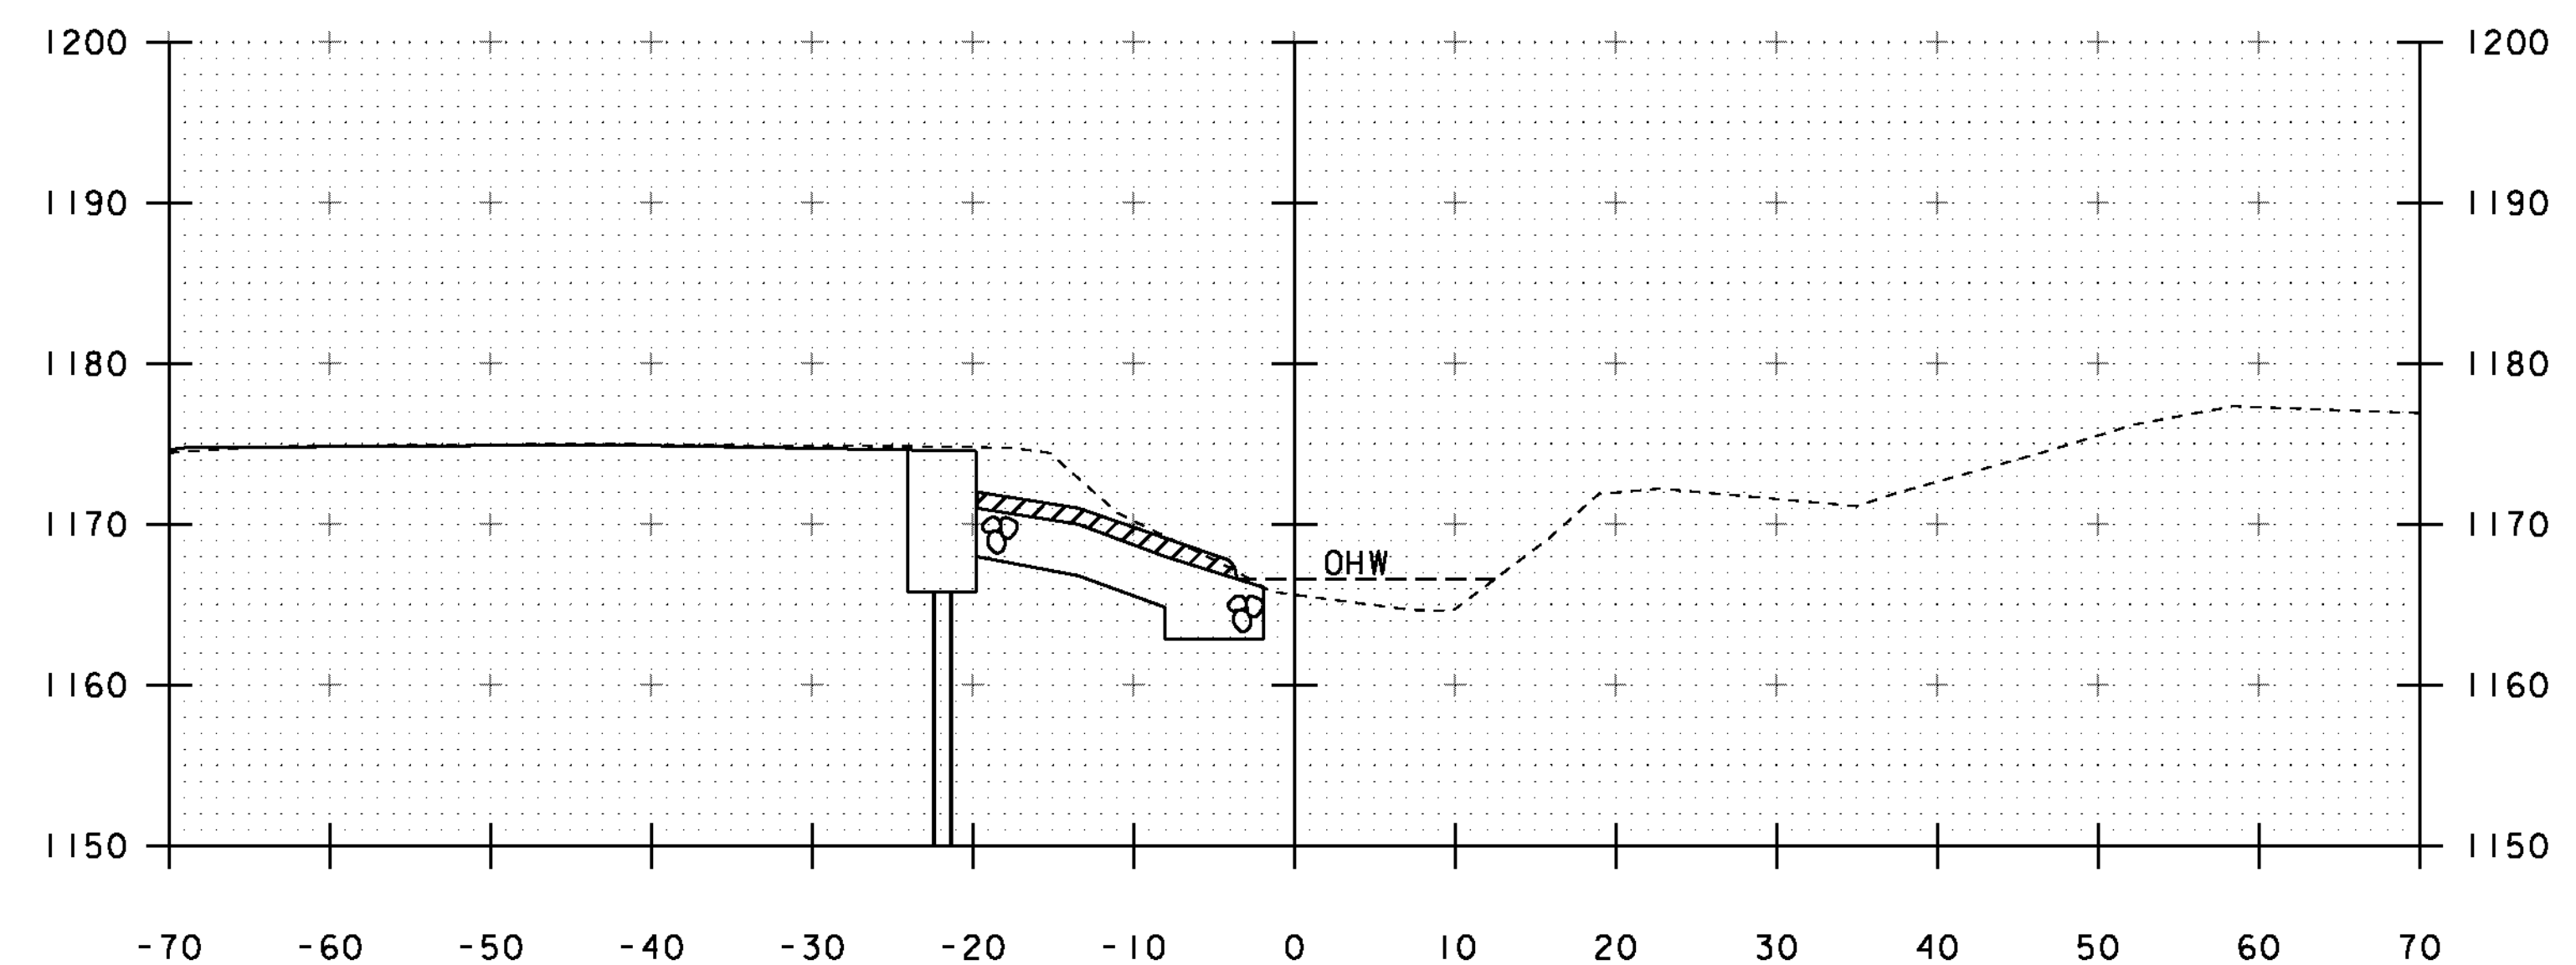

10+70

PROJECT NAME: BRIGHTON  
 PROJECT NUMBER: ER STP 034-3(25)

FILE NAME: s1b208xs.dgn  
 PROJECT LEADER: K. HIGGINS  
 DESIGNED BY: J. SALVATORI  
 CHANNEL SECTIONS

PLOT DATE: 12-SEP-2012  
 DRAWN BY: J. SALVATORI  
 CHECKED BY: W. LAMMER  
 SHEET 34 OF 36

STA. 10+50 TO STA. 10+80