



STA 11+44 RT  
 END CHANNEL EXCAVATION  
 END GEOTEXTILE FABRIC UNDER STONE FILL  
 END STONE FILL, TYPE III  
 END GRUBBING MATERIAL

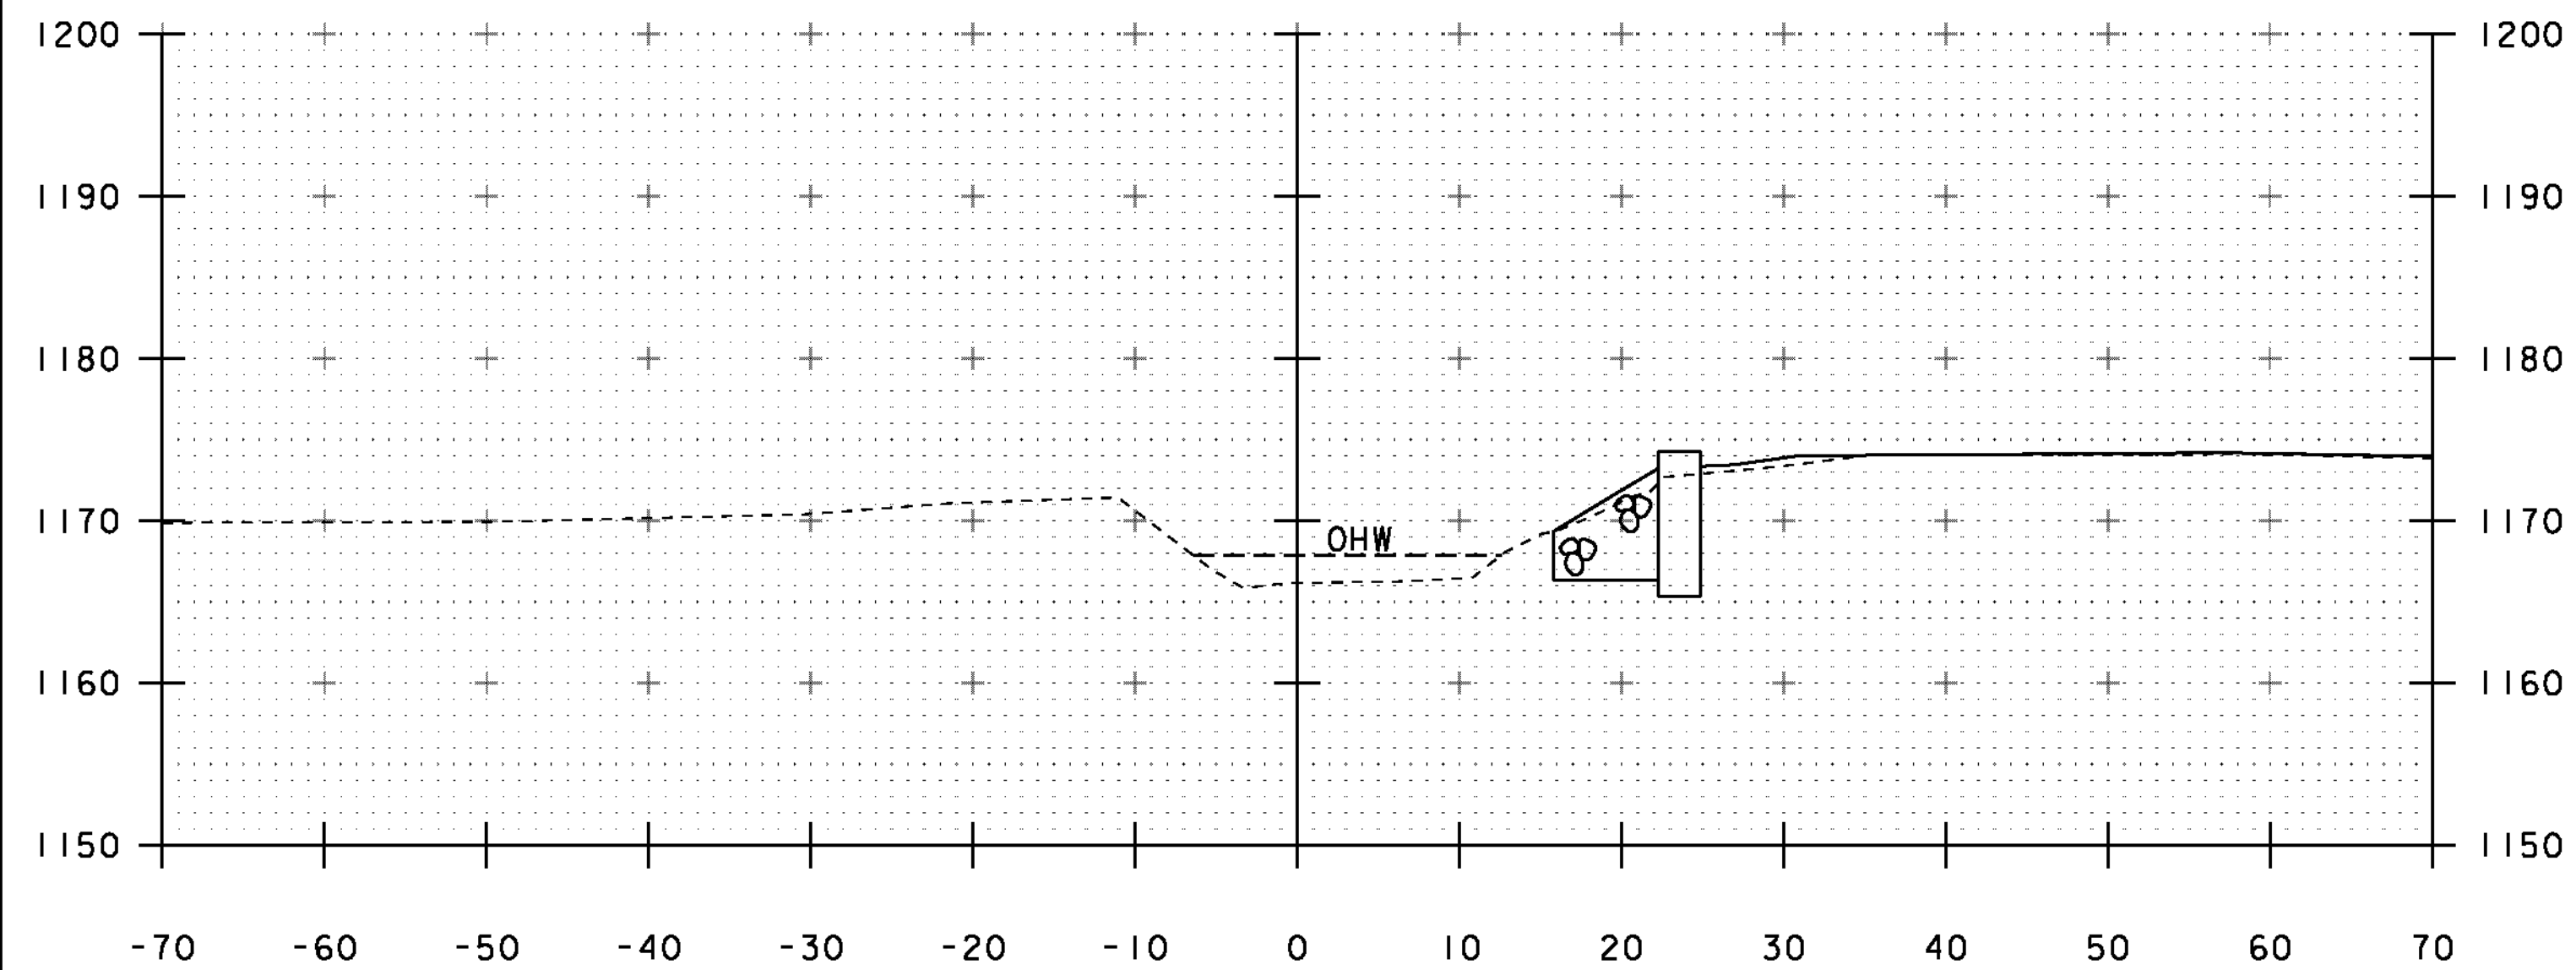


11+40

STA 11+27 LT  
 END CHANNEL EXCAVATION  
 END GEOTEXTILE FABRIC UNDER STONE FILL  
 END STONE FILL, TYPE III  
 END GRUBBING MATERIAL

STA 11+28 RT  
 BEGIN GRUBBING MATERIAL

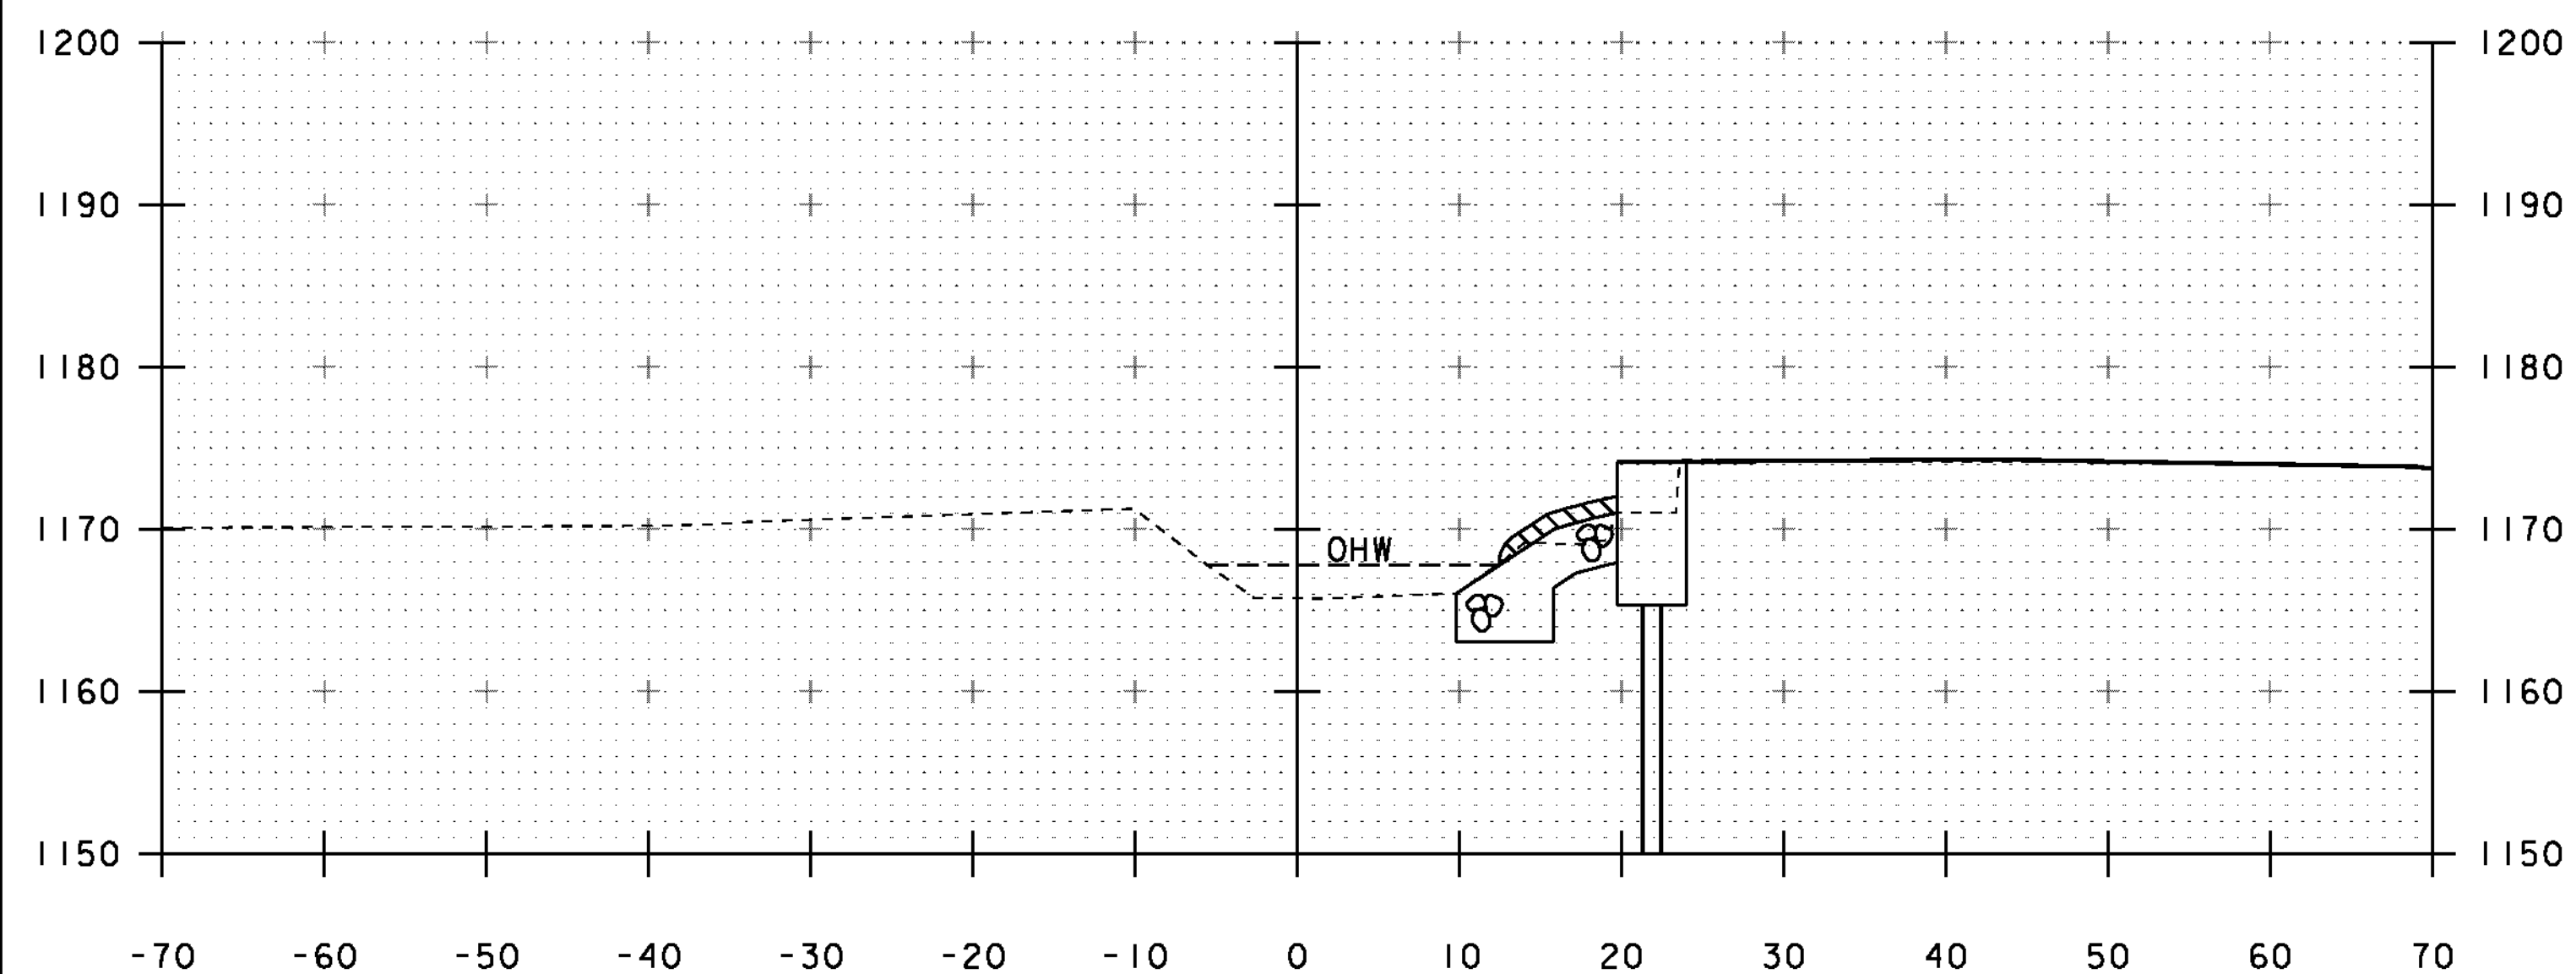

11+30

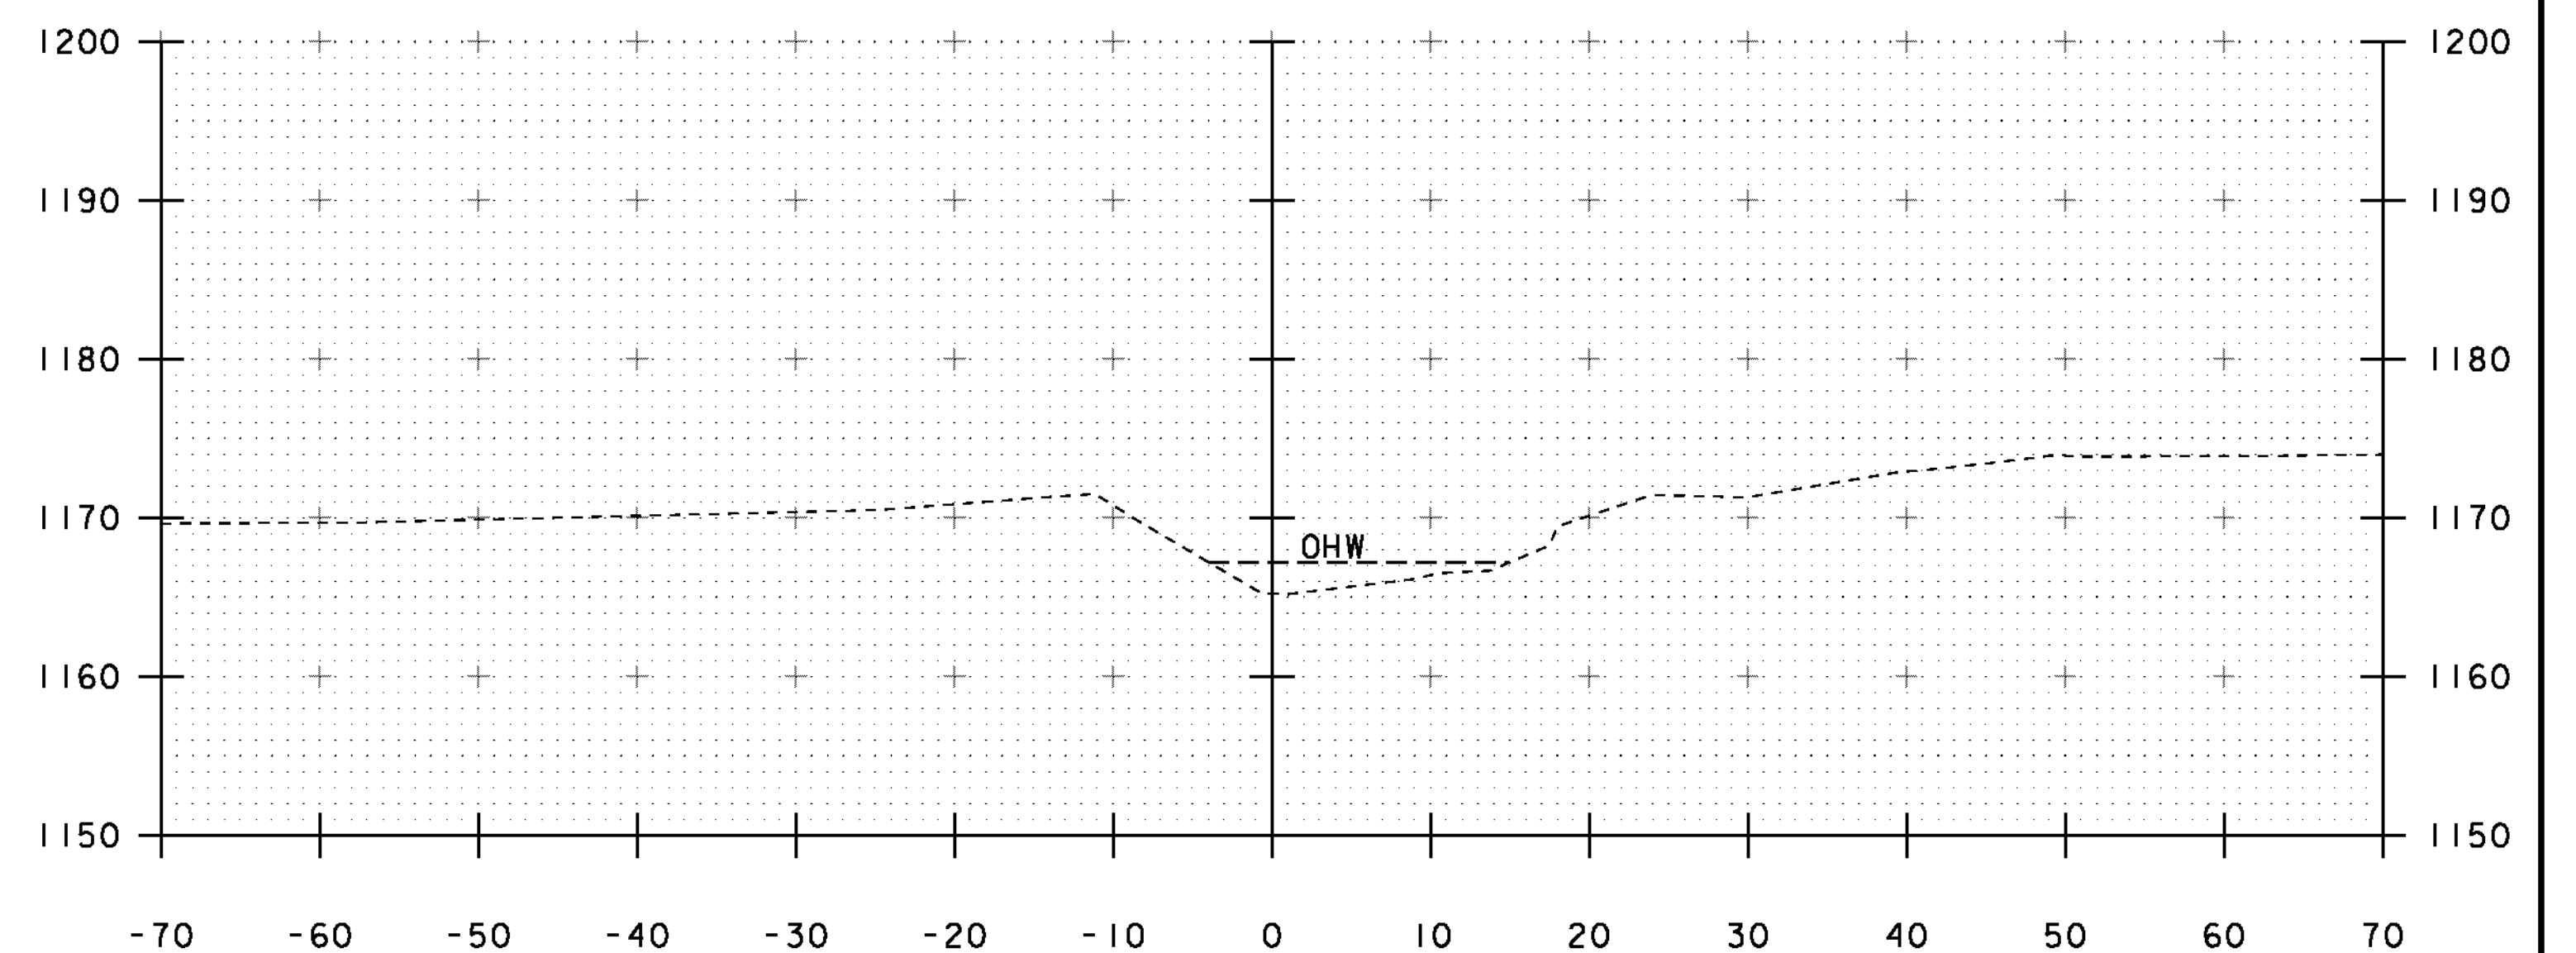

11+50

PROJECT NAME: BRIGHTON  
 PROJECT NUMBER: ER STP 034-3(25)

FILE NAME: s1b208xs.dgn  
 PROJECT LEADER: K. HIGGINS  
 DESIGNED BY: J. SALVATORI  
 CHANNEL SECTIONS

PLOT DATE: 12-SEP-2012  
 DRAWN BY: J. SALVATORI  
 CHECKED BY: W. LAMMER  
 SHEET 36 OF 36

STA. 11+30 TO STA. 11+50