



STATE OF VERMONT AGENCY OF TRANSPORTATION

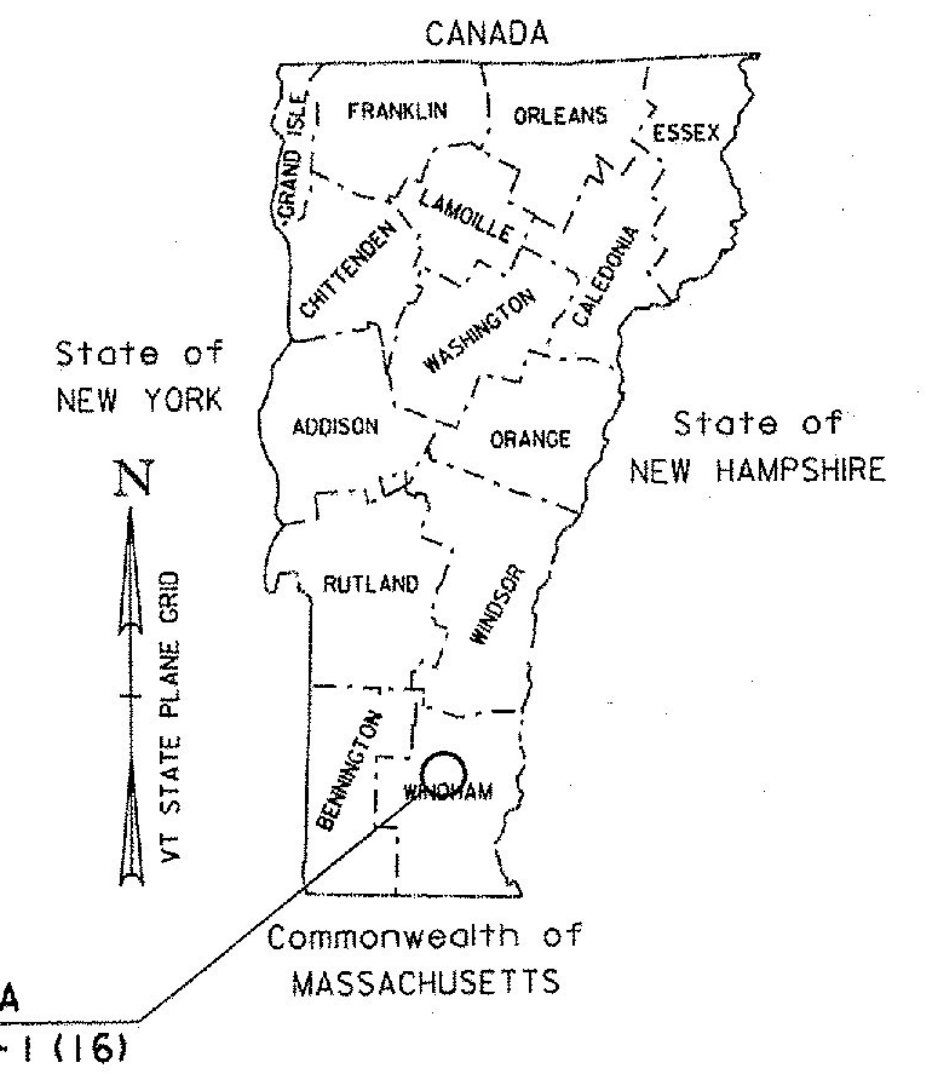

PROPOSED IMPROVEMENT BRIDGE PROJECT TOWN OF JAMAICA COUNTY OF WINDHAM

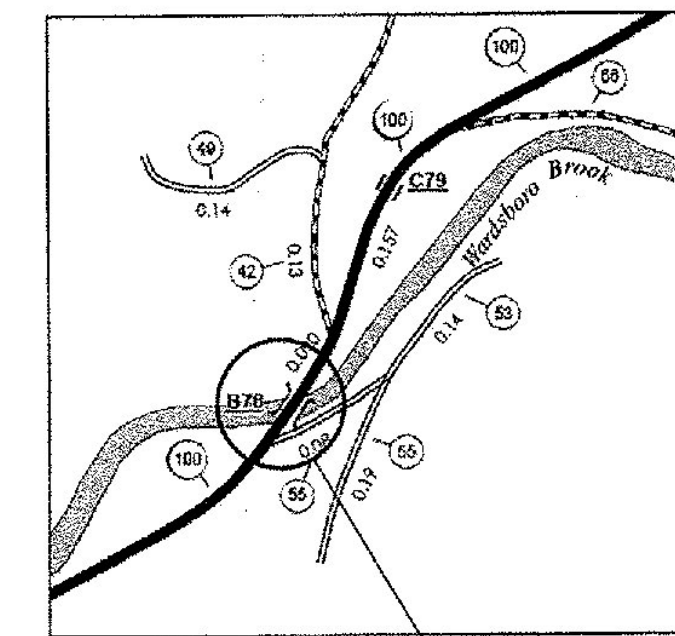


RECORD PLANS	
CONTRACTOR:	T. BUCK - AUBURN, ME.
RESIDENT ENGINEER:	CHAD GREENWOOD
CONSTRUCTION BEGAN:	APRIL 20, 2013
CONSTRUCTION COMPLETE:	JUNE 5, 2014
RECORD PLANS BY:	CHAD GREENWOOD & CRAIG PIERCE
I HEREBY CERTIFY THAT ALL THE CONSTRUCTION REQUIRED BY THIS SET OF DRAWINGS HAS BEEN ACCOMPLISHED AS INDICATED HEREIN.	
BY	RESIDENT ENGINEER
DATE <u>7/28/15</u>	
NOTE: Any further information concerning final quantities, amounts or other details relative to this project may be found at Central Files in the electronic archives.	

ROUTE NO : VT 100 (MINOR ARTERIAL) BRIDGE NO : 78
 PROJECT LOCATION : LOCATED APPROXIMATELY 1.5 MILES SOUTH OF THE JUNCTION OF VT ROUTE 100 AND VT ROUTE 30.

PROJECT DESCRIPTION : REPLACE EXISTING BRIDGE WITH RELATED ROADWAY APPROACH AND CHANNEL WORK.

LENGTH OF STRUCTURE : 241.78 FEET.
 LENGTH OF ROADWAY : 58.22 FEET.
 LENGTH OF PROJECT : 300.00 FEET.

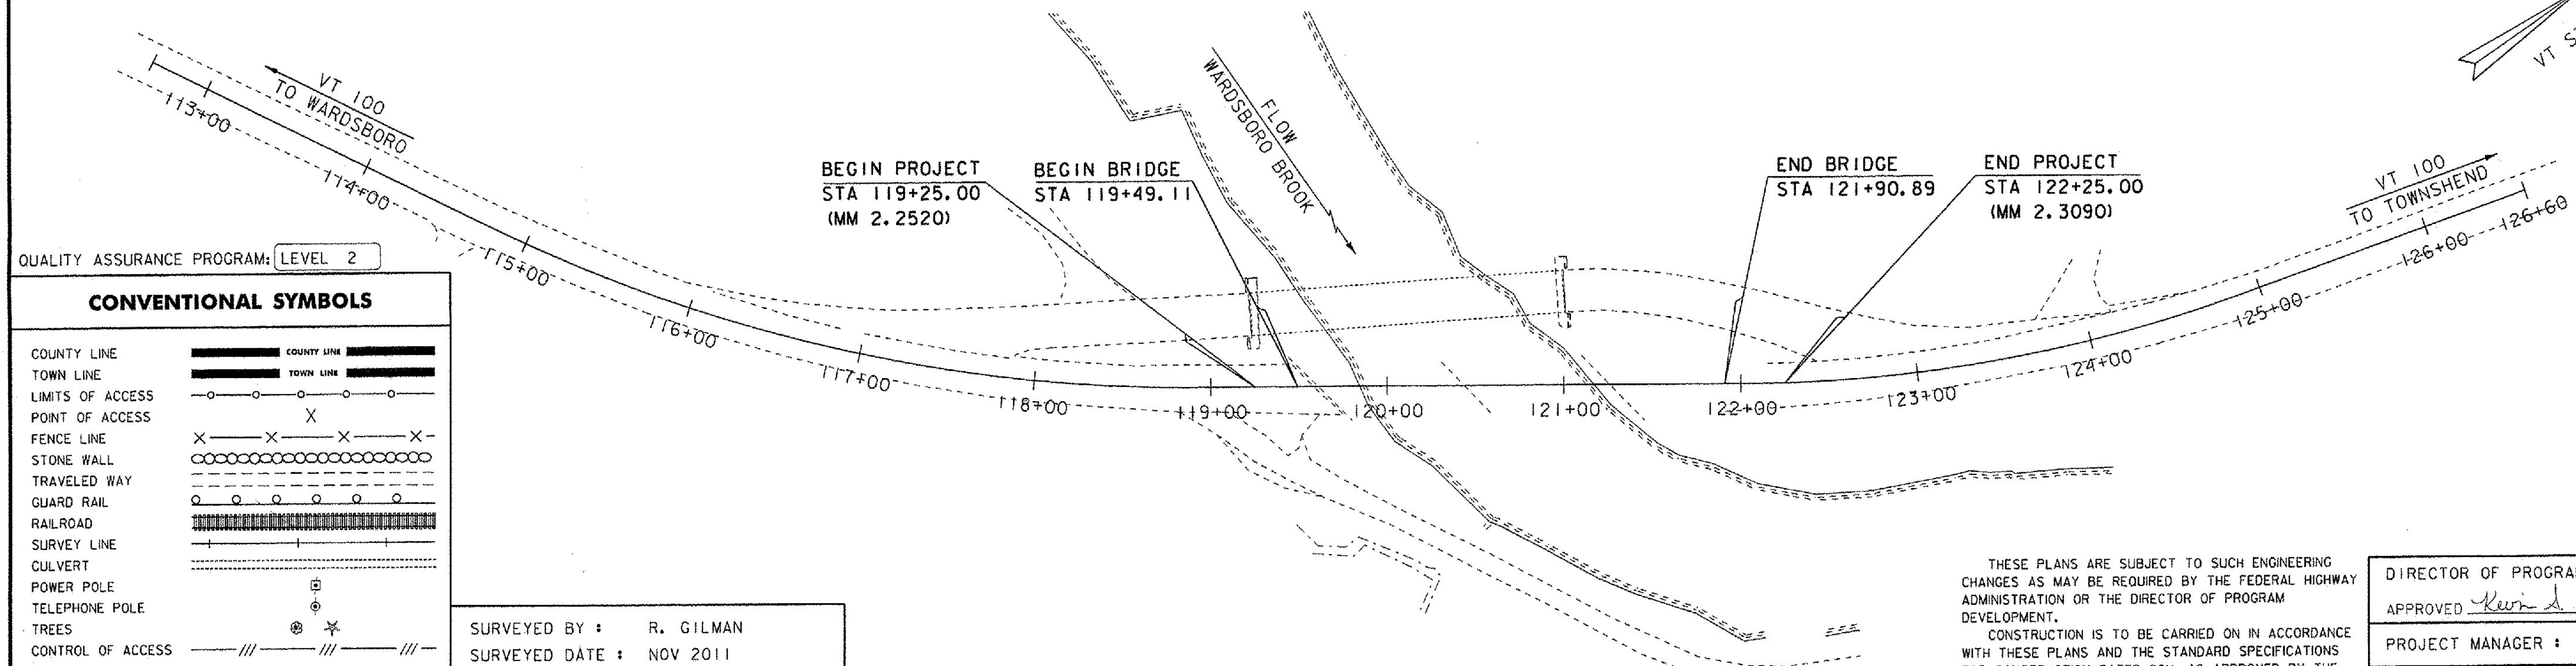

QUALITY ASSURANCE PROGRAM: LEVEL 2

CONVENTIONAL SYMBOLS	
COUNTY LINE	
TOWN LINE	
LIMITS OF ACCESS	
POINT OF ACCESS	
FENCE LINE	
STONE WALL	
TRAVELED WAY	
GUARD RAIL	
RAILROAD	
SURVEY LINE	
CULVERT	
POWER POLE	
TELEPHONE POLE	
TREES	
CONTROL OF ACCESS	
PROPERTY LINE	
R.O.W. TAKING LINE	
SLOPE RIGHTS	
TOP OF CUT	
TOE OF SLOPE	

SURVEYED BY : R. GILMAN
 SURVEYED DATE : NOV 2011

DATUM
 VERTICAL NAVD 88
 HORIZONTAL NAD 83 (92)

SCALE 1" = 50'-0"

THESE PLANS ARE SUBJECT TO SUCH ENGINEERING CHANGES AS MAY BE REQUIRED BY THE FEDERAL HIGHWAY ADMINISTRATION OR THE DIRECTOR OF PROGRAM DEVELOPMENT.
 CONSTRUCTION IS TO BE CARRIED ON IN ACCORDANCE WITH THESE PLANS AND THE STANDARD SPECIFICATIONS FOR CONSTRUCTION DATED 2011, AS APPROVED BY THE FEDERAL HIGHWAY ADMINISTRATION ON JULY 20, 2011 FOR USE ON THIS PROJECT, INCLUDING ALL SUBSEQUENT REVISIONS AND SUCH REVISED SPECIFICATIONS AND SPECIAL PROVISIONS AS ARE INCORPORATED IN THESE PLANS.

DIRECTOR OF PROGRAM DEVELOPMENT	
APPROVED	DATE <u>10/12/12</u>
PROJECT MANAGER :	KRISTIN HIGGINS
PROJECT NAME :	JAMAICA
PROJECT NUMBER :	ER-BRF 013-1 (16)
SHEET 1 OF 85 SHEETS	

