


* 5 1/2" SUPERPAVE BITUMINOUS CONCRETE PAVEMENT
 1 1/2" TYPE IVS OVER
 1 1/2" TYPE IVS OVER
 2 1/2" TYPE IIS
 24" SUBBASE OPTION

ROADWAY TYPICAL

SCALE 1/2" = 1'-0"

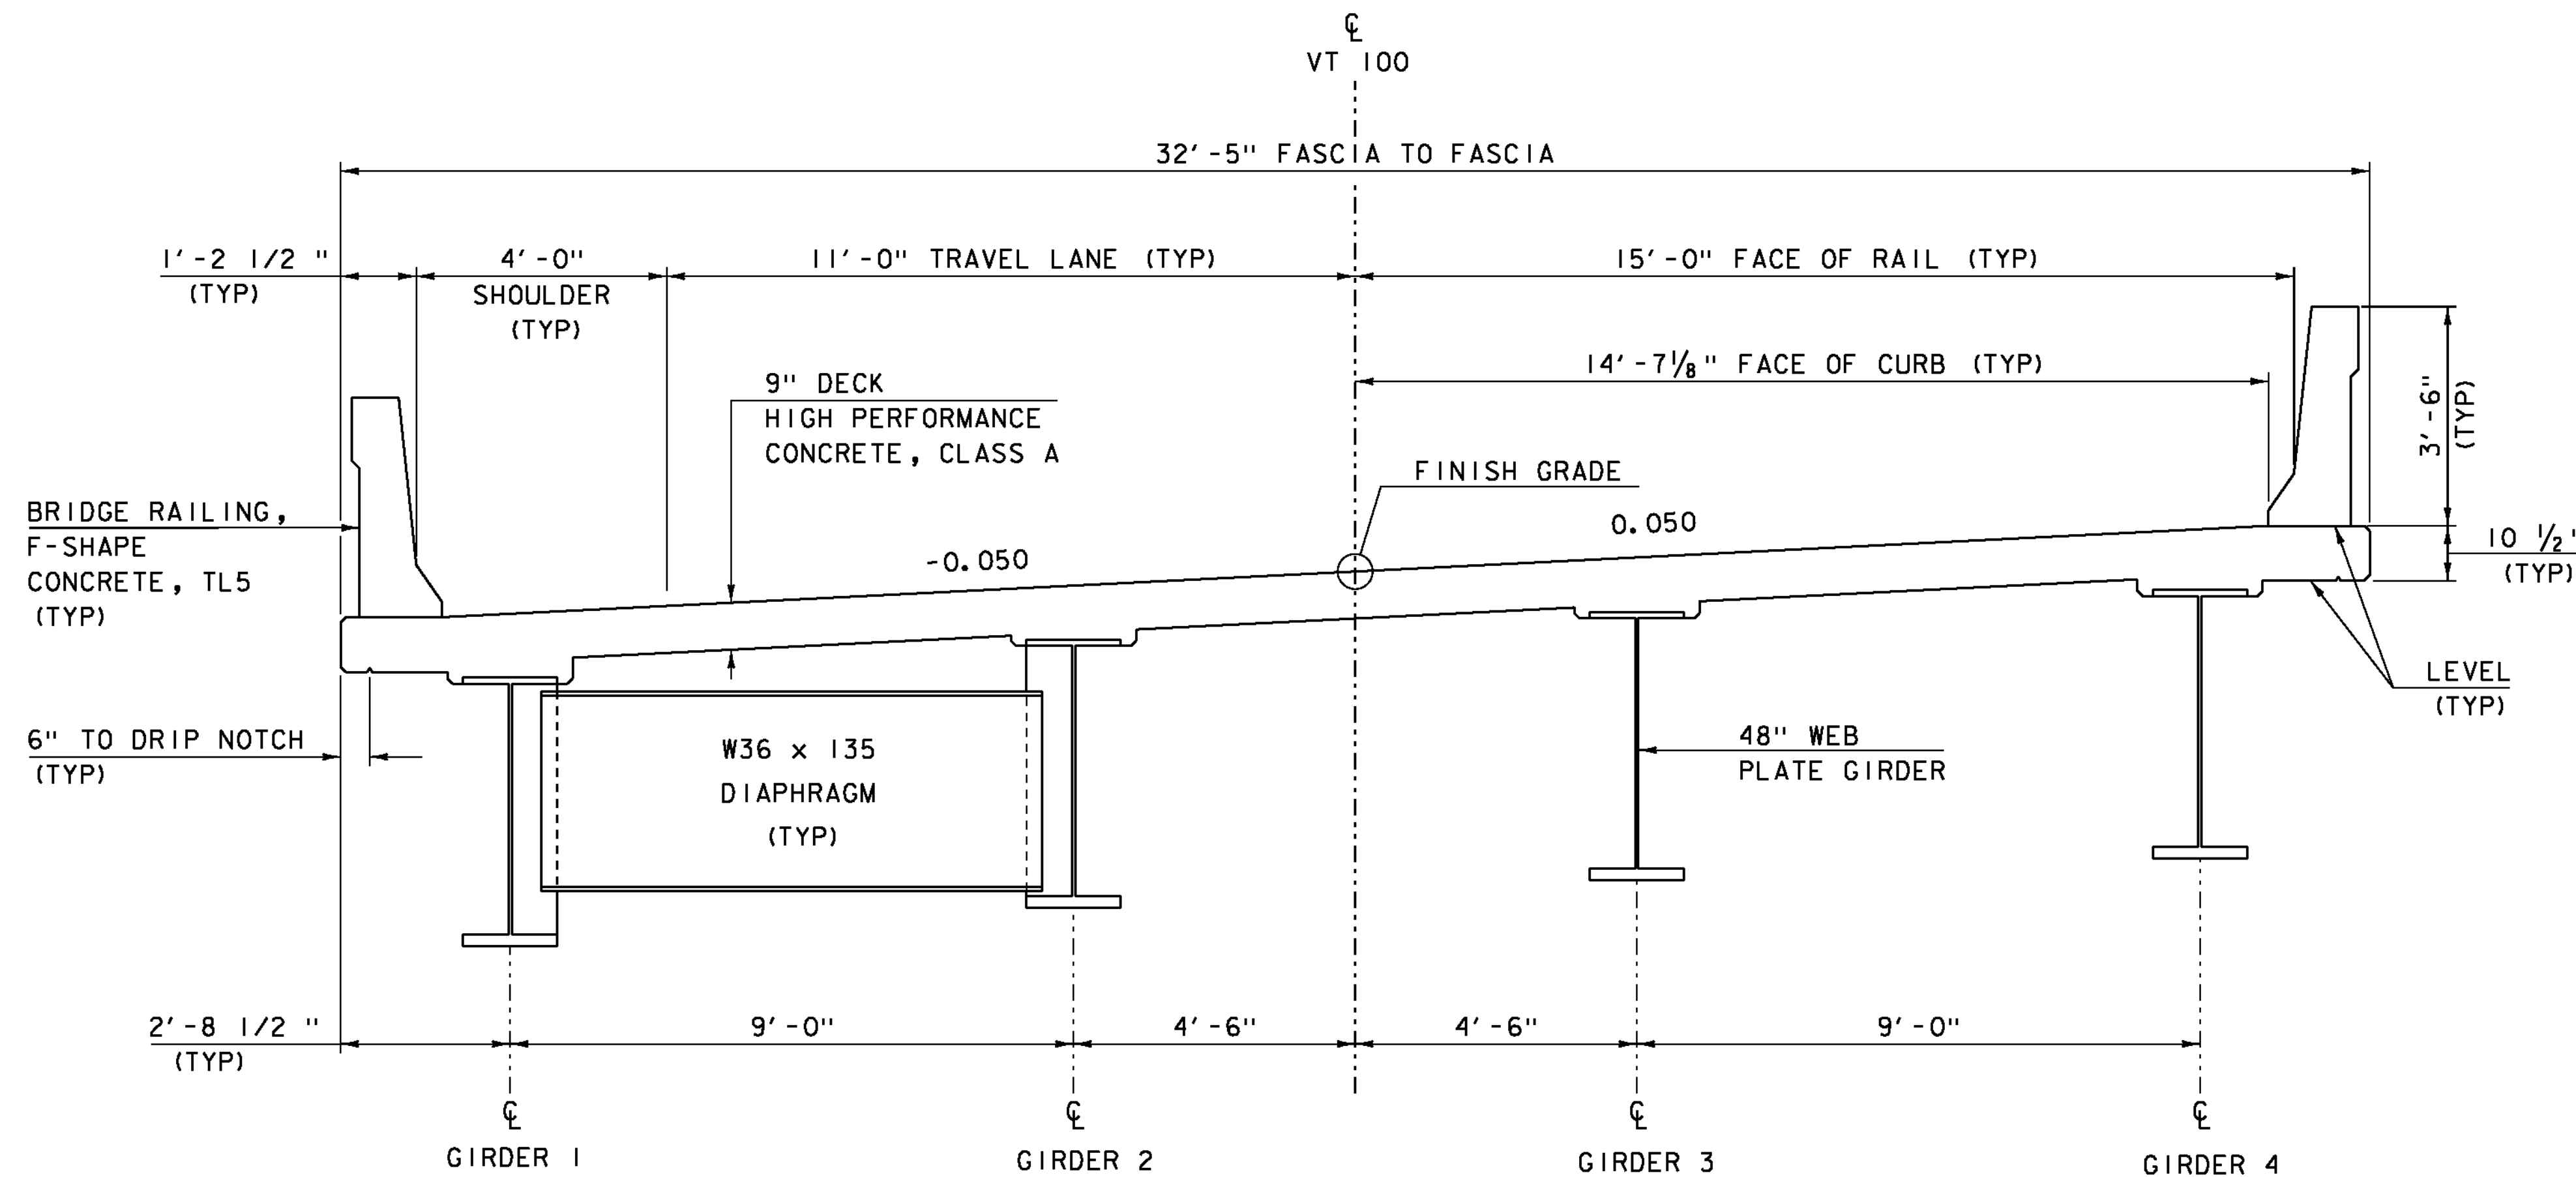

BRIDGE TYPICAL

SCALE 1/2" = 1'-0"

MATERIAL TOLERANCES

(IF USED ON PROJECT)

SURFACE	
- PAVEMENT (TOTAL THICKNESS)	+/- 1/4"
- AGGREGATE SURFACE COURSE	+/- 1/2"
SUBBASE	
	+/- 1"
SAND BORROW	
	+/- 1"

PROJECT NAME: JAMAICA
 PROJECT NUMBER: ER-BRF 013-1(16)

FILE NAME: s1lb212+yp.dgn
 PROJECT LEADER: K. HIGGINS
 DESIGNED BY: G. LAROCHE
 TYPICAL SECTIONS 1

PLOT DATE: 12-OCT-2012
 DRAWN BY: K. FRIEDLAND
 CHECKED BY: G. LAROCHE
 SHEET 8 OF 85