
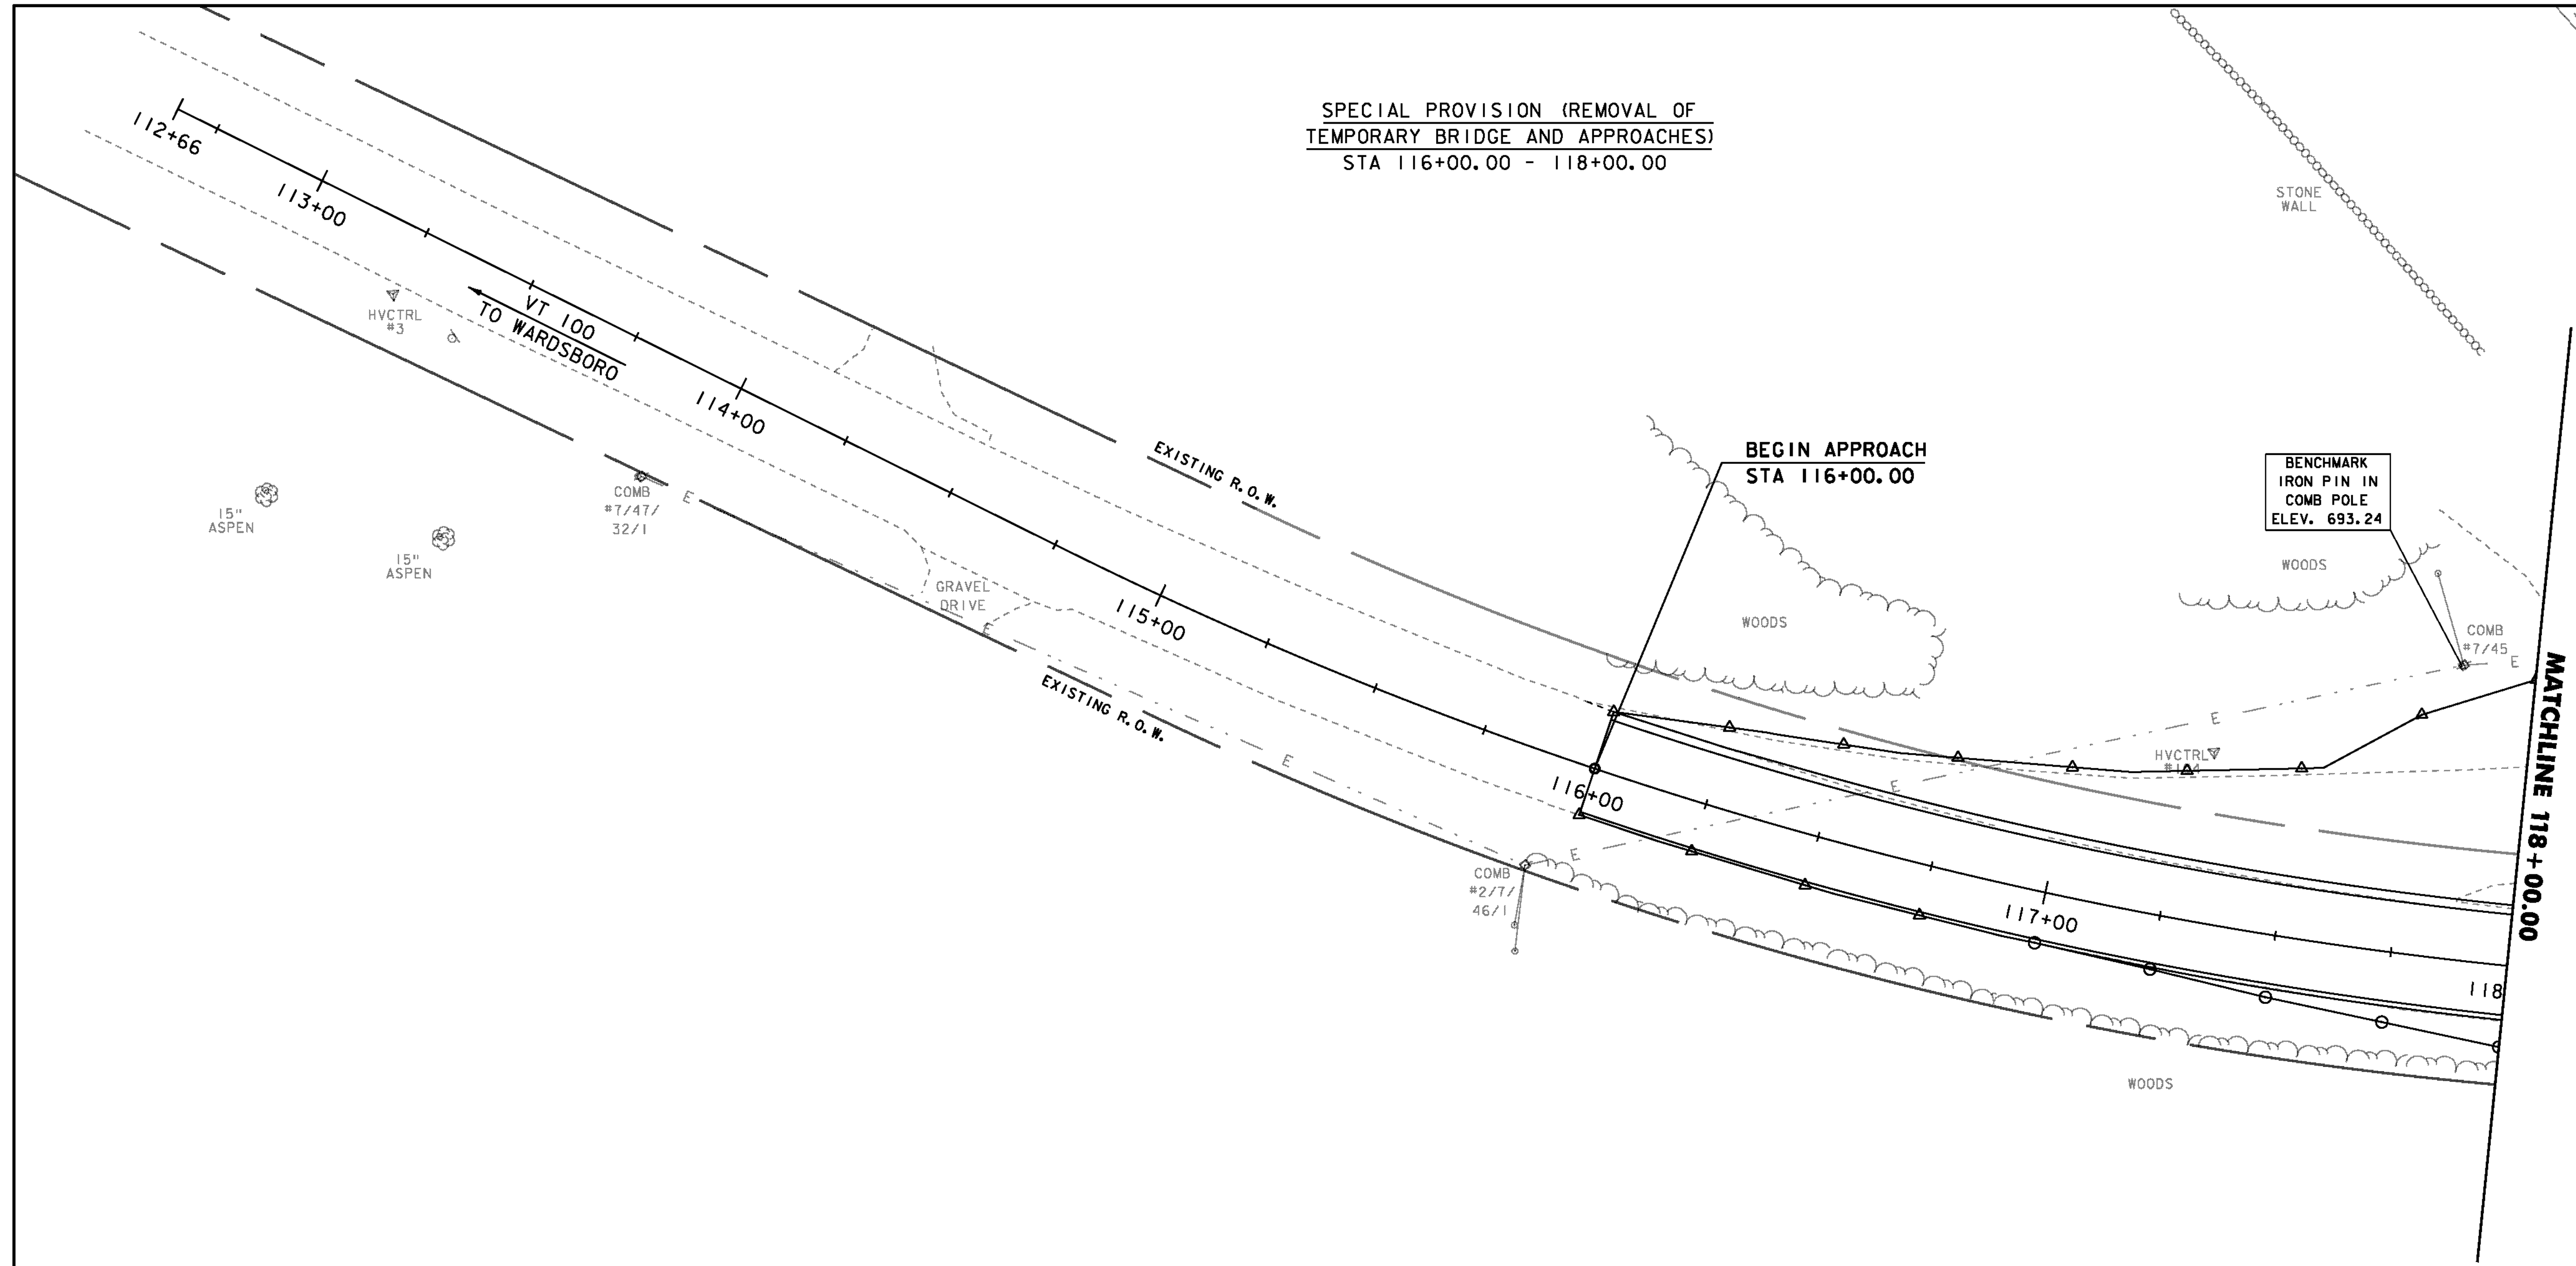


SPECIAL PROVISION (REMOVAL OF
 TEMPORARY BRIDGE AND APPROACHES)
 STA 116+00.00 - 118+00.00

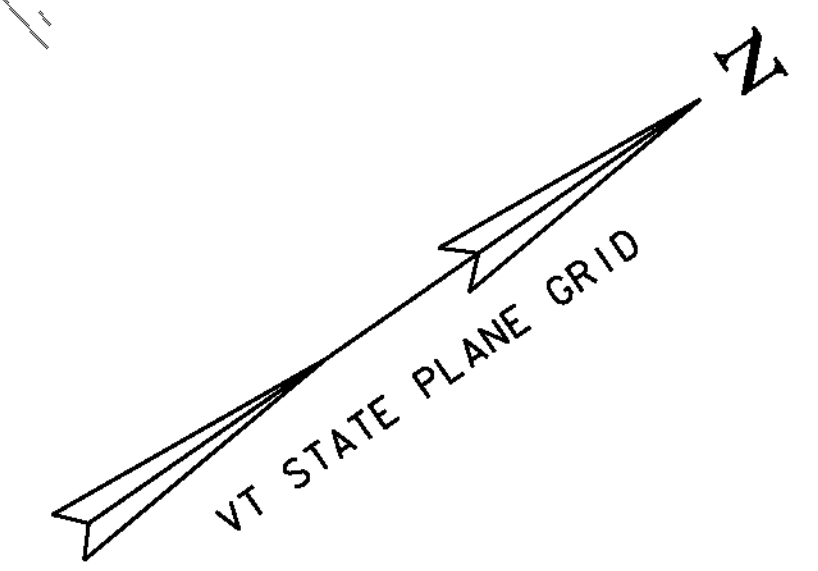

LAYOUT I

SCALE 1" = 20'-0"
 20 0 20

PROJECT NAME:	JAMAICA	PLOT DATE:	12-OCT-2012
PROJECT NUMBER:	ER-BRF 013-1(16)	DRAWN BY:	K. FRIEDLAND
FILE NAME:	s11b212bdr.dgn	CHECKED BY:	G. LAROCHE
PROJECT LEADER:	K. HIGGINS	SHEET	12 OF 85
DESIGNED BY:	G. LAROCHE	LAYOUT I	