


MAINLINE PROFILE 2

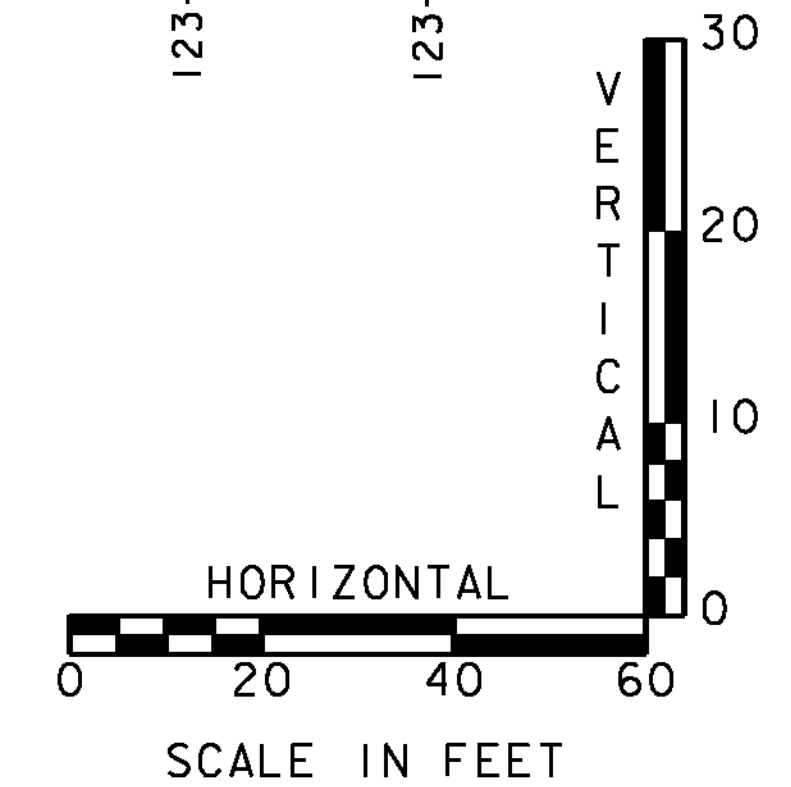

GRADES SHOWN TO THE NEAREST
 TENTH ARE EXISTING GROUND
 GRADES SHOWN TO THE NEAREST
 HUNDREDTH ARE FINISH GRADE

PROJECT NAME: JAMIACA
 PROJECT NUMBER: ER-BRF 013-1(16)

FILE NAME: s11b212pro.dgn
 PROJECT LEADER: K. HIGGINS
 DESIGNED BY: G. LAROCHE
 MAINLINE PROFILE 2
 PLOT DATE: 12-OCT-2012
 DRAWN BY: K. FRIEDLAND
 CHECKED BY: G. LAROCHE
 SHEET 16 OF 85