


MAINLINE PROFILE 3

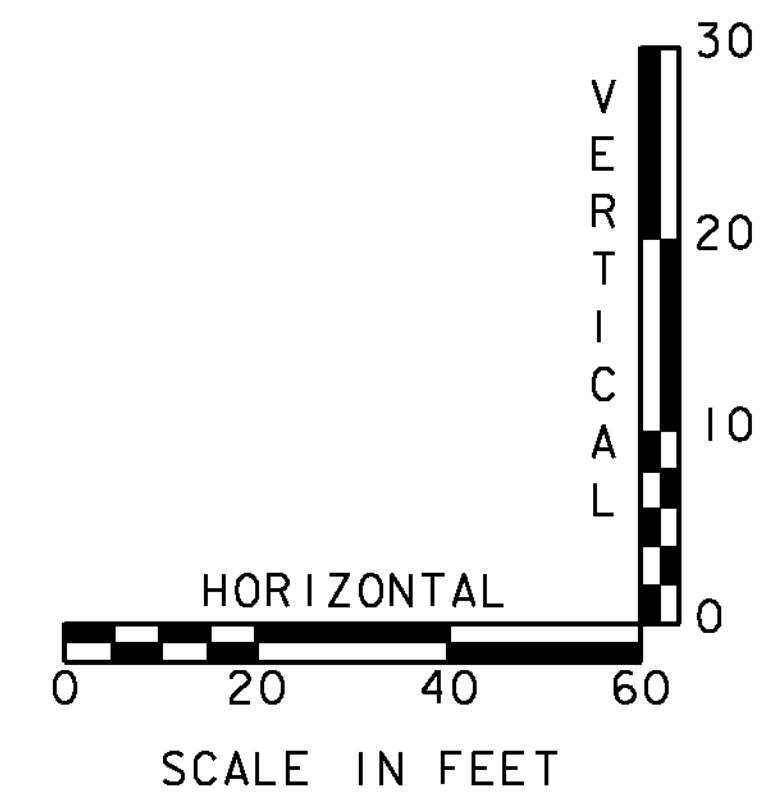

GRADES SHOWN TO THE NEAREST TENTH ARE EXISTING GROUND
 GRADES SHOWN TO THE NEAREST HUNDREDTH ARE FINISH GRADE

PROJECT NAME: JAMIACA	PLOT DATE: 12-OCT-2012
PROJECT NUMBER: ER-BRF 013-1(16)	DRAWN BY: K. FRIEDLAND
FILE NAME: s11b212pro.dgn	CHECKED BY: G. LAROCHE
PROJECT LEADER: K. HIGGINS	SHEET 17 OF 85
DESIGNED BY: G. LAROCHE	
MAINLINE PROFILE 3	