



APPROACH SLAB #1 PLAN

SCALE 1/4" = 1'-0"

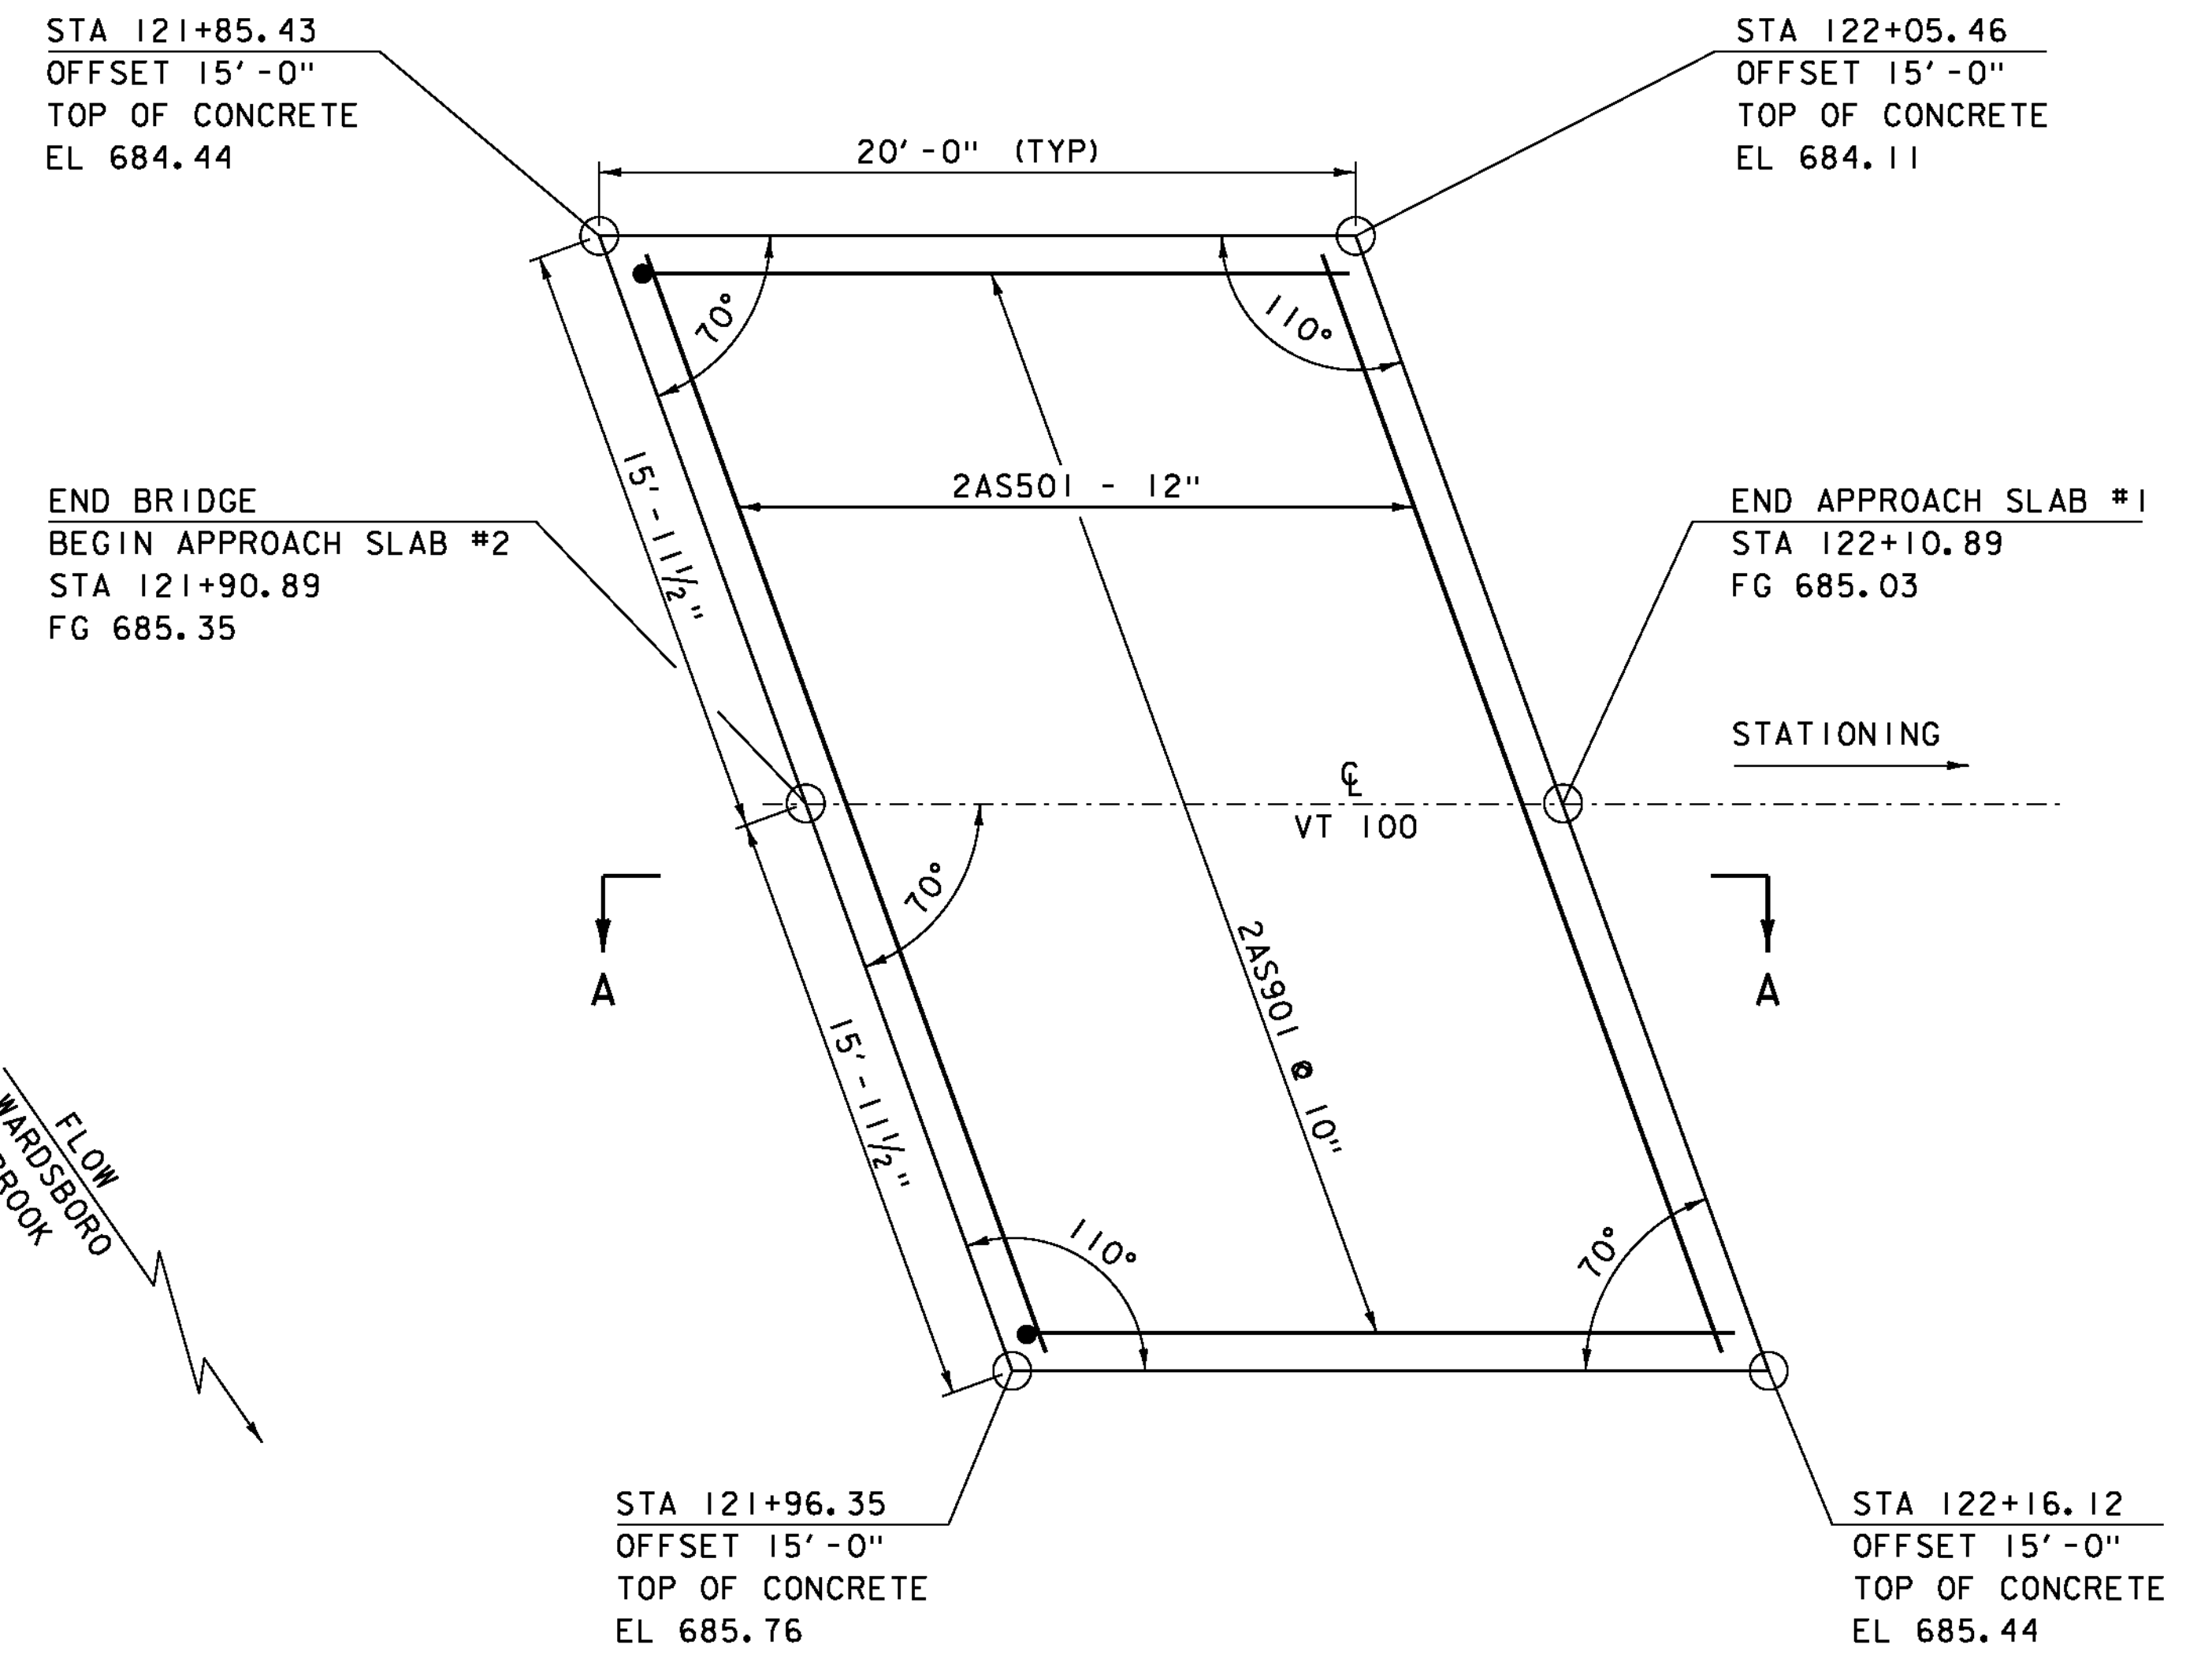

APPROACH SLAB #2 PLAN

SCALE 1/4" = 1'-0"

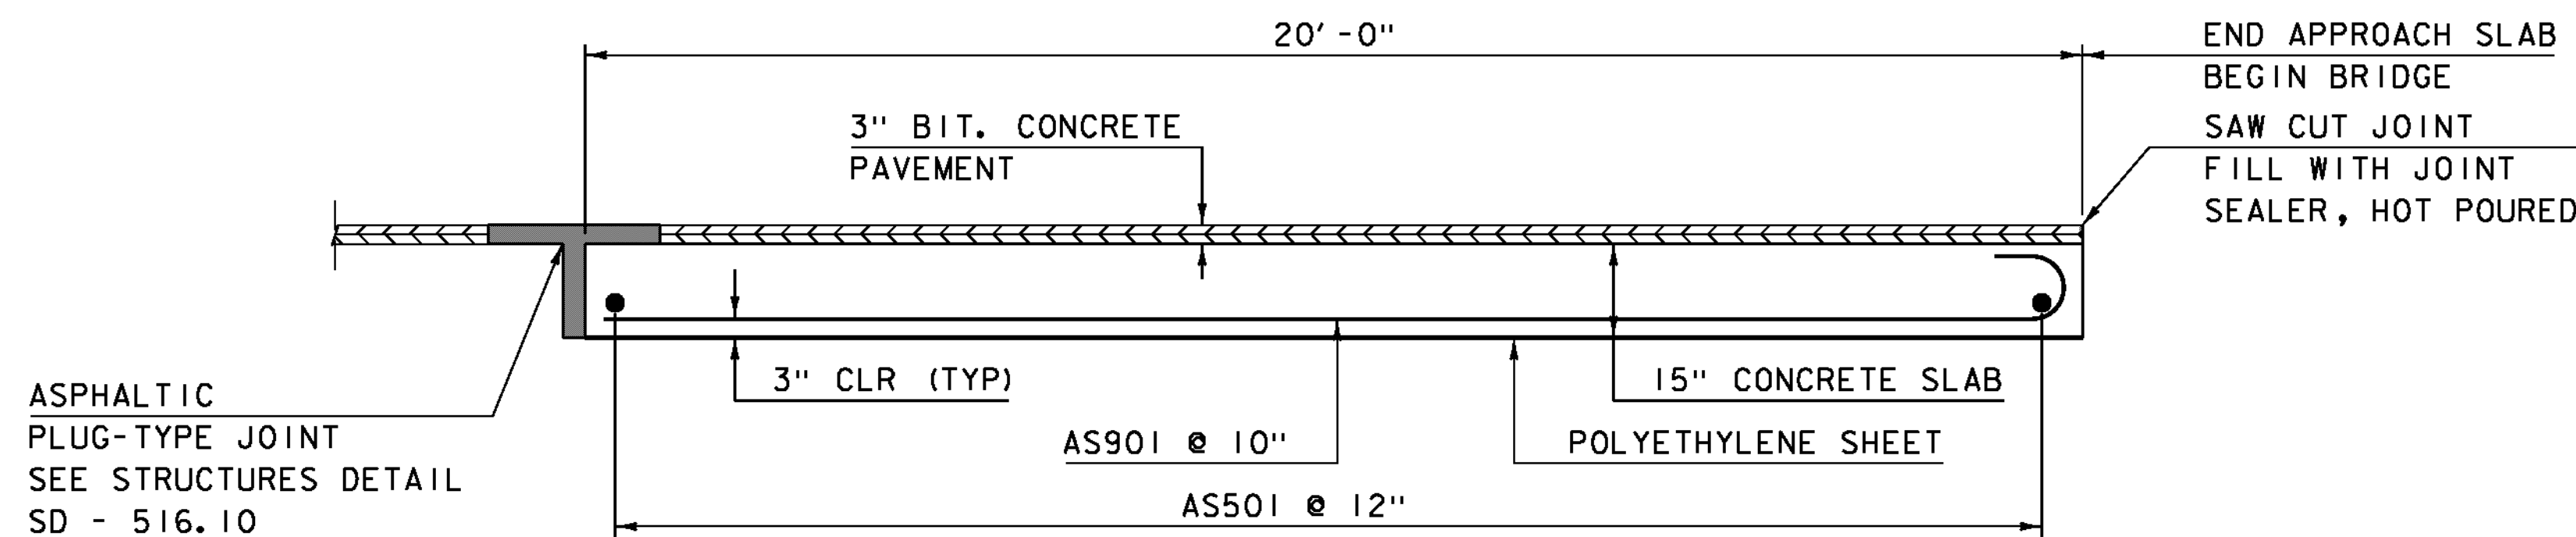

**SECTION A-A
APPROACH SLAB ELEVATION**

SCALE 1/4" = 1'-0"

NOTE:

- NF = NEAR FACE
- FF = FAR FACE
- EF = EACH FACE
- ▲ = CUT TO FIT IN FIELD
- 3" CLEAR, UNLESS OTHERWISE SPECIFIED ON THE PLANS.
- 3'-0" BAR LAP UNLESS OTHERWISE SPECIFIED ON THE PLANS.

PROJECT NAME:	JAMAICA	PLOT DATE:	12-OCT-2012
PROJECT NUMBER:	ER-BRF 013-1 (16)	DRAWN BY:	K. FRIEDLAND
FILE NAME:	s1lb212sup.dgn	CHECKED BY:	J. SALVATORI
PROJECT LEADER:	K. HIGGINS	APPROACH SLAB DETAILS	SHEET 33 OF 85
DESIGNED BY:	K. FRIEDLAND		