


RETAINING WALL LAYOUT
SCALE 1/4" = 1'-0"



RETAINING WALL ELEVATION
SCALE 1/4" = 1'-0"

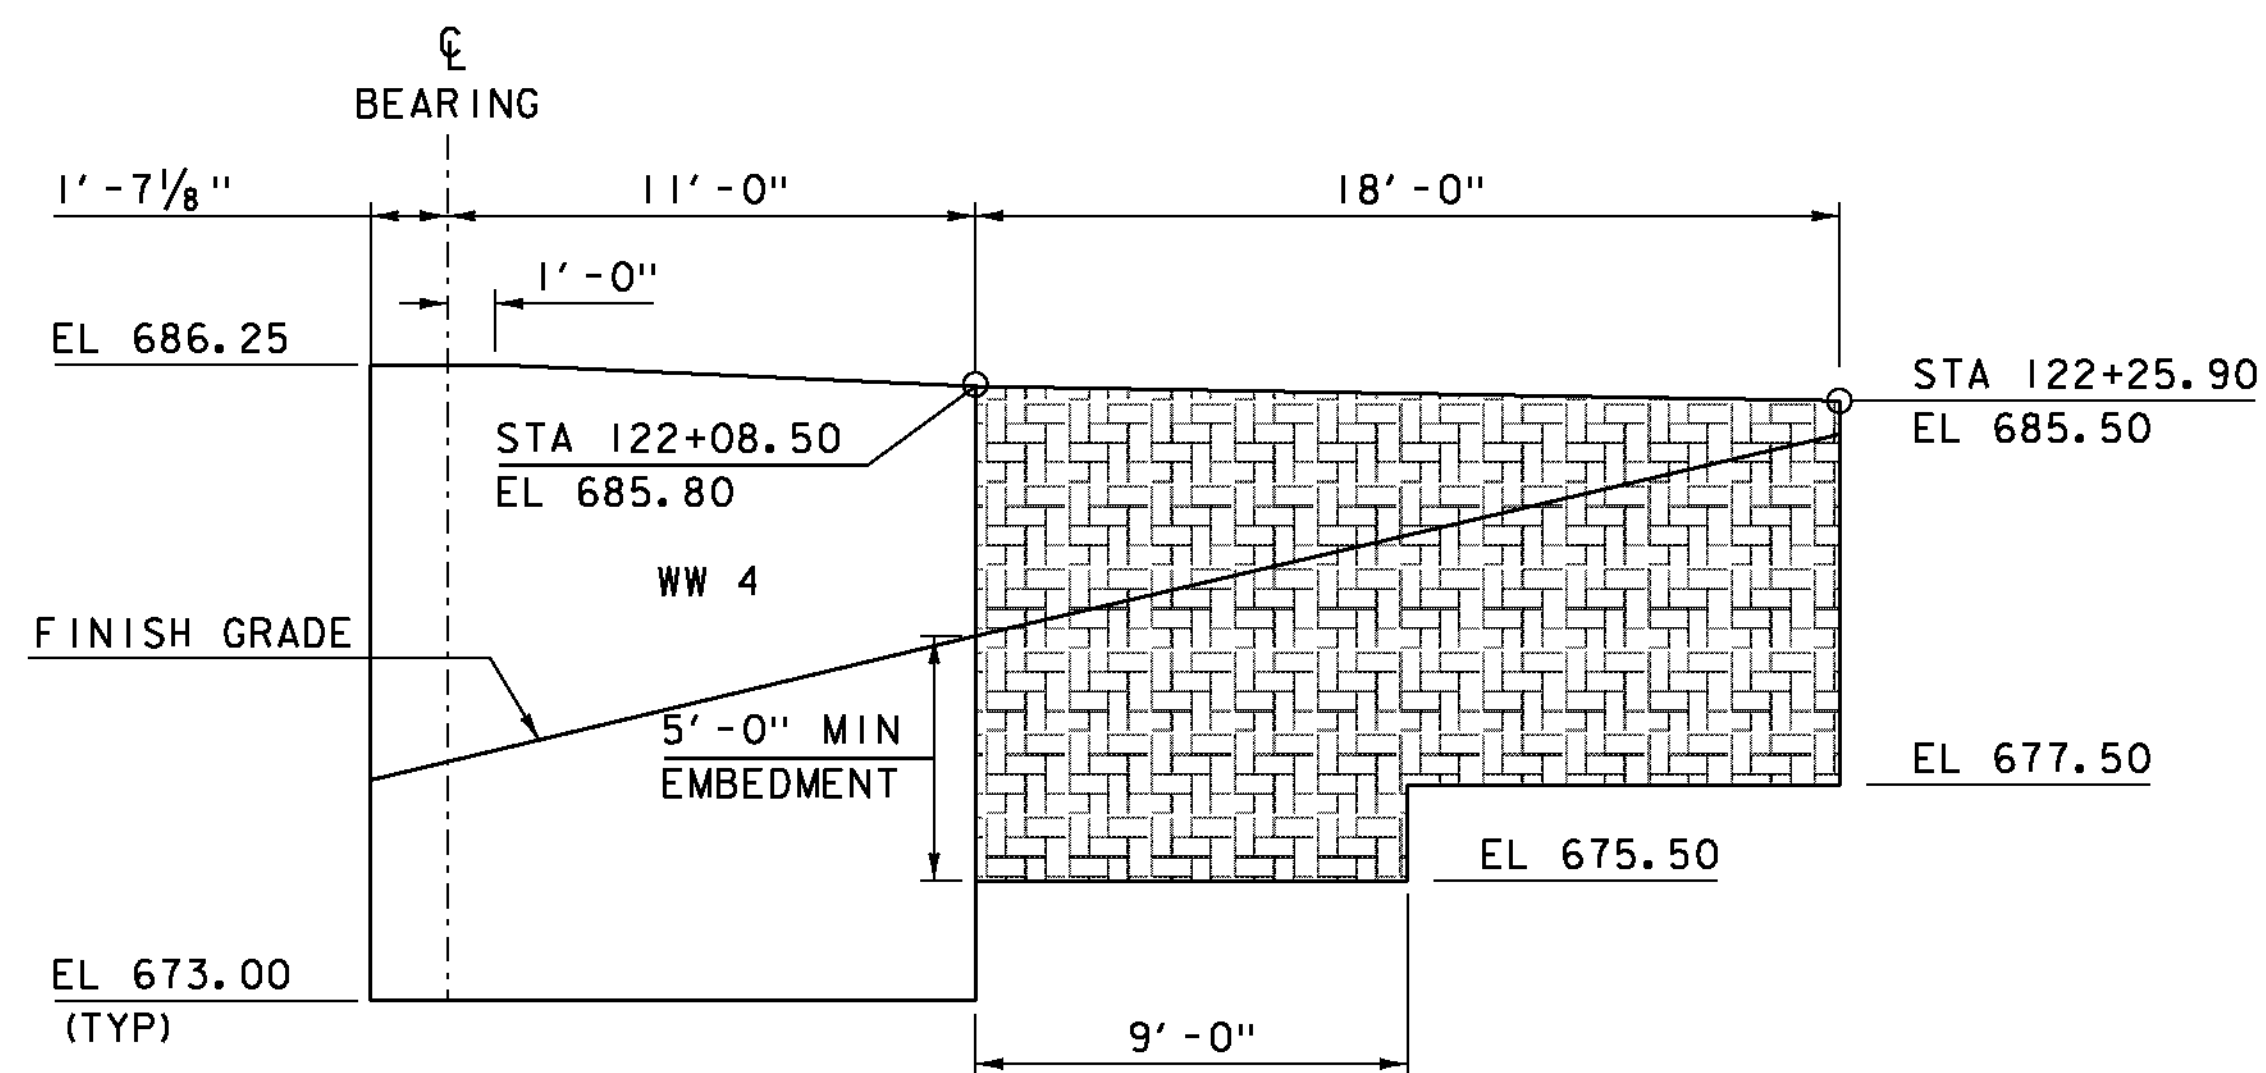

PROJECT NAME: JAMAICA
PROJECT NUMBER: ER-BRF 013-1 (16)

FILE NAME: s11b212sub.dgn
PROJECT LEADER: VTRANS
DESIGNED BY: K. KRETSCH
RETAINING WALL

PLOT DATE: 12-OCT-2012
DRAWN BY: VTRANS
CHECKED BY: G. GOODRICH
SHEET 37 OF 85