


FINAL CONDITIONS SHEET 1

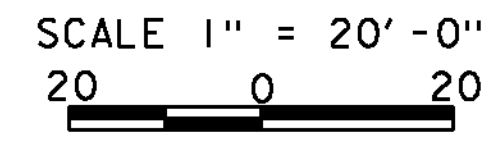


**AREAS OF EARTH DISTURBANCE THAT WILL REQUIRE REVEGETATION.**

PROJECT NAME:	JAMAICA	PLOT DATE:	12-OCT-2012
PROJECT NUMBER:	ER-BRF 013-1(16)	DRAWN BY:	K. FRIEDLAND
FILE NAME:	s11b212ero_final.dgn	CHECKED BY:	G. LAROCHE
PROJECT LEADER:	K. HIGGINS	FINAL CONDITIONS SHEET 1	SHEET 53 OF 85