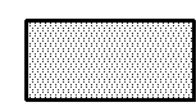


FINAL CONDITIONS SHEET 2

SCALE 1" = 20' - 0"
 20 0 20

 AREAS OF EARTH DISTURBANCE THAT WILL REQUIRE REVEGETATION.

| | | | |
|-----------------|---------------------|--------------------------|----------------|
| PROJECT NAME: | JAMAICA | PLOT DATE: | 12-OCT-2012 |
| PROJECT NUMBER: | ER-BRF 013-1(16) | DRAWN BY: | K. FRIEDLAND |
| FILE NAME: | s1b212ero_final.dgn | CHECKED BY: | G. LAROCHE |
| PROJECT LEADER: | K. HIGGINS | FINAL CONDITIONS SHEET 2 | SHEET 54 OF 85 |
| DESIGNED BY: | G. LAROCHE | | |