


**MATERIAL TRANSITION I**

HOR. SCALE 1" = 20'-0"  
NO VERT. SCALE

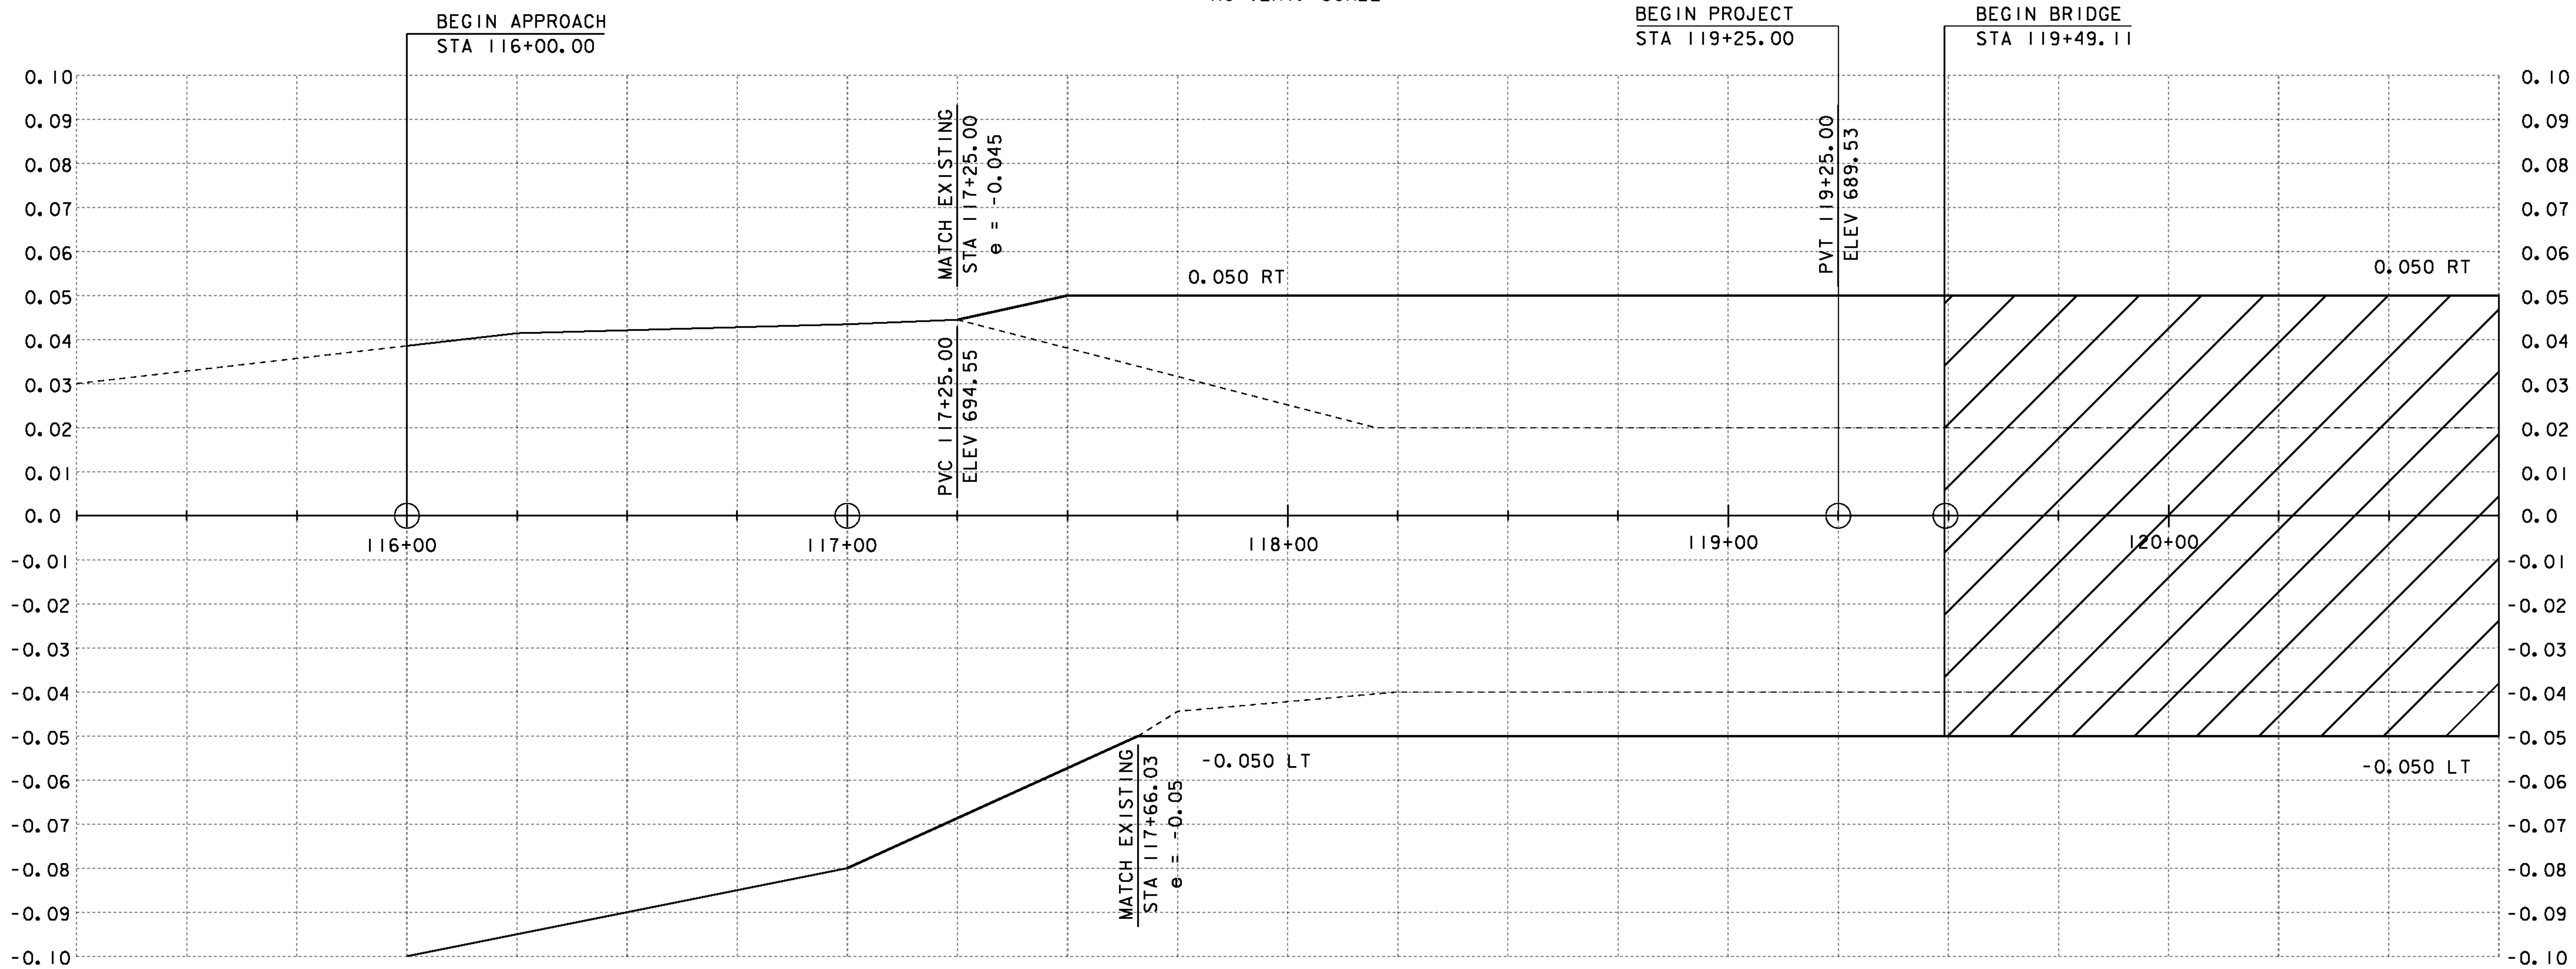

**BANKING DIAGRAM I**

HOR. SCALE 1" = 20'-0"  
NO VERT. SCALE

PROJECT NAME: JAMIACA  
PROJECT NUMBER: ER-BRF 013-1(16)

FILE NAME: s11b212pro.dgn PLOT DATE: 12-OCT-2012  
PROJECT LEADER: K. HIGGINS DRAWN BY: K. FRIEDLAND  
DESIGNED BY: G. LAROCHE CHECKED BY: G. LAROCHE  
MATERIAL TRANSITION / BANKING DIAGRAM I SHEET 59 OF 85