


MATERIAL TRANSITION 2

HOR. SCALE 1" = 20'-0"
NO VERT. SCALE

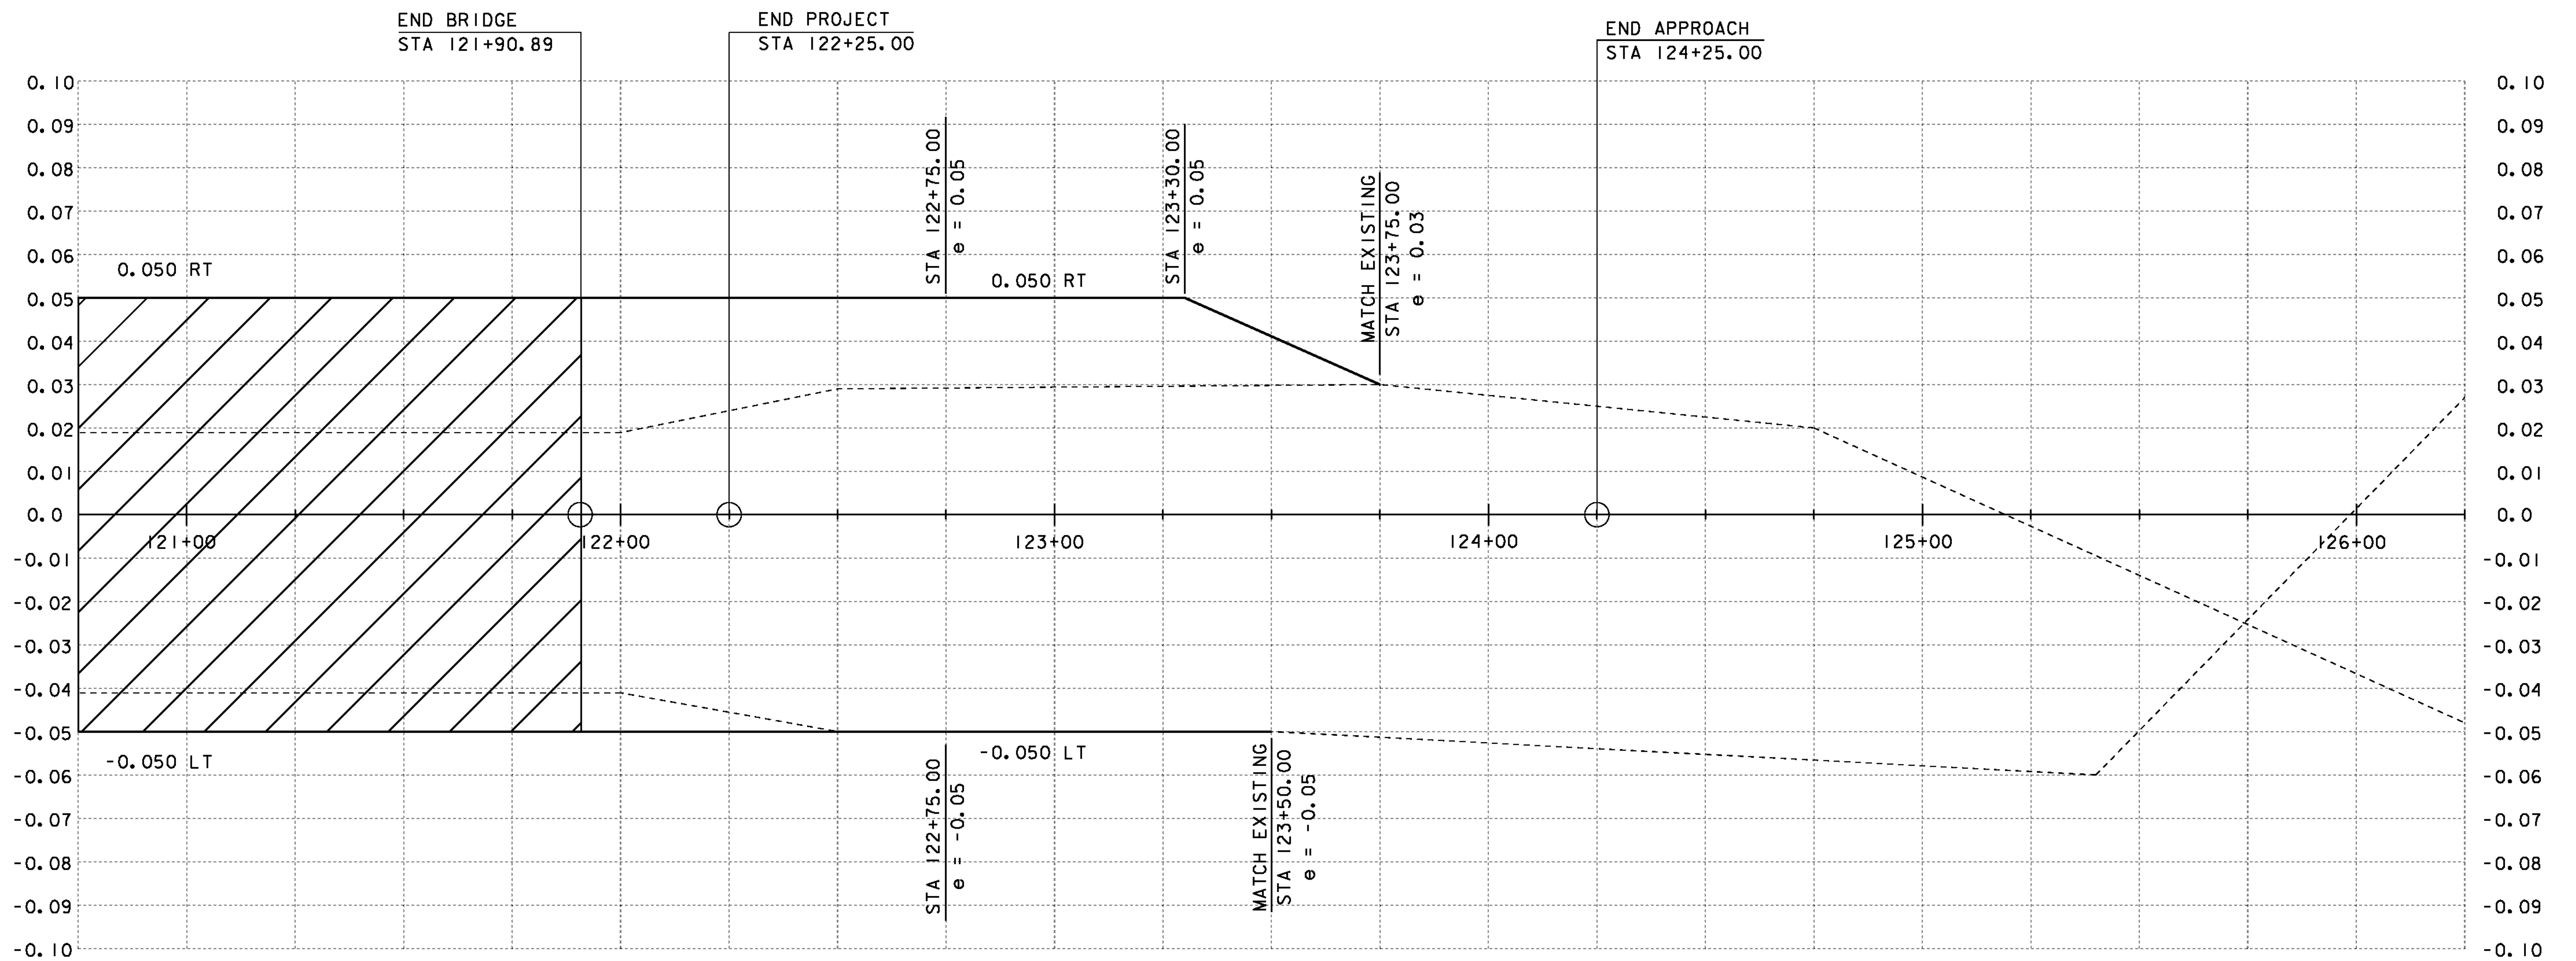

BANKING DIAGRAM 2

HORITONTAL SCALE 1" = 20'-0"
VERTICAL NOT TO SCALE

PROJECT NAME: JAMIACA
PROJECT NUMBER: ER-BRF 013-1(16)

FILE NAME: s1lb212pro.dgn PLOT DATE: 12-OCT-2012
PROJECT LEADER: K. HIGGINS DRAWN BY: K. FRIEDLAND
DESIGNED BY: G. LAROCHE CHECKED BY: G. LAROCHE
MATERIAL TRANSITION / BANKING DIAGRAM 2 SHEET 60 OF 85