




116+25

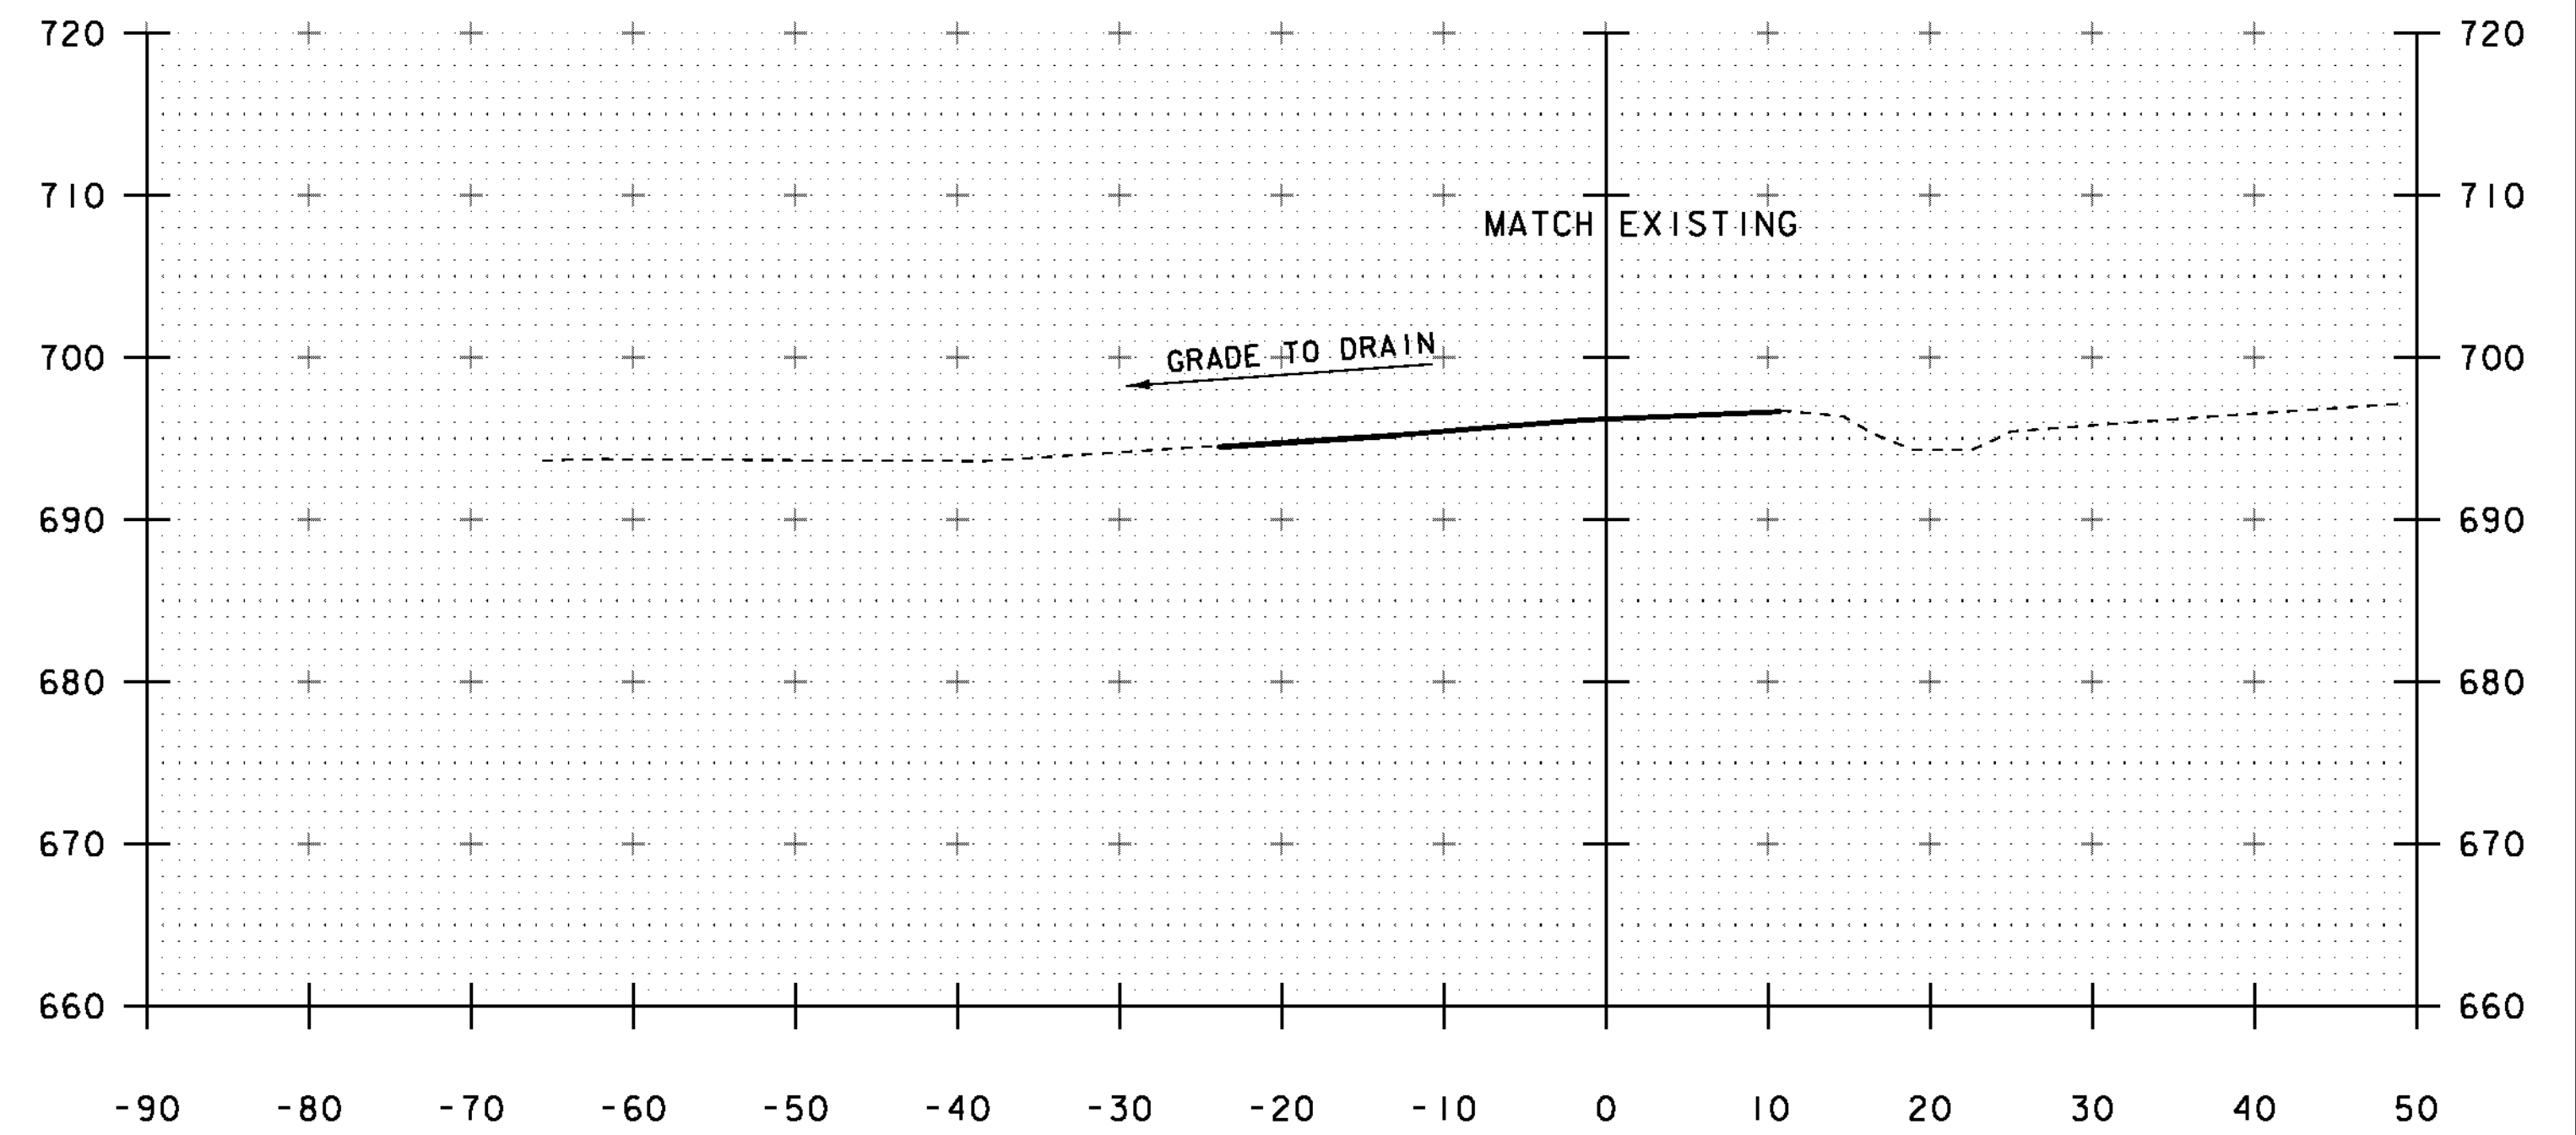


116+75

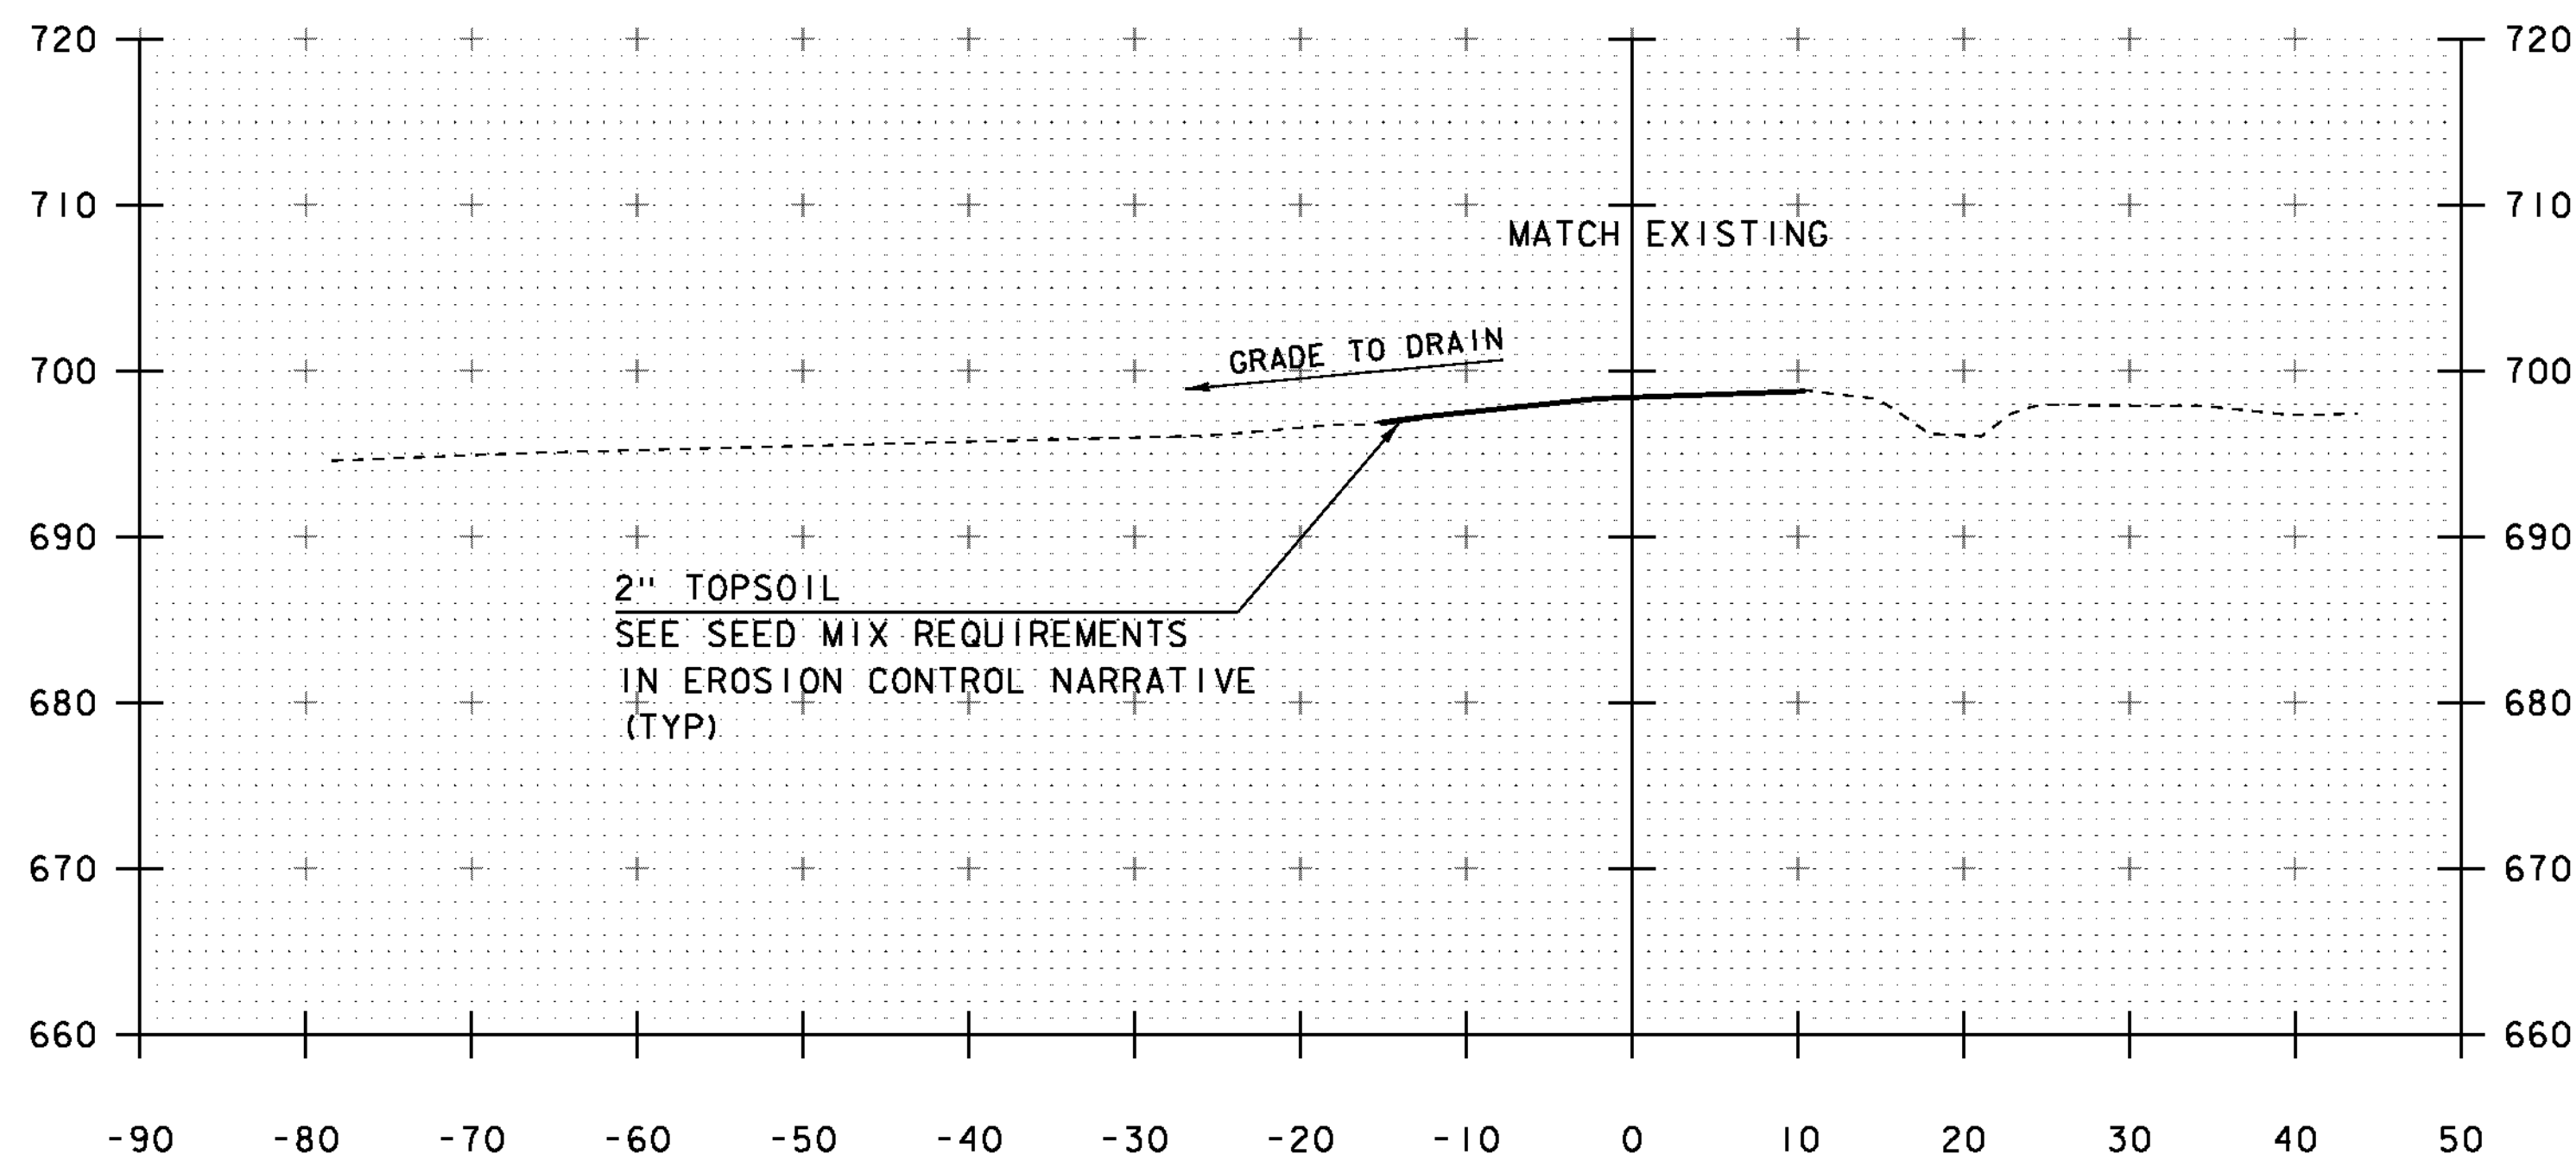

116+00
BEGIN APPROACH

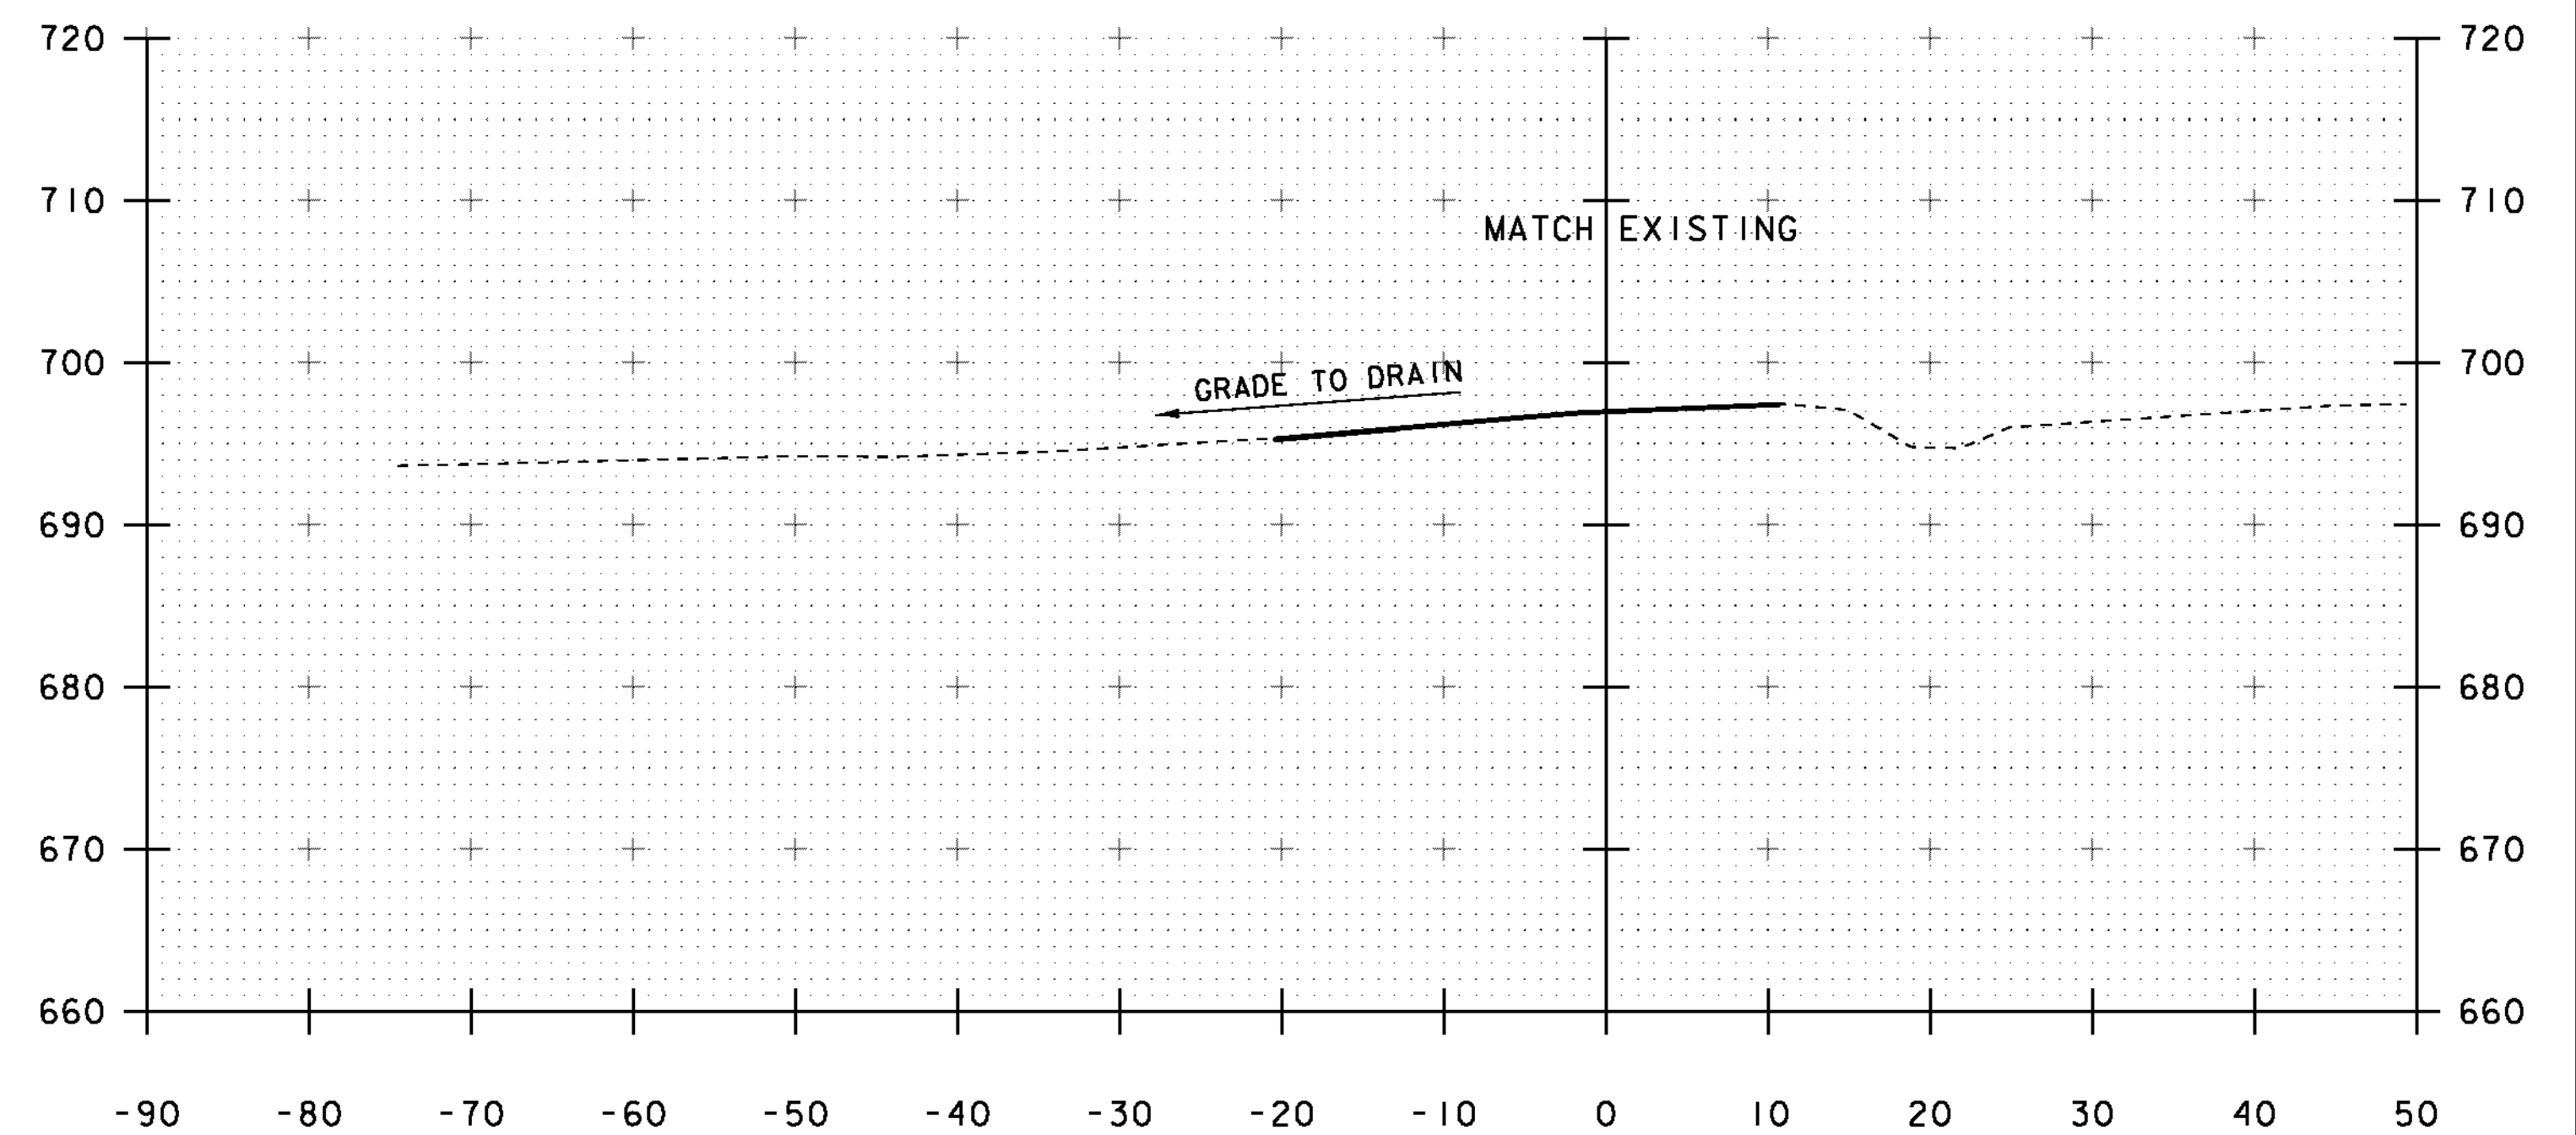

116+50

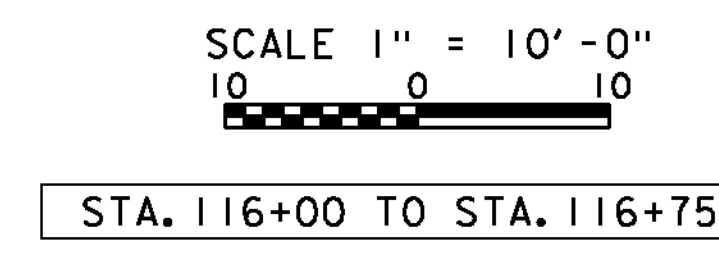

STA. 116+00 TO STA. 116+75

PROJECT NAME: JAMAICA	
PROJECT NUMBER: ER-BRF 013-1(16)	
FILE NAME: s11b212xs.dgn	PLOT DATE: 12-OCT-2012
PROJECT LEADER: K. HIGGINS	DRAWN BY: K. FRIEDLAND
DESIGNED BY: G. LAROCHE	CHECKED BY: G. LAROCHE
MAINLINE CROSS SECTION 1	SHEET 61 OF 85