




118+25

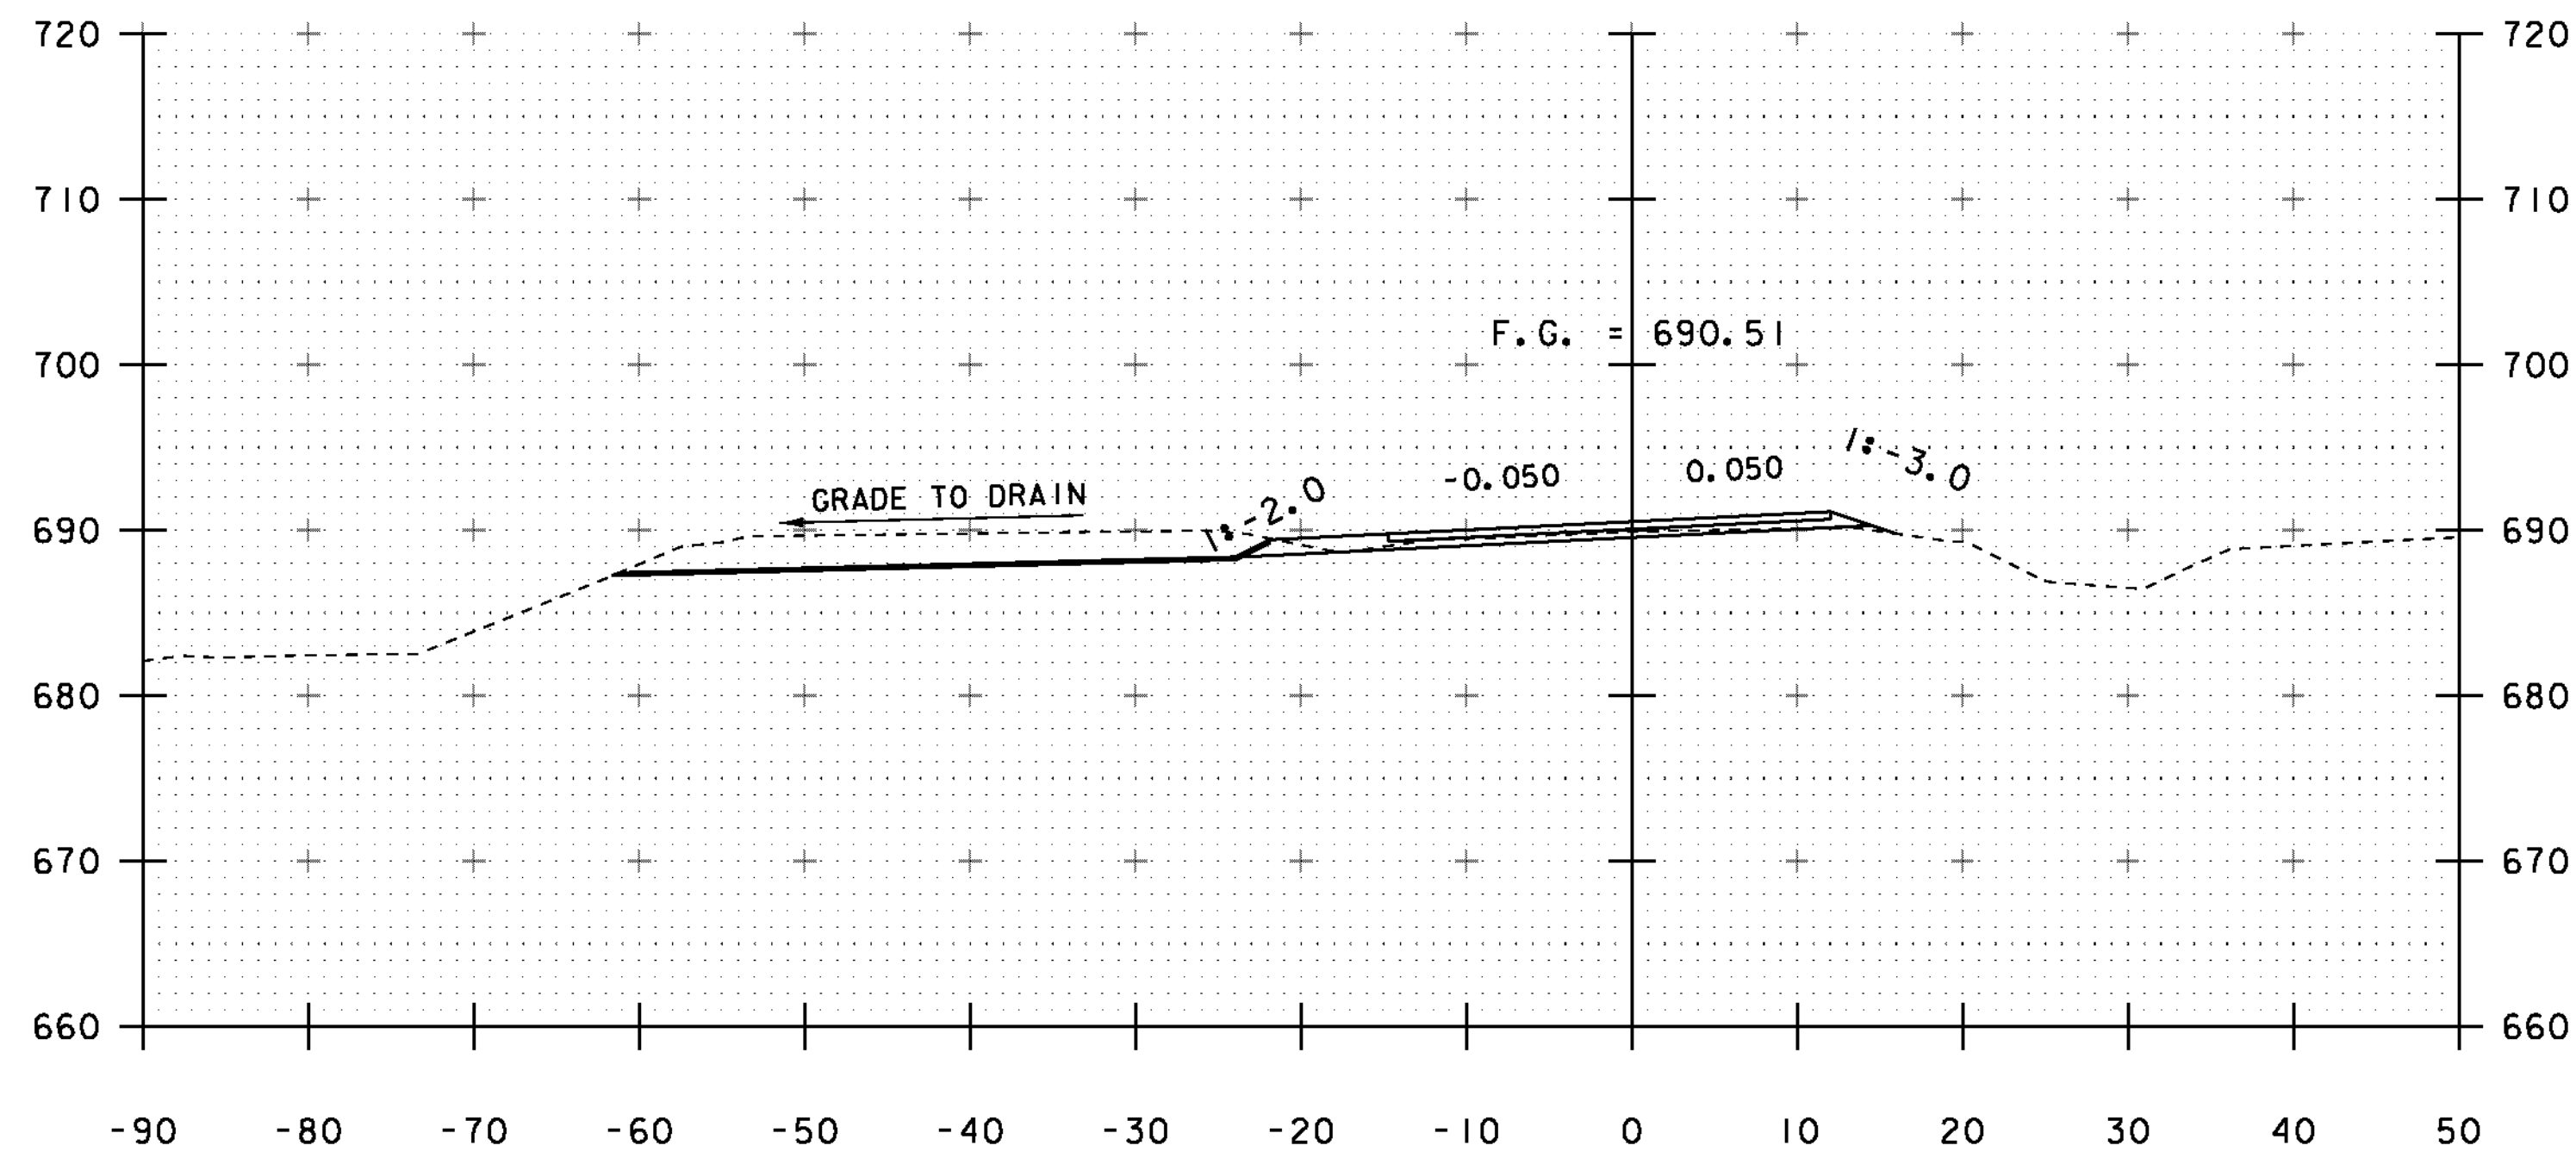

118+75

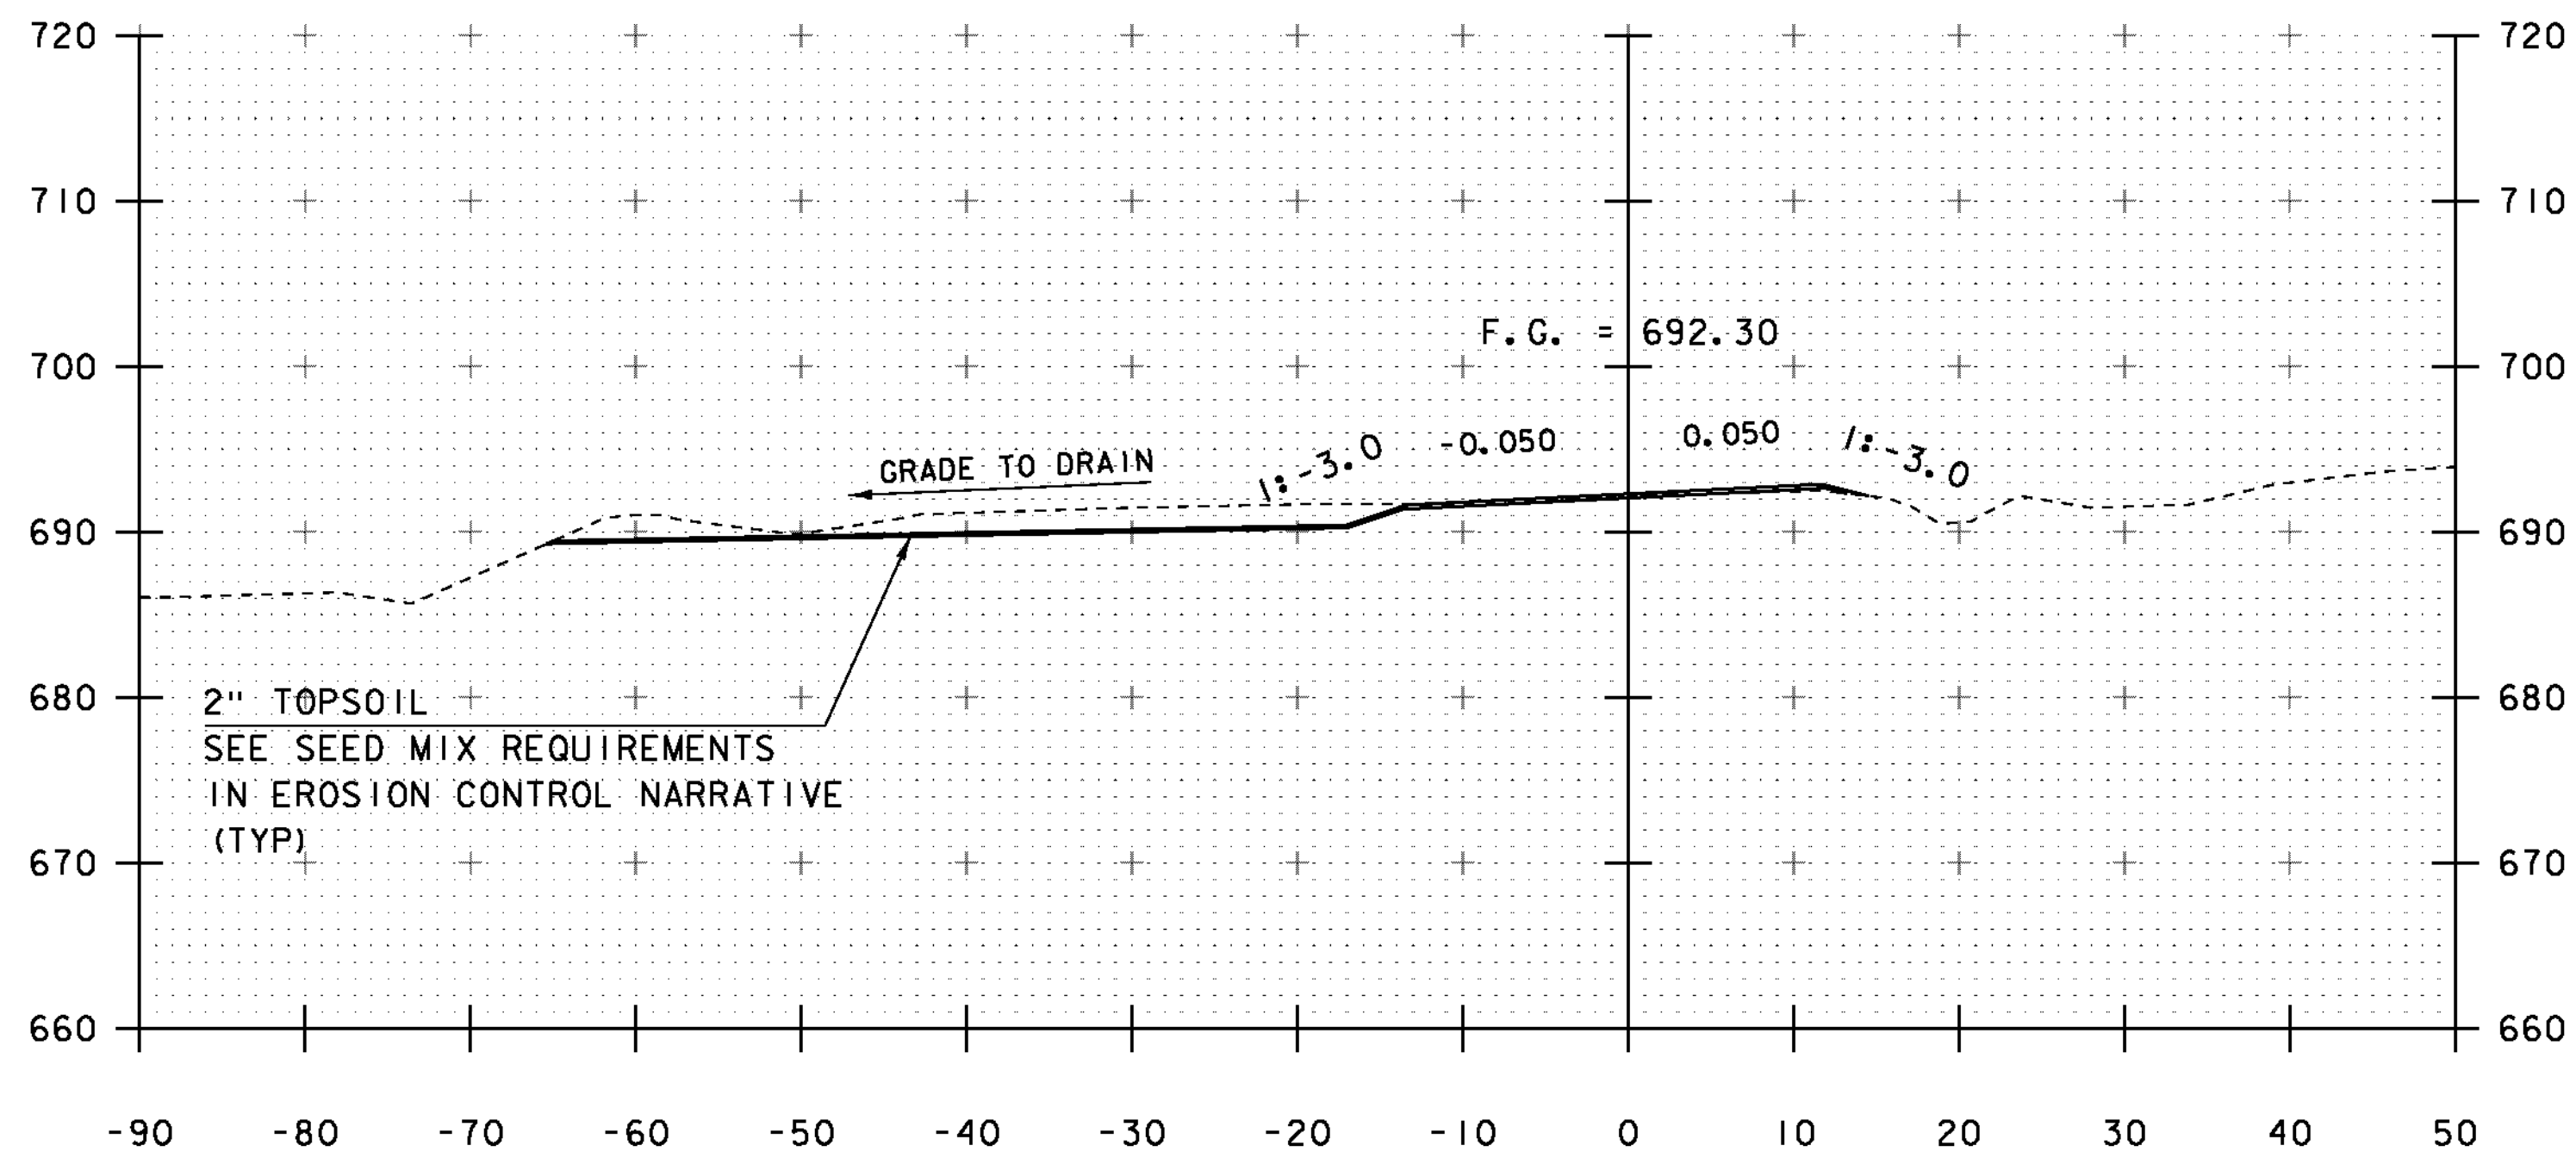

118+00

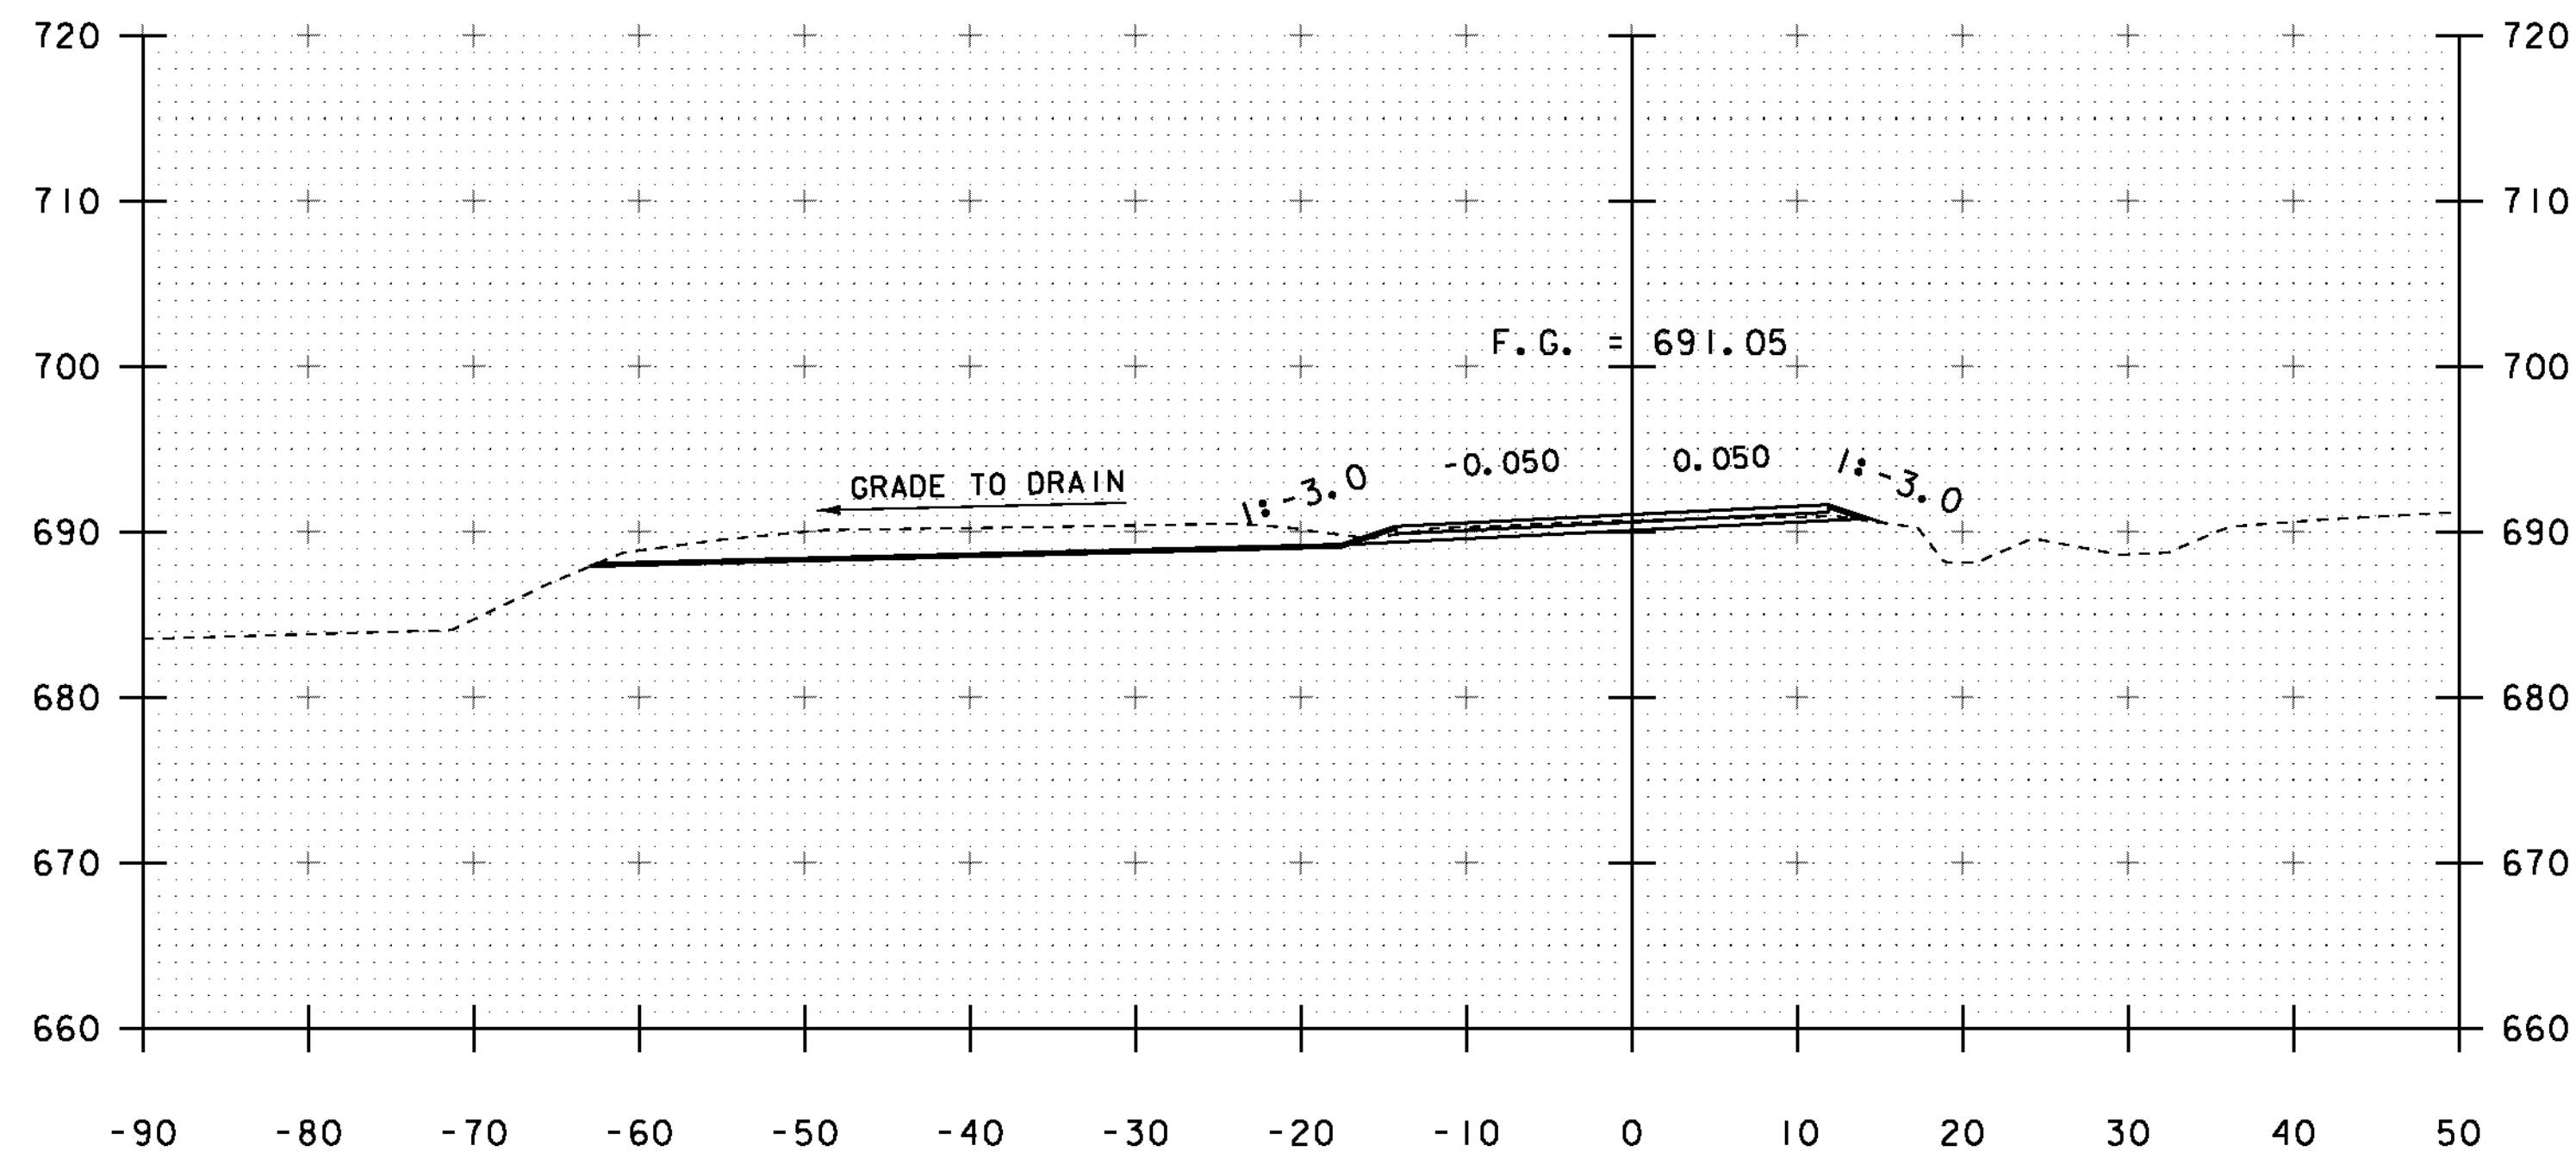

118+50

SCALE 1" = 10' - 0"

STA. 118+00 TO STA. 118+75

PROJECT NAME: JAMAICA  
 PROJECT NUMBER: ER-BRF 013-1(16)  
 FILE NAME: s11b212xs.dgn  
 PROJECT LEADER: K. HIGGINS  
 DESIGNED BY: G. LAROCHE  
 MAINLINE CROSS SECTION 3

PLOT DATE: 12-OCT-2012  
 DRAWN BY: K. FRIEDLAND  
 CHECKED BY: G. LAROCHE  
 SHEET 63 OF 85