




119+00

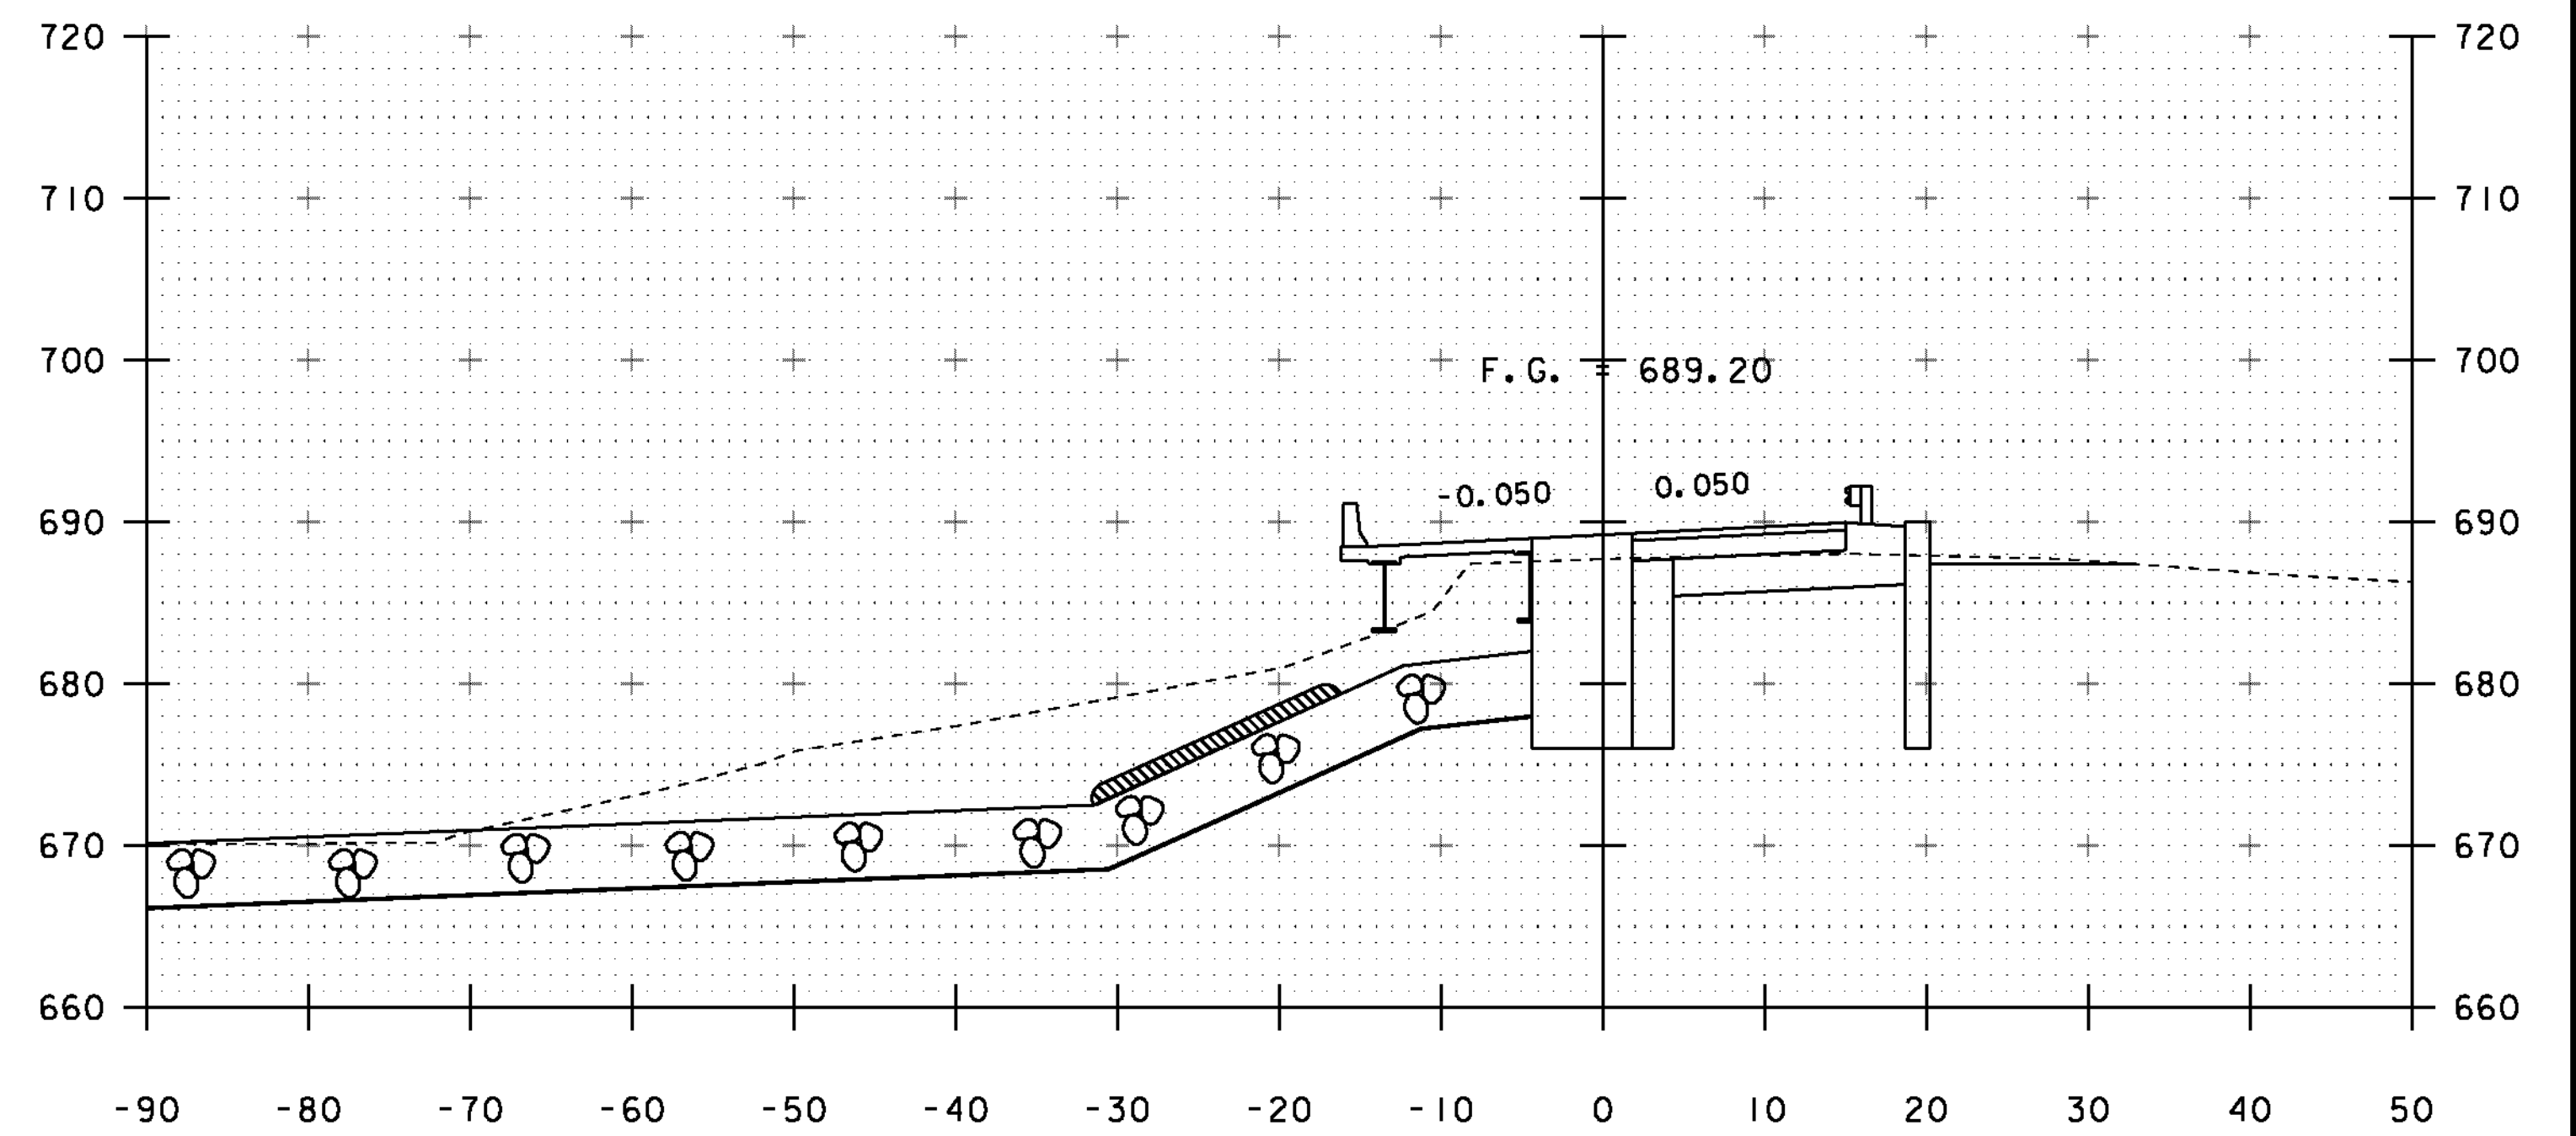

119+50  
BEGIN BRIDGE - 119+49.11

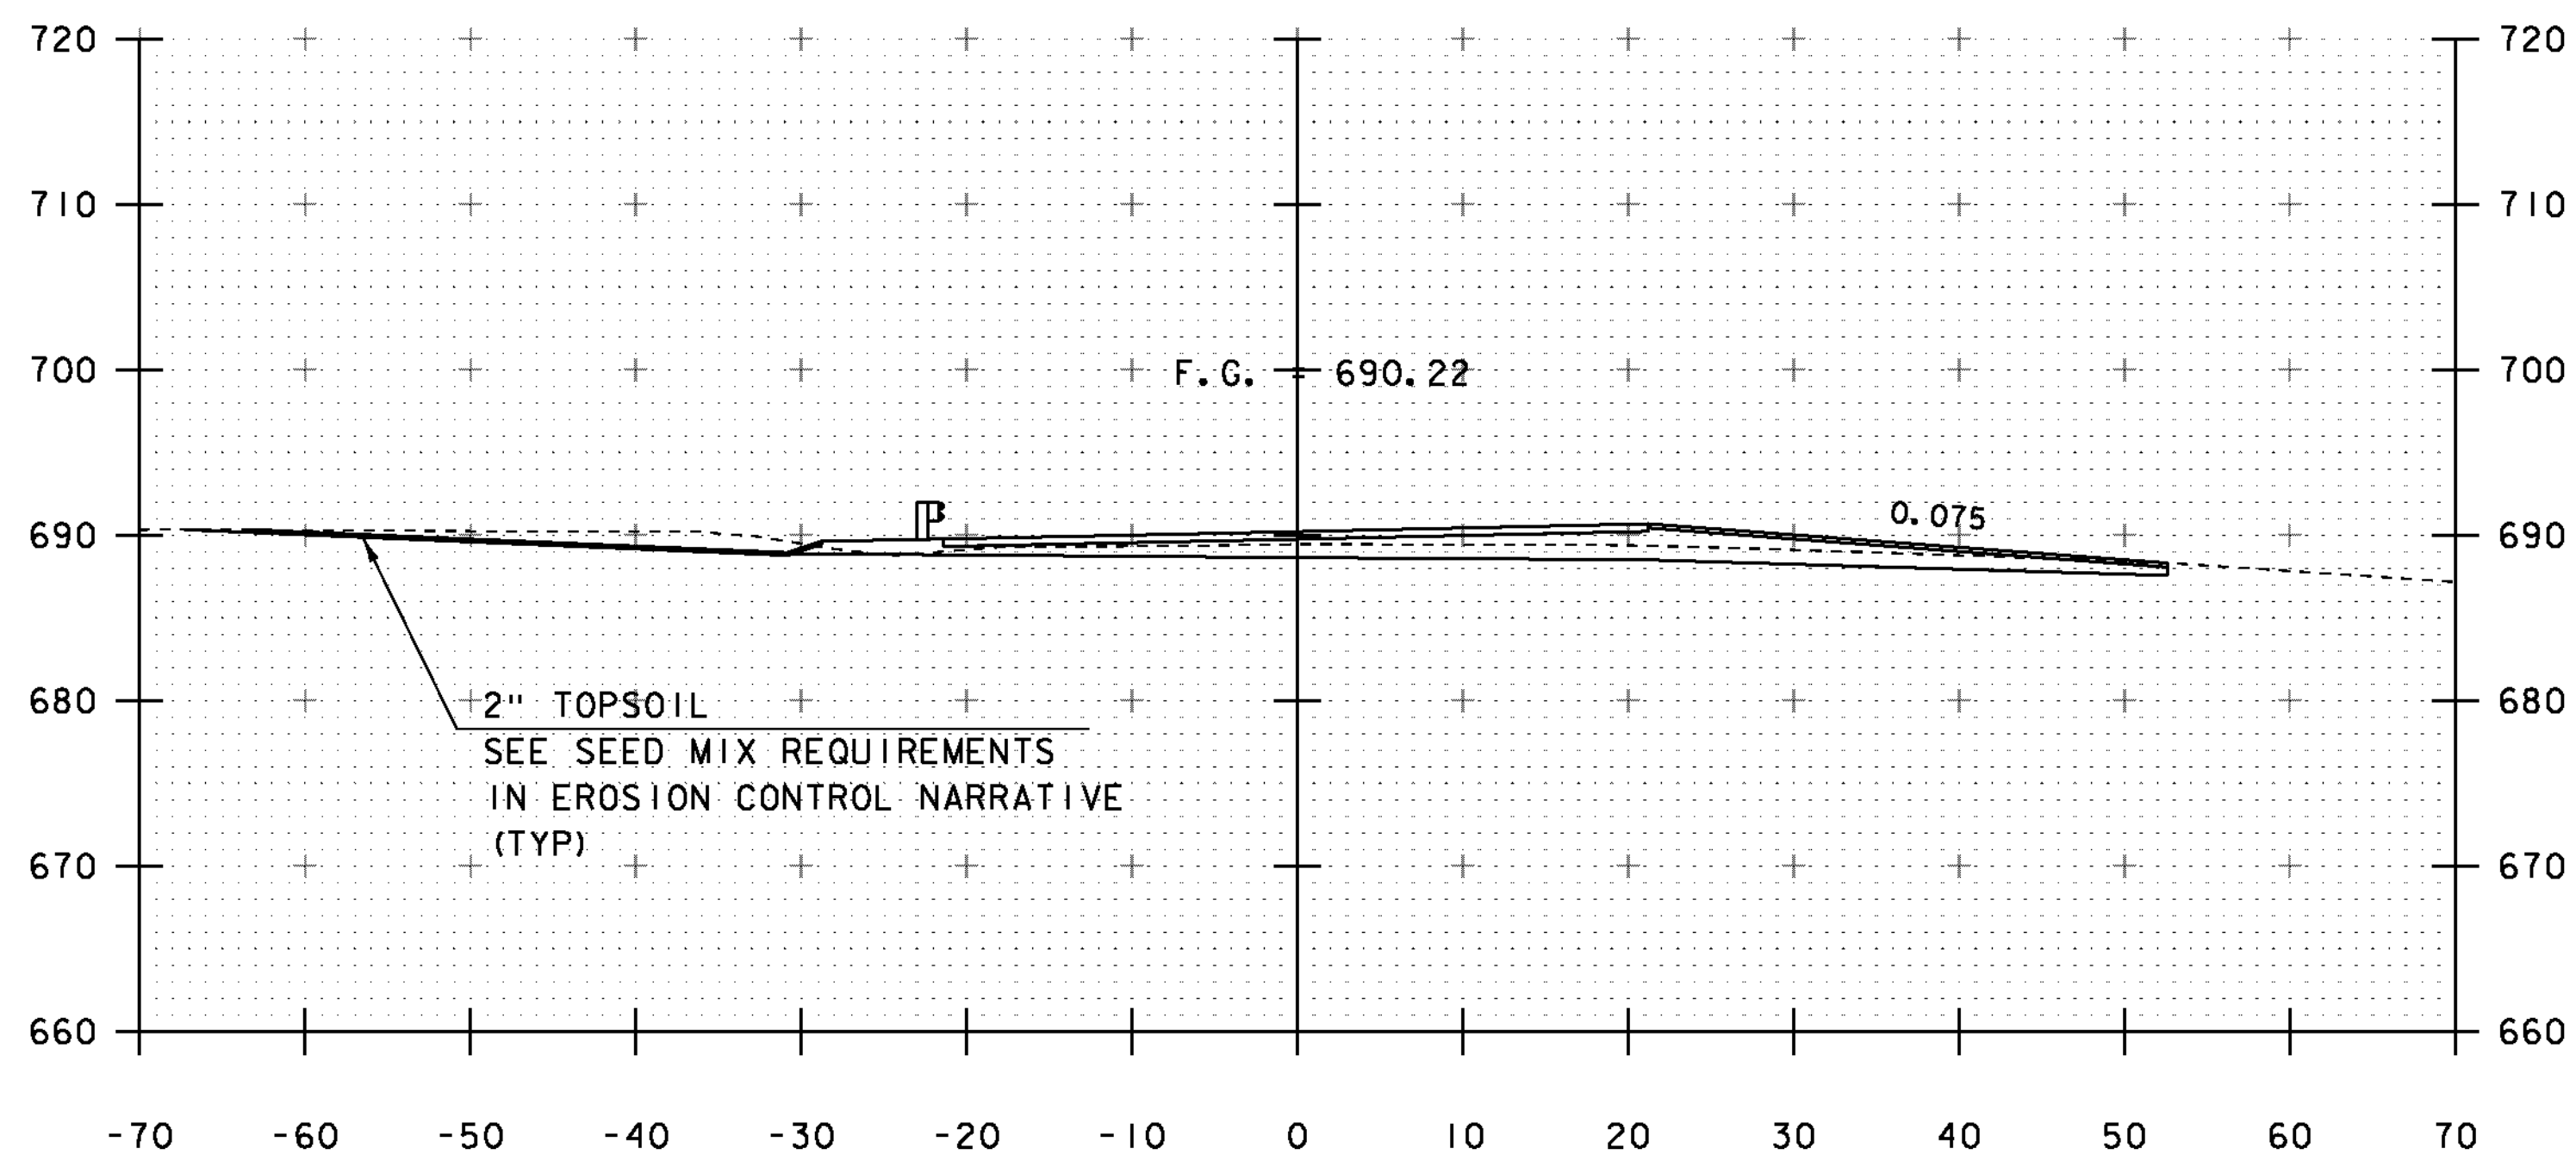

118+90  
TOWN HIGHWAY 55 SKEWED @ 45 DEG.

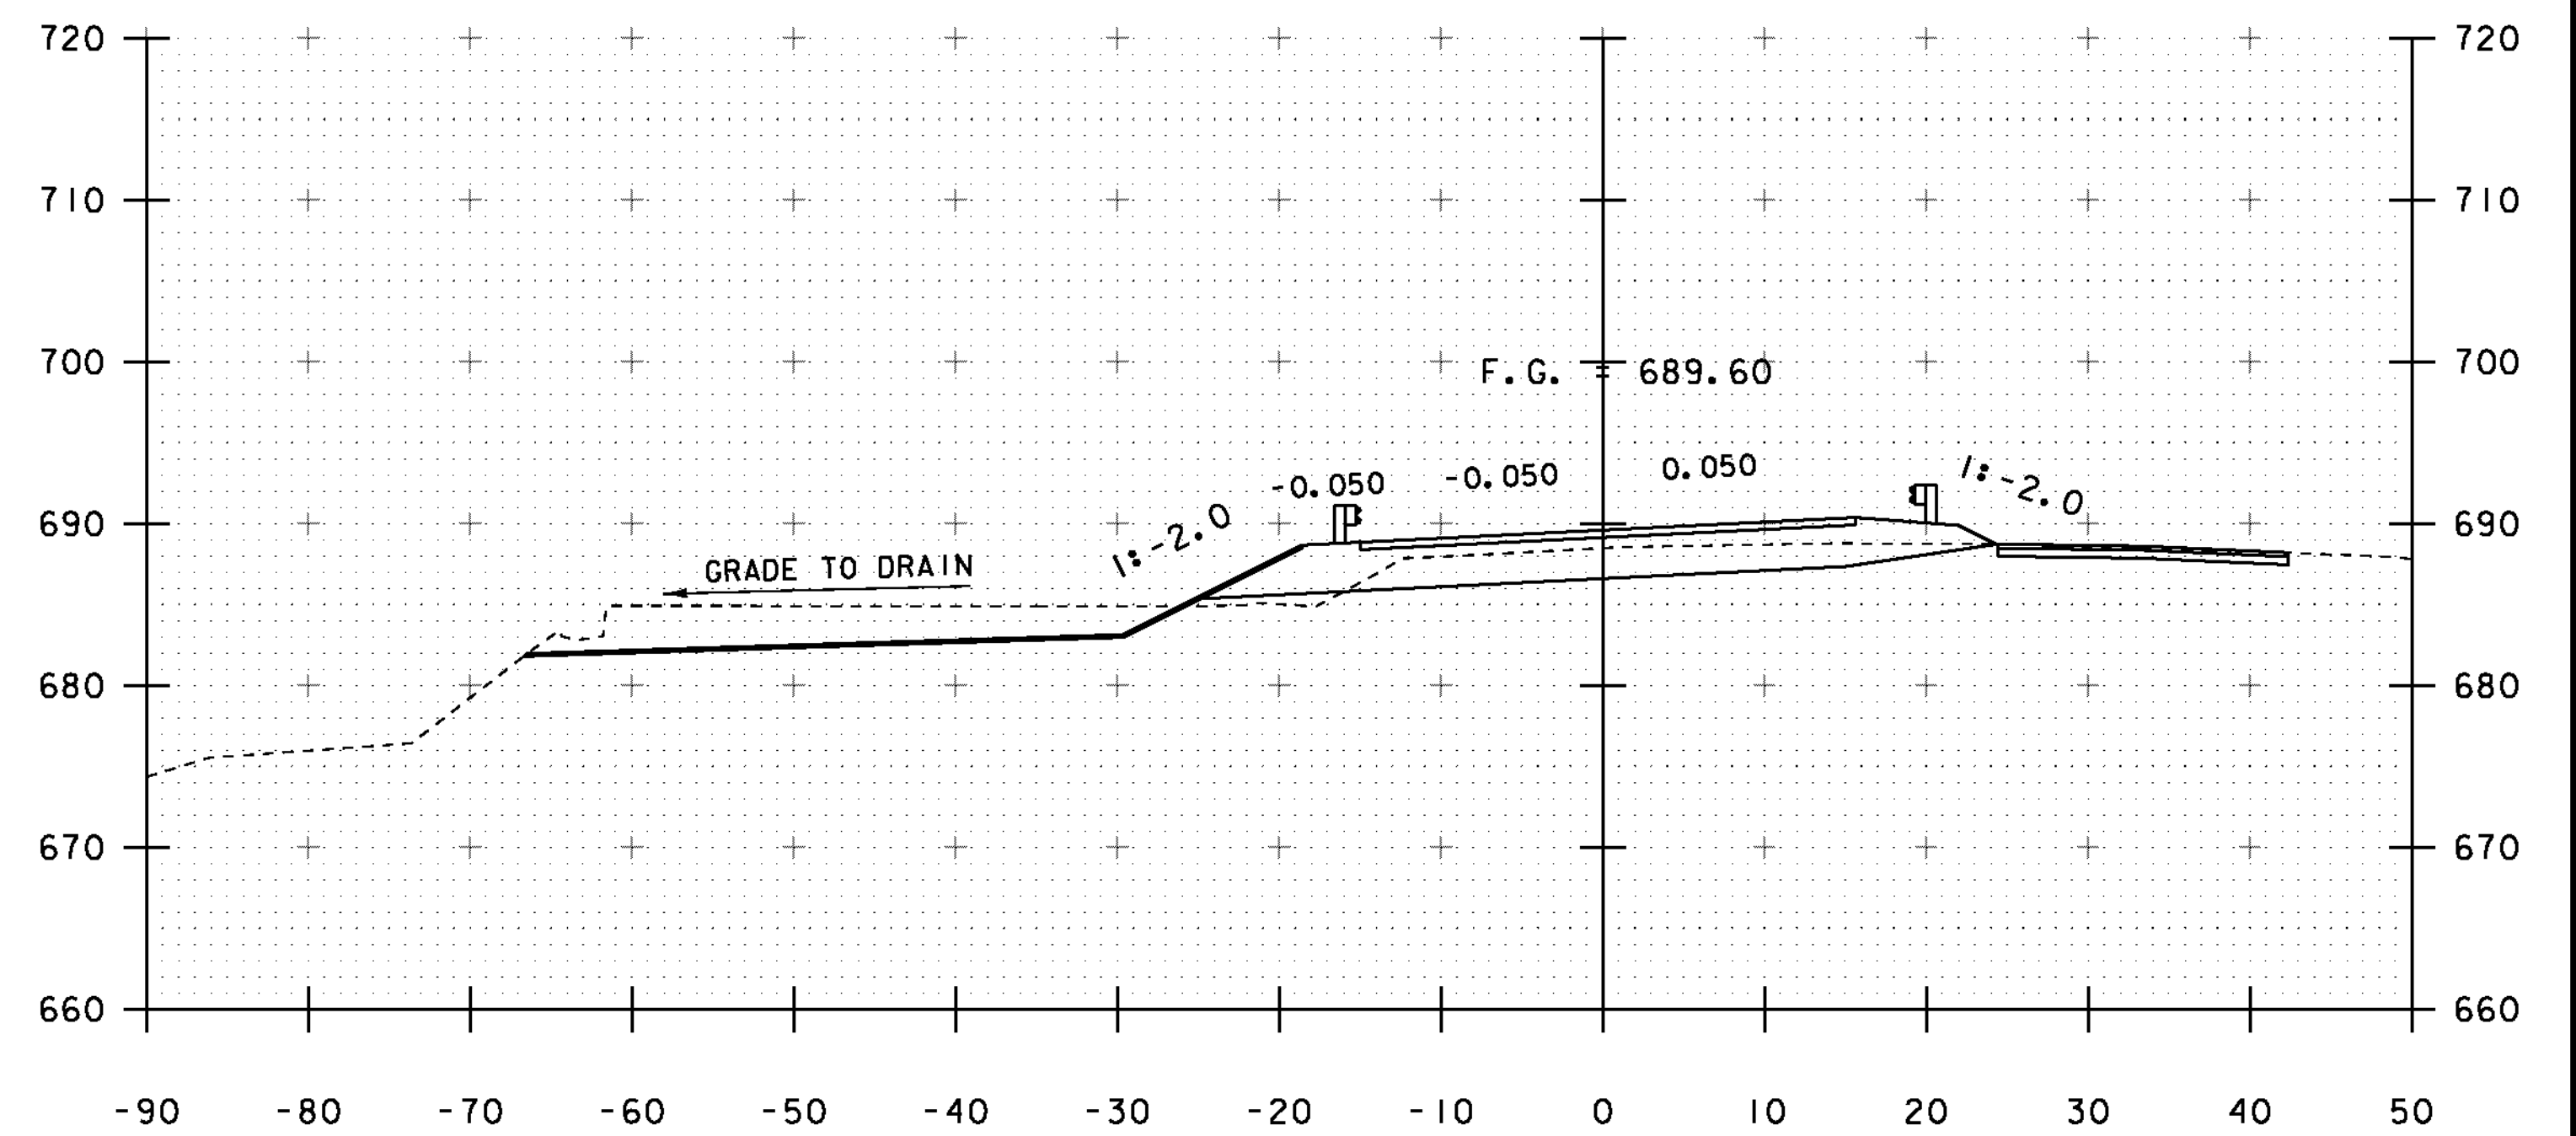

119+25  
END APPROACH  
BEGIN PROJECT

SCALE 1" = 10'-0"  
10 0 10

STA. 118+90 TO STA. 119+50

PROJECT NAME: JAMAICA	PLOT DATE: 12-OCT-2012
PROJECT NUMBER: ER-BRF 013-1(16)	DRAWN BY: K. FRIEDLAND
FILE NAME: s11b212xs.dgn	CHECKED BY: G. LAROCHE
PROJECT LEADER: K. HIGGINS	SHEET 64 OF 85
DESIGNED BY: G. LAROCHE	
MAINLINE CROSS SECTION 4	