




120+00

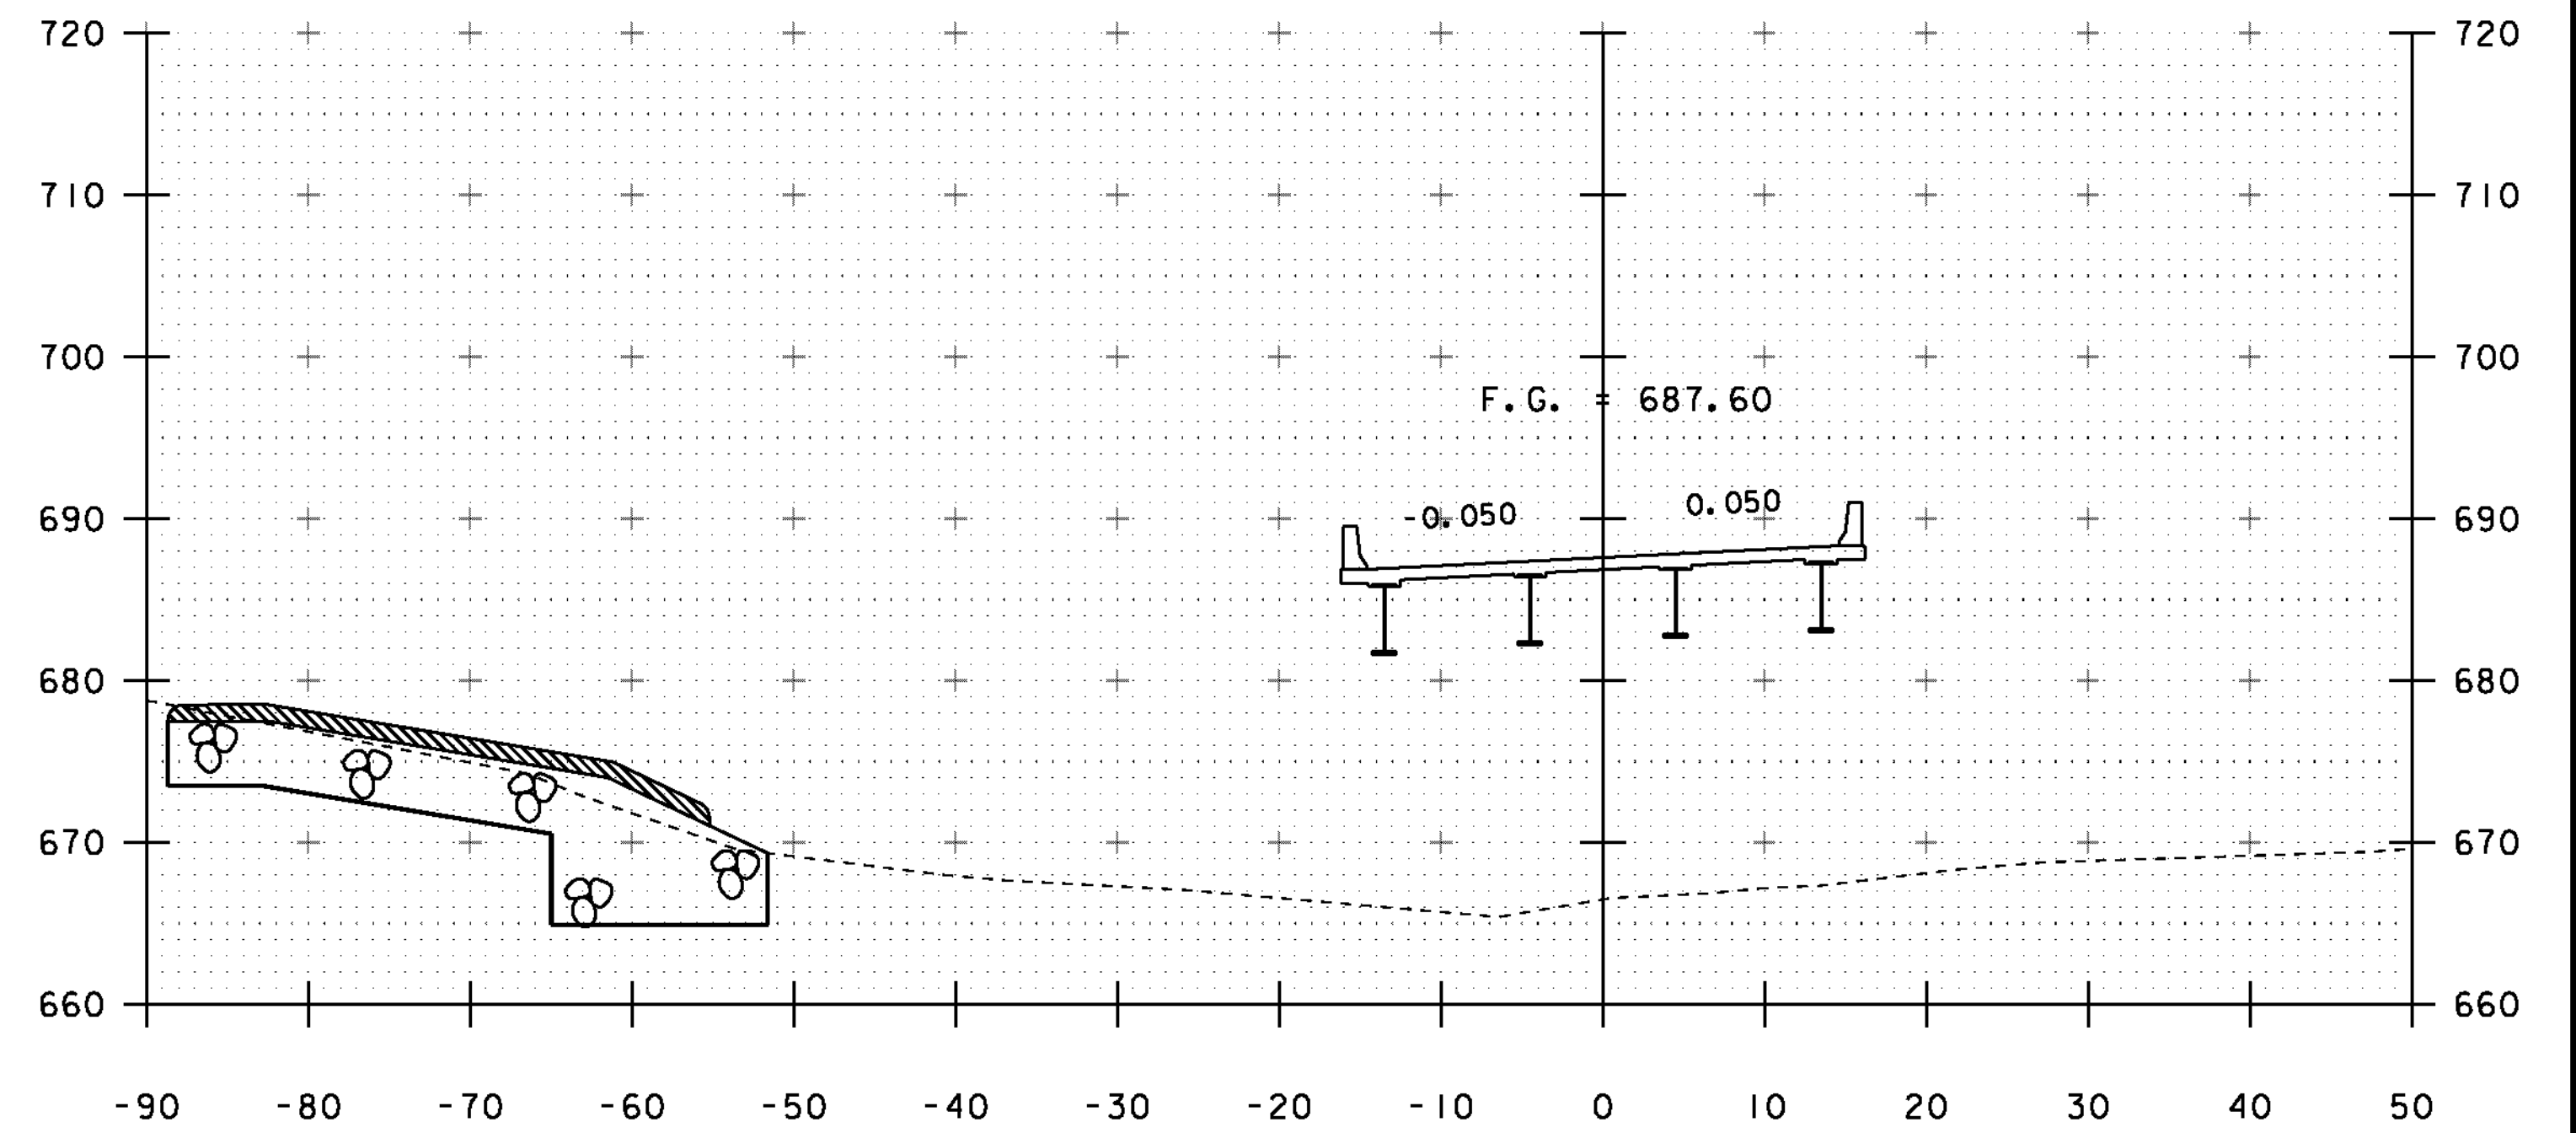

120+50

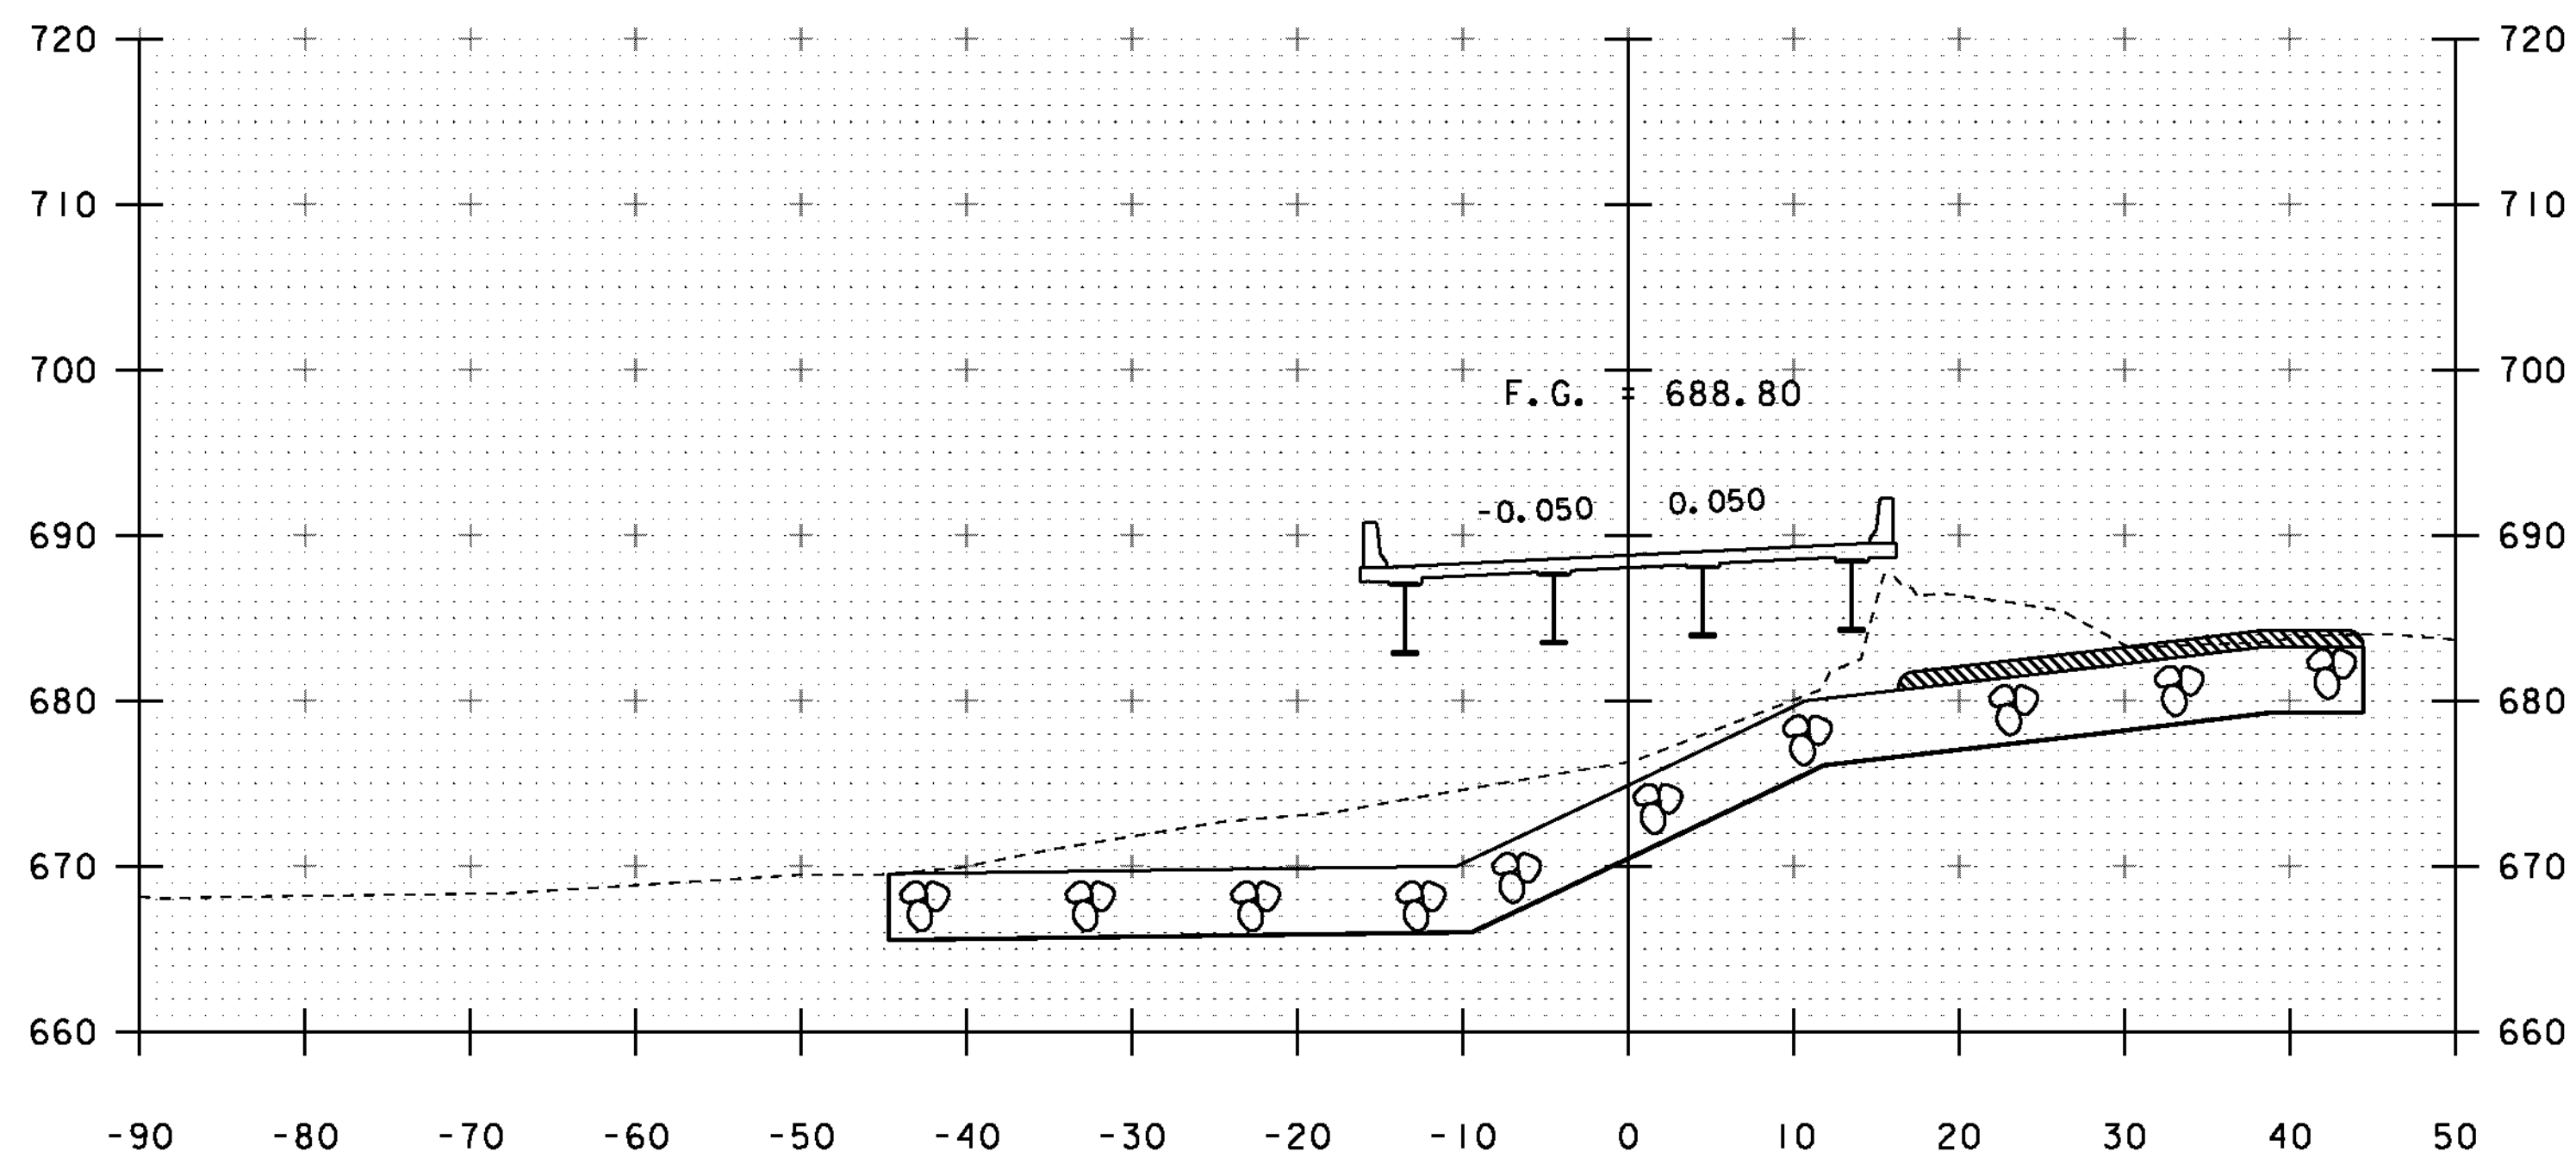

119+75

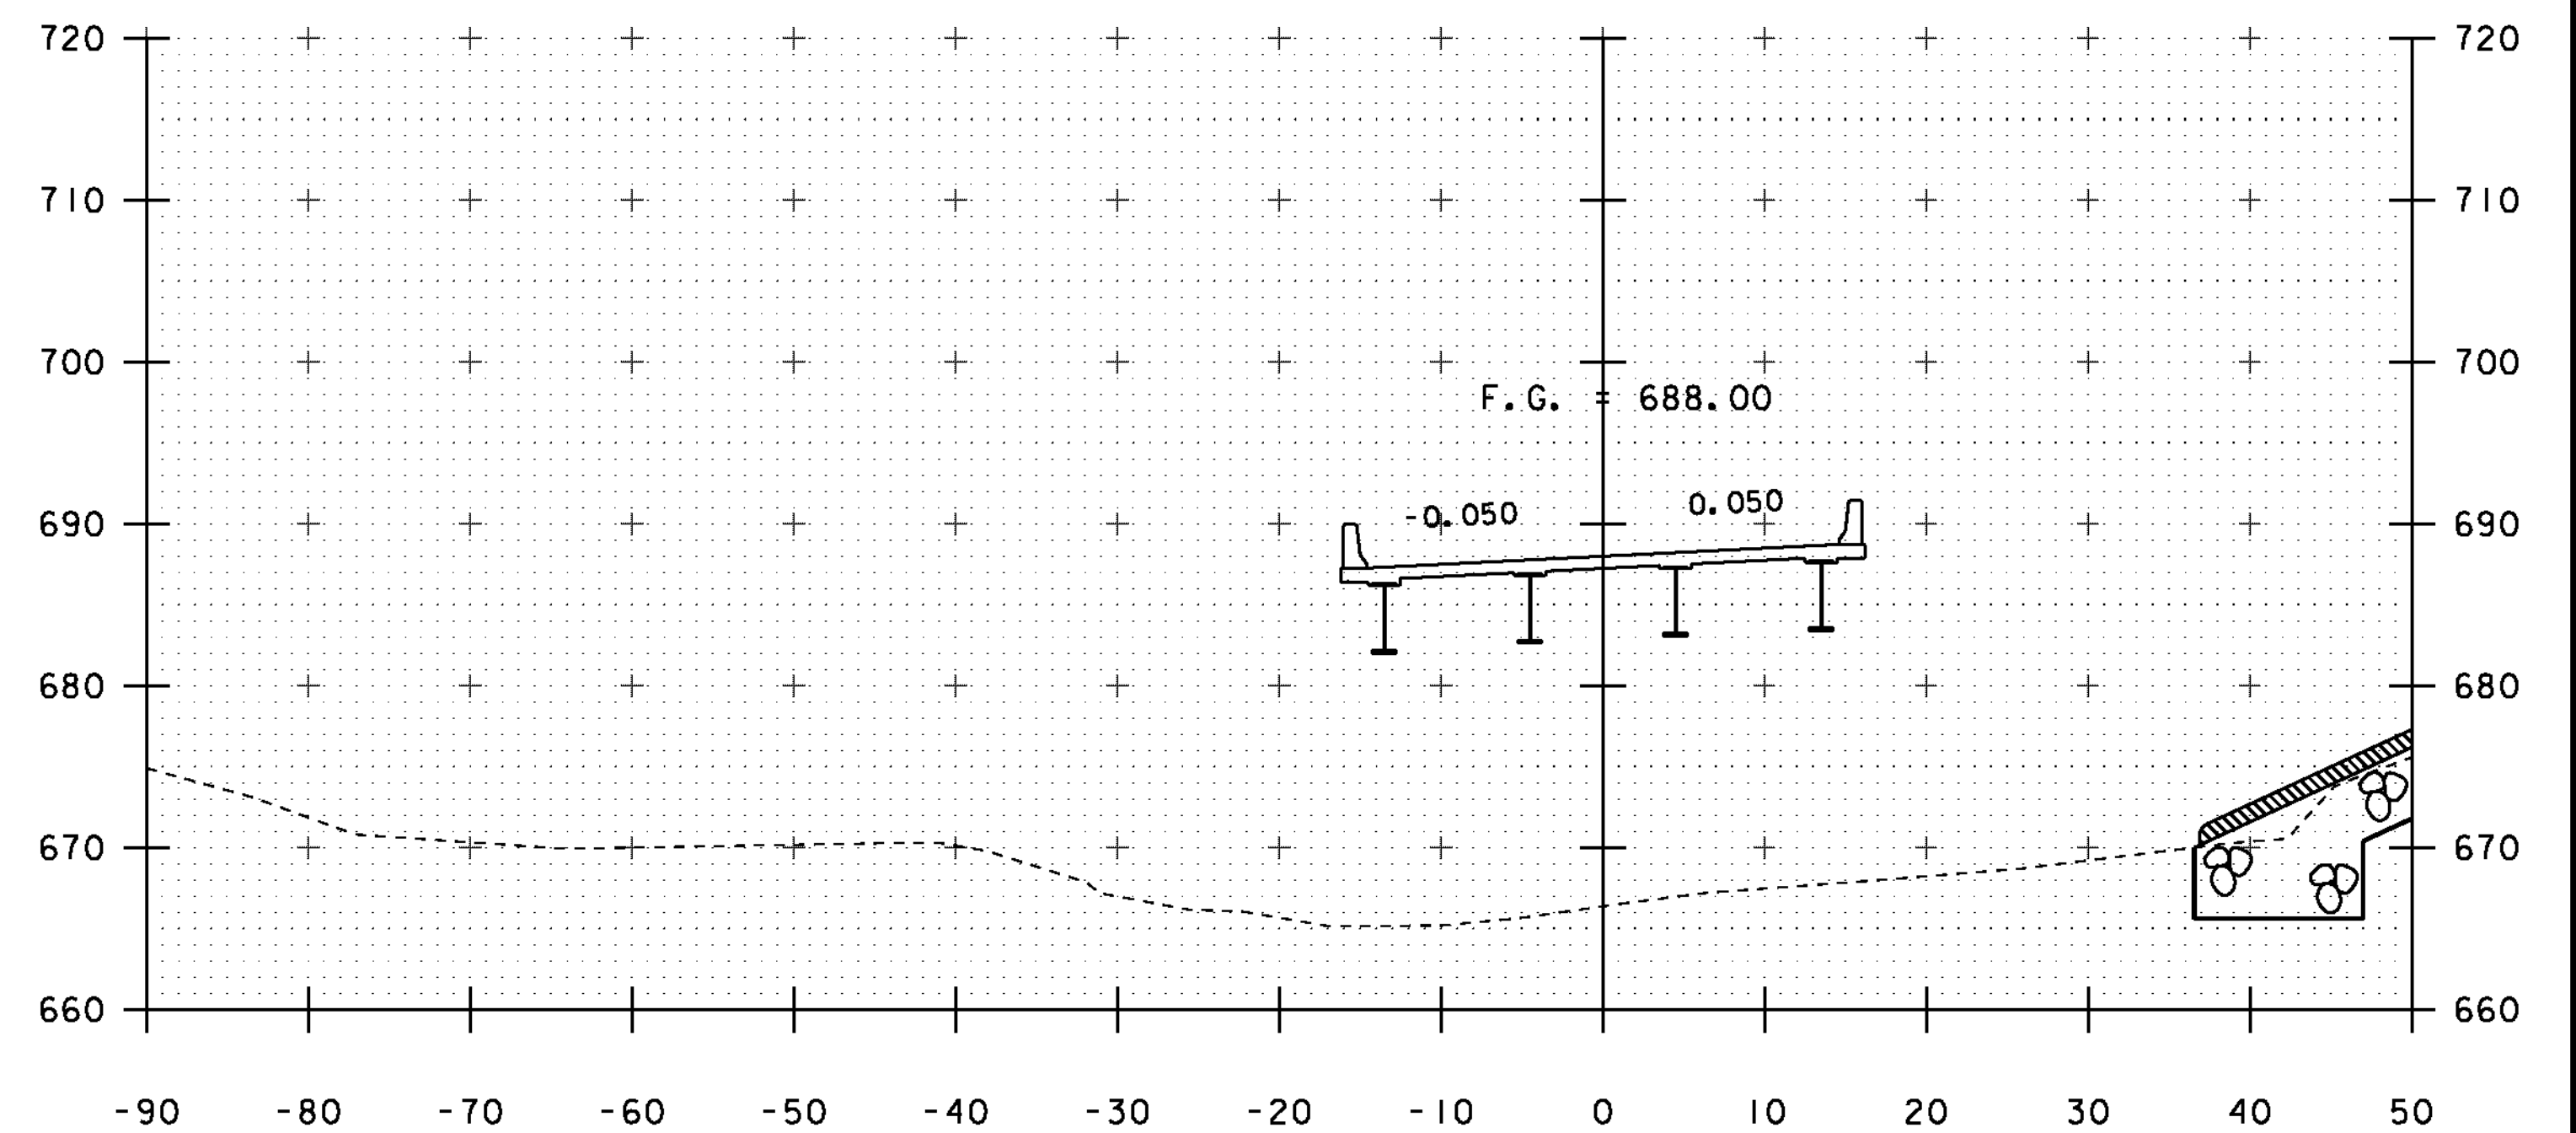

120+25

SCALE 1" = 10' - 0"
 10 0 10

STA. 119+75 TO STA. 120+50

PROJECT NAME: JAMAICA	PLOT DATE: 12-OCT-2012
PROJECT NUMBER: ER-BRF 013-1(16)	DRAWN BY: K. FRIEDLAND
FILE NAME: s11b212xs.dgn	CHECKED BY: G. LAROCHE
PROJECT LEADER: K. HIGGINS	SHEET 65 OF 85
DESIGNED BY: G. LAROCHE	
MAINLINE CROSS SECTION 5	