




121+00

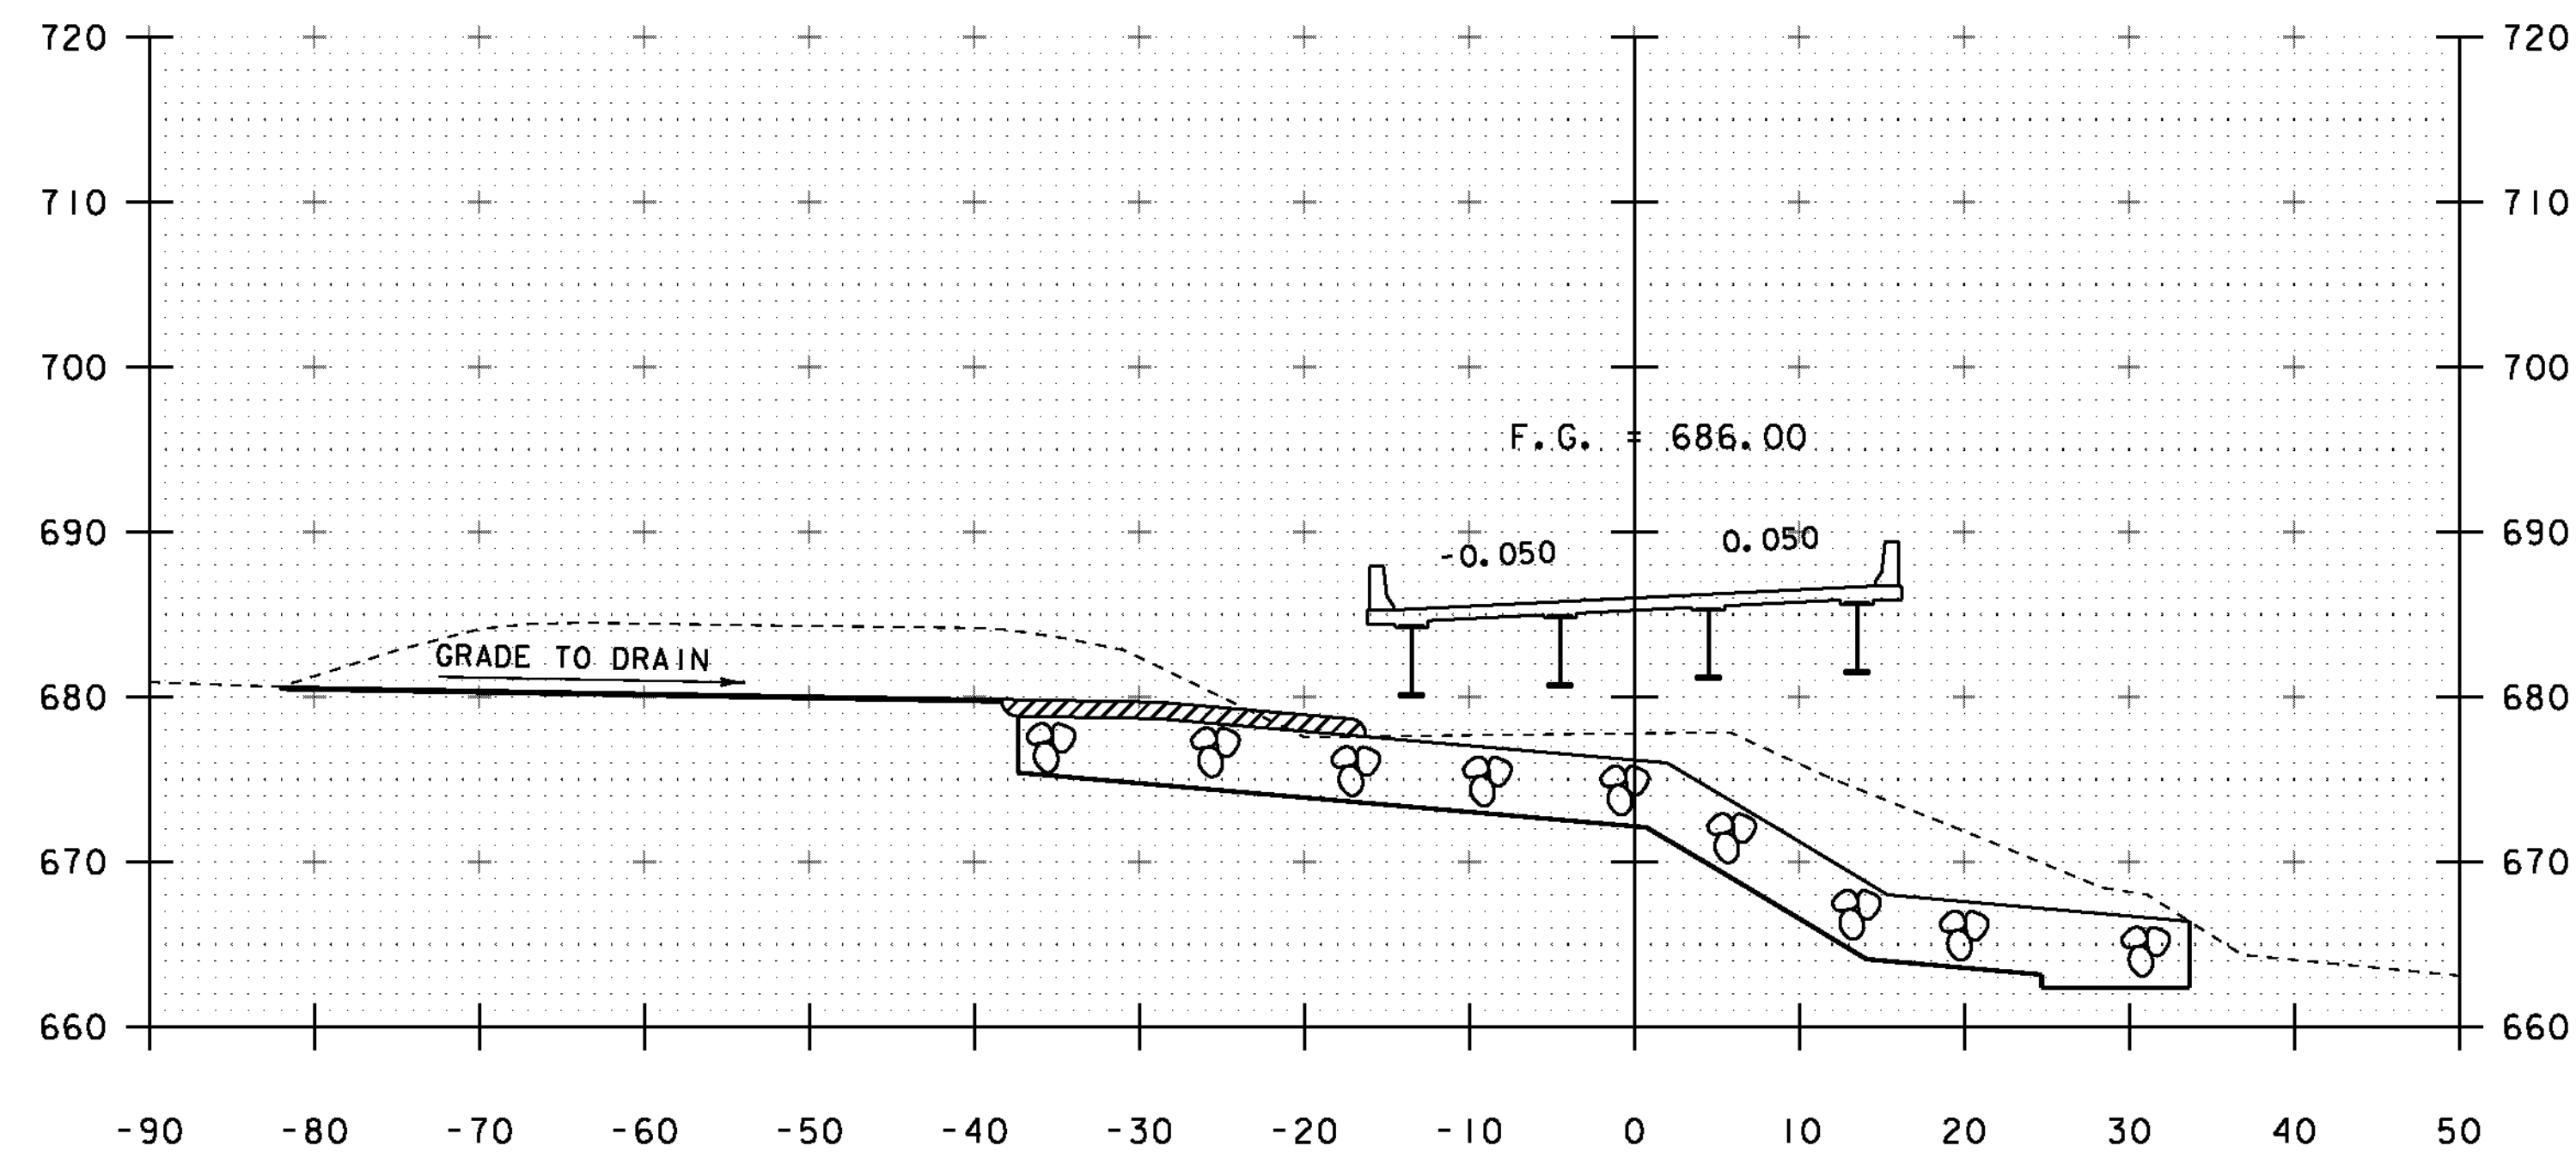

121+50

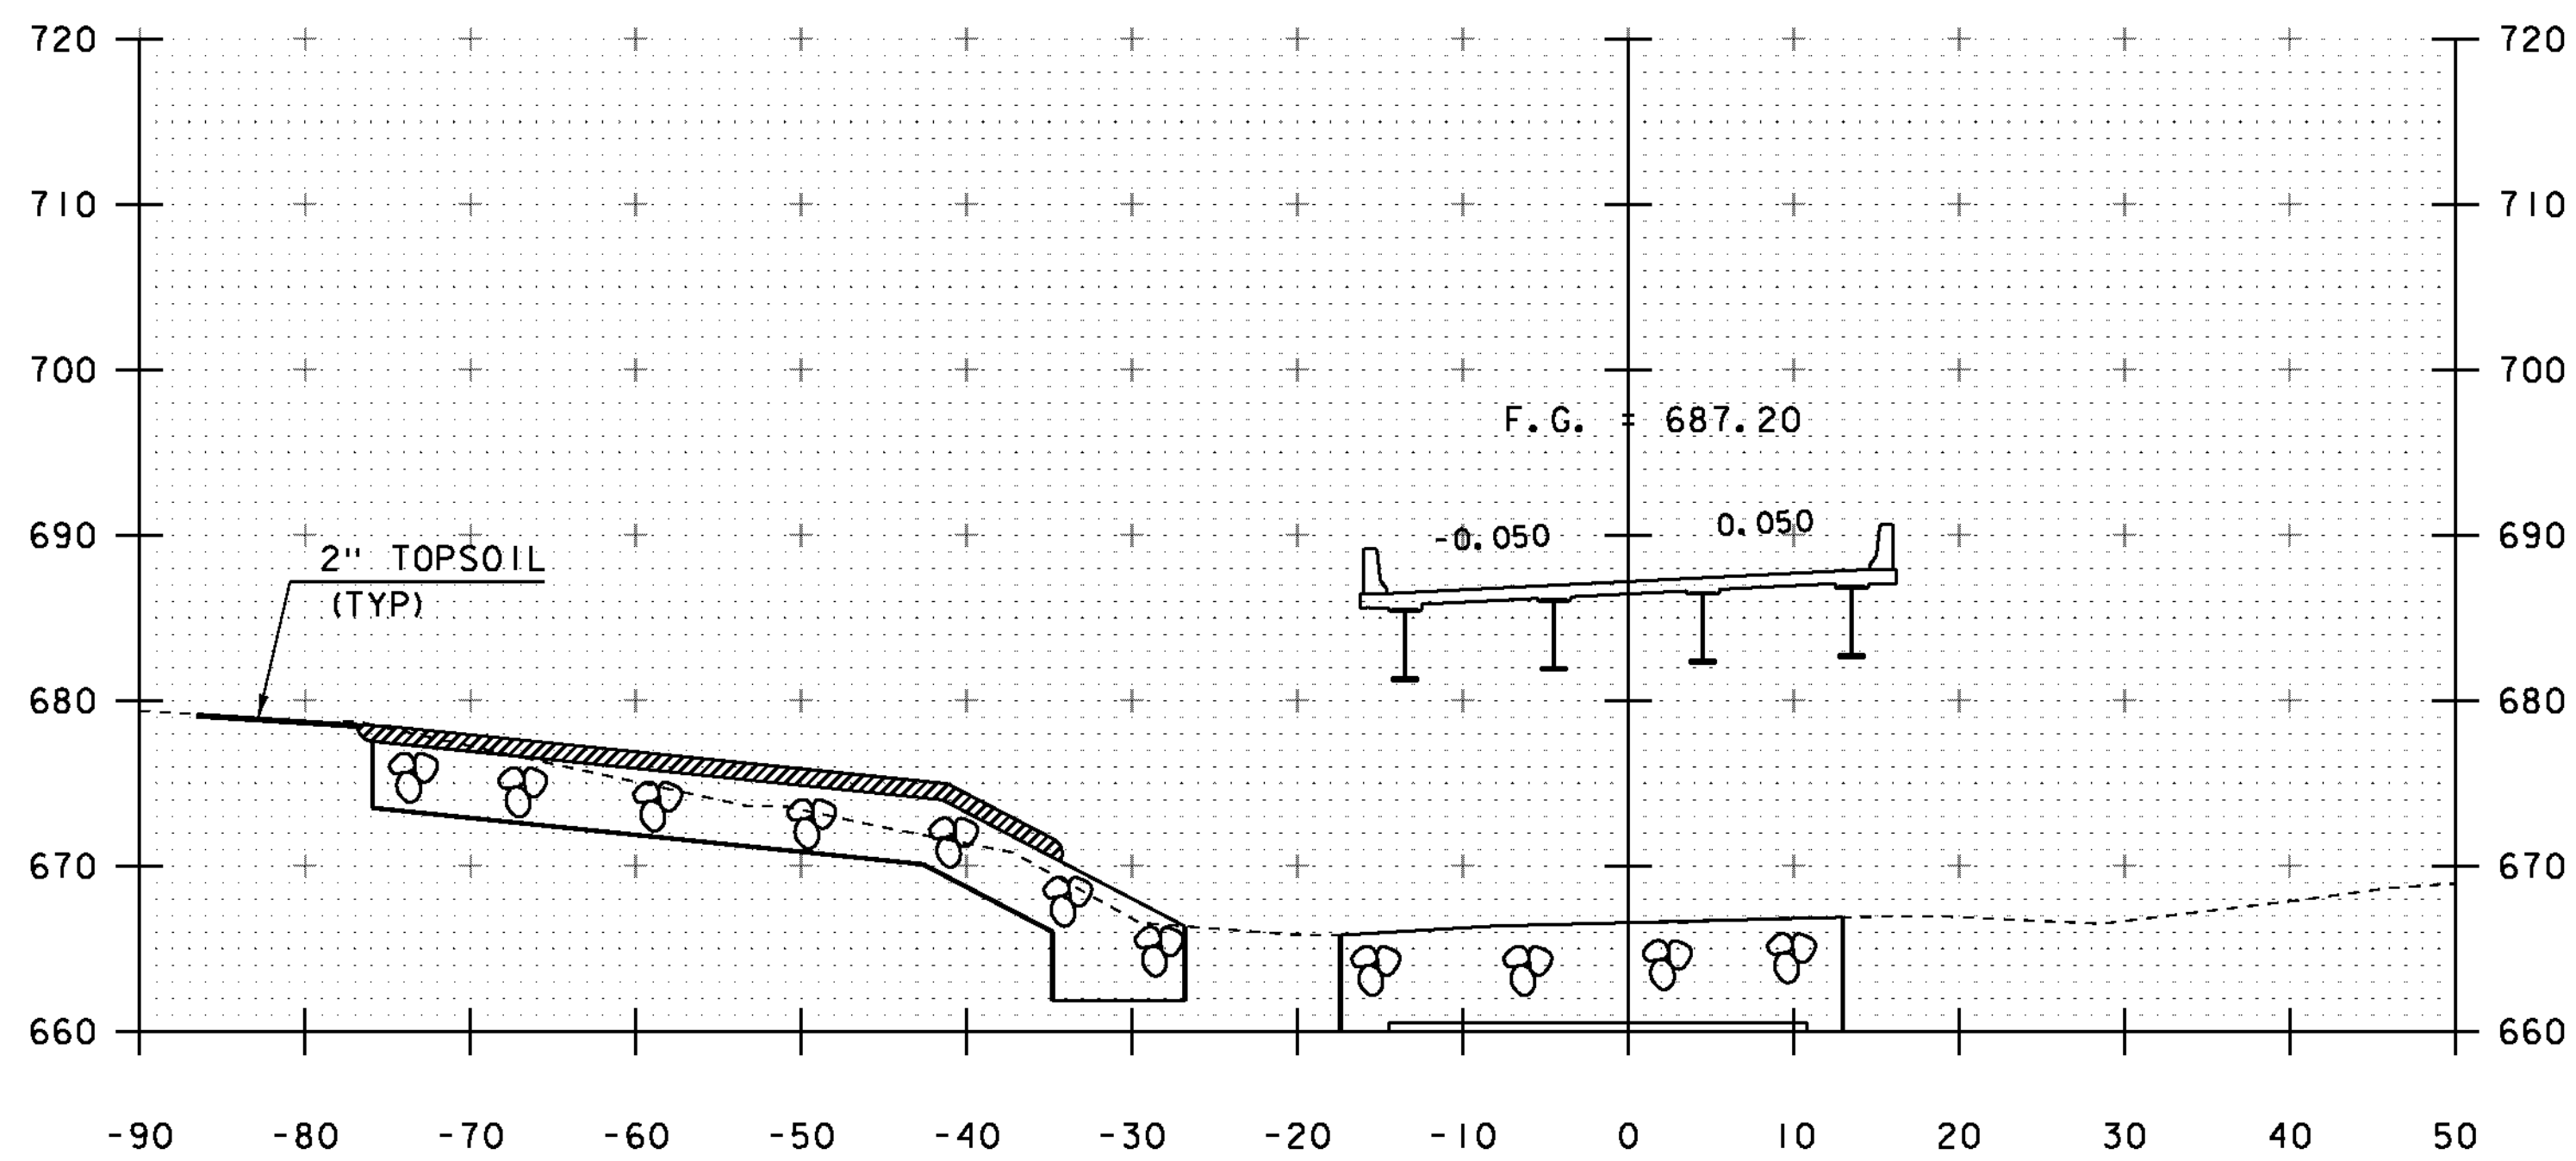

120+75

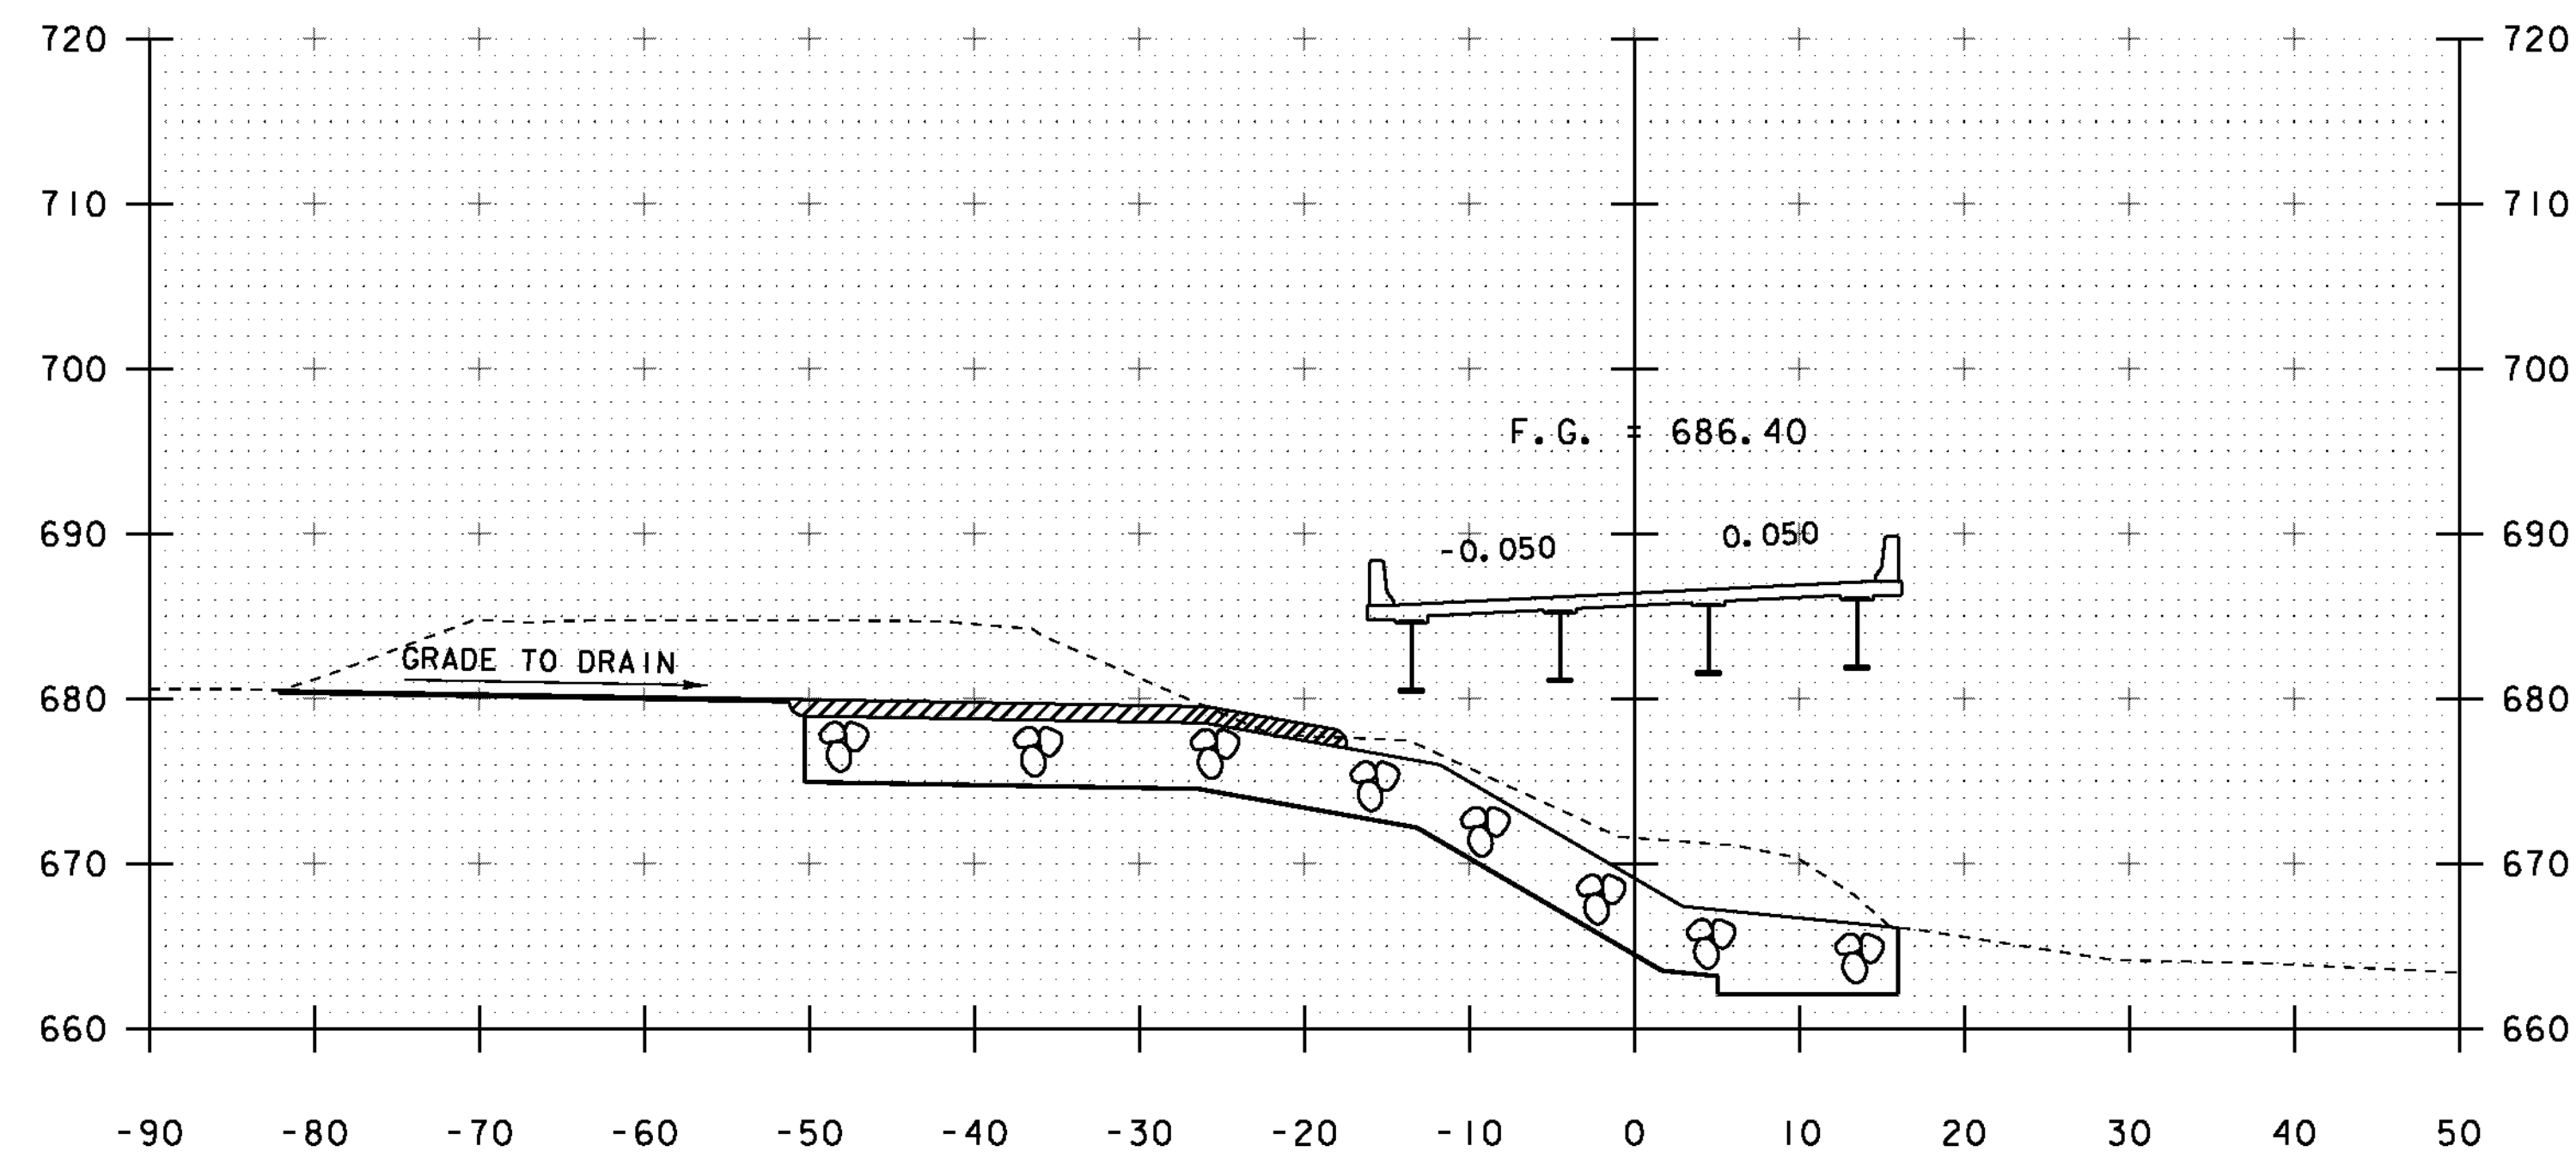

121+25

SCALE 1" = 10' - 0"
 10 0 10

STA. 120+75 TO STA. 121+50

PROJECT NAME: JAMAICA
 PROJECT NUMBER: ER-BRF 013-1(16)
 FILE NAME: s11b212xs.dgn
 PROJECT LEADER: K. HIGGINS
 DESIGNED BY: G. LAROCHE
 MAINLINE CROSS SECTION 6

PLOT DATE: 12-OCT-2012
 DRAWN BY: K. FRIEDLAND
 CHECKED BY: G. LAROCHE
 SHEET 66 OF 85