




123+00

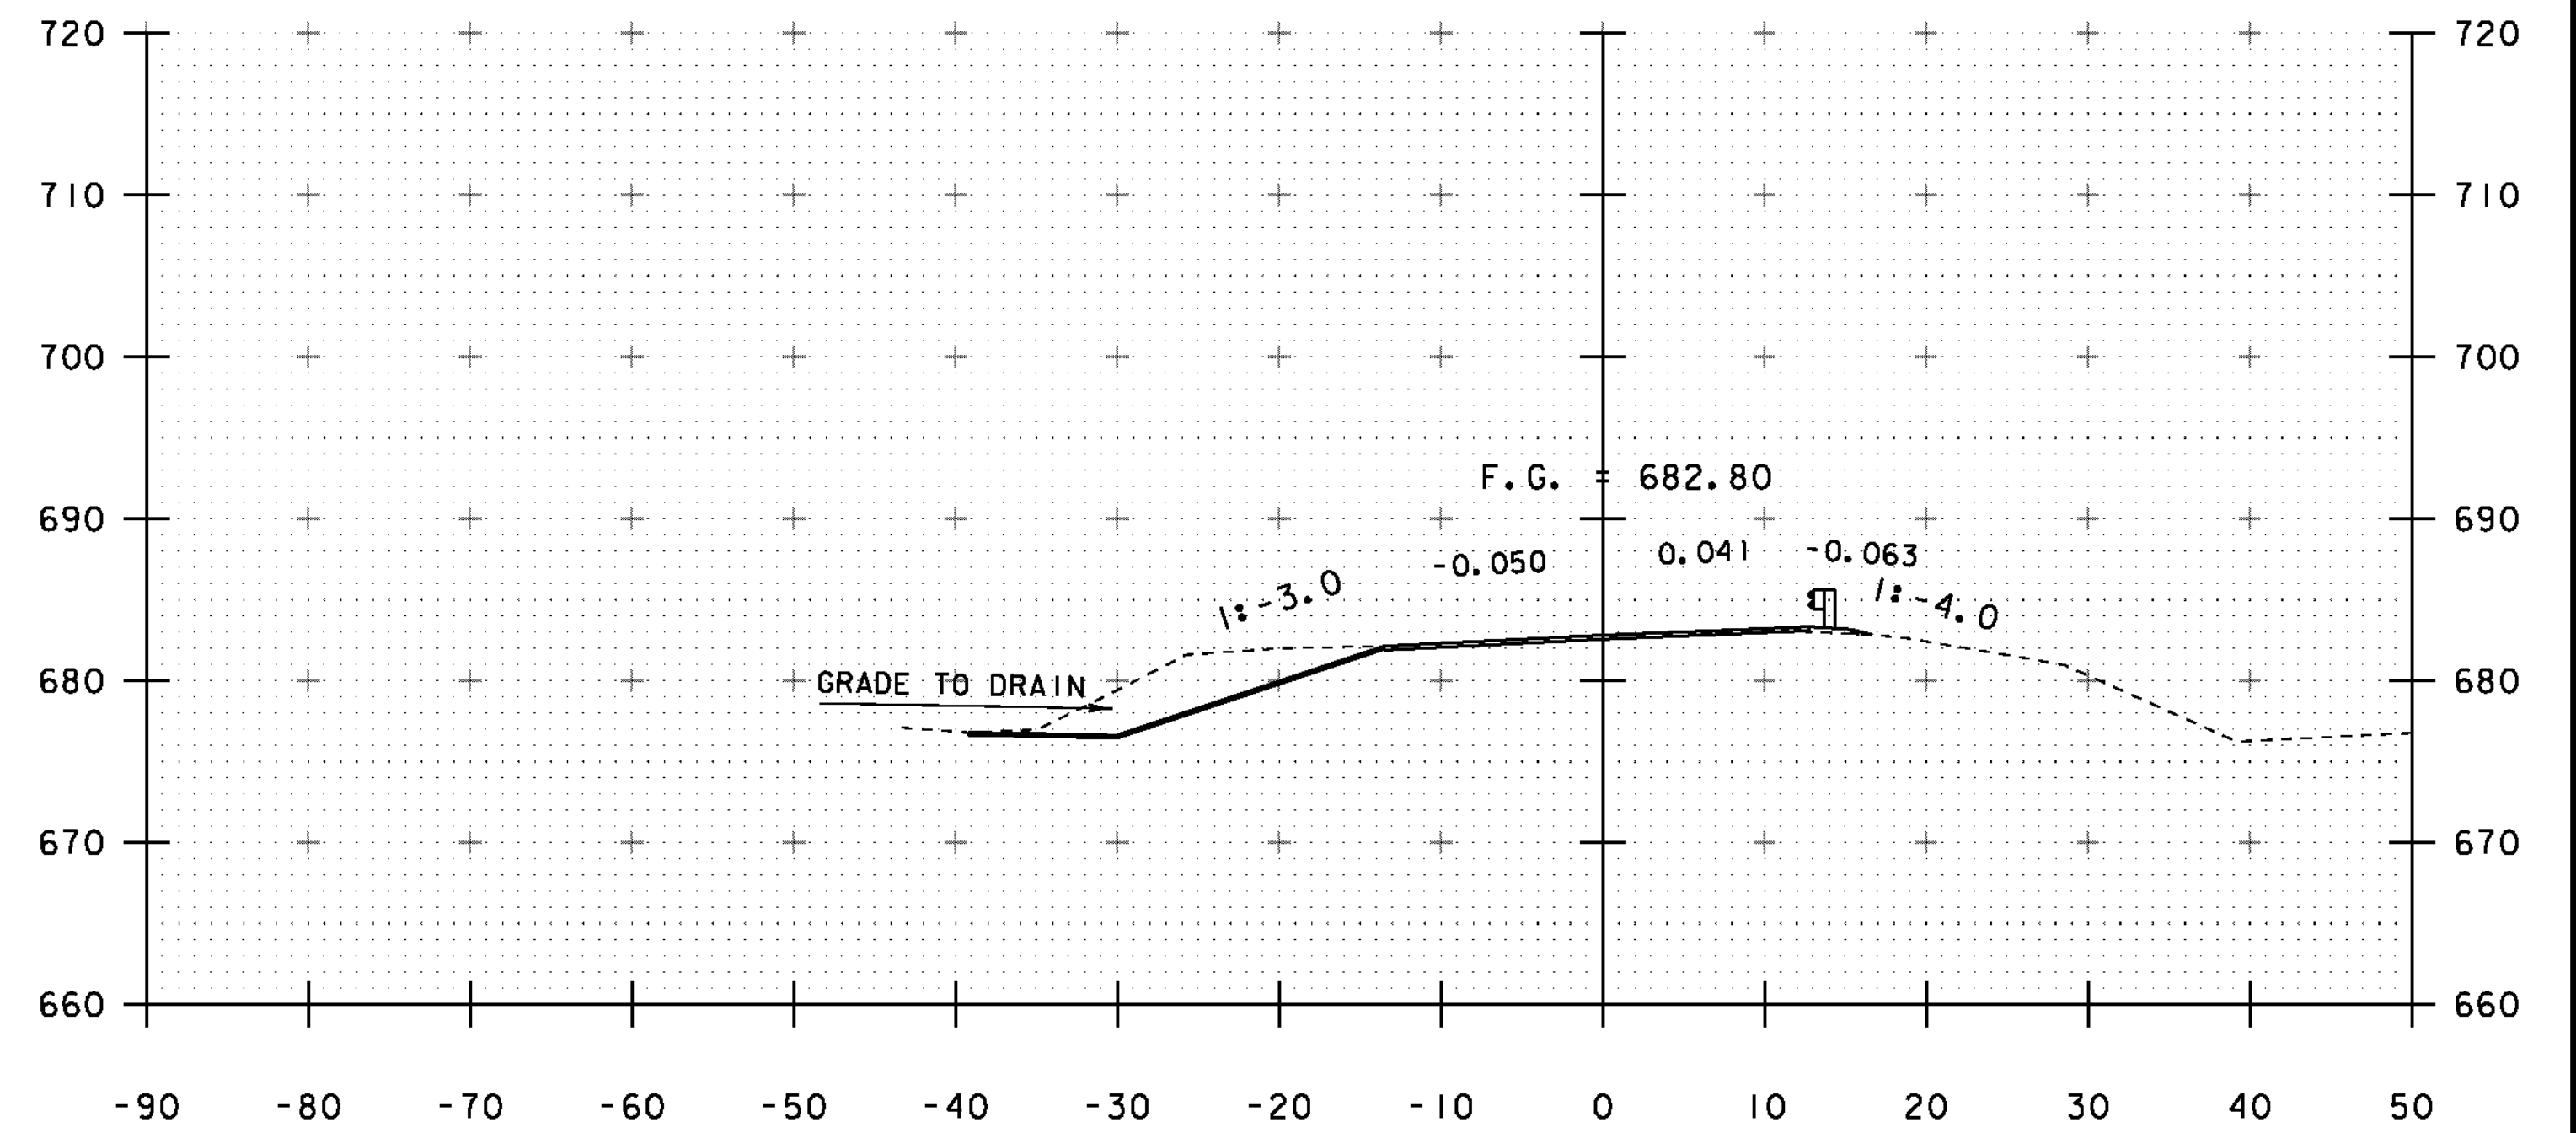


123+50

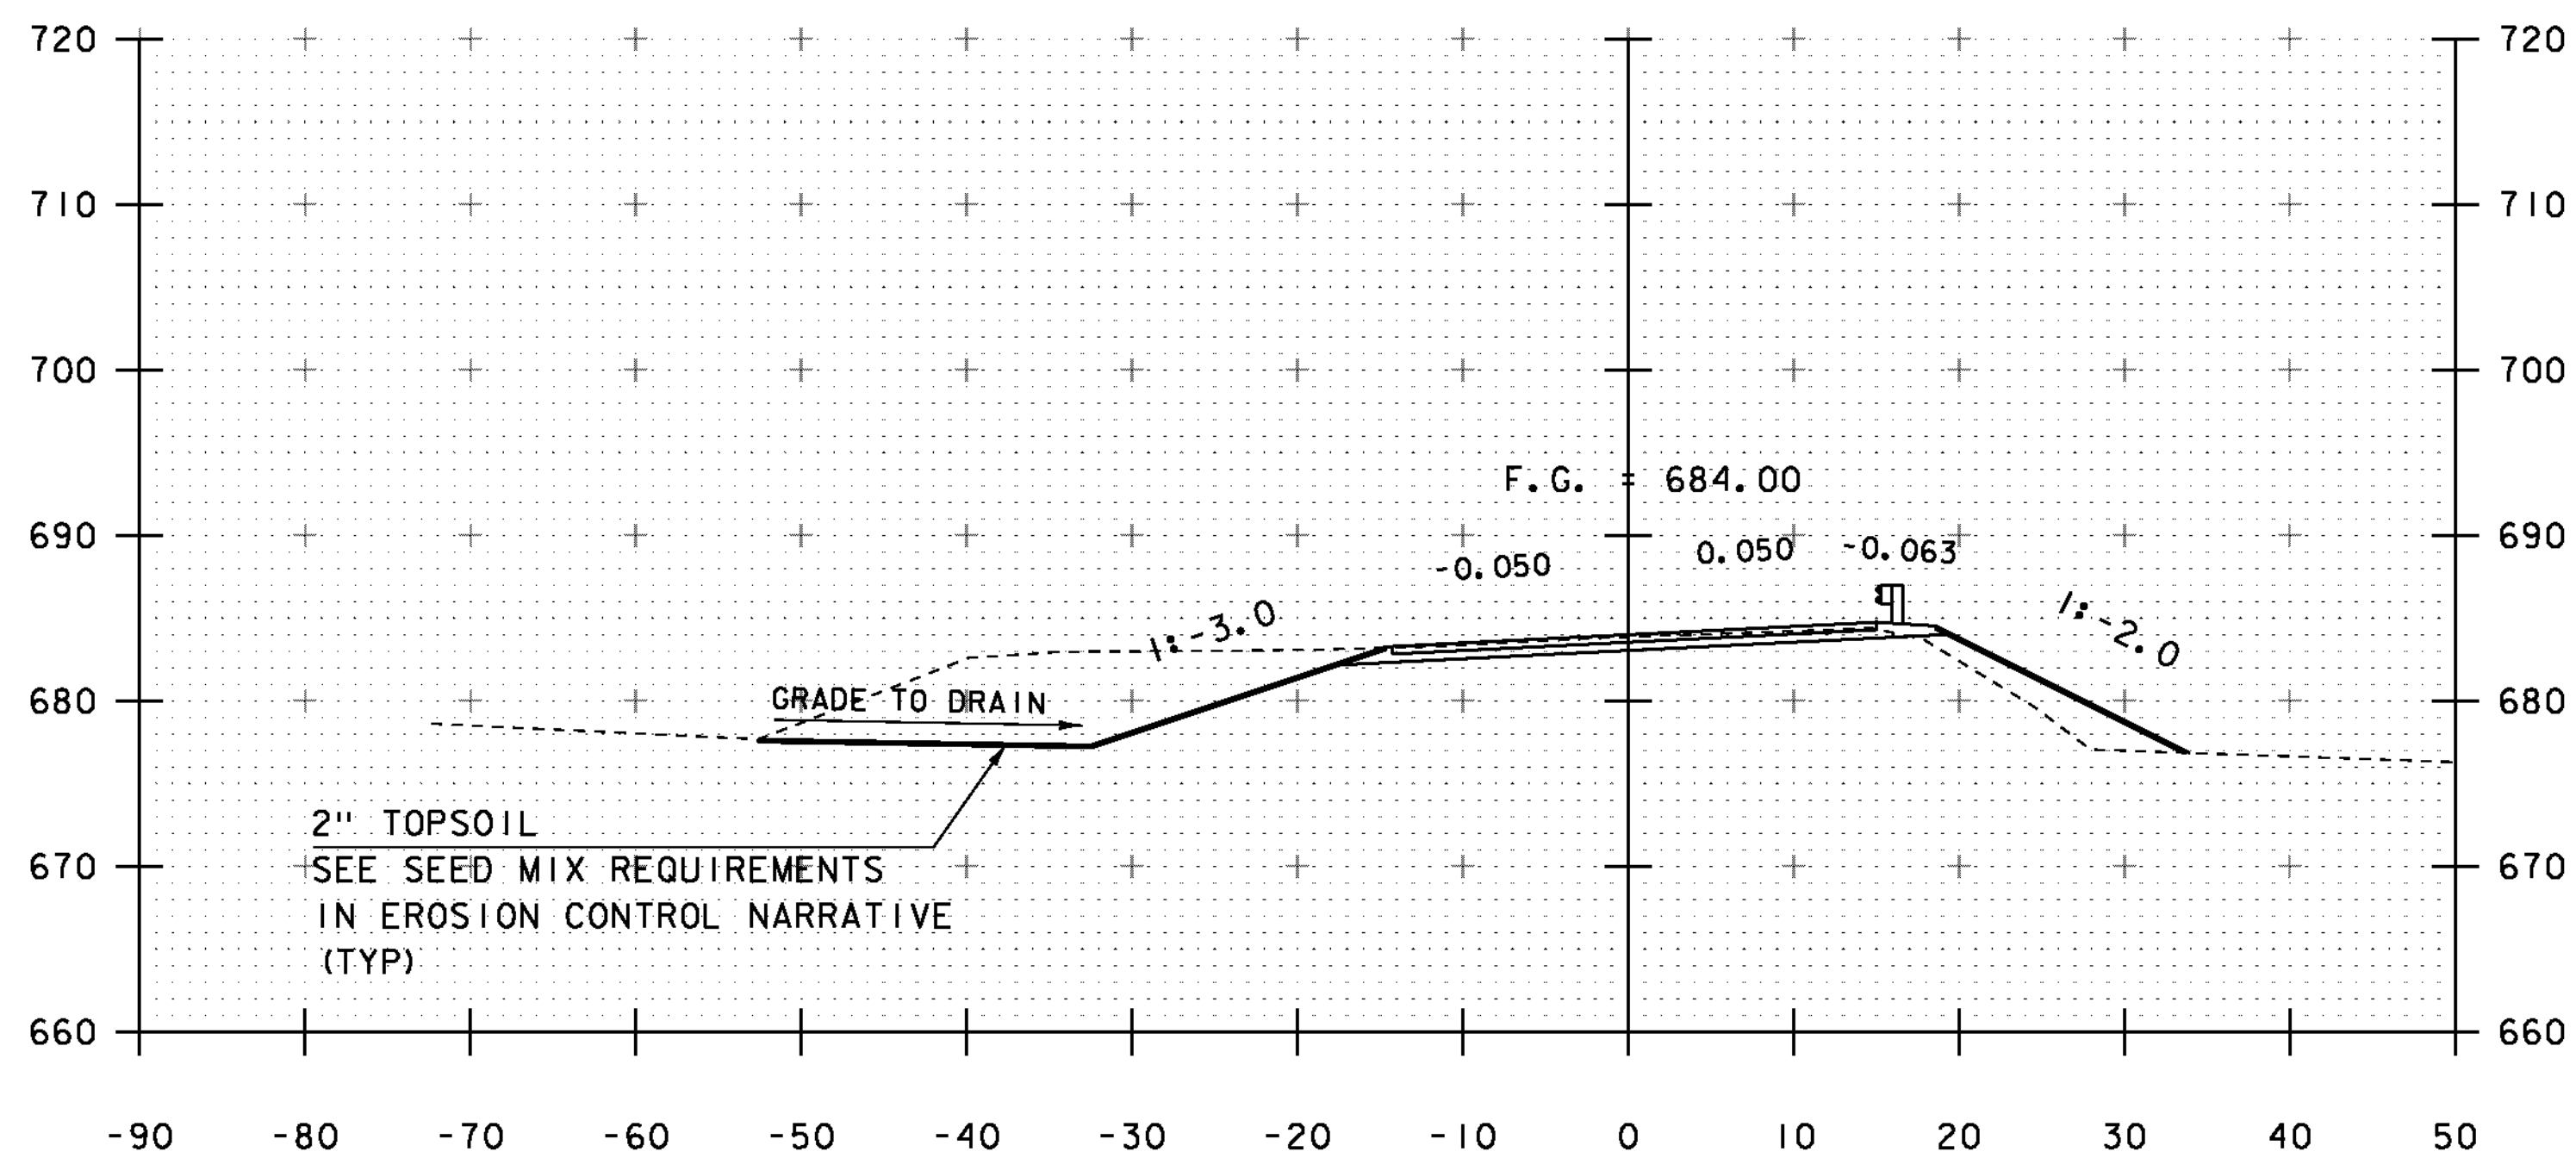

122+75

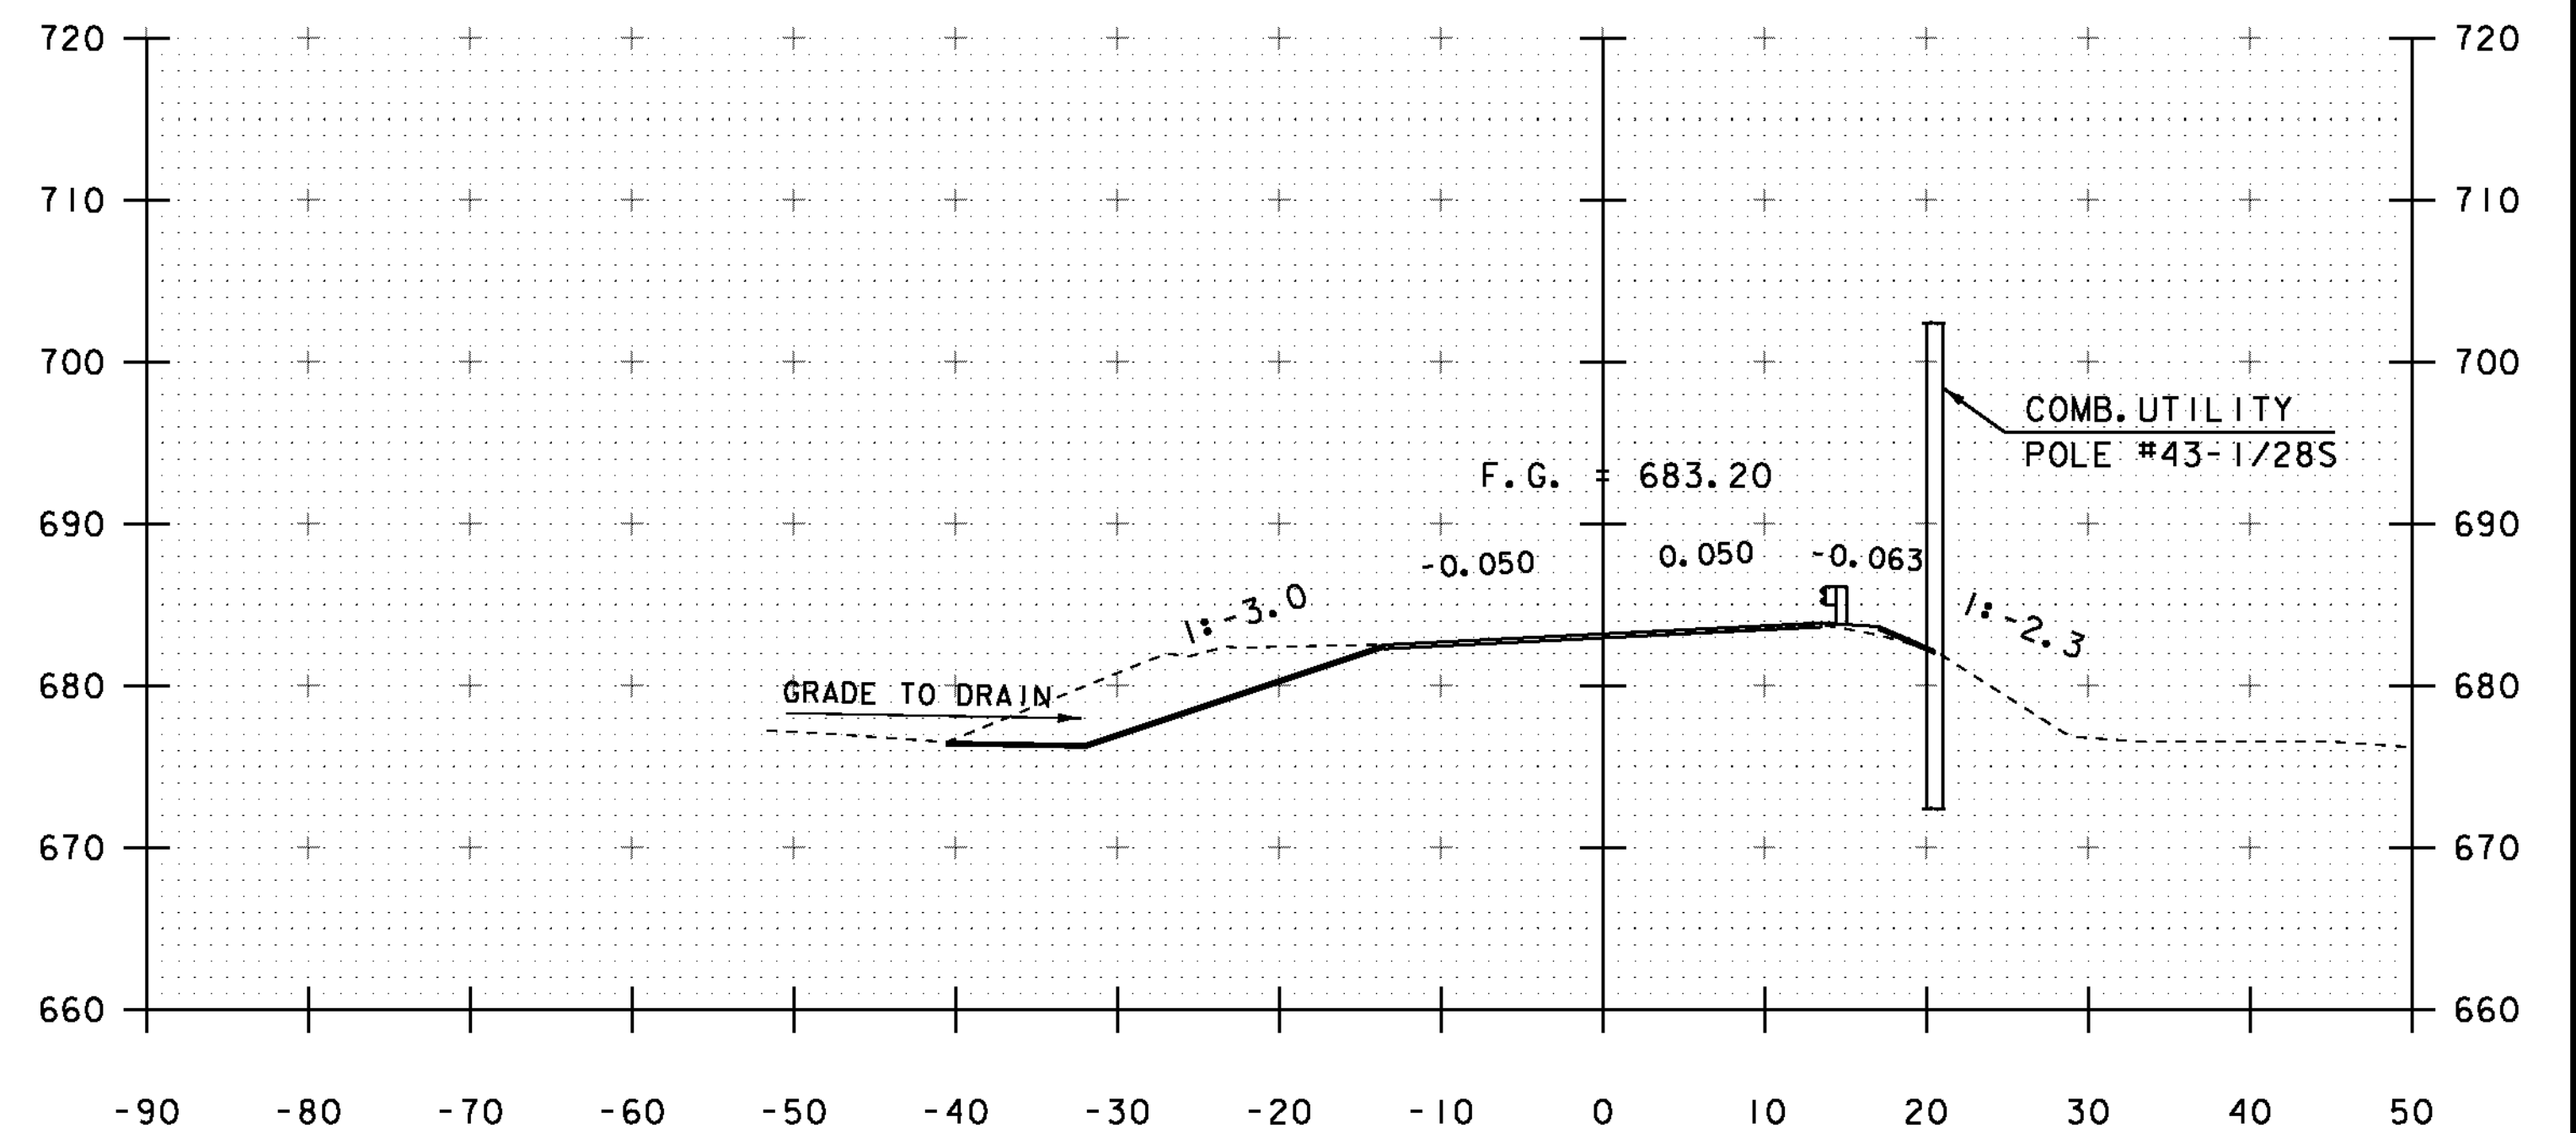

123+25

SCALE 1" = 10' - 0"  
  
 STA. 122+75 TO STA. 123+50

PROJECT NAME: JAMAICA	PLOT DATE: 12-OCT-2012
PROJECT NUMBER: ER-BRF 013-1(16)	DRAWN BY: K. FRIEDLAND
FILE NAME: s11b212xs.dgn	CHECKED BY: G. LAROCHE
PROJECT LEADER: K. HIGGINS	SHEET 68 OF 85
DESIGNED BY: G. LAROCHE	MAINLINE CROSS SECTION 8