




STA 51+24.00 RT (ABUT #2)
 BEGIN UNCLASSIFIED CHANNEL EXCAVATION
 BEGIN STONE FILL, TYPE IV
 BEGIN GEOTEXTILE UNDER STONE FILL
 BEGIN GRUBBING MATERIAL

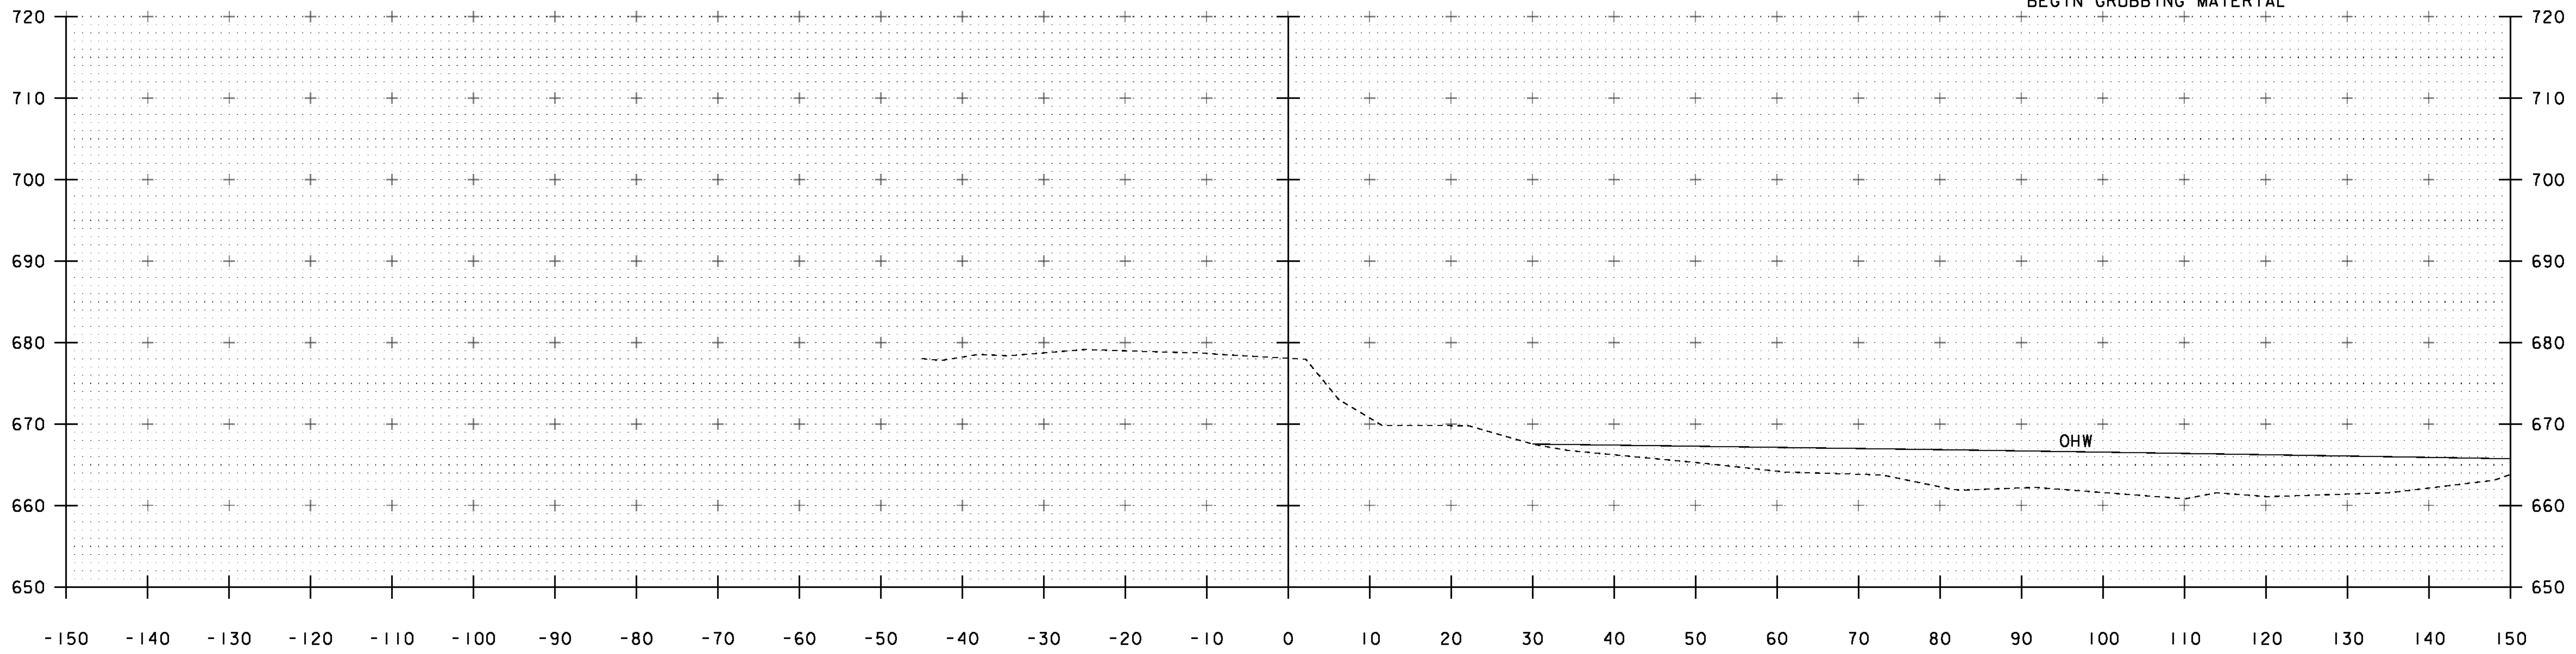

51+25

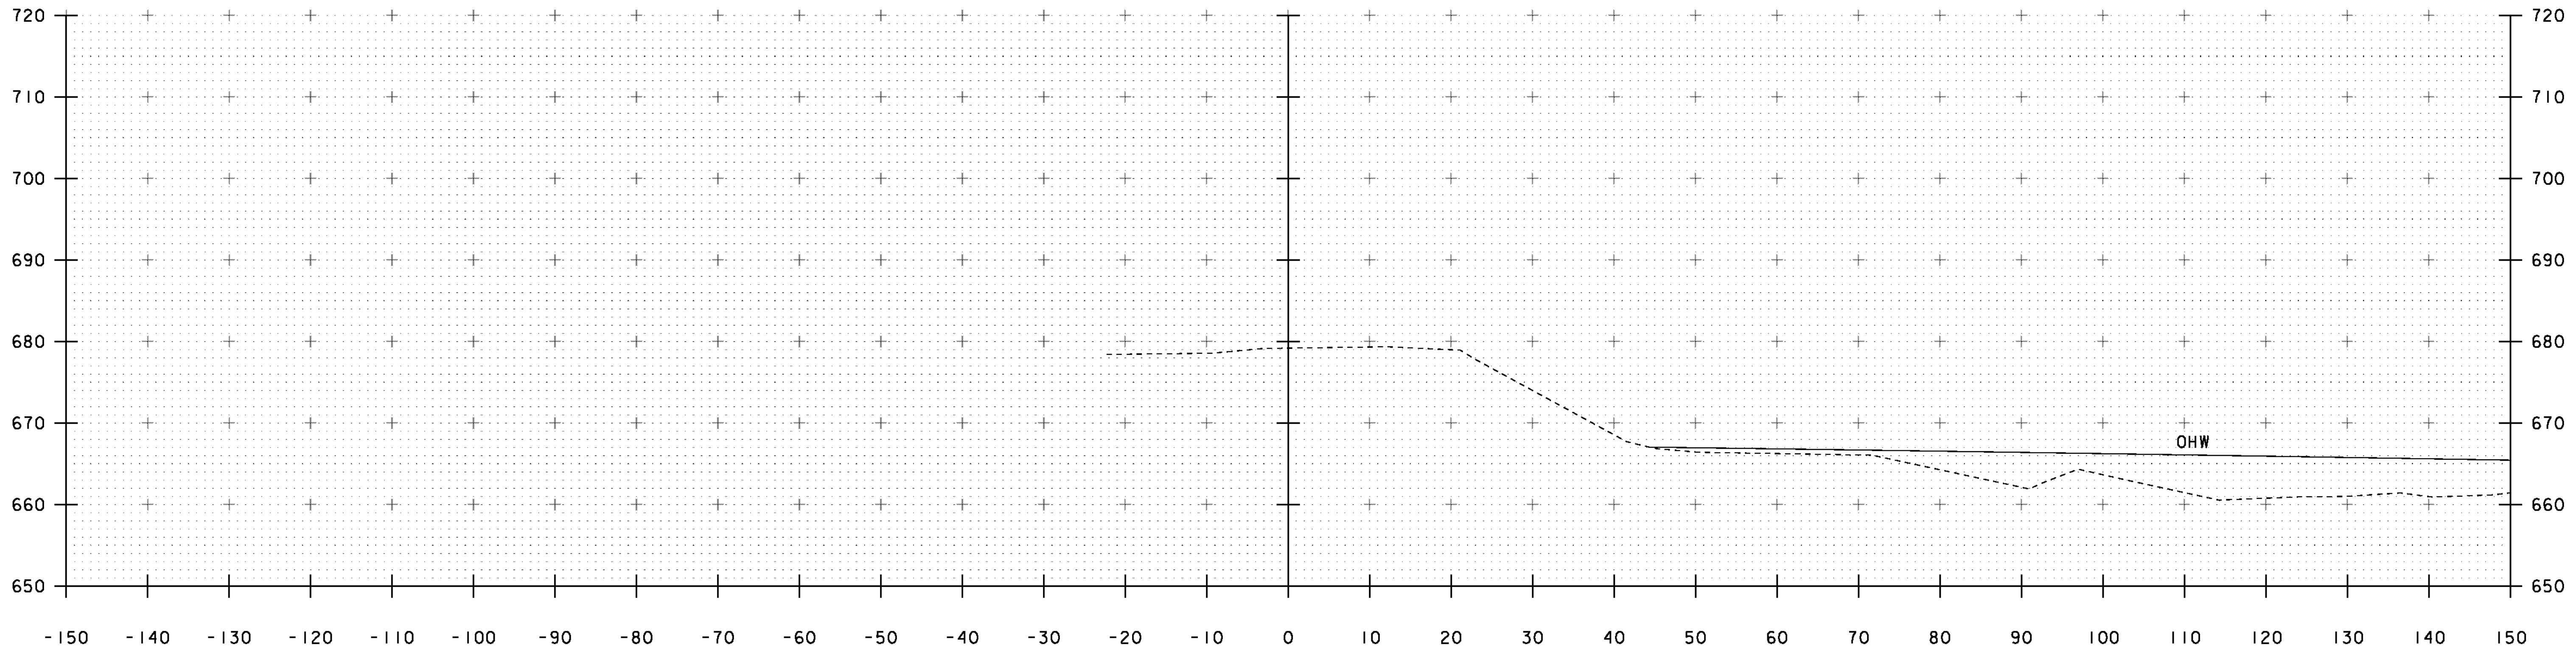

51+00

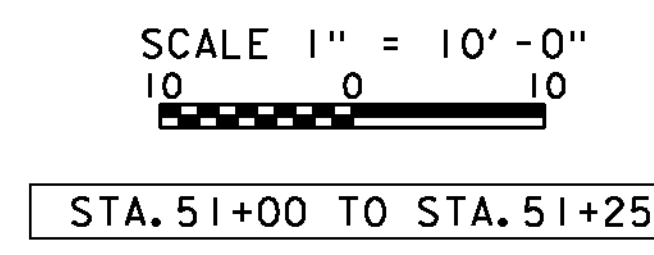

PROJECT NAME:	JAMAICA	PLOT DATE:	12-OCT-2012
PROJECT NUMBER:	ER-BRF 013-1(16)	DRAWN BY:	K. FRIEDLAND
FILE NAME:	s11b212xs.dgn	CHECKED BY:	G. LAROCHE
PROJECT LEADER:	K. HIGGINS	SHEET	70 OF 85
DESIGNED BY:	G. LAROCHE	CHANNEL CROSS SECTIONS 1	