
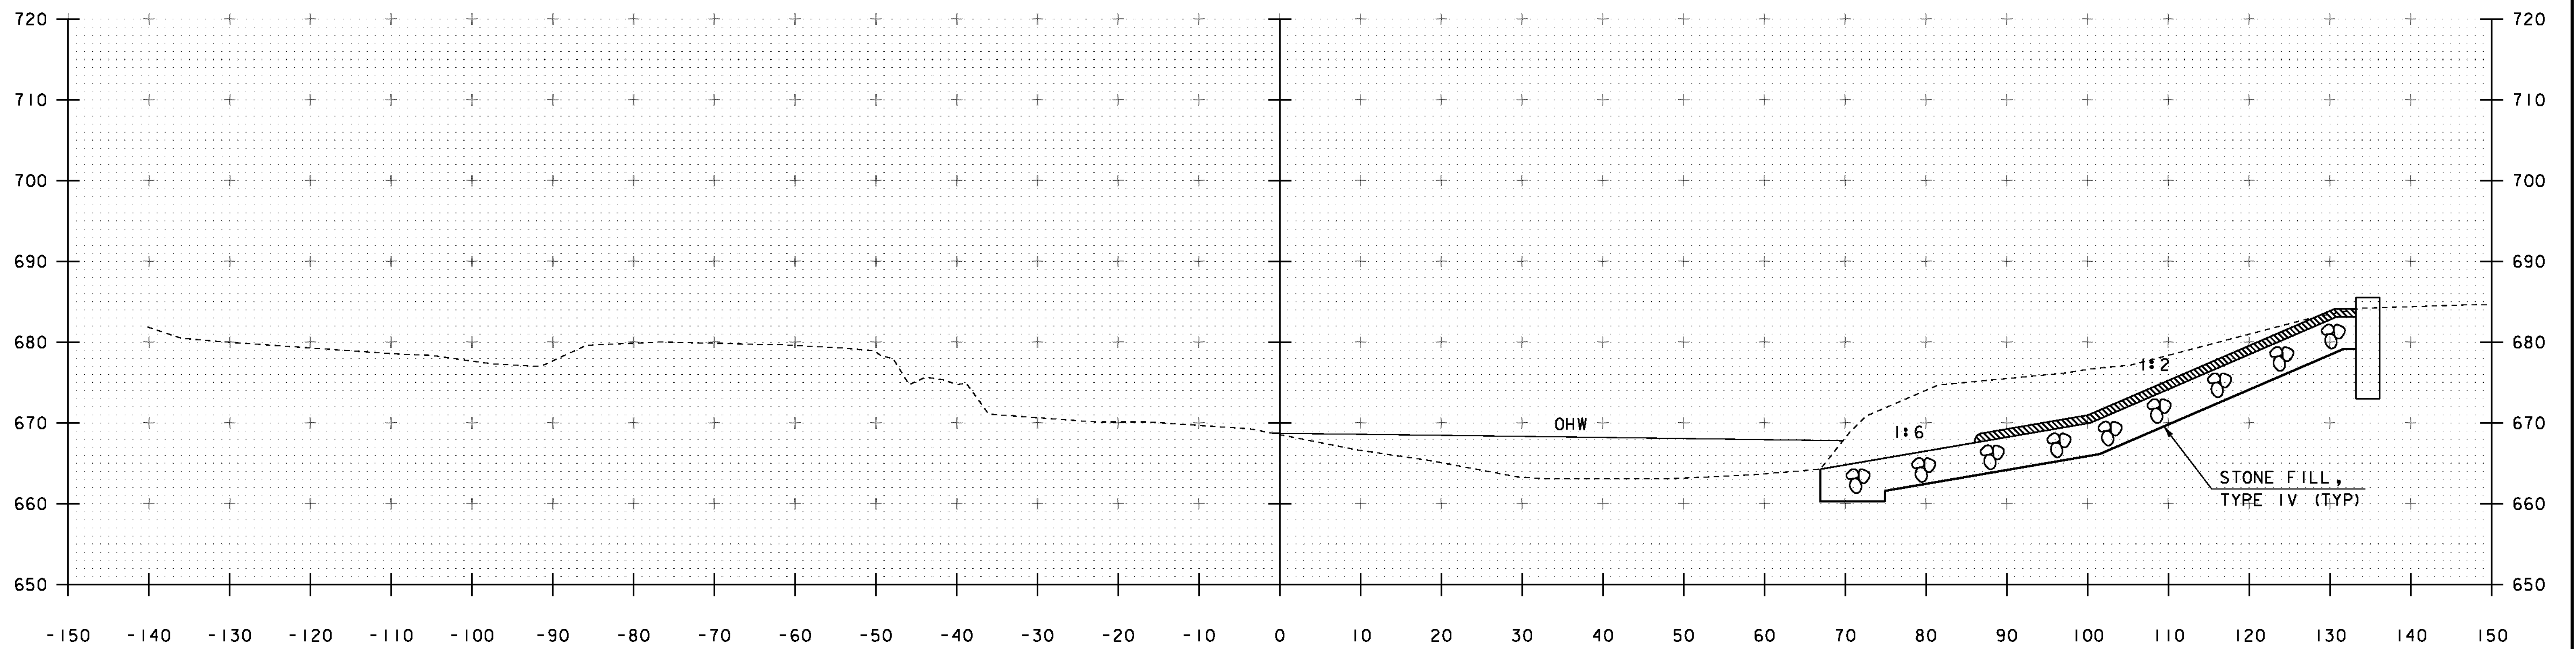


51+90

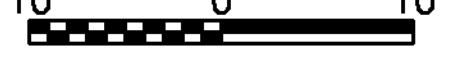

51+80

SCALE 1" = 10' - 0"  
  
 STA. 51+80 TO STA. 51+90

PROJECT NAME: JAMAICA	PLOT DATE: 12-OCT-2012
PROJECT NUMBER: ER-BRF 013-1(16)	DRAWN BY: K. FRIEDLAND
FILE NAME: s11b212xs.dgn	CHECKED BY: G. LAROCHE
PROJECT LEADER: K. HIGGINS	SHEET 72 OF 85
DESIGNED BY: G. LAROCHE	
CHANNEL CROSS SECTIONS 3	