


52+10

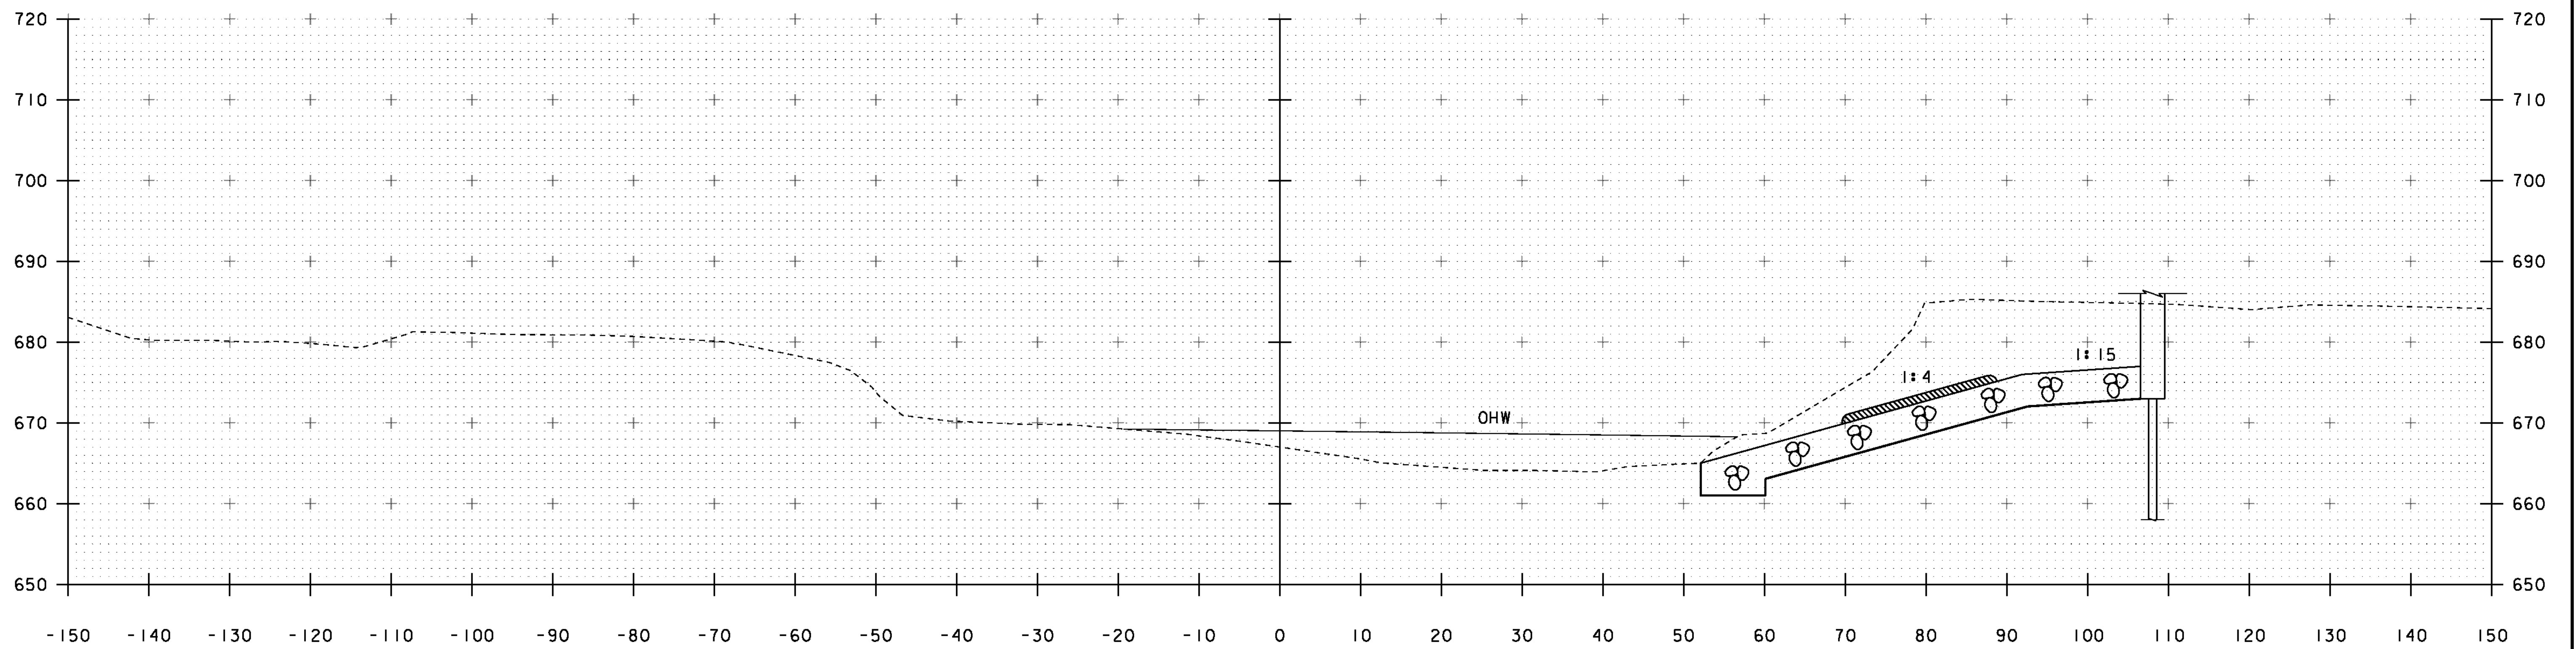

52+00

STA 52+10.00 LT (ABUT #1)
 BEGIN UNCLASSIFIED CHANNEL EXCAVATION
 BEGIN STONE FILL, TYPE IV
 BEGIN GEOTEXTILE UNDER STONE FILL
 BEGIN GRUBBING MATERIAL

SCALE 1" = 10' - 0"
 10 0 10

STA. 52+00 TO STA. 52+10

PROJECT NAME:	JAMAICA	PLOT DATE:	12-OCT-2012
PROJECT NUMBER:	ER-BRF 013-1(16)	DRAWN BY:	K. FRIEDLAND
FILE NAME:	s1b212xs.dgn	CHECKED BY:	G. LAROCHE
PROJECT LEADER:	K. HIGGINS	SHEET	73 OF 85
DESIGNED BY:	G. LAROCHE	CHANNEL CROSS SECTIONS	4