



52+50

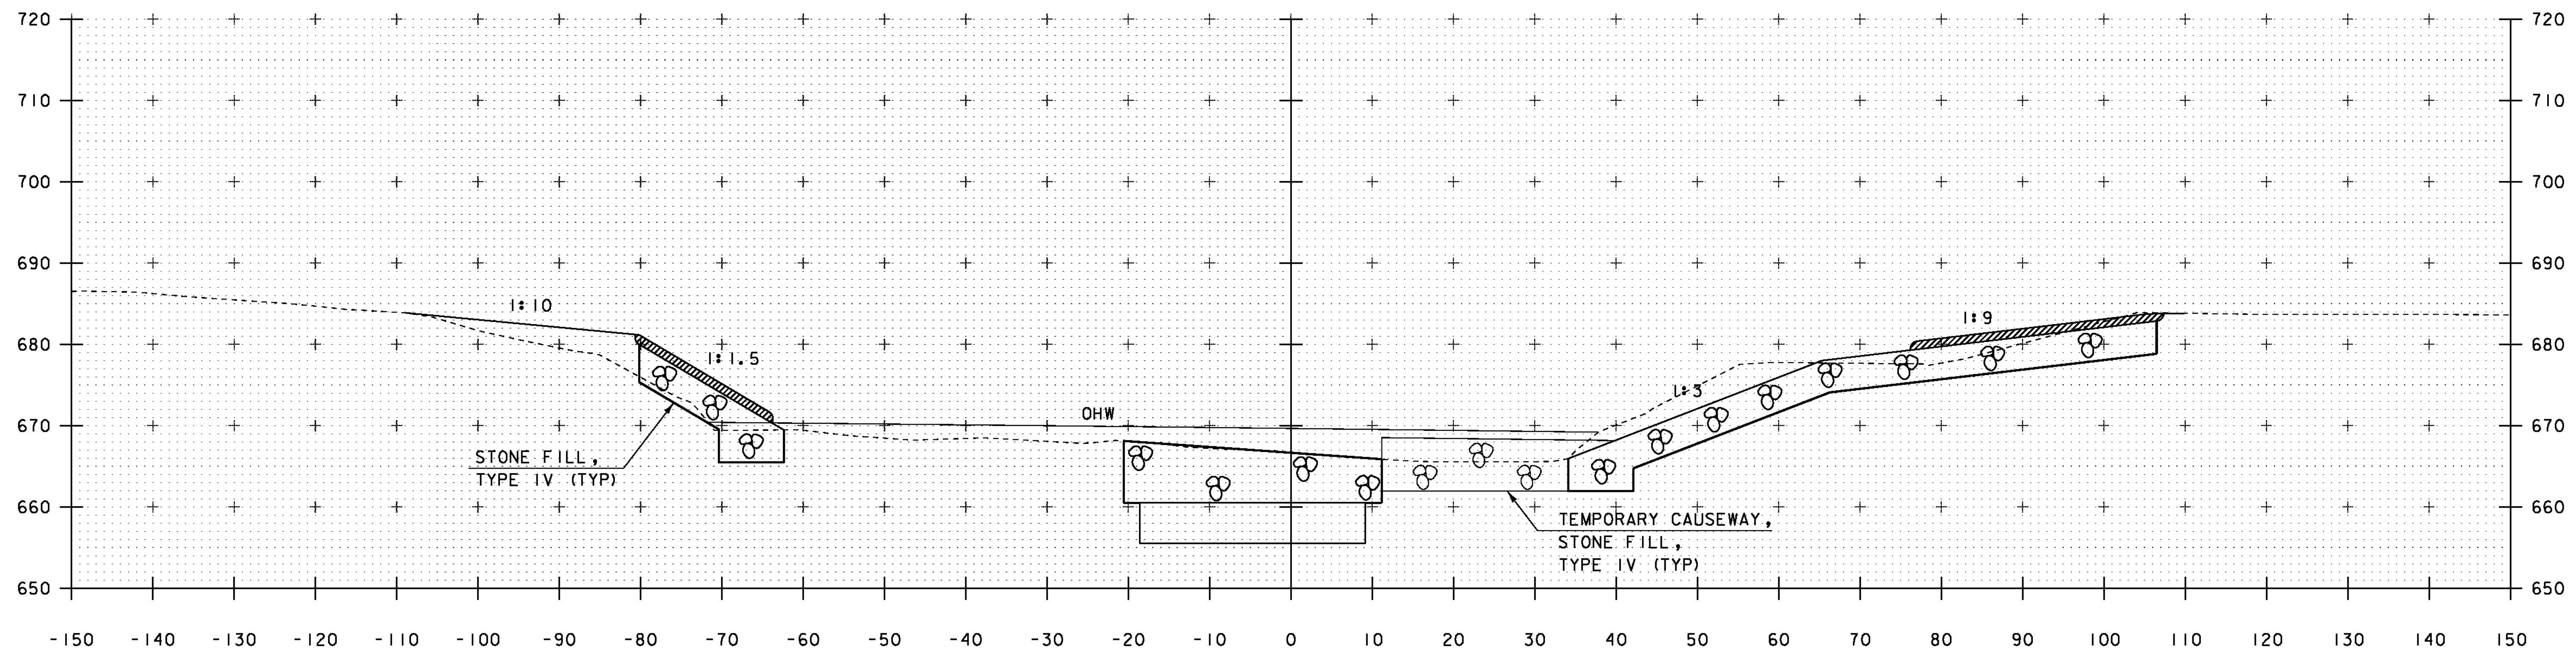

52+40

STA 52+31.00 RT (ABUT #2)
BEGIN GRUBBING MATERIAL

NOTE: SUPERSTRUCTURE OMITTED FOR CLARITY

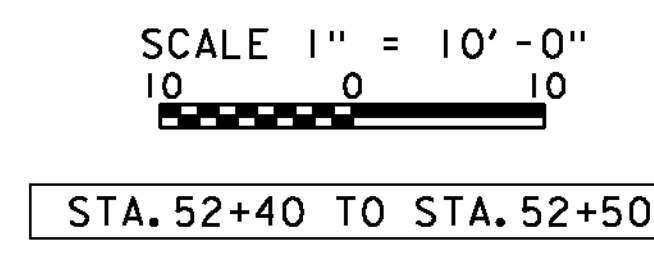

PROJECT NAME:	JAMAICA	PLOT DATE:	12-OCT-2012
PROJECT NUMBER:	ER-BRF 013-1(16)	DRAWN BY:	K. FRIEDLAND
FILE NAME:	s1b212xs.dgn	CHECKED BY:	G. LAROCHE
PROJECT LEADER:	K. HIGGINS	SHEET	75 OF 85
DESIGNED BY:	G. LAROCHE		
CHANNEL CROSS SECTIONS	6		