


52+70

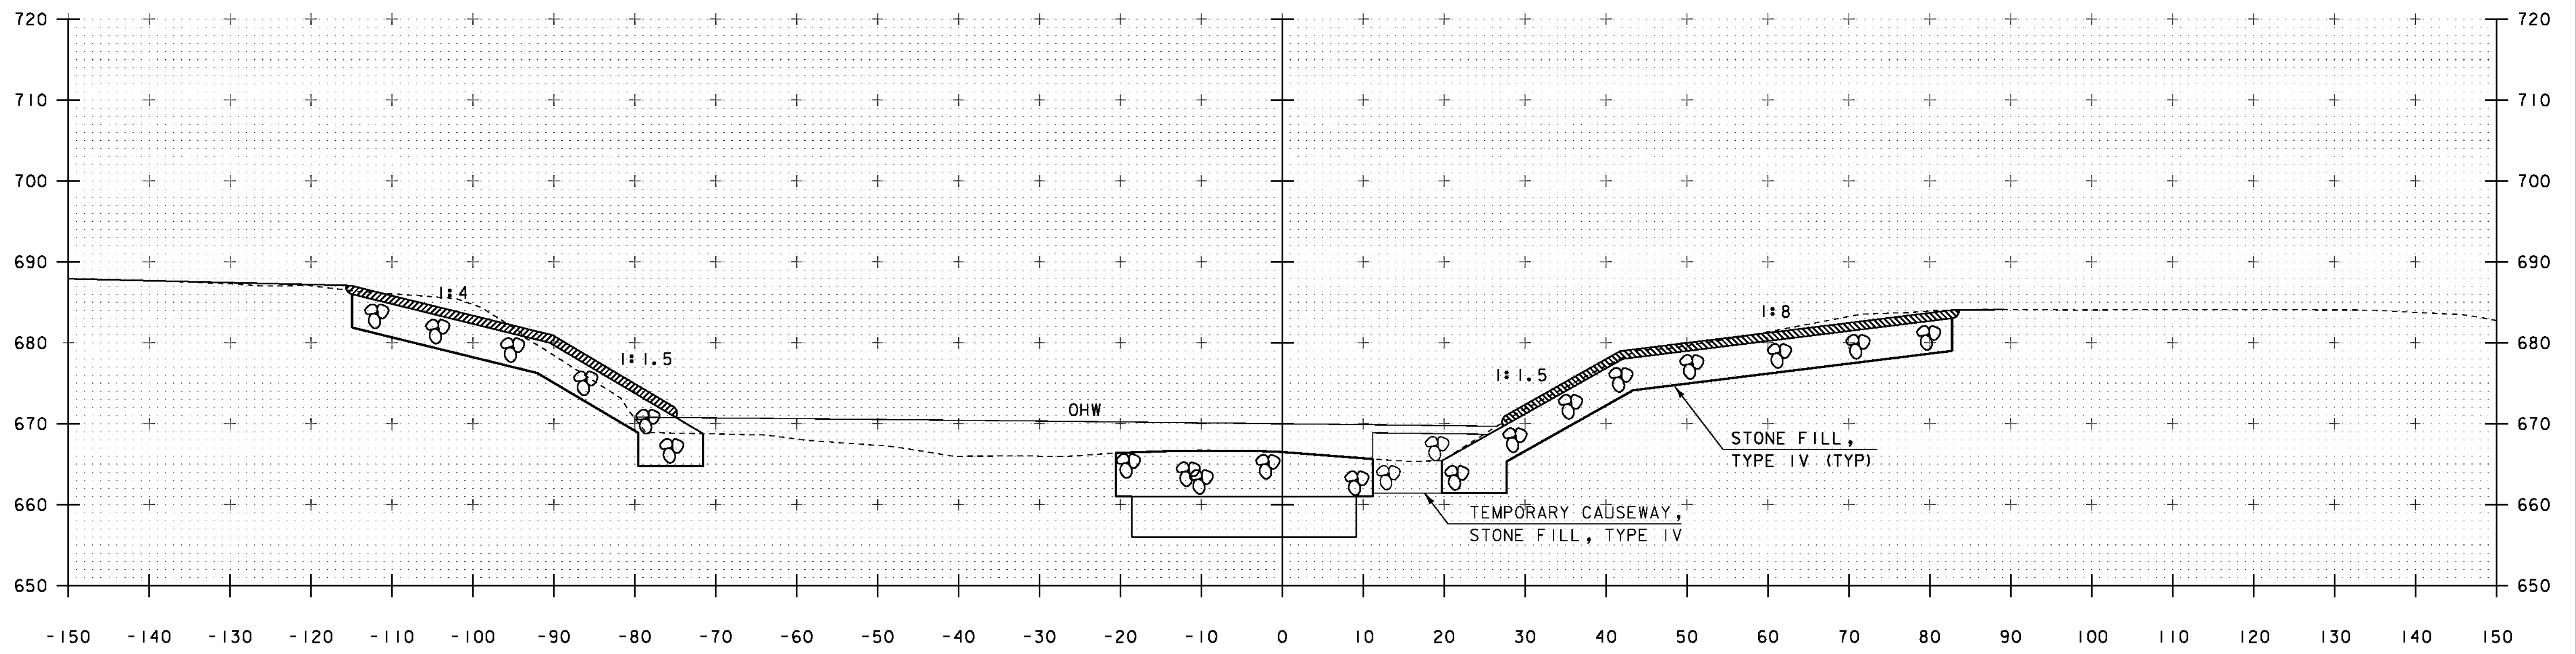

52+60

STA 52+58.00 LT (ABUT #1)
END GRUBBING MATERIAL

NOTE: SUPERSTRUCTURE OMITTED FOR CLARITY

SCALE 1" = 10' - 0"
10 0 10

STA. 52+60 TO STA. 52+70

PROJECT NAME: JAMAICA	
PROJECT NUMBER: ER-BRF 013-1(16)	
FILE NAME: s11b212xs.dgn	PLOT DATE: 12-OCT-2012
PROJECT LEADER: K. HIGGINS	DRAWN BY: K. FRIEDLAND
DESIGNED BY: G. LAROCHE	CHECKED BY: G. LAROCHE
CHANNEL CROSS SECTIONS 7	SHEET 76 OF 85