


52+90

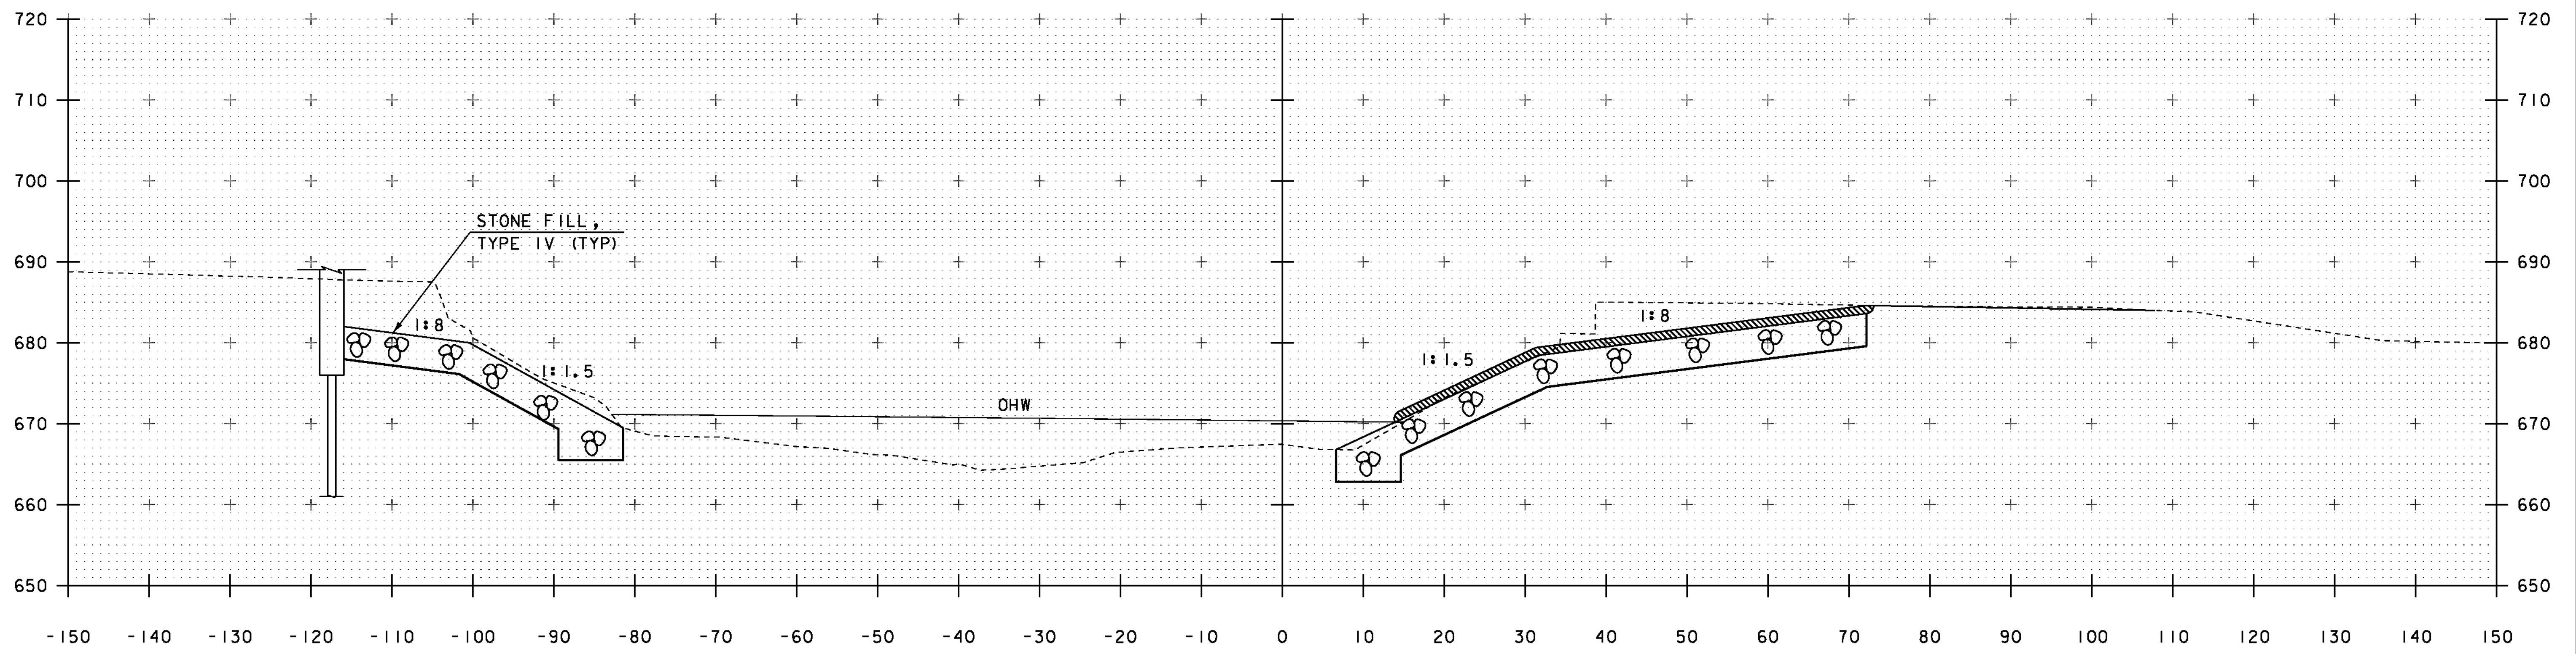

52+80

NOTE: SUPERSTRUCTURE OMITTED FOR CLARITY

SCALE 1" = 10'-0"
 10 0 10

STA. 52+80 TO STA. 52+90

PROJECT NAME: JAMAICA	PLOT DATE: 12-OCT-2012
PROJECT NUMBER: ER-BRF 013-1(16)	DRAWN BY: K. FRIEDLAND
FILE NAME: s11b212xs.dgn	DESIGNED BY: G. LAROCHE
PROJECT LEADER: K. HIGGINS	CHECKED BY: G. LAROCHE
CHANNEL CROSS SECTIONS 8	SHEET 77 OF 85