


53+10

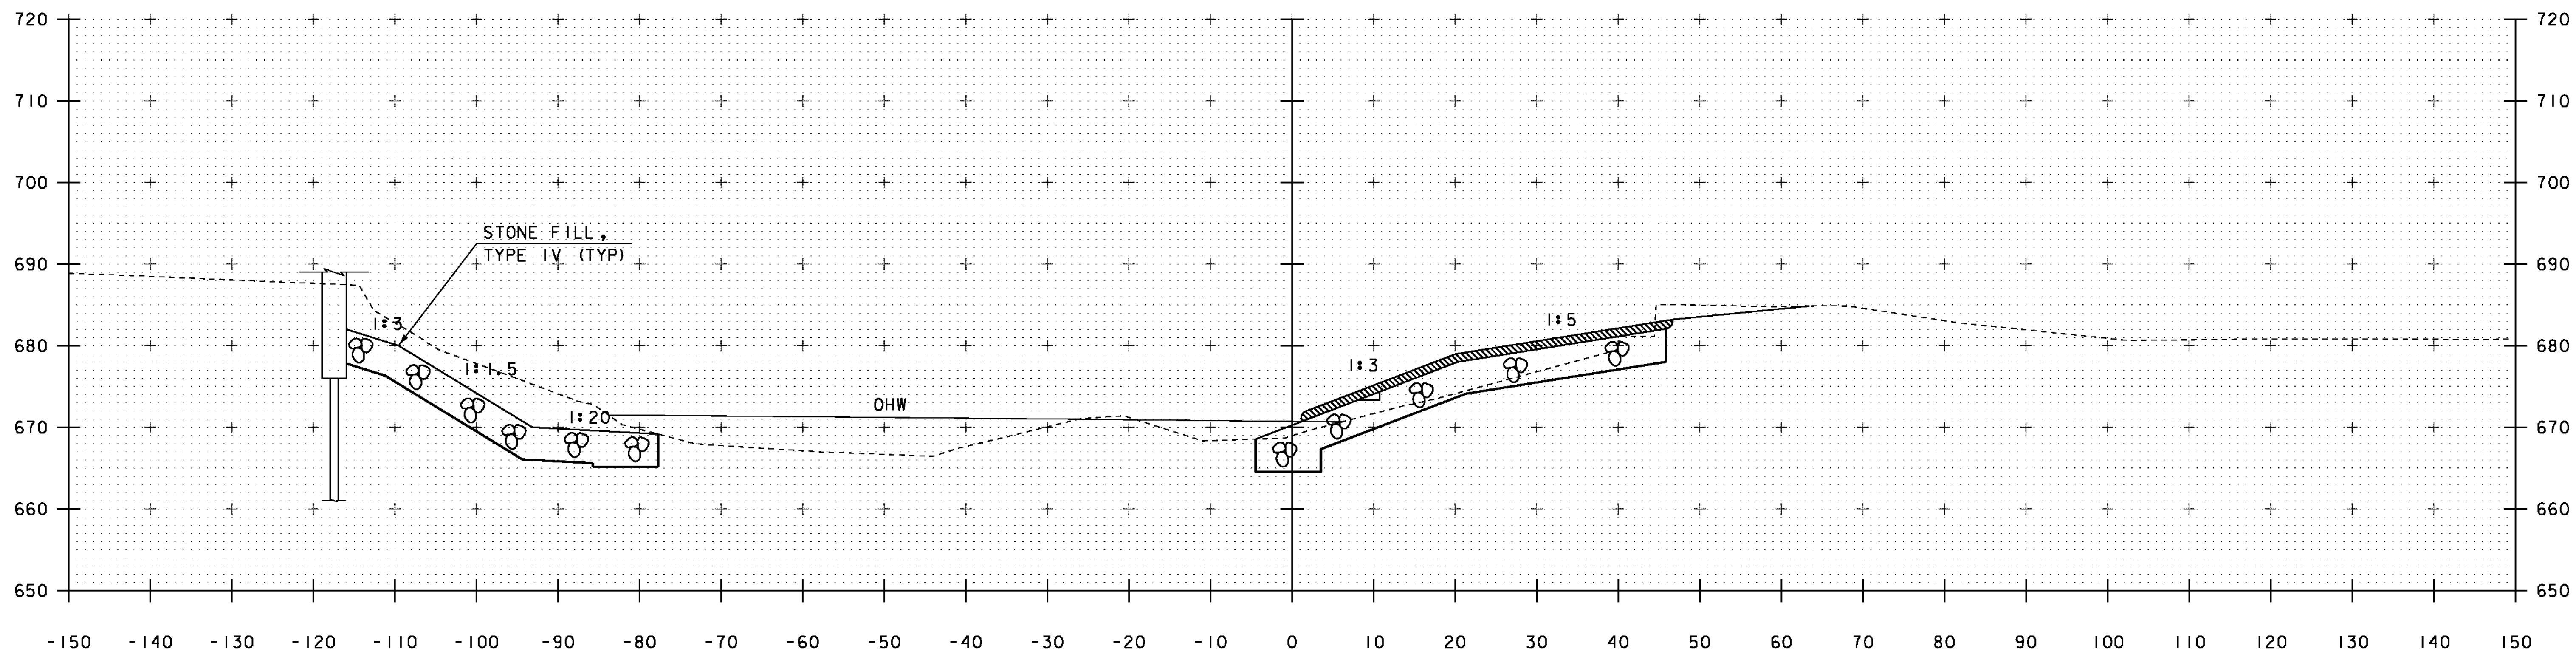

53+00

STA 52+97.00 LT (ABUT #1)
BEGIN GRUBBING MATERIAL

NOTE: SUPERSTRUCTURE OMITTED FOR CLARITY

SCALE 1" = 10' - 0"
10 0 10

STA. 53+00 TO STA. 53+10

PROJECT NAME: JAMAICA
PROJECT NUMBER: ER-BRF 013-1(16)

FILE NAME: s11b212xs.dgn
PROJECT LEADER: K. HIGGINS
DESIGNED BY: G. LAROCHE
CHANNEL CROSS SECTIONS 9

PLOT DATE: 12-OCT-2012
DRAWN BY: K. FRIEDLAND
CHECKED BY: G. LAROCHE
SHEET 78 OF 85