


53+75

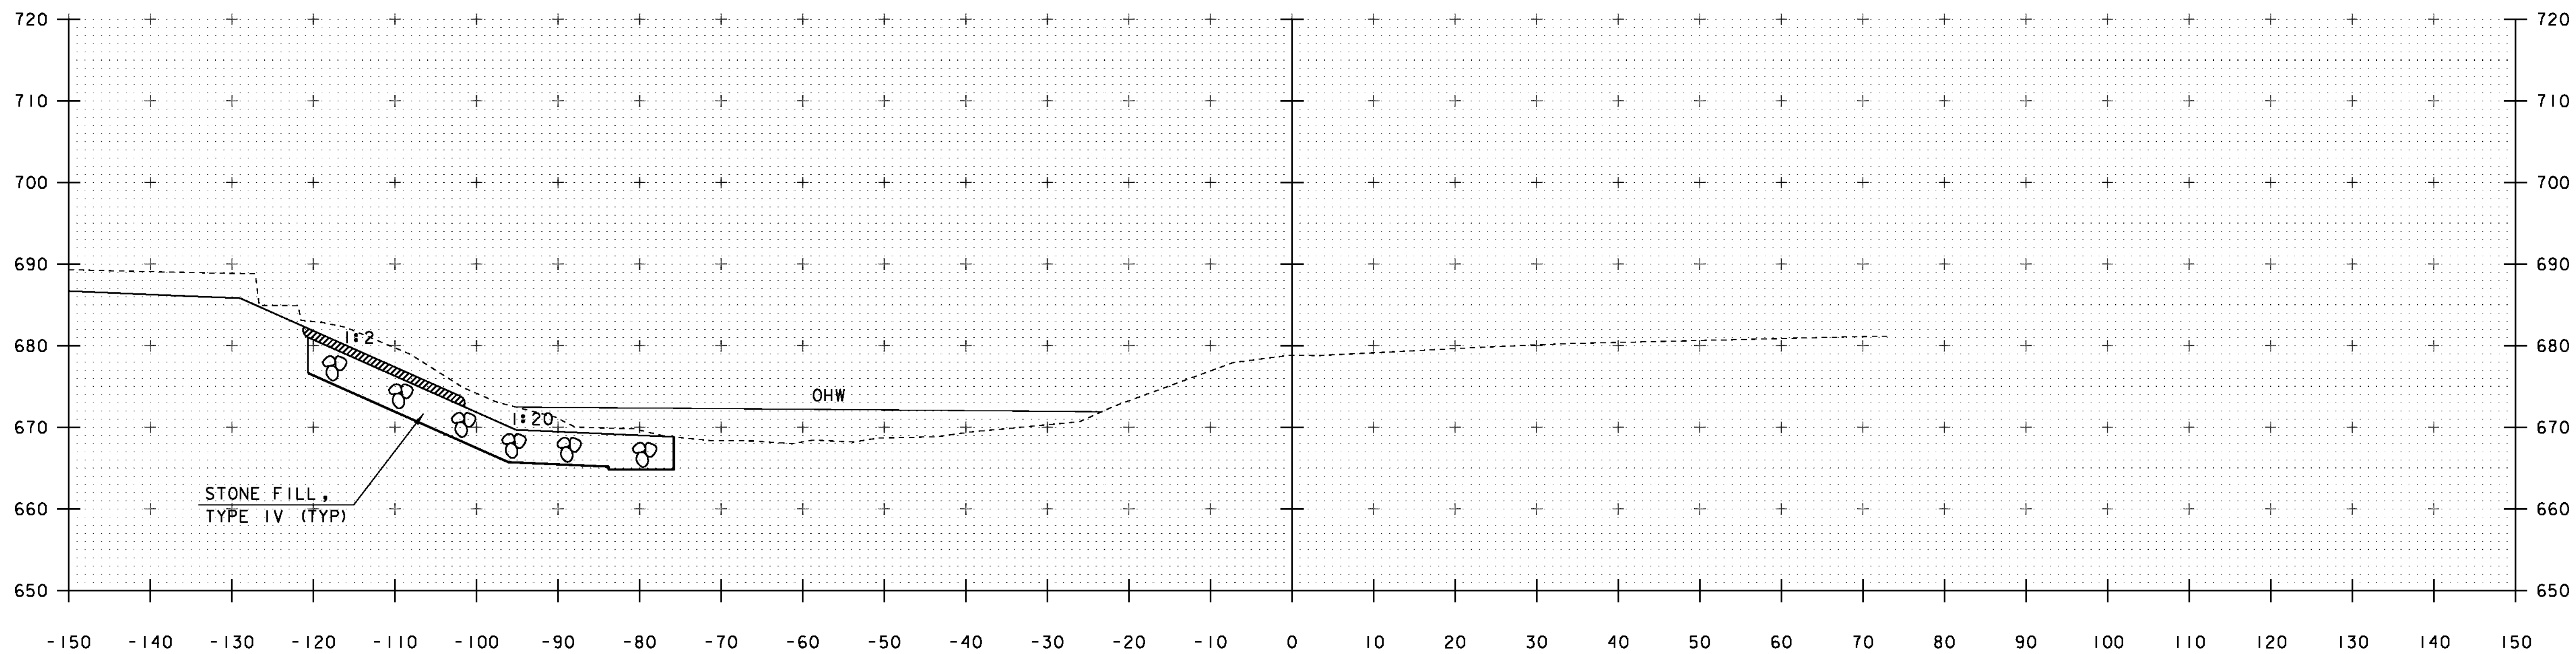

53+50

STA 53+42.00 RT (ABUT #2)
 END UNCLASSIFIED CHANNEL EXCAVATION
 END STONE FILL, TYPE IV
 END GEOTEXTILE UNDER STONE FILL
 END GRUBBING MATERIAL

SCALE 1" = 10' - 0"
 10 0 10

STA. 53+50 TO STA. 53+75

NOTE: SUPERSTRUCTURE OMITTED FOR CLARITY

PROJECT NAME: JAMAICA
 PROJECT NUMBER: ER-BRF 013-1(16)

FILE NAME: s11b212xs.dgn
 PROJECT LEADER: K. HIGGINS
 DESIGNED BY: G. LAROCHE
 CHANNEL CROSS SECTIONS II

PLOT DATE: 12-OCT-2012
 DRAWN BY: K. FRIEDLAND
 CHECKED BY: G. LAROCHE
 SHEET 80 OF 85