


54+25

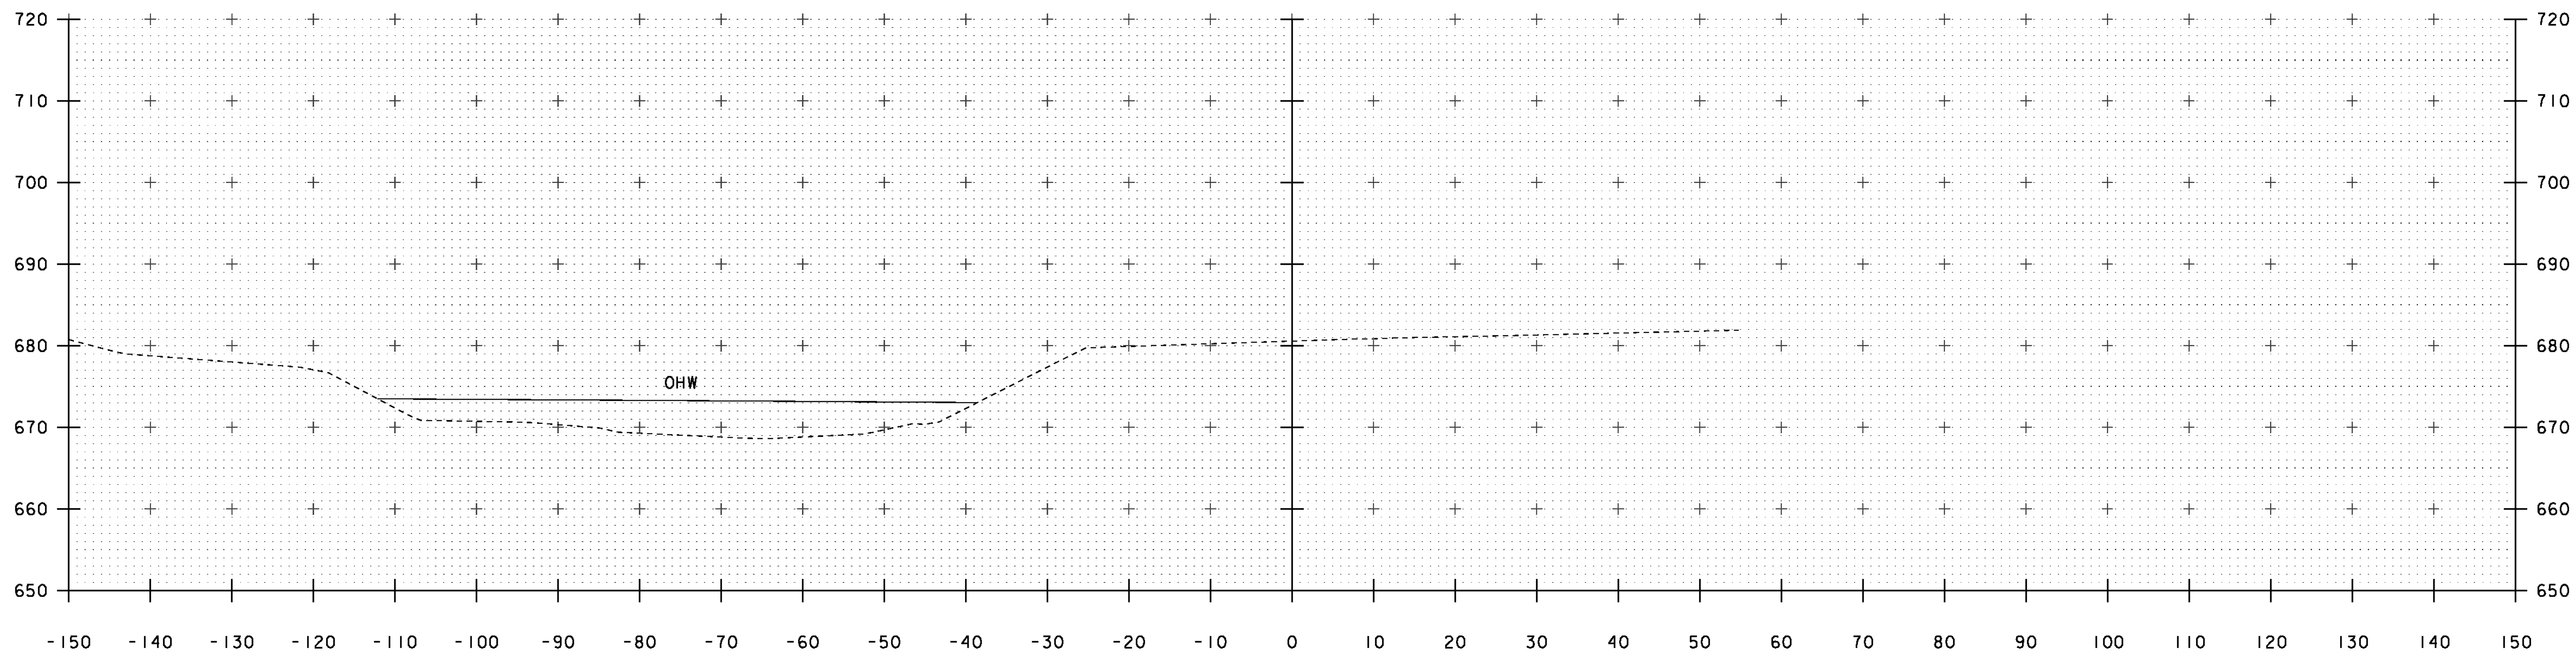

54+00

STA 53+98 LT (ABUT #1)
 END UNCLASSIFIED CHANNEL EXCAVATION
 END STONE FILL, TYPE IV
 END GEOTEXTILE UNDER STONE FILL
 END GRUBBING MATERIAL

NOTE: SUPERSTRUCTURE OMITTED FOR CLARITY

SCALE 1" = 10' - 0"
 10 0 10

STA. 54+00 TO STA. 54+25

PROJECT NAME: JAMAICA
 PROJECT NUMBER: ER-BRF 013-1(16)

FILE NAME: s11b212xs.dgn
 PROJECT LEADER: K. HIGGINS
 DESIGNED BY: G. LAROCHE
 CHANNEL CROSS SECTIONS 12

PLOT DATE: 12-OCT-2012
 DRAWN BY: K. FRIEDLAND
 CHECKED BY: G. LAROCHE
 SHEET 81 OF 85