



Volume: ±16.78 CY
Weight: ±67,103 lbs

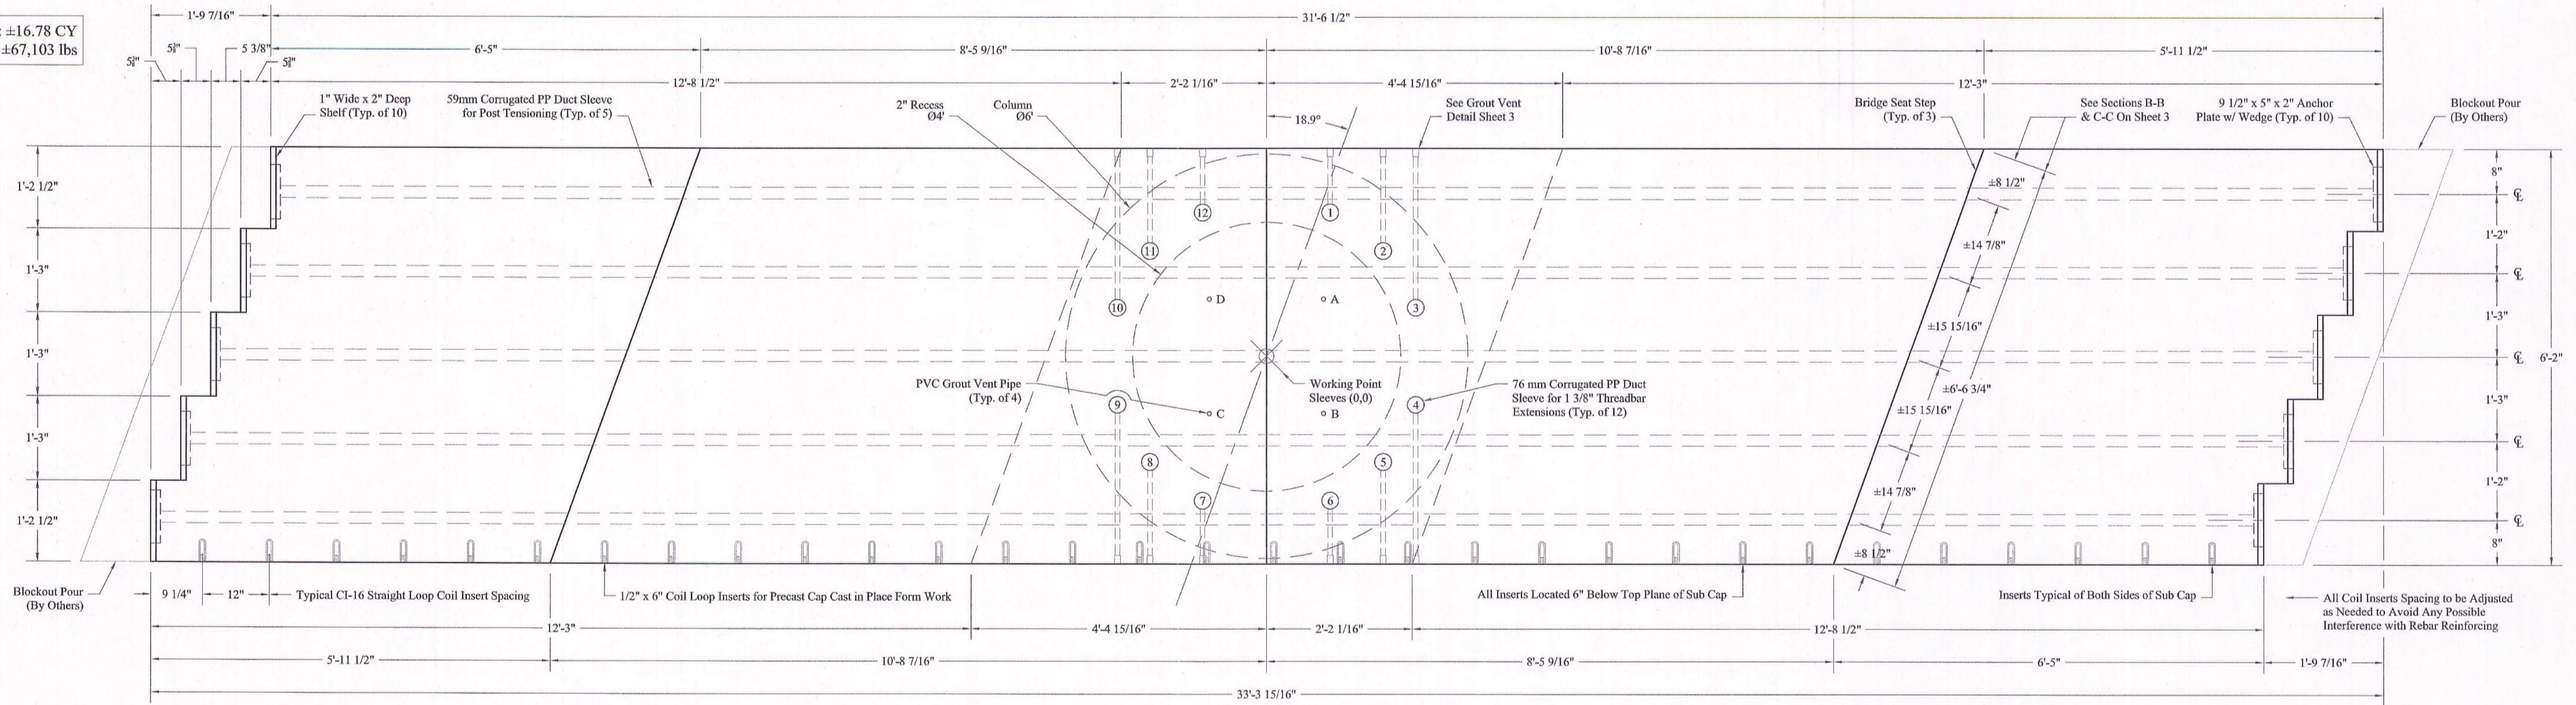

Plan View

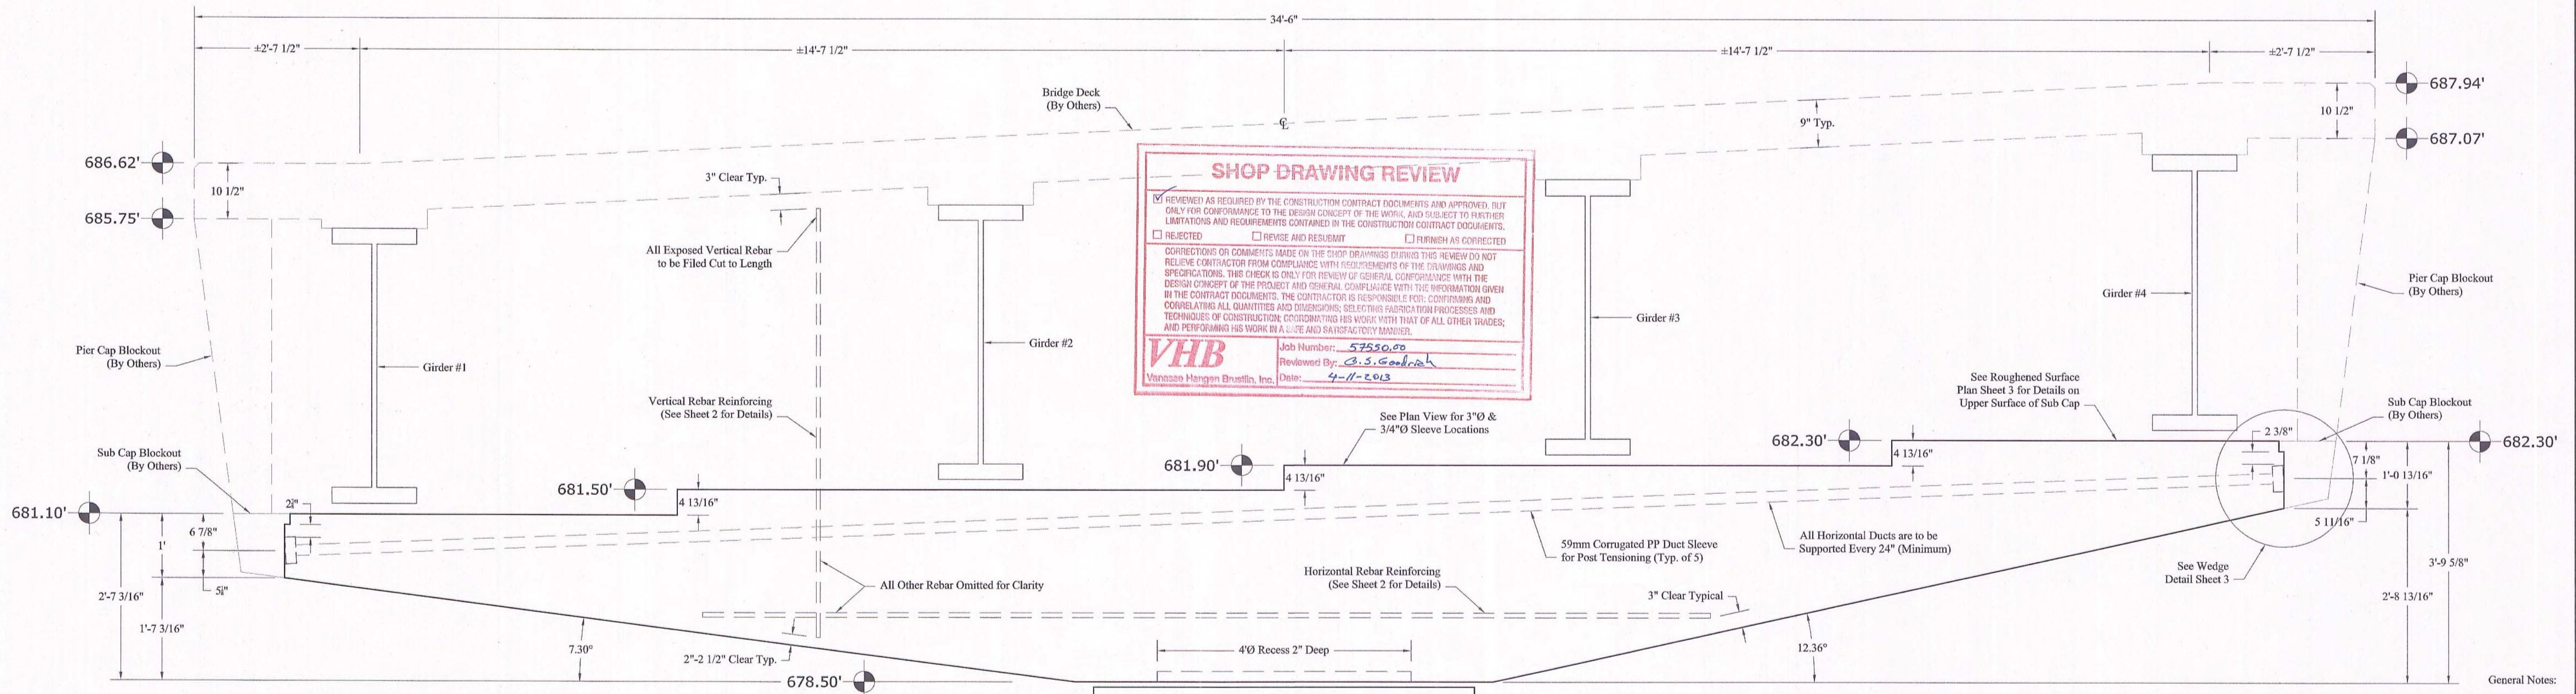

SHOP DRAWING REVIEW

REVIEWED AS REQUIRED BY THE CONSTRUCTION CONTRACT DOCUMENTS AND APPROVED, BUT ONLY FOR CONFORMANCE TO THE DESIGN CONCEPT OF THE WORK, AND SUBJECT TO FURTHER LIMITATIONS AND REQUIREMENTS CONTAINED IN THE CONSTRUCTION CONTRACT DOCUMENTS.

REJECTED REVISE AND RESUBMIT FINISH AS CORRECTED

CORRECTIONS OR COMMENTS MADE ON THE SHOP DRAWINGS DURING THIS REVIEW DO NOT RELIEVE CONTRACTOR FROM COMPLIANCE WITH REQUIREMENTS OF THE DRAWINGS AND SPECIFICATIONS. THIS CHECK IS ONLY FOR REVIEW OF GENERAL CONFORMANCE WITH THE DESIGN CONCEPT OF THE PROJECT AND GENERAL COMPLIANCE WITH THE INFORMATION GIVEN IN THE CONTRACT DOCUMENTS. THE CONTRACTOR IS RESPONSIBLE FOR CONTINUING AND CORRELATING ALL QUANTITIES AND DIMENSIONS; SELECTING FABRICATION PROCESSES AND TECHNIQUES OF CONSTRUCTION; COORDINATING HIS WORK WITH THAT OF ALL OTHER TRADES; AND PERFORMING HIS WORK IN A SAFE AND SATISFACTORY MANNER.

VHB
Vannoy Hagen Brunelle, Inc.

Job Number: 57550.00
Reviewed By: C.S. Gendron
Date: 4-11-2013

Sleeve Legend & Coordinates

Mark	Ø	X	Y	Mark	Ø	X	Y	Mark	Ø	X	Y
1	3"	11 7/16"	2'-1 11/16"	7	3"	-11 7/16"	-2'-1 11/16"	A	3/4"	10 1/4"	10 1/4"
2	3"	1'-8 7/8"	1'-6 13/16"	8	3"	-1'-8 7/8"	-1'-6 13/16"	B	3/4"	10 1/4"	-10 1/4"
3	3"	2'-2 11/16"	8 11/16"	9	3"	-2'-2 11/16"	-8 11/16"	C	3/4"	-10 1/4"	-10 1/4"
4	3"	2'-2 11/16"	-8 11/16"	10	3"	-2'-2 11/16"	8 11/16"	D	3/4"	-10 1/4"	10 1/4"
5	3"	1'-8 7/8"	-1'-6 13/16"	11	3"	-1'-8 7/8"	1'-6 13/16"				
6	3"	11 7/16"	-2'-1 11/16"	12	3"	-11 7/16"	2'-1 11/16"				

Elevation View at CL

Vermont Agency of Transportation
RECEIVED
CK'D BY VHB OK'D BY JTS
April 11, 2013
RESUBMIT NO Approved
BY KMH DATE 04/12/13
SD Ireland
PRECAST DIVISION

- General Notes:
- Concrete Shall Have a Minimum 28 Days Compressive Strength of 6,000 PSI SCC Mix
 - All Reinforcing Rebar to be Level II Bar that is Dual Coated by the Manufacturer
 - All Horizontal Ducts (59mm PP Ducts) are to be Supported Every 24" (Minimum)
 - Post Tensioning Details Based on Post Tensioning Contractors Submittal Dated 03-22-13 Revised

PROJECT NAME: JAMAICA	
PROJECT NUMBER: ER-BRF 013-1(16)	
PRECAST SUB-CAP PRODUCTION DRAWING SET	
DRAWING: PLAN LAYOUT & ELEVATION VIEW	
DRAWN BY: CD	DATE: 04/11/13
APPROVED BY: TD	SHEET: 1 OF 4