
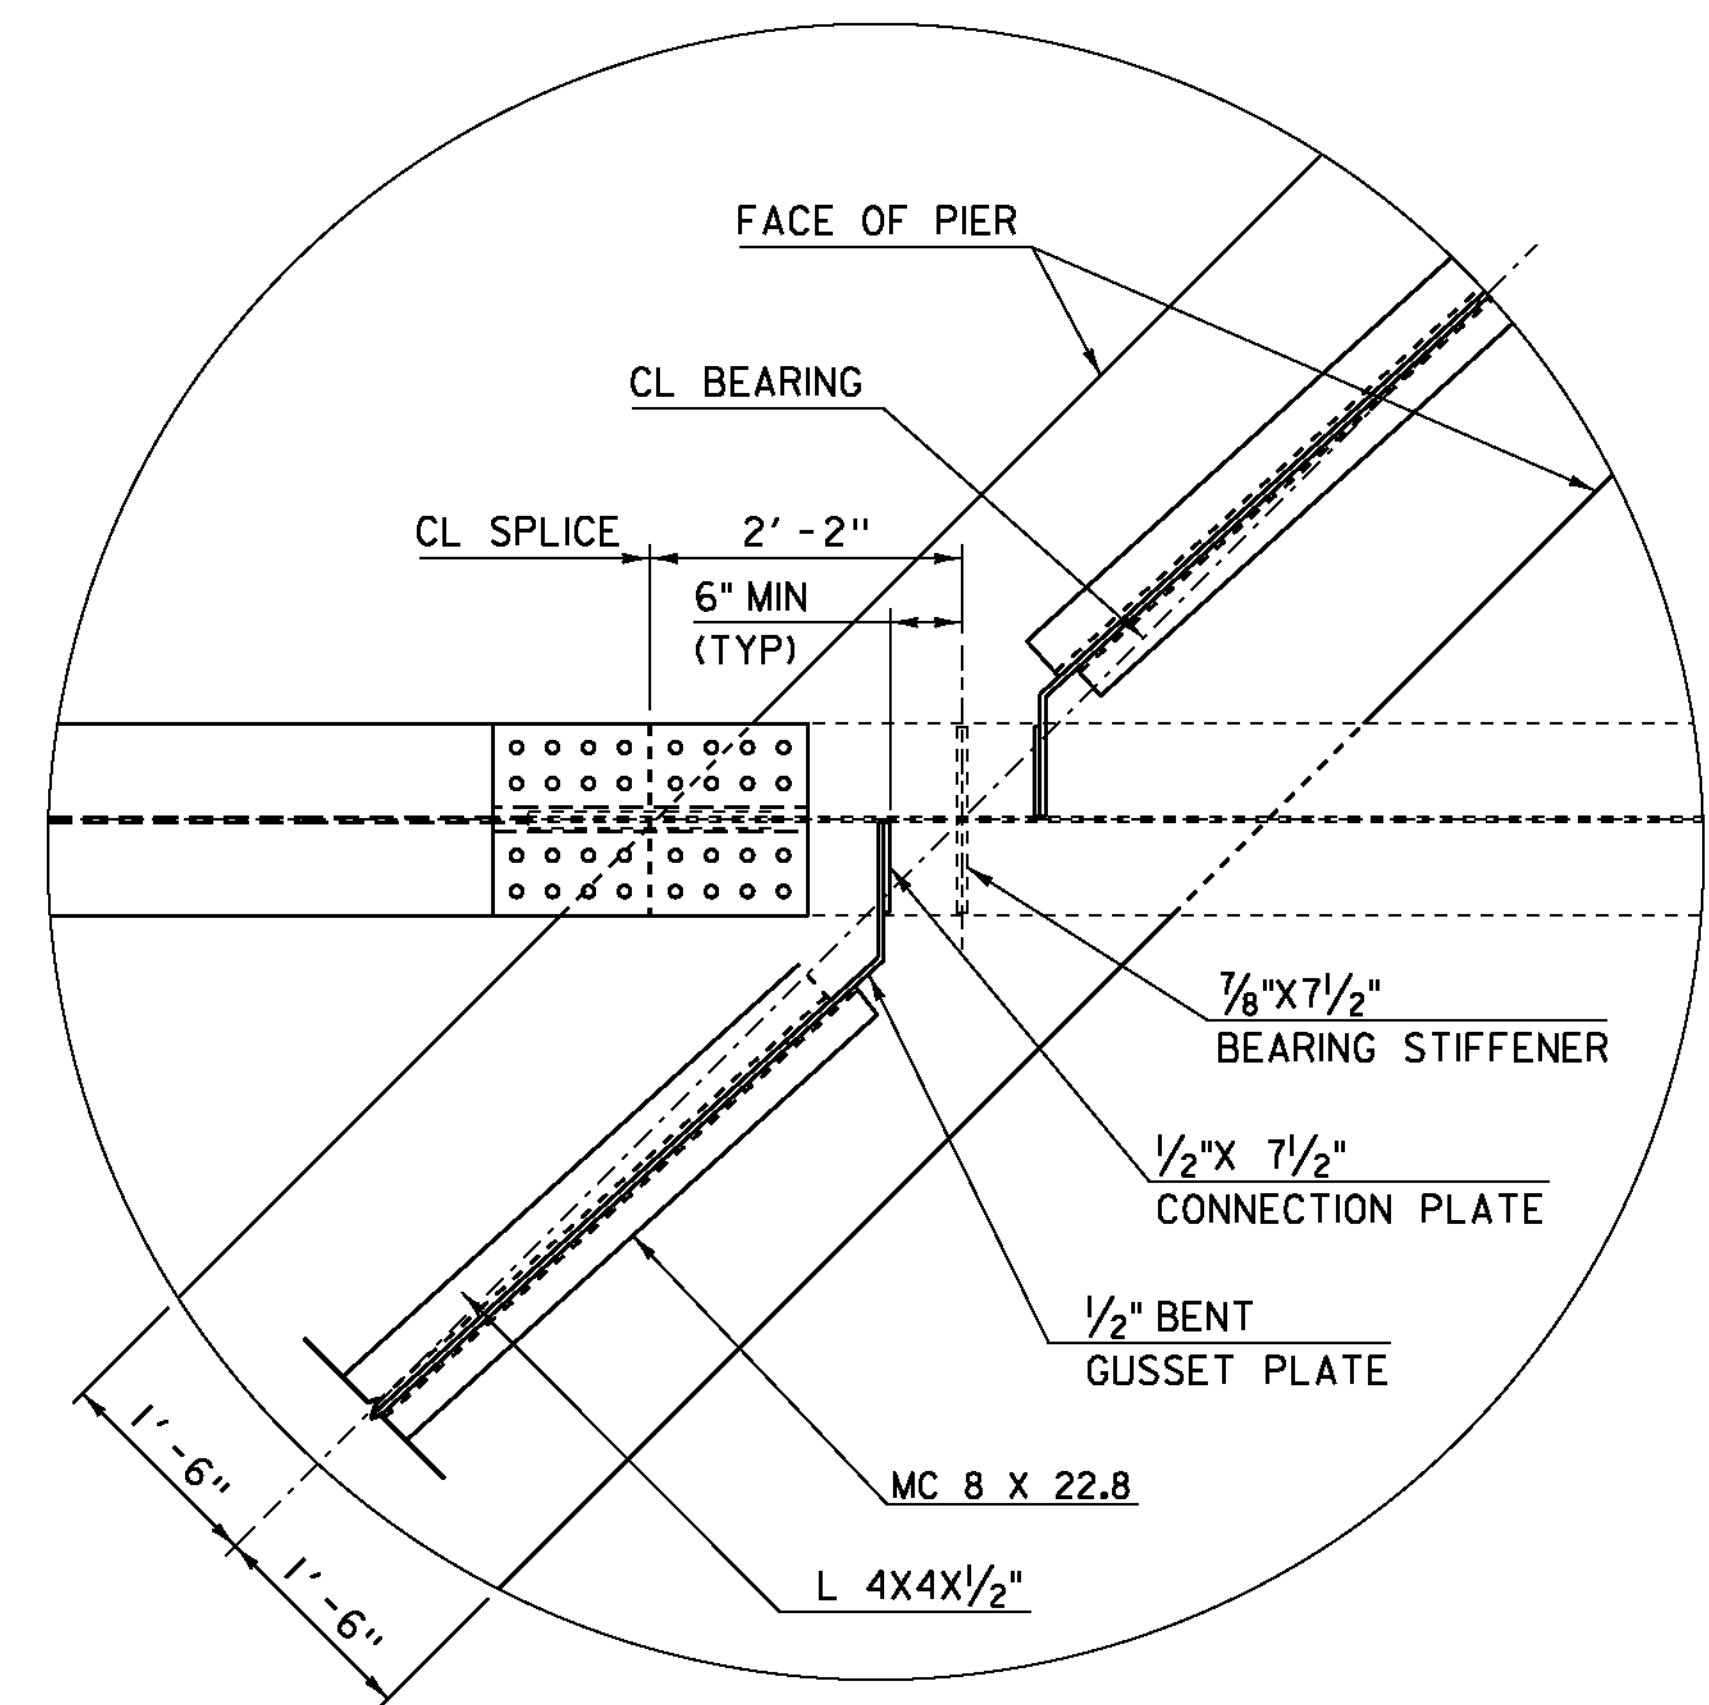
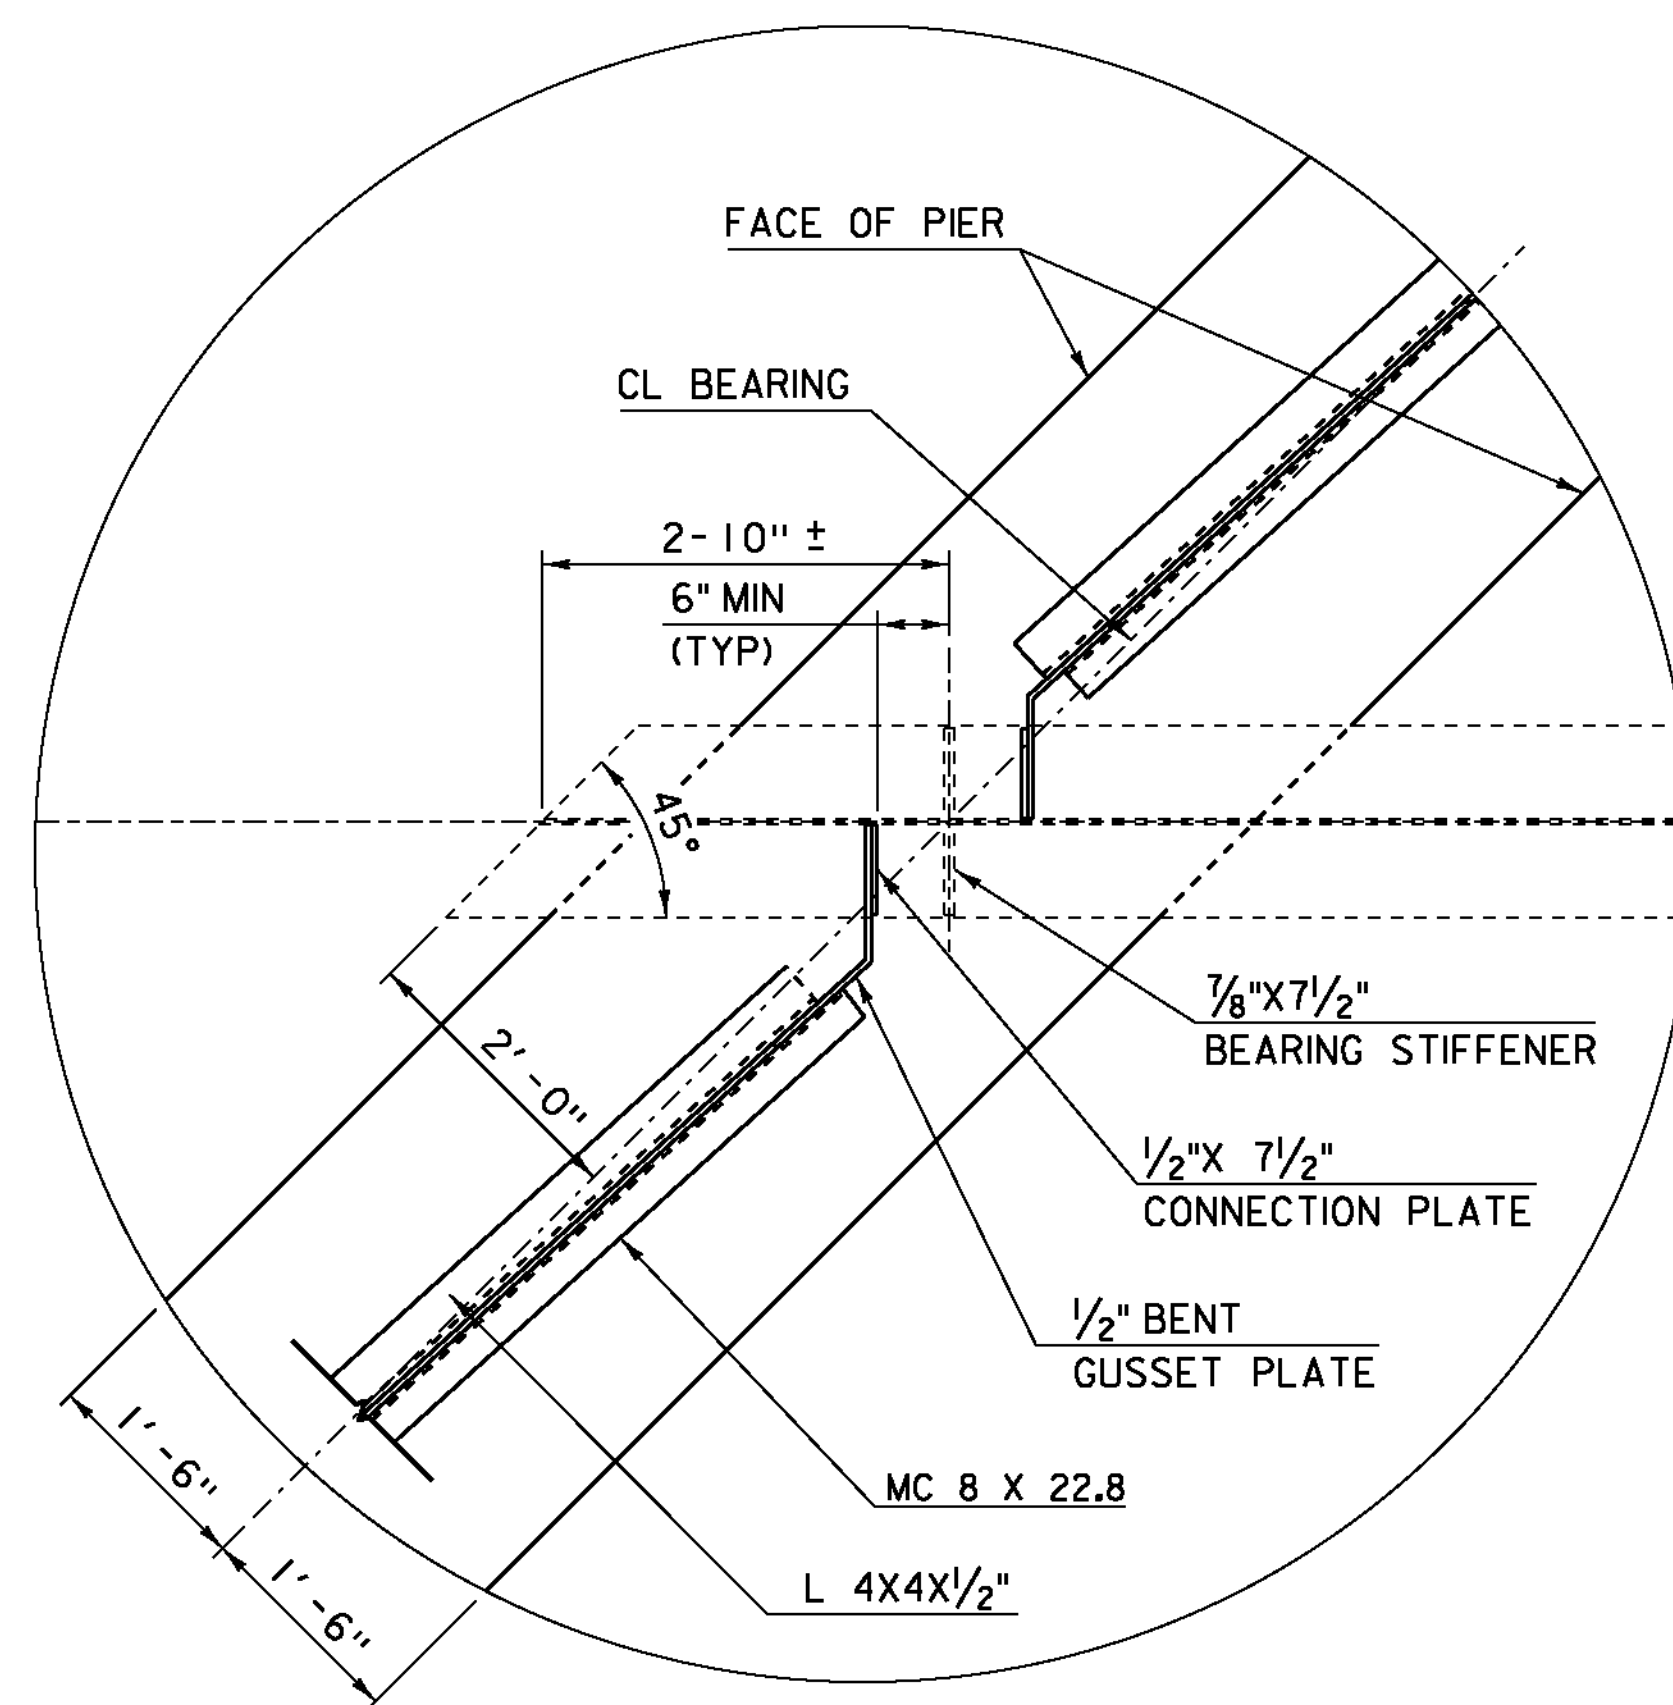
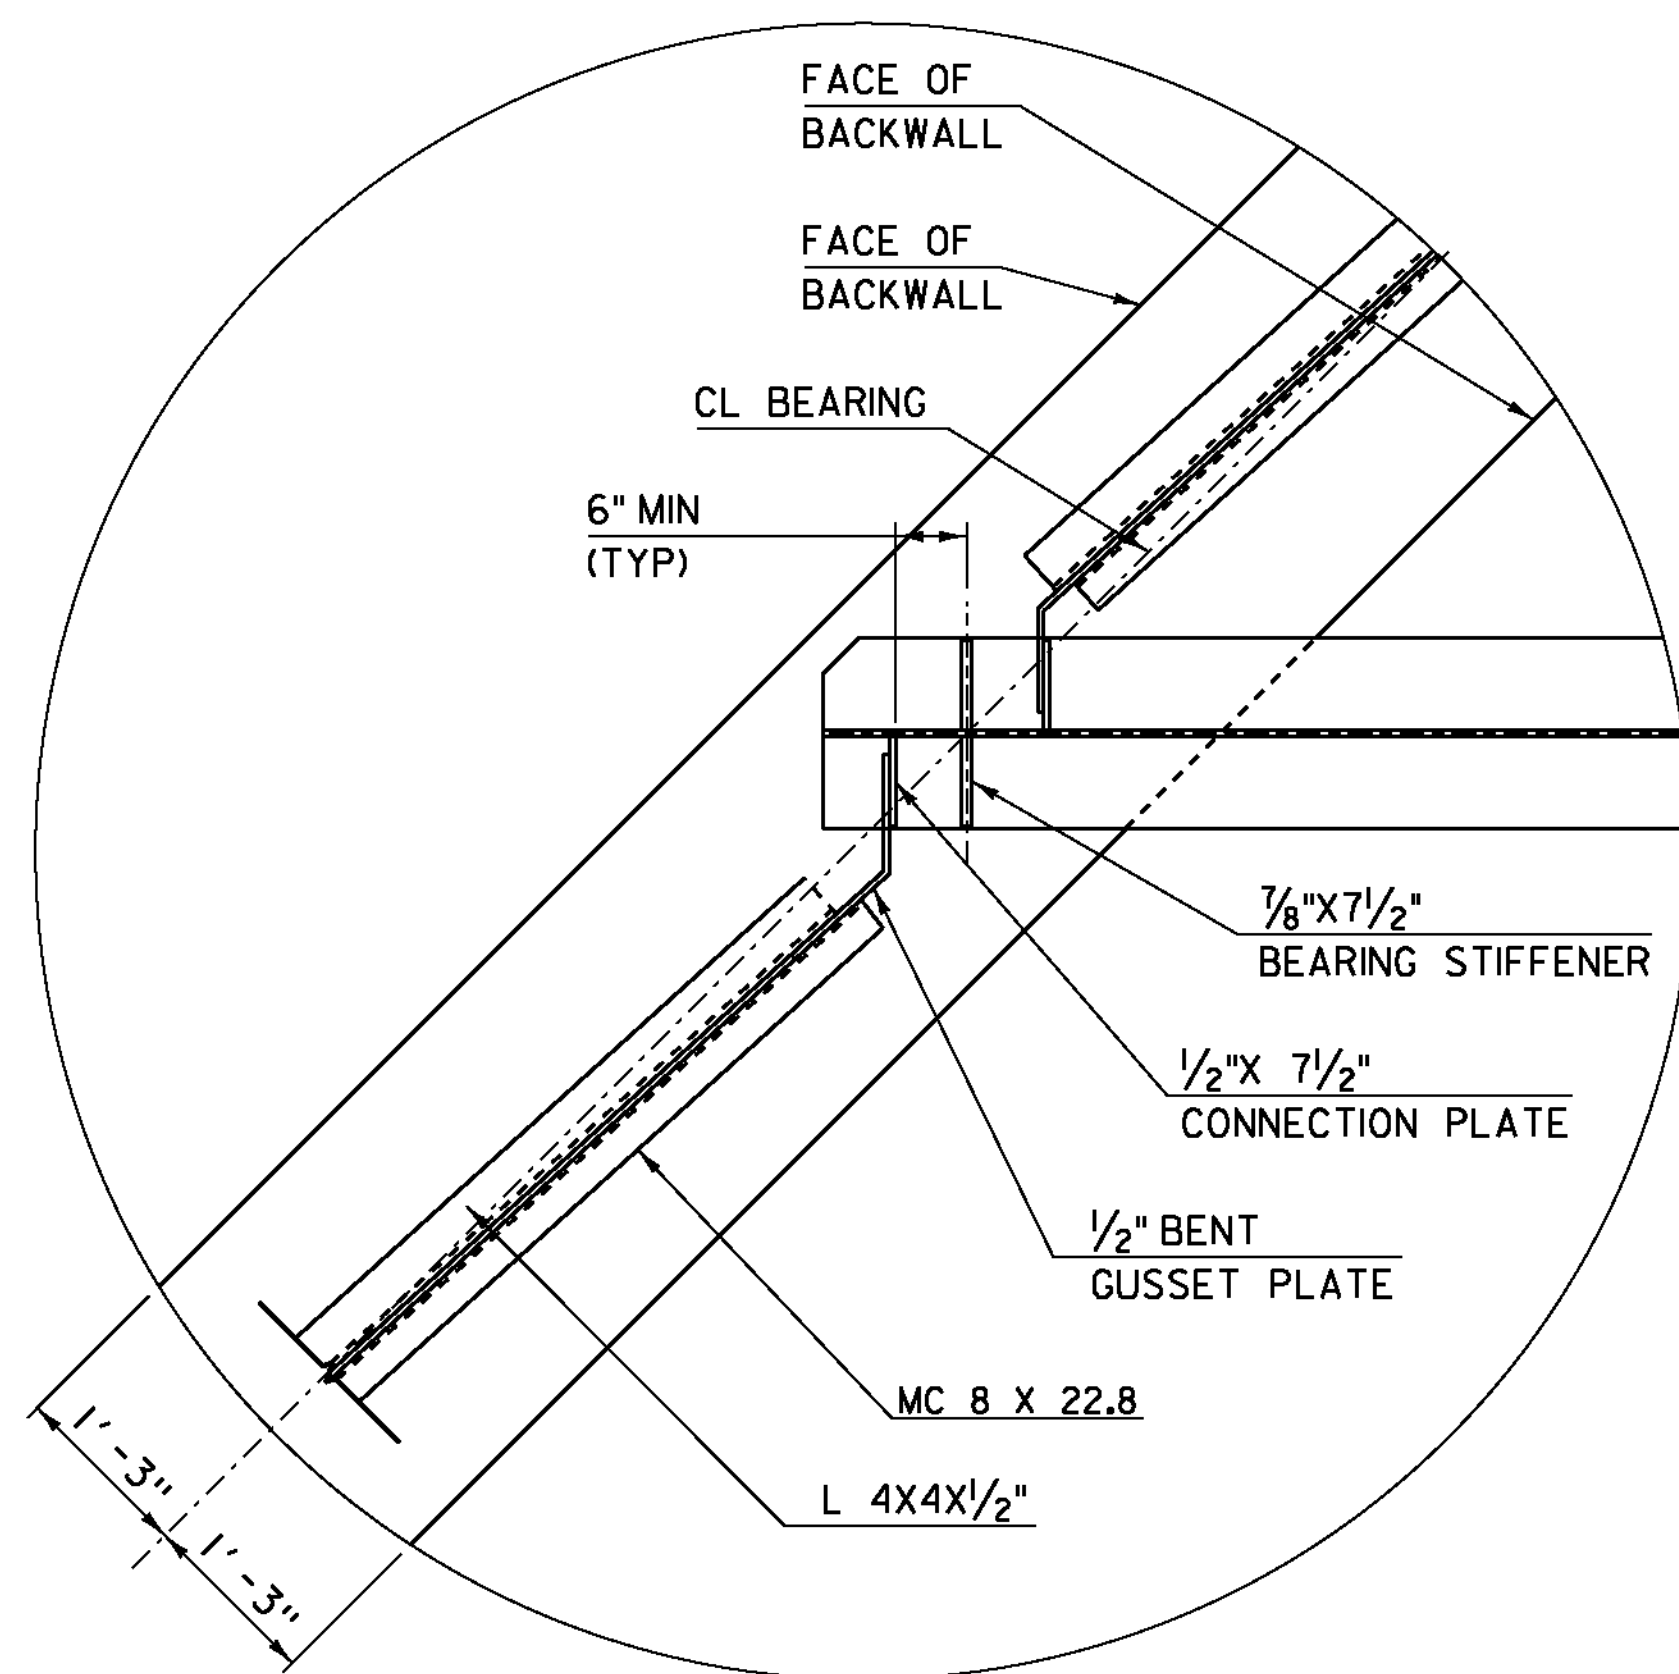


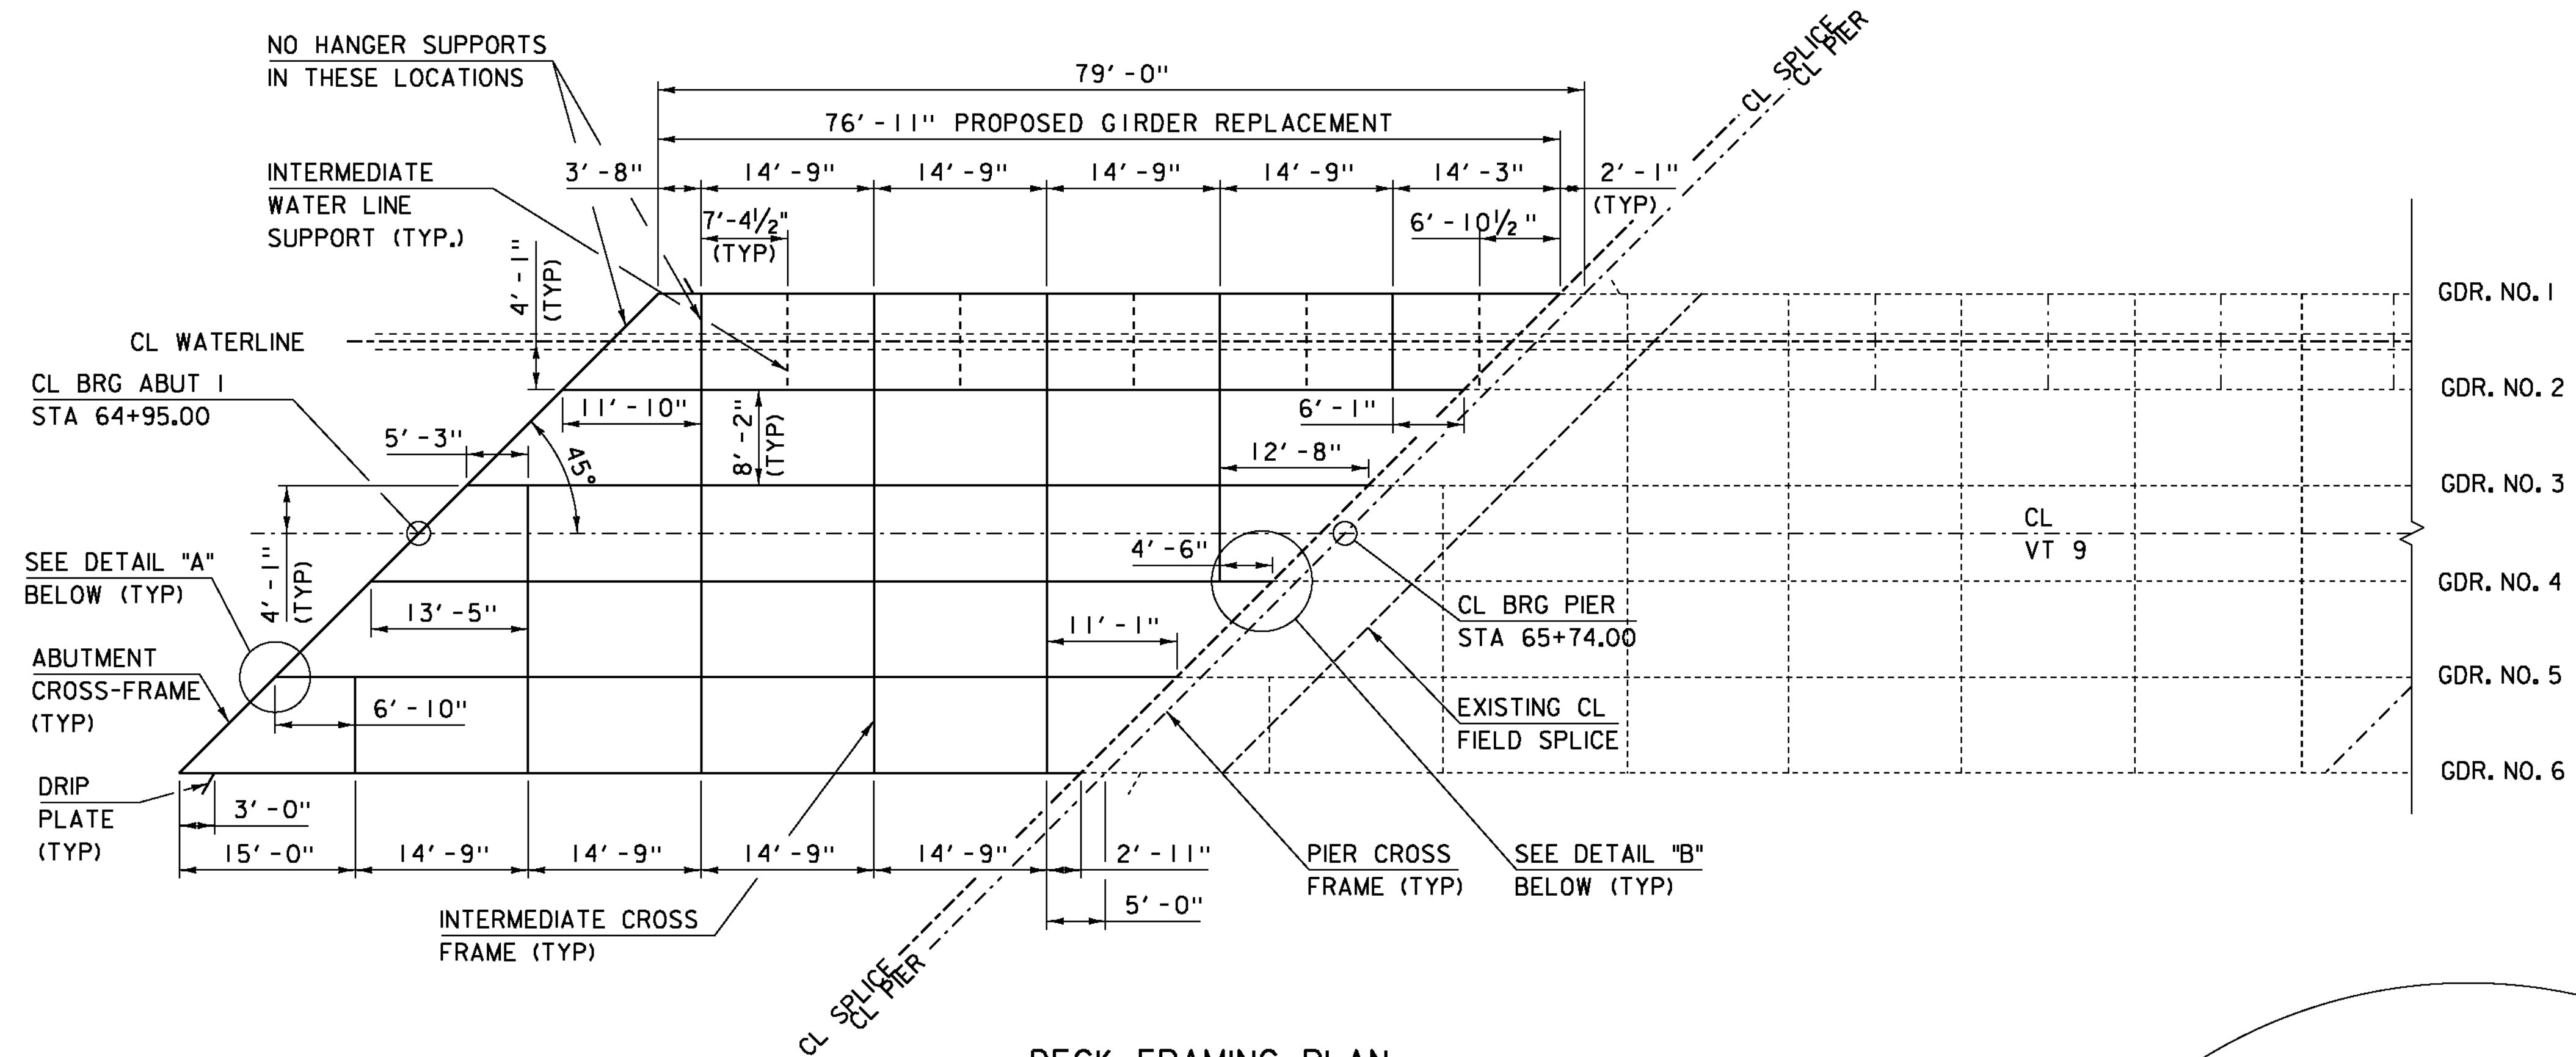

PROJECT NAME:	WOODFORD
PROJECT NUMBER:	ER BHF 010-1(44)
FILE NAME:	slb214sup.dgn
PROJECT LEADER:	C. CARLSON
DESIGNED BY:	M. EVANS-MONGEON
DECK FRAMING PLAN	
PLOT DATE:	23-MAR-2012
DRAWN BY:	C. MOONEY
CHECKED BY:	M. EVANS-MONGEON
SHEET	21 OF 58