




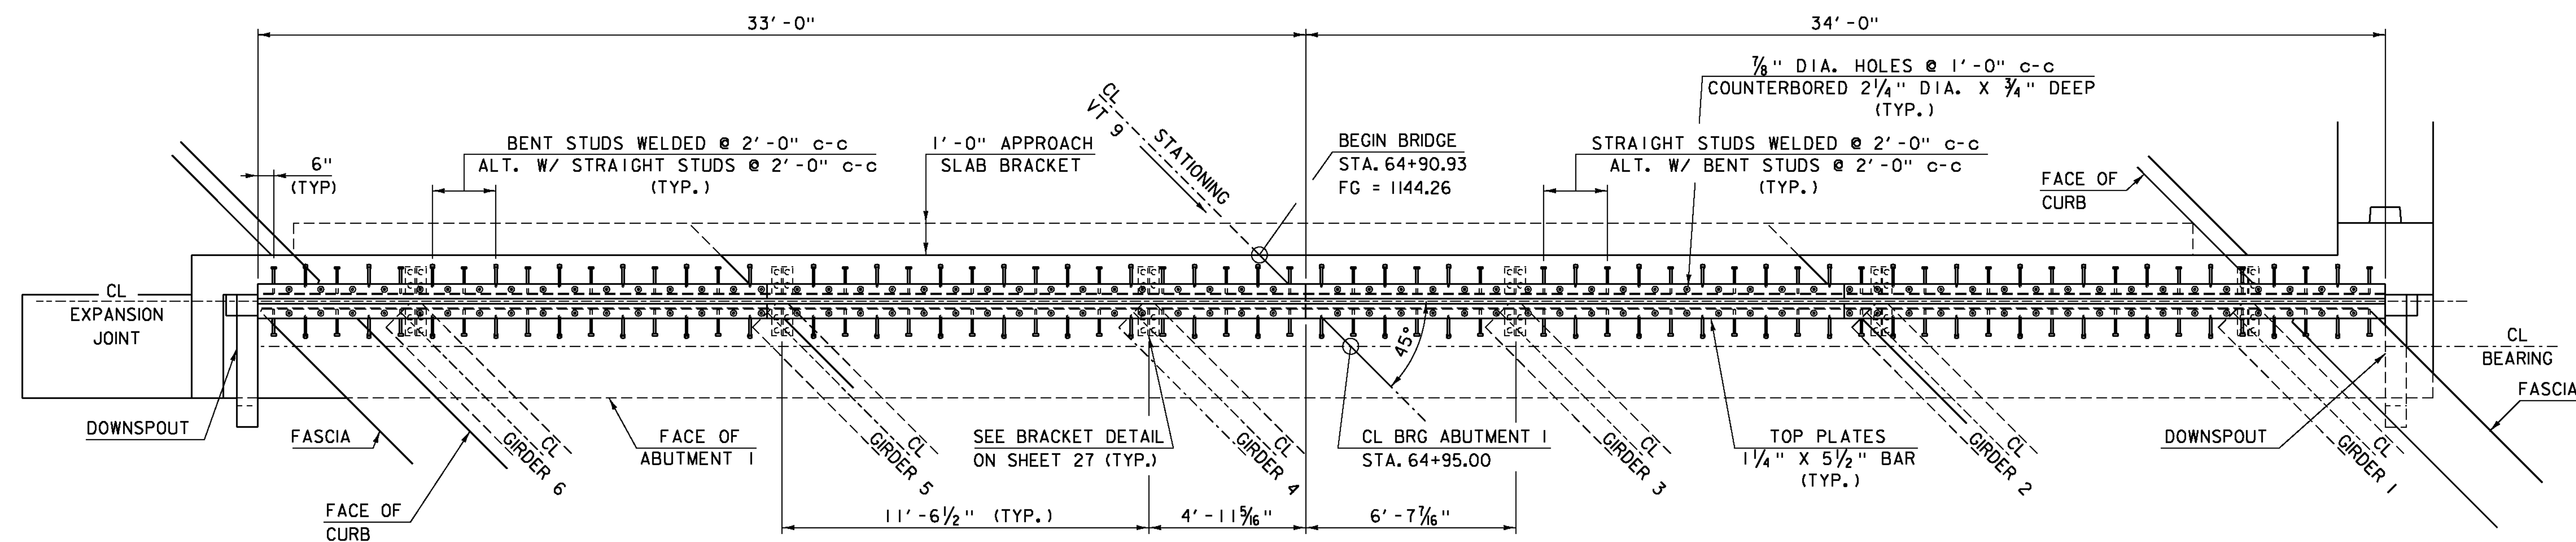

ABUTMENT I VT JOINT PLAN VIEW
SCALE $\frac{3}{8}" = 1'-0"$

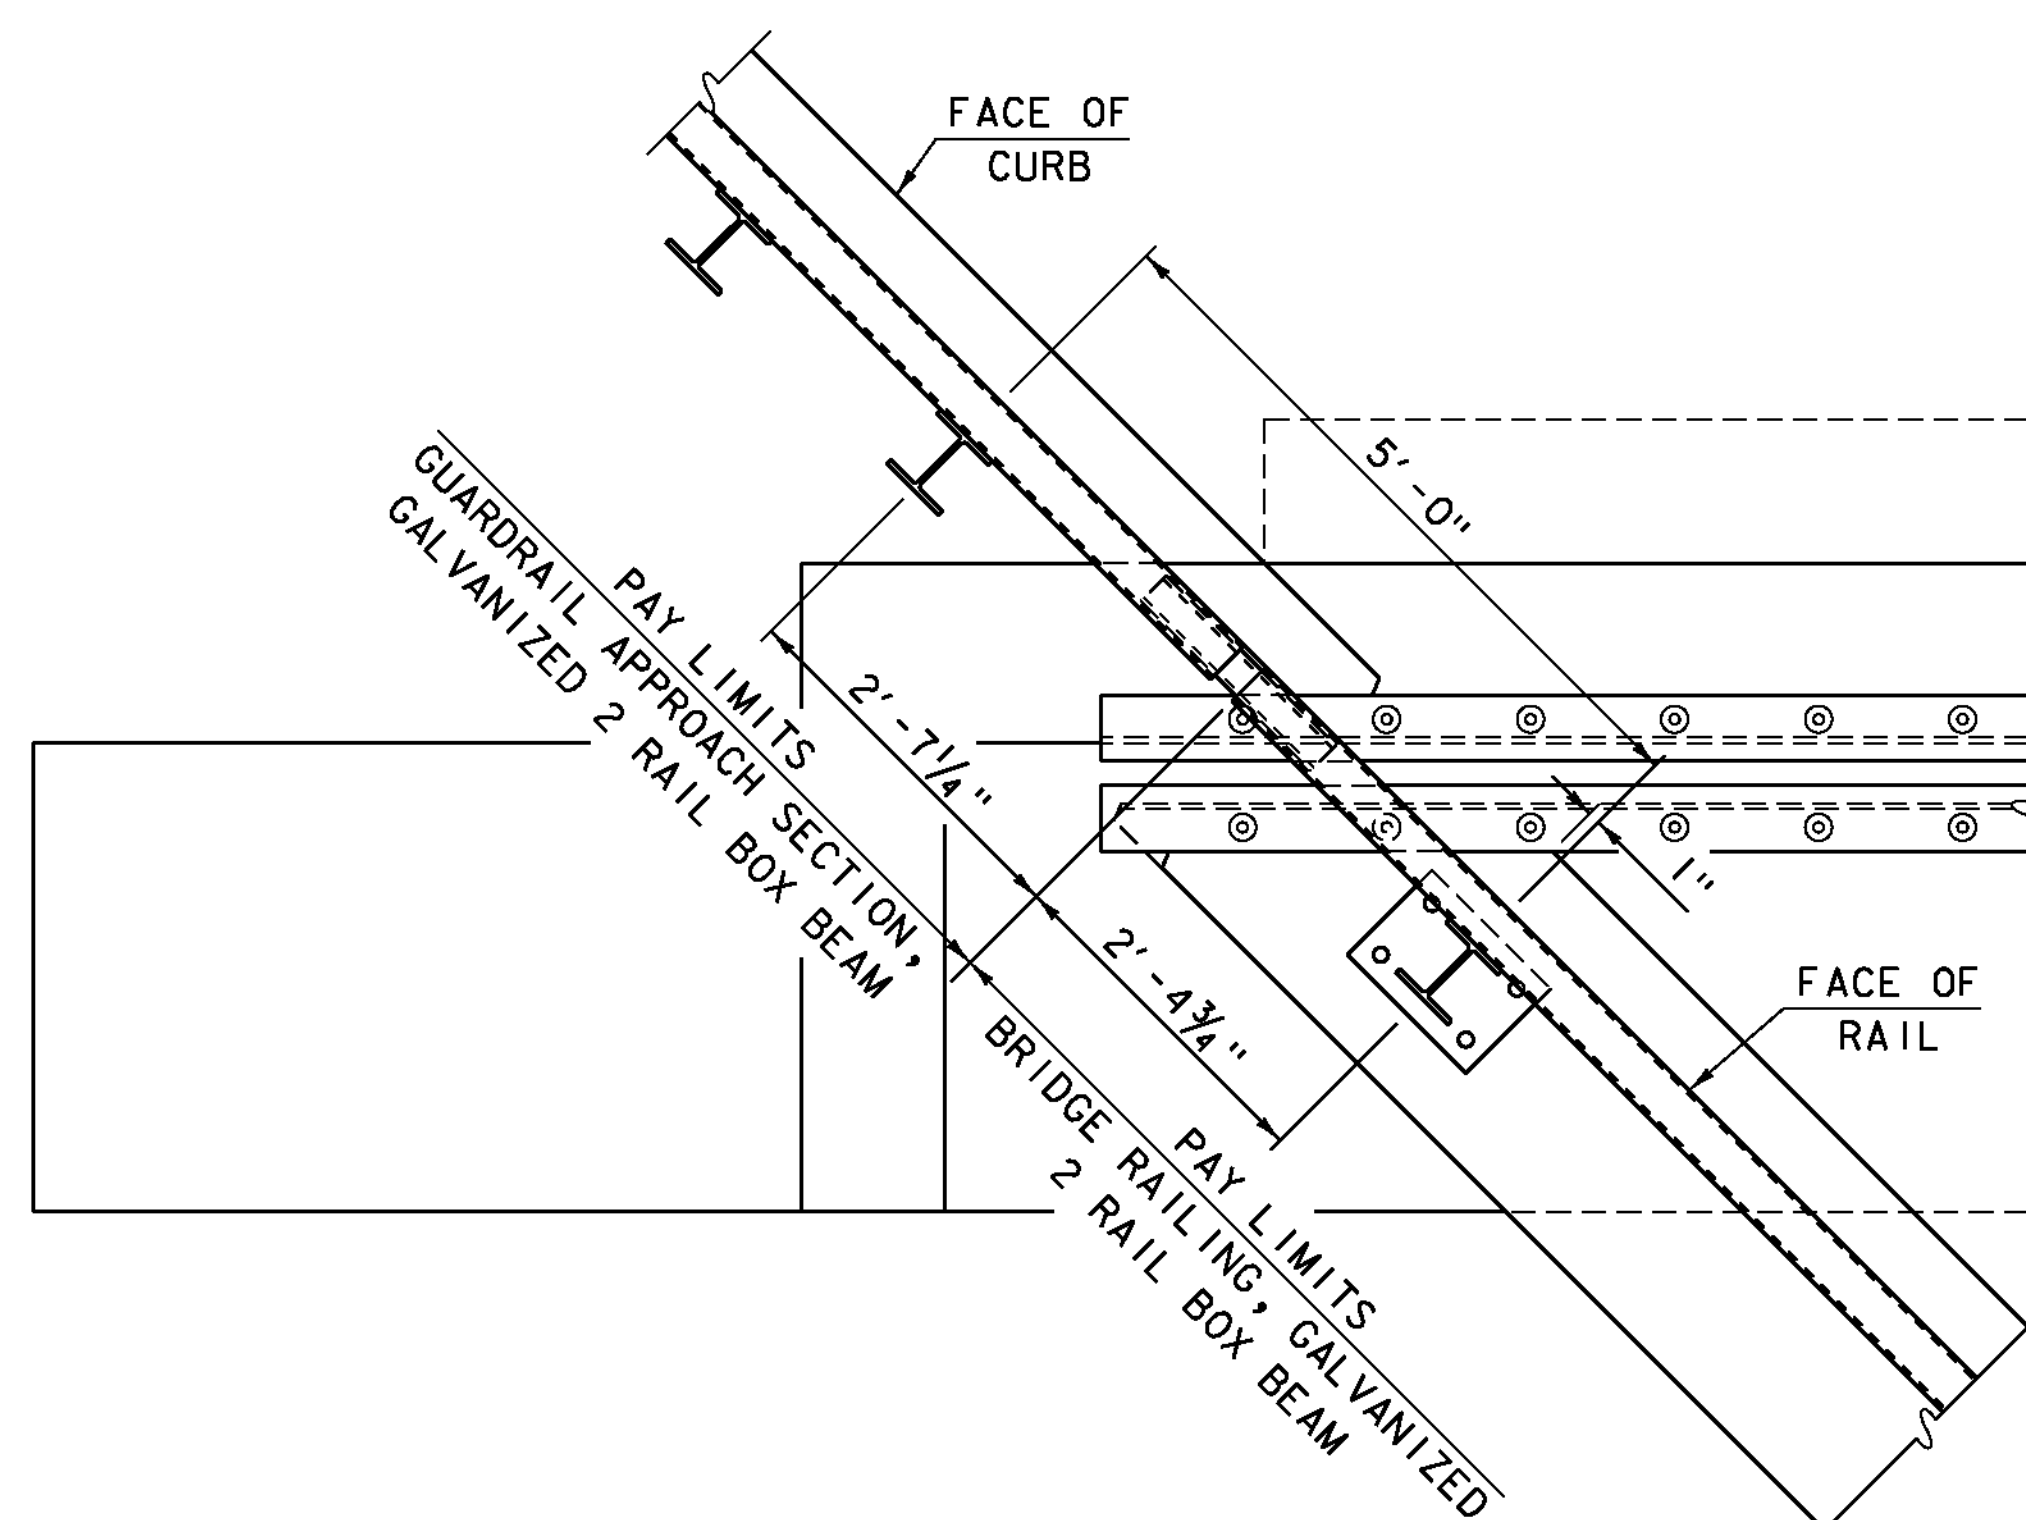

RAIL PLACEMENT @ WINGWALL 2
SCALE $\frac{3}{4}" = 1'-0"$

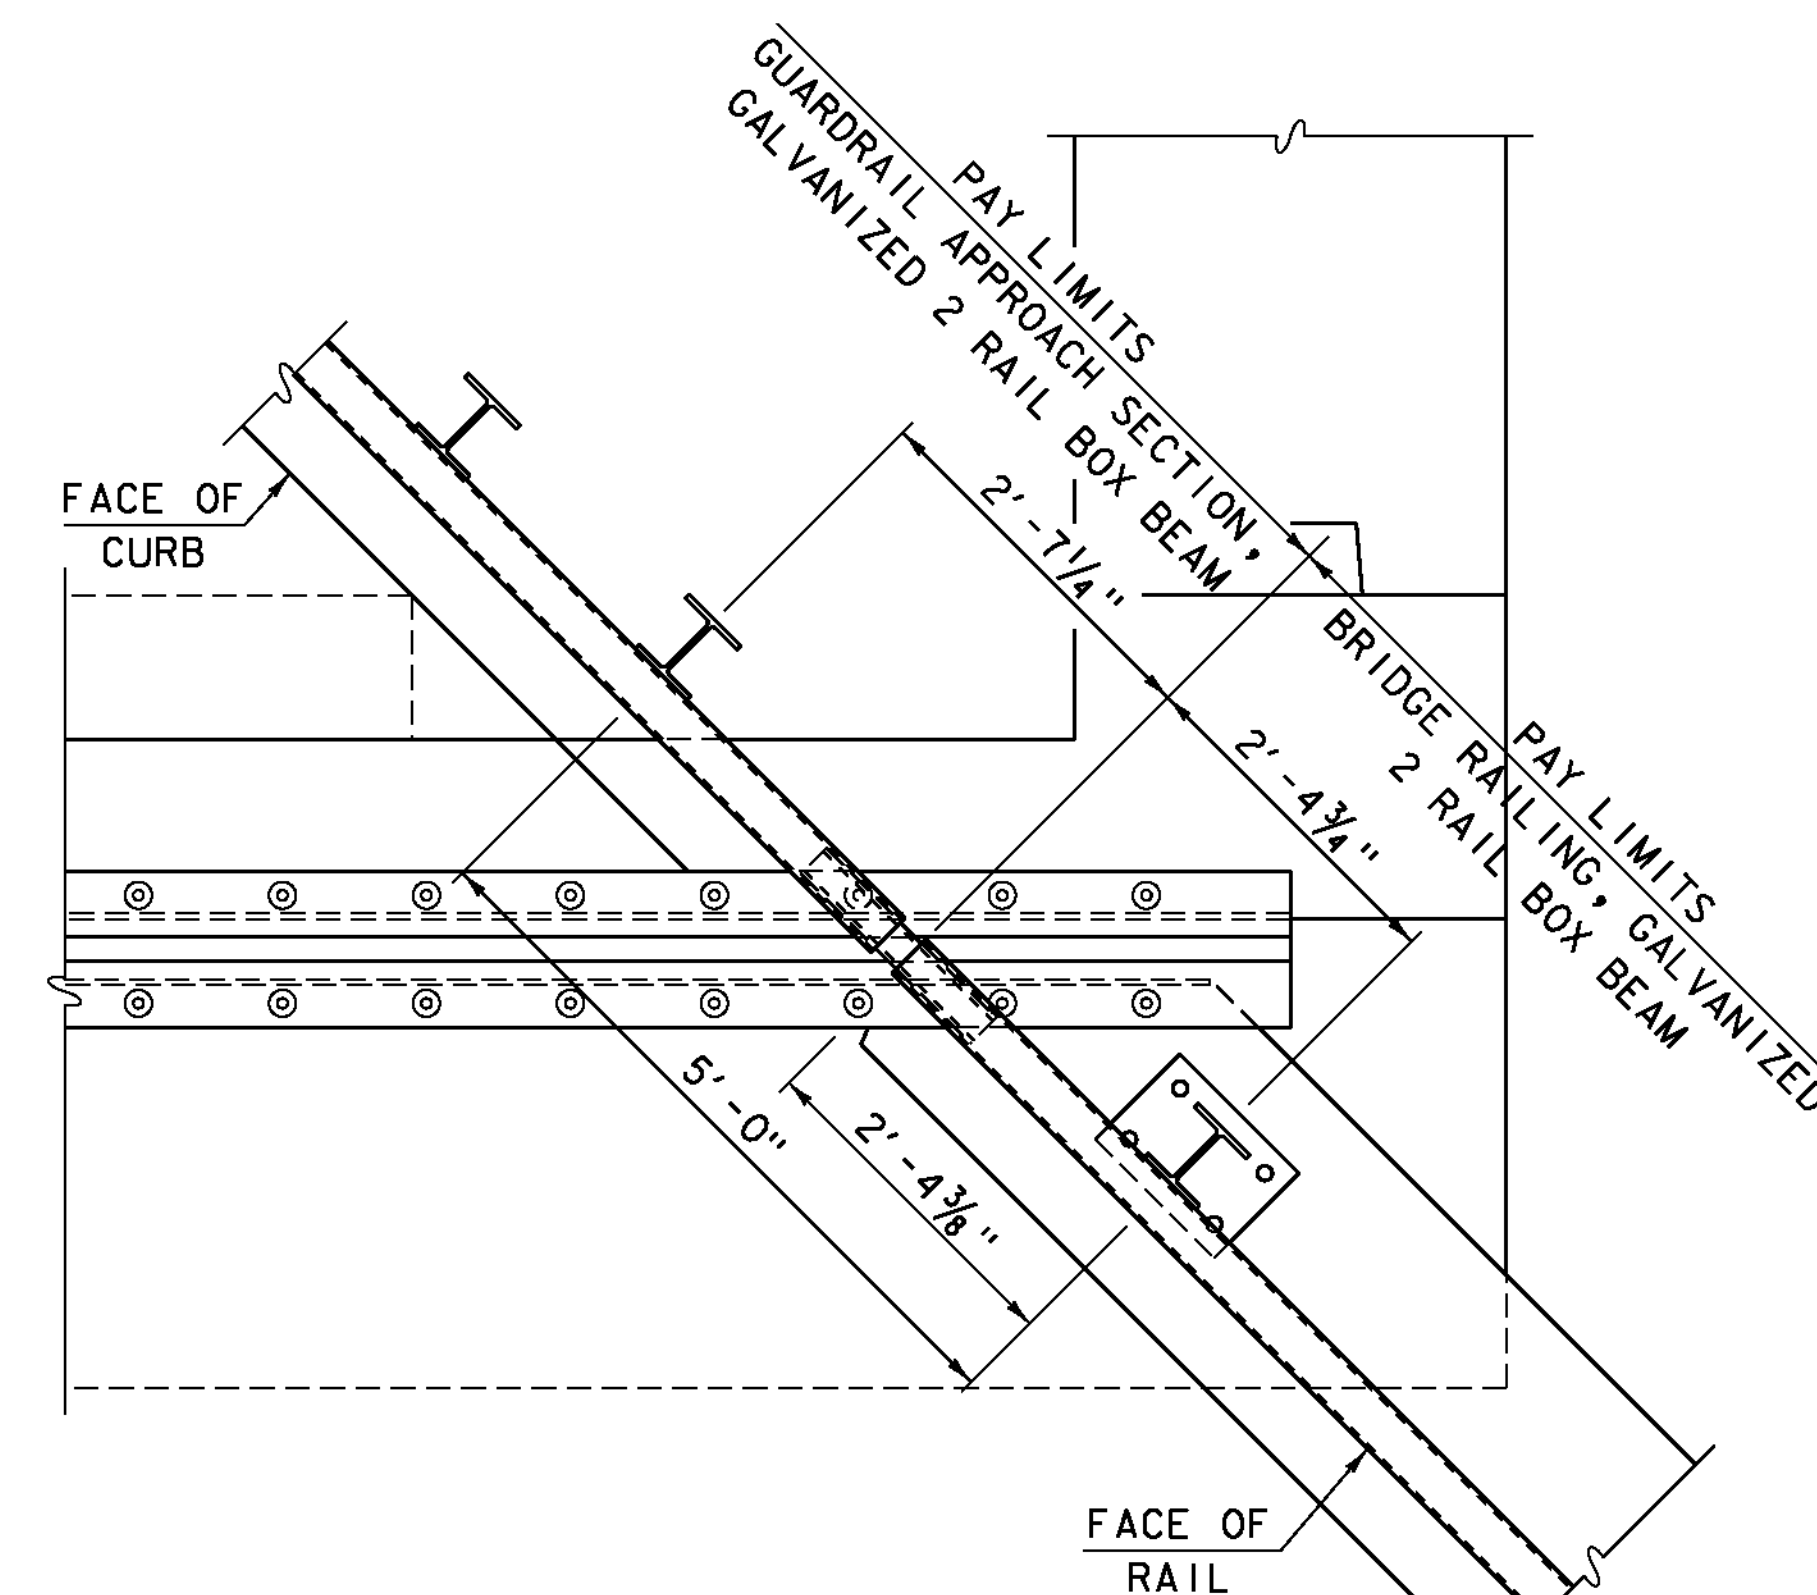

RAIL PLACEMENT @ WINGWALL I
SCALE $\frac{3}{4}" = 1'-0"$

PROJECT NAME:	WOODFORD
PROJECT NUMBER:	ER BHF 010-1(44)
FILE NAME:	slb214sup.dgn
PROJECT LEADER:	C. CARLSON
DESIGNED BY:	M. EVANS-MONGEON
BRIDGE EXPANSION JOINT PLAN	
PLOT DATE:	23-MAR-2012
DRAWN BY:	C. MOONEY
CHECKED BY:	M. EVANS-MONGEON
SHEET	28 OF 58