



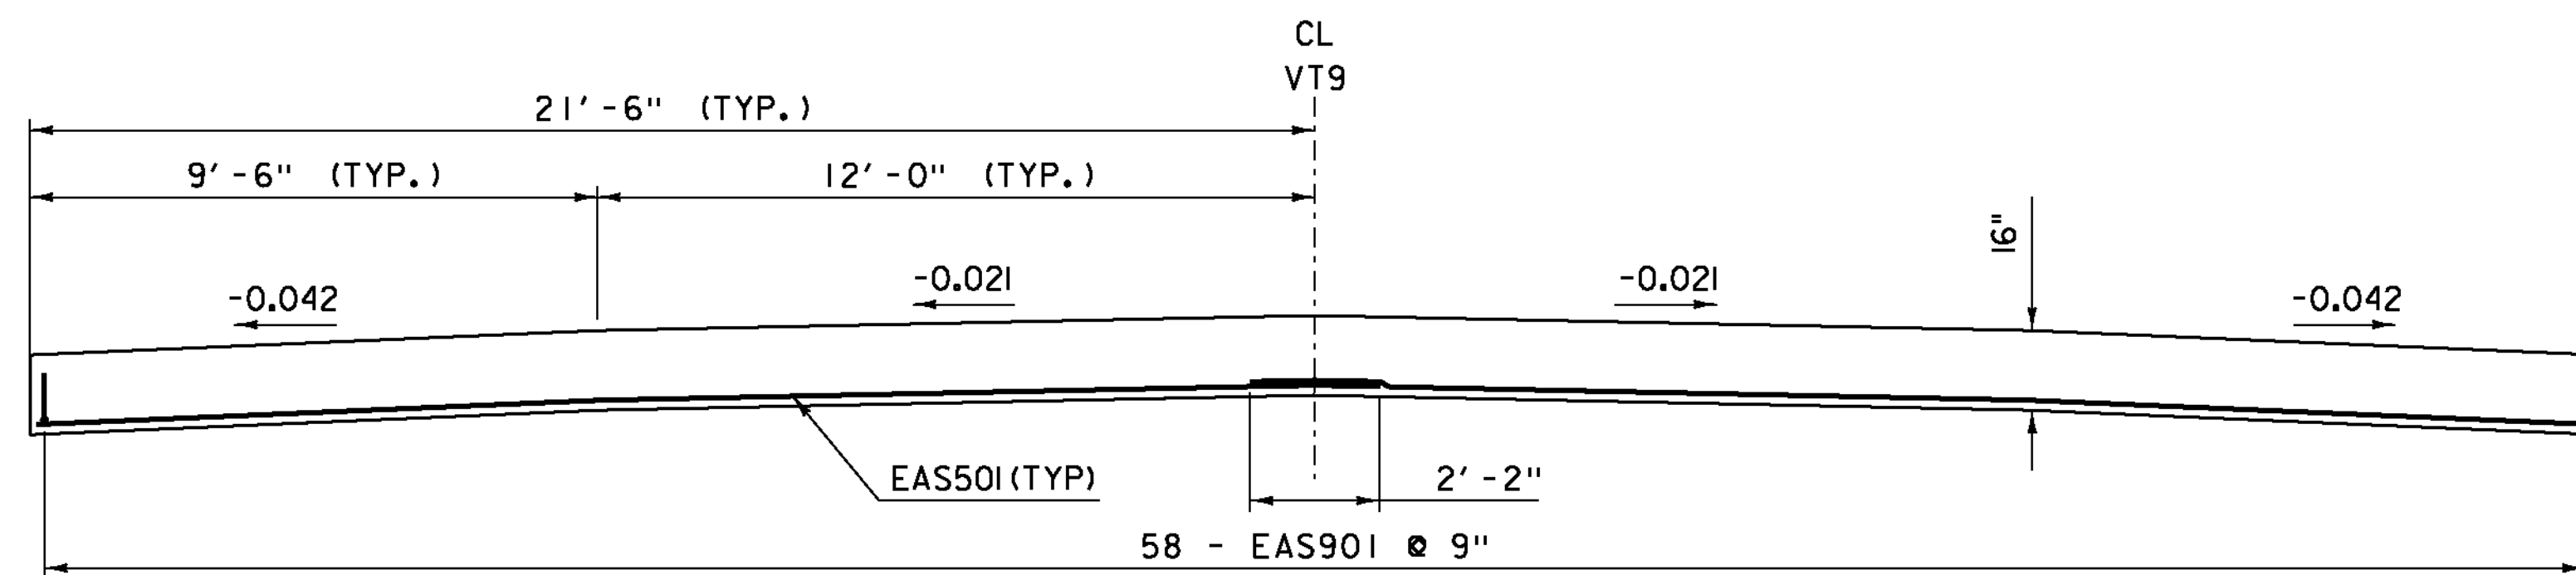


APPROACH SLAB SECTION

SCALE $\frac{3}{8}" = 1'-0"$

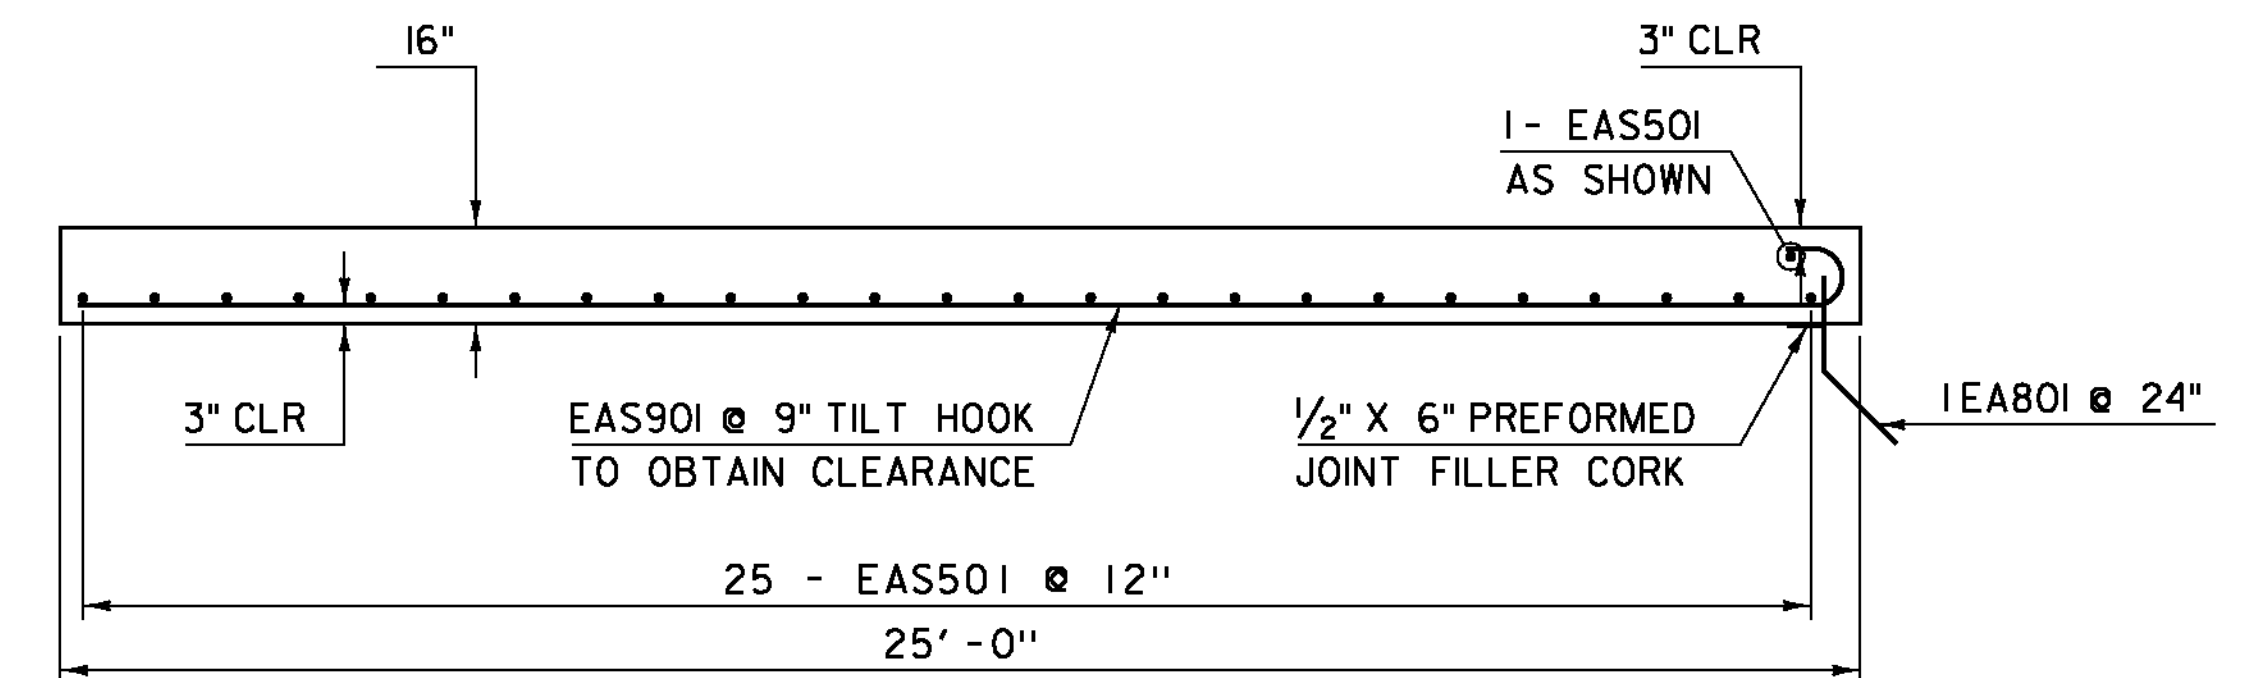


SECTION A-A

SCALE $\frac{3}{8}" = 1'-0"$

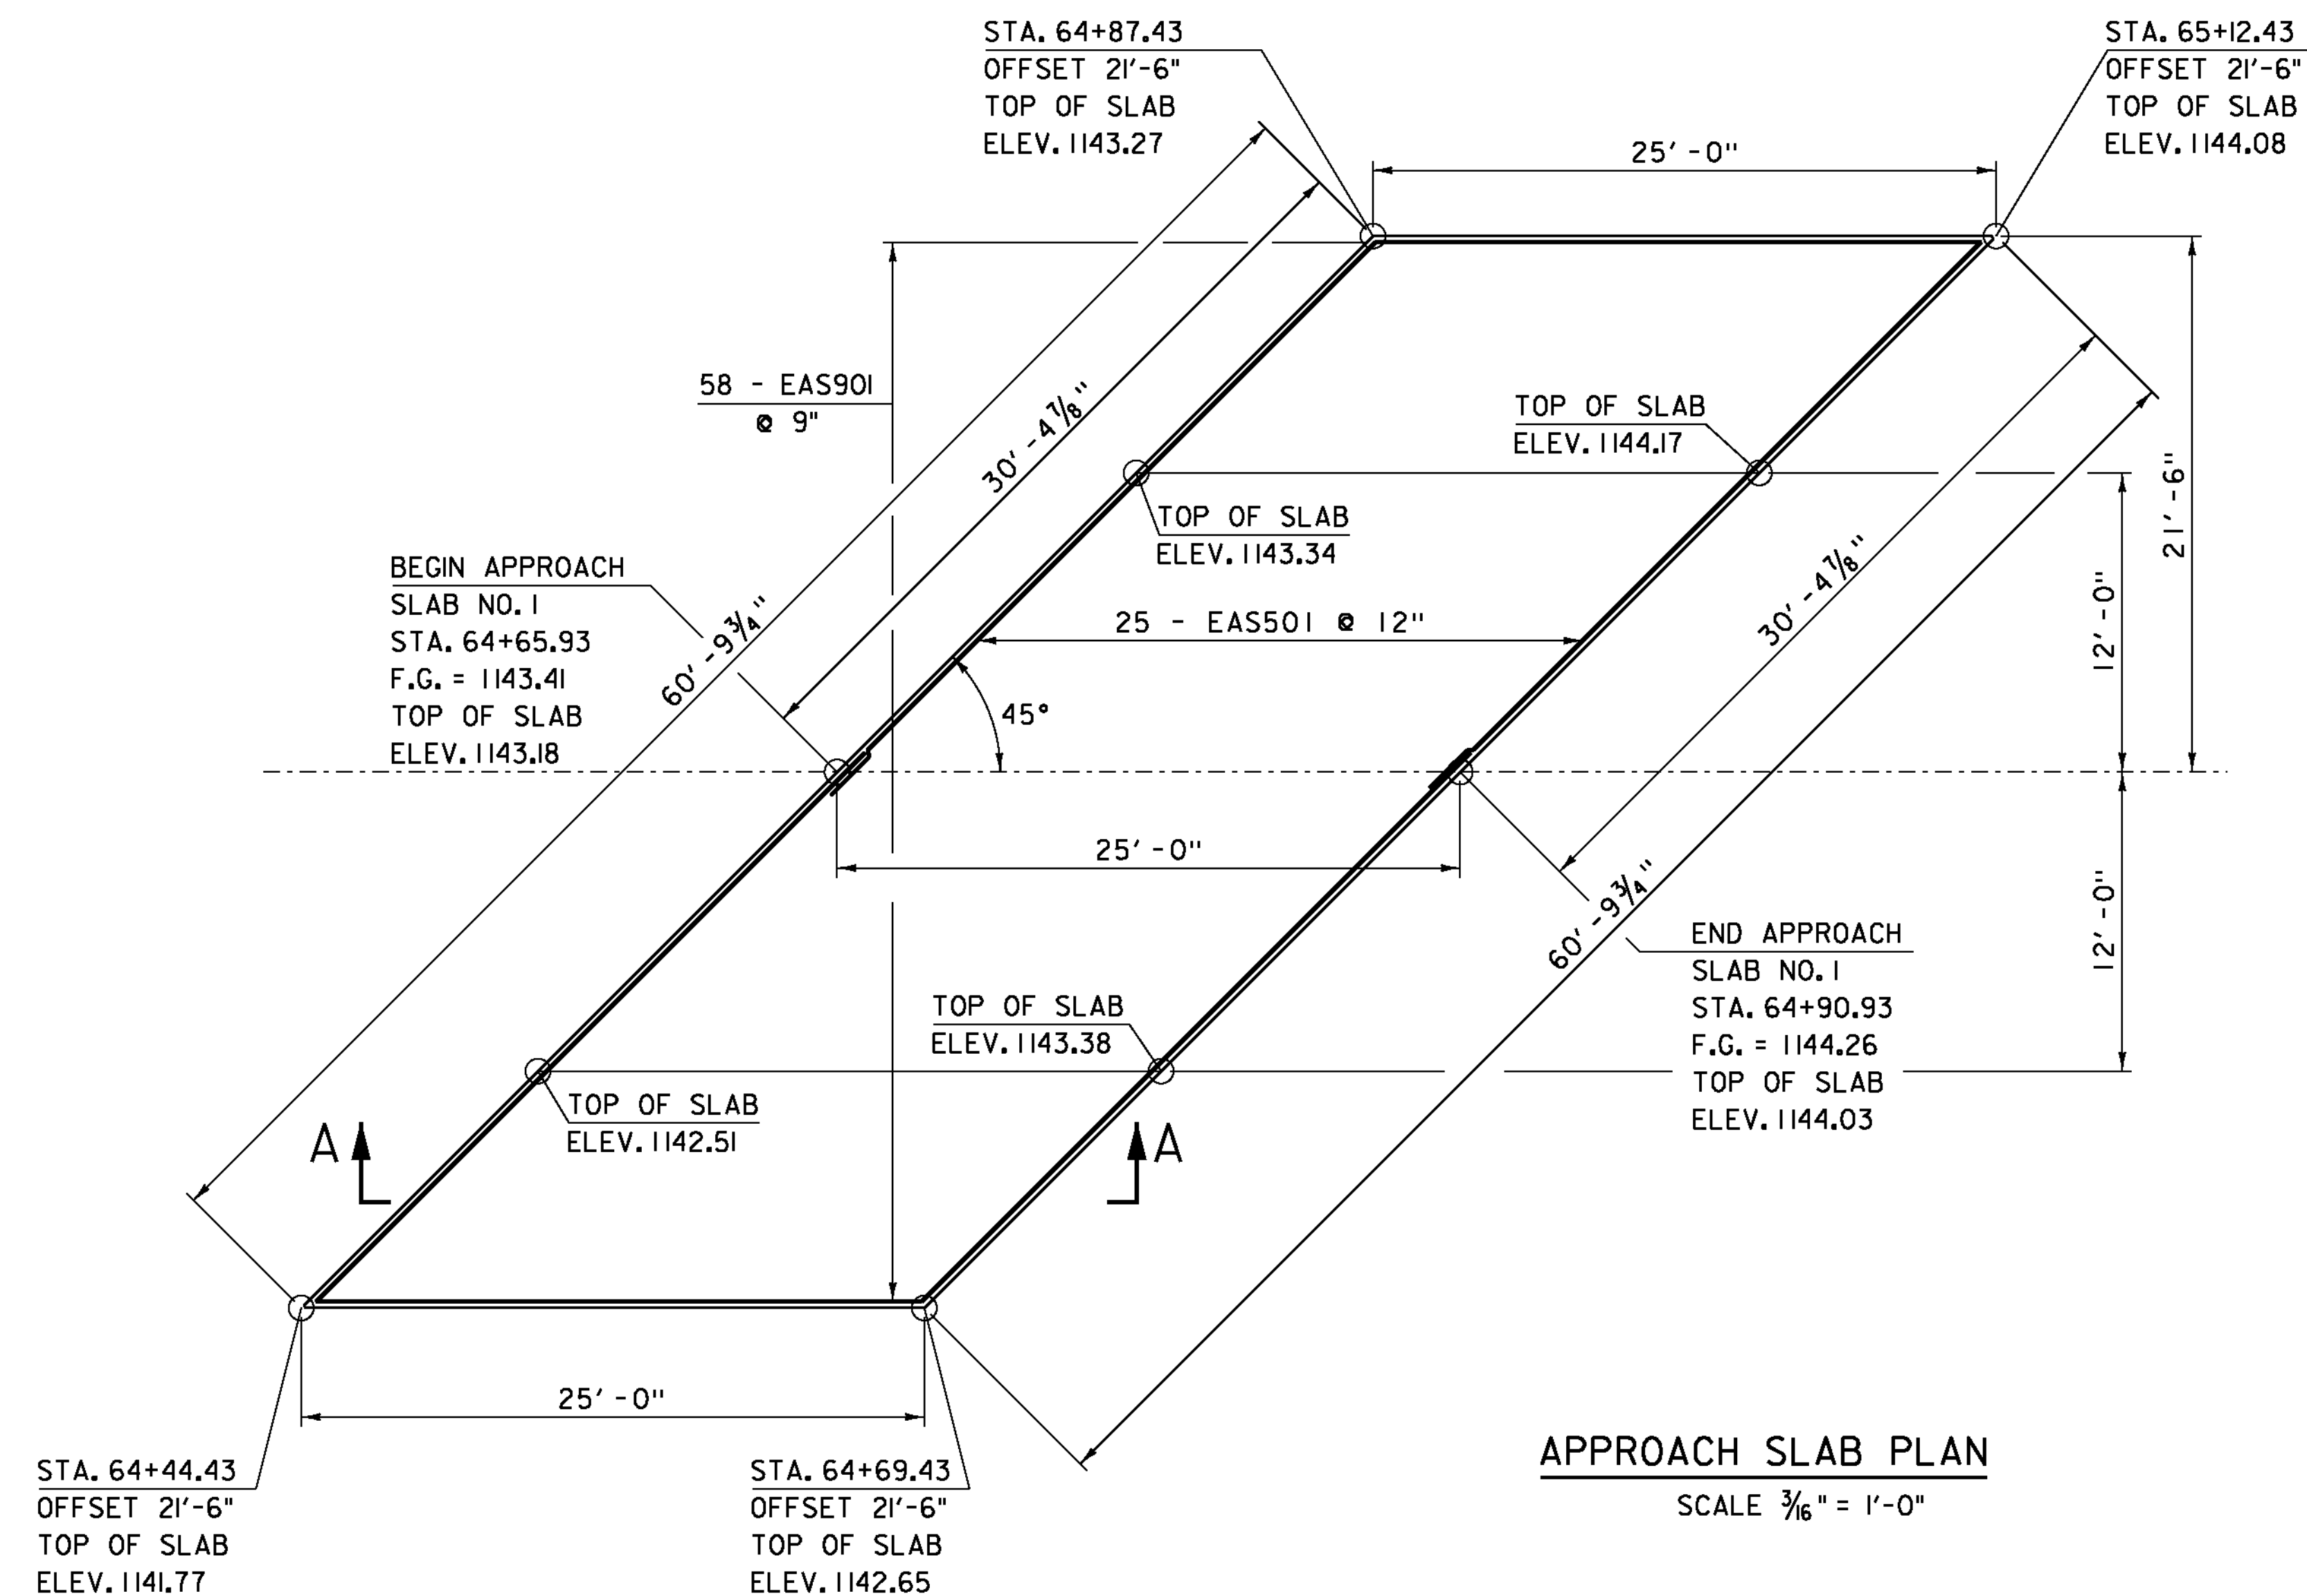

APPROACH SLAB PLAN

SCALE $\frac{3}{16}" = 1'-0"$

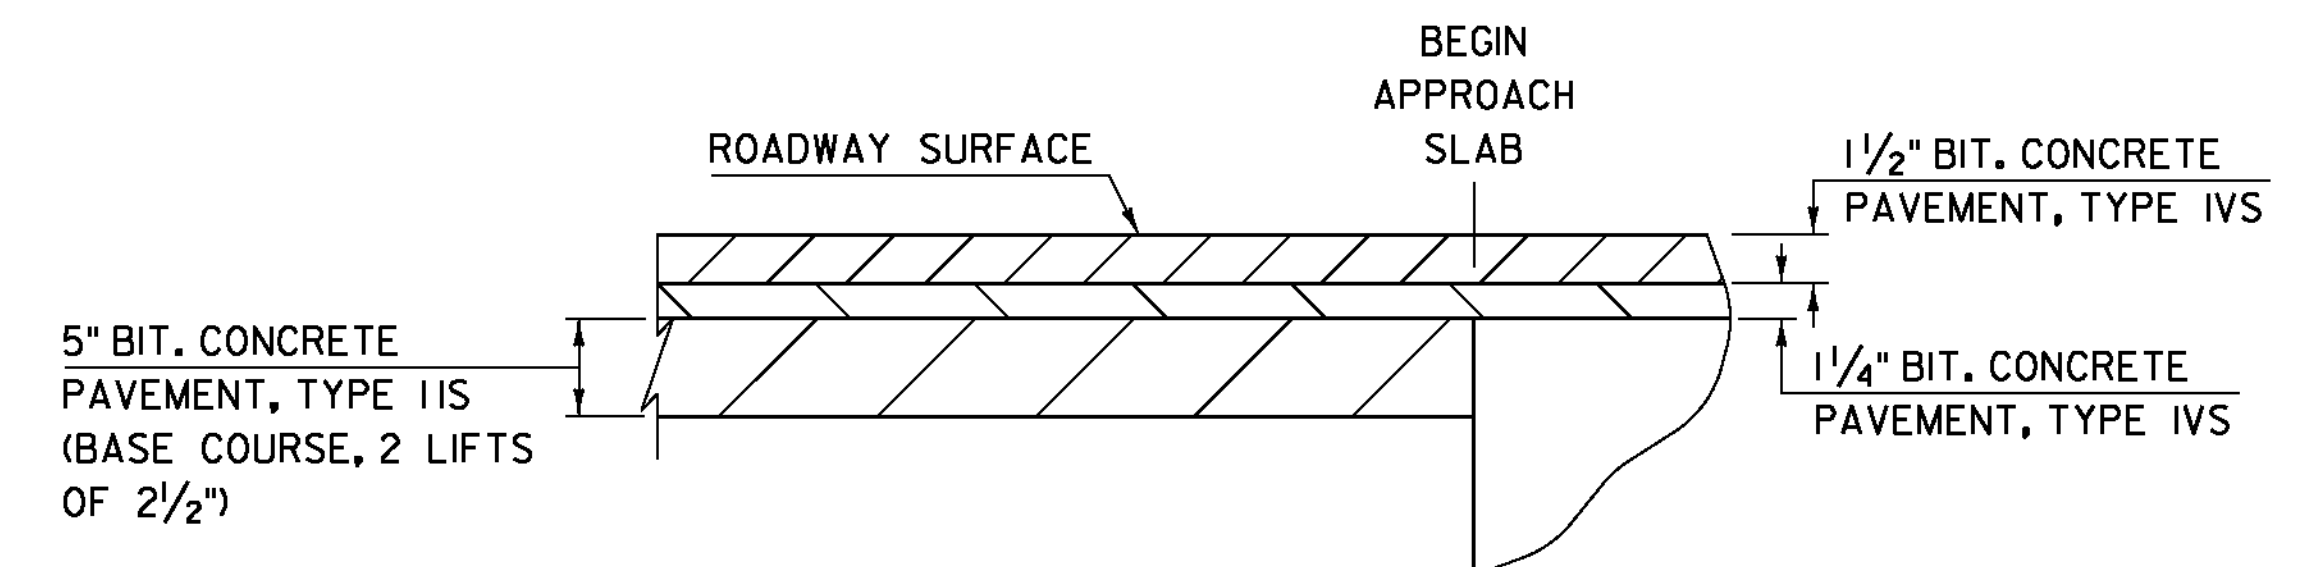

DETAIL AT APPROACH SLAB END

NTS

PROJECT NAME: WOODFORD	
PROJECT NUMBER: ER BHF 010-1(44)	
FILE NAME: slb214sup.dgn	PLOT DATE: 23-MAR-2012
PROJECT LEADER: C. CARLSON	DRAWN BY: C. MOONEY
DESIGNED BY: M. EVANS-MONGEON	CHECKED BY: M. EVANS-MONGEON
APPROACH SLAB DETAILS	SHEET 30 OF 58