


RECORD PLANS

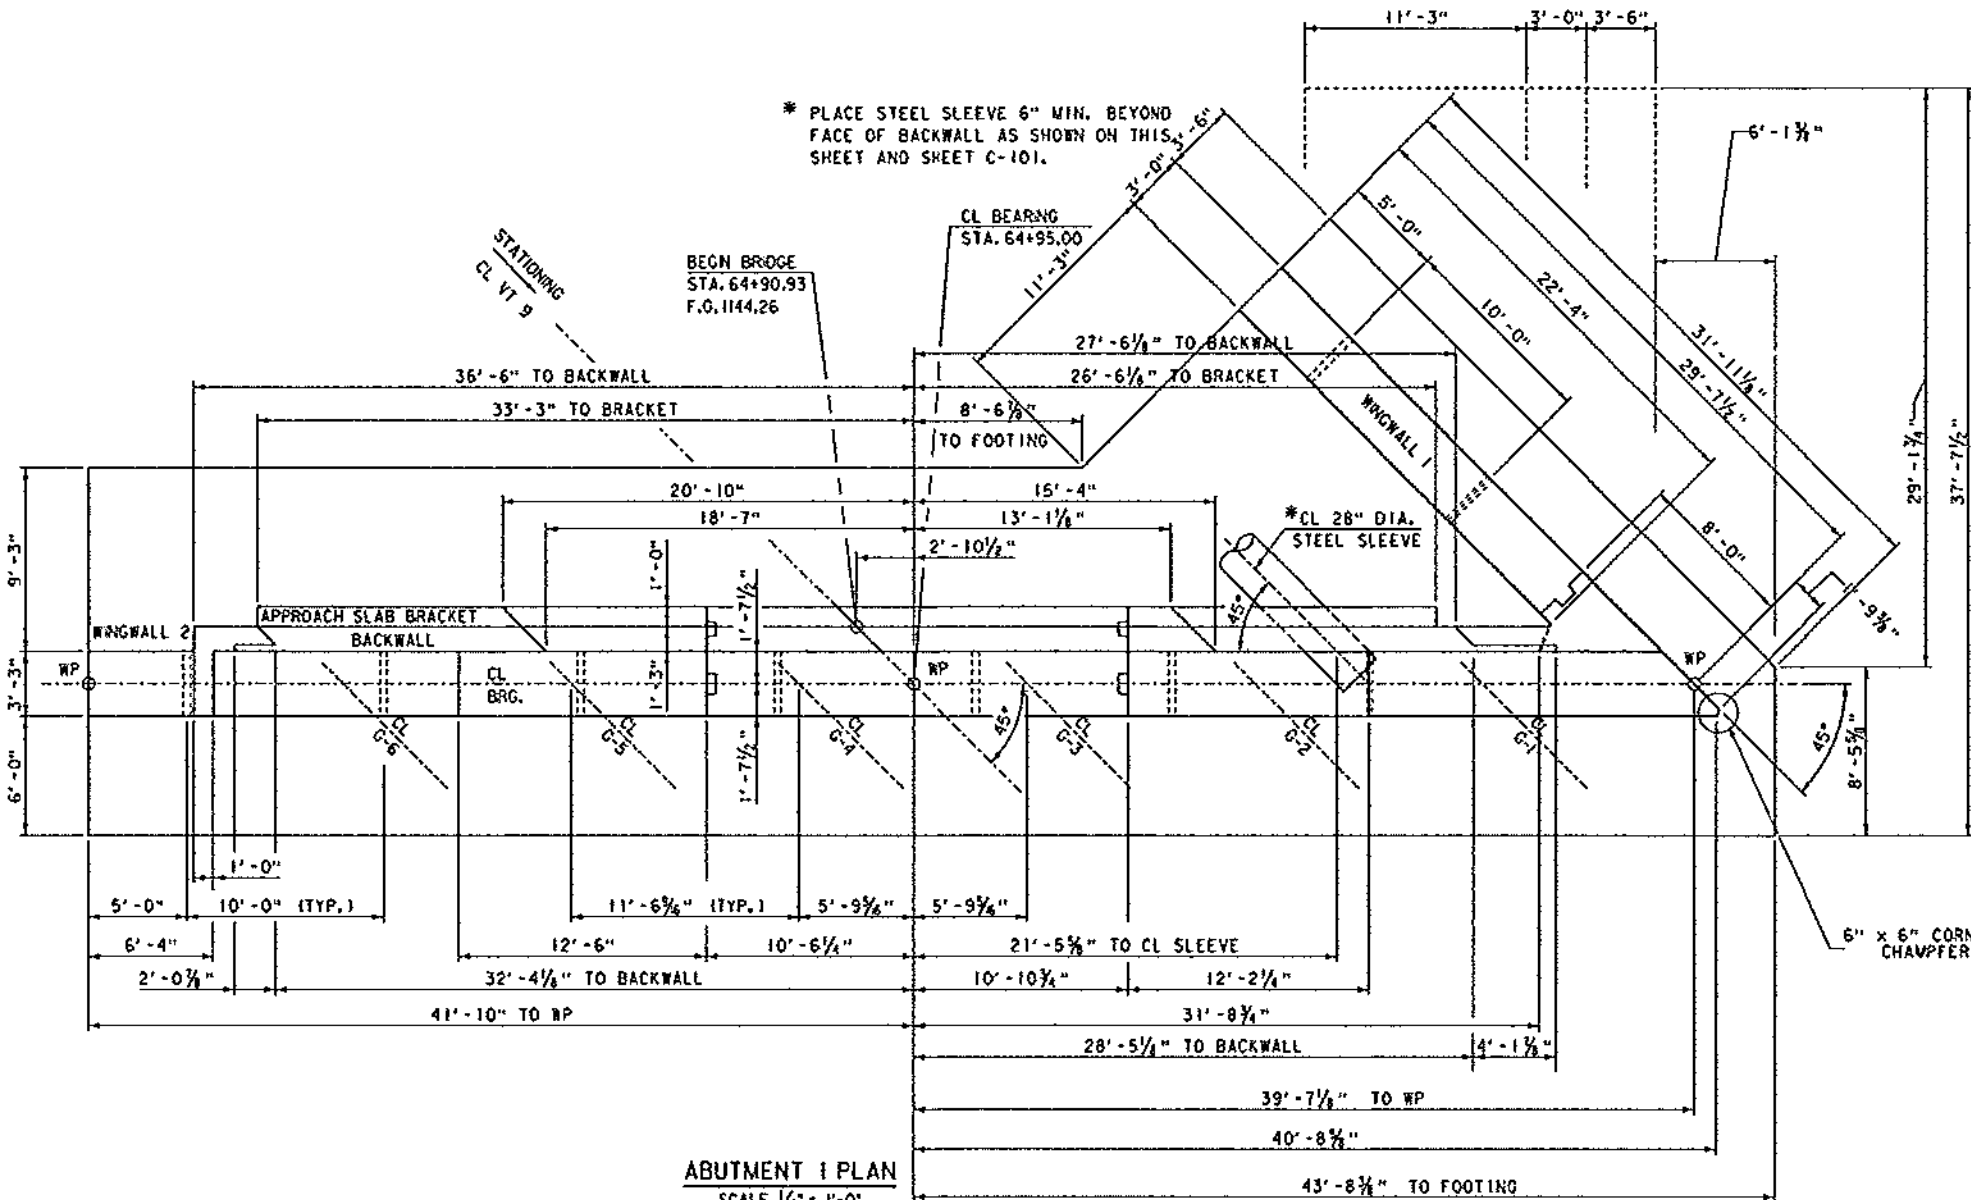

PROJECT NAME:	
PROJECT NUMBER:	
FILE NAME:	
PROJECT LEADER:	<i>1-45678</i>
DESIGNED BY:	
	PLOT DATE: 13-SEP-20
	DRAWN BY:
	CHECKED BY: