



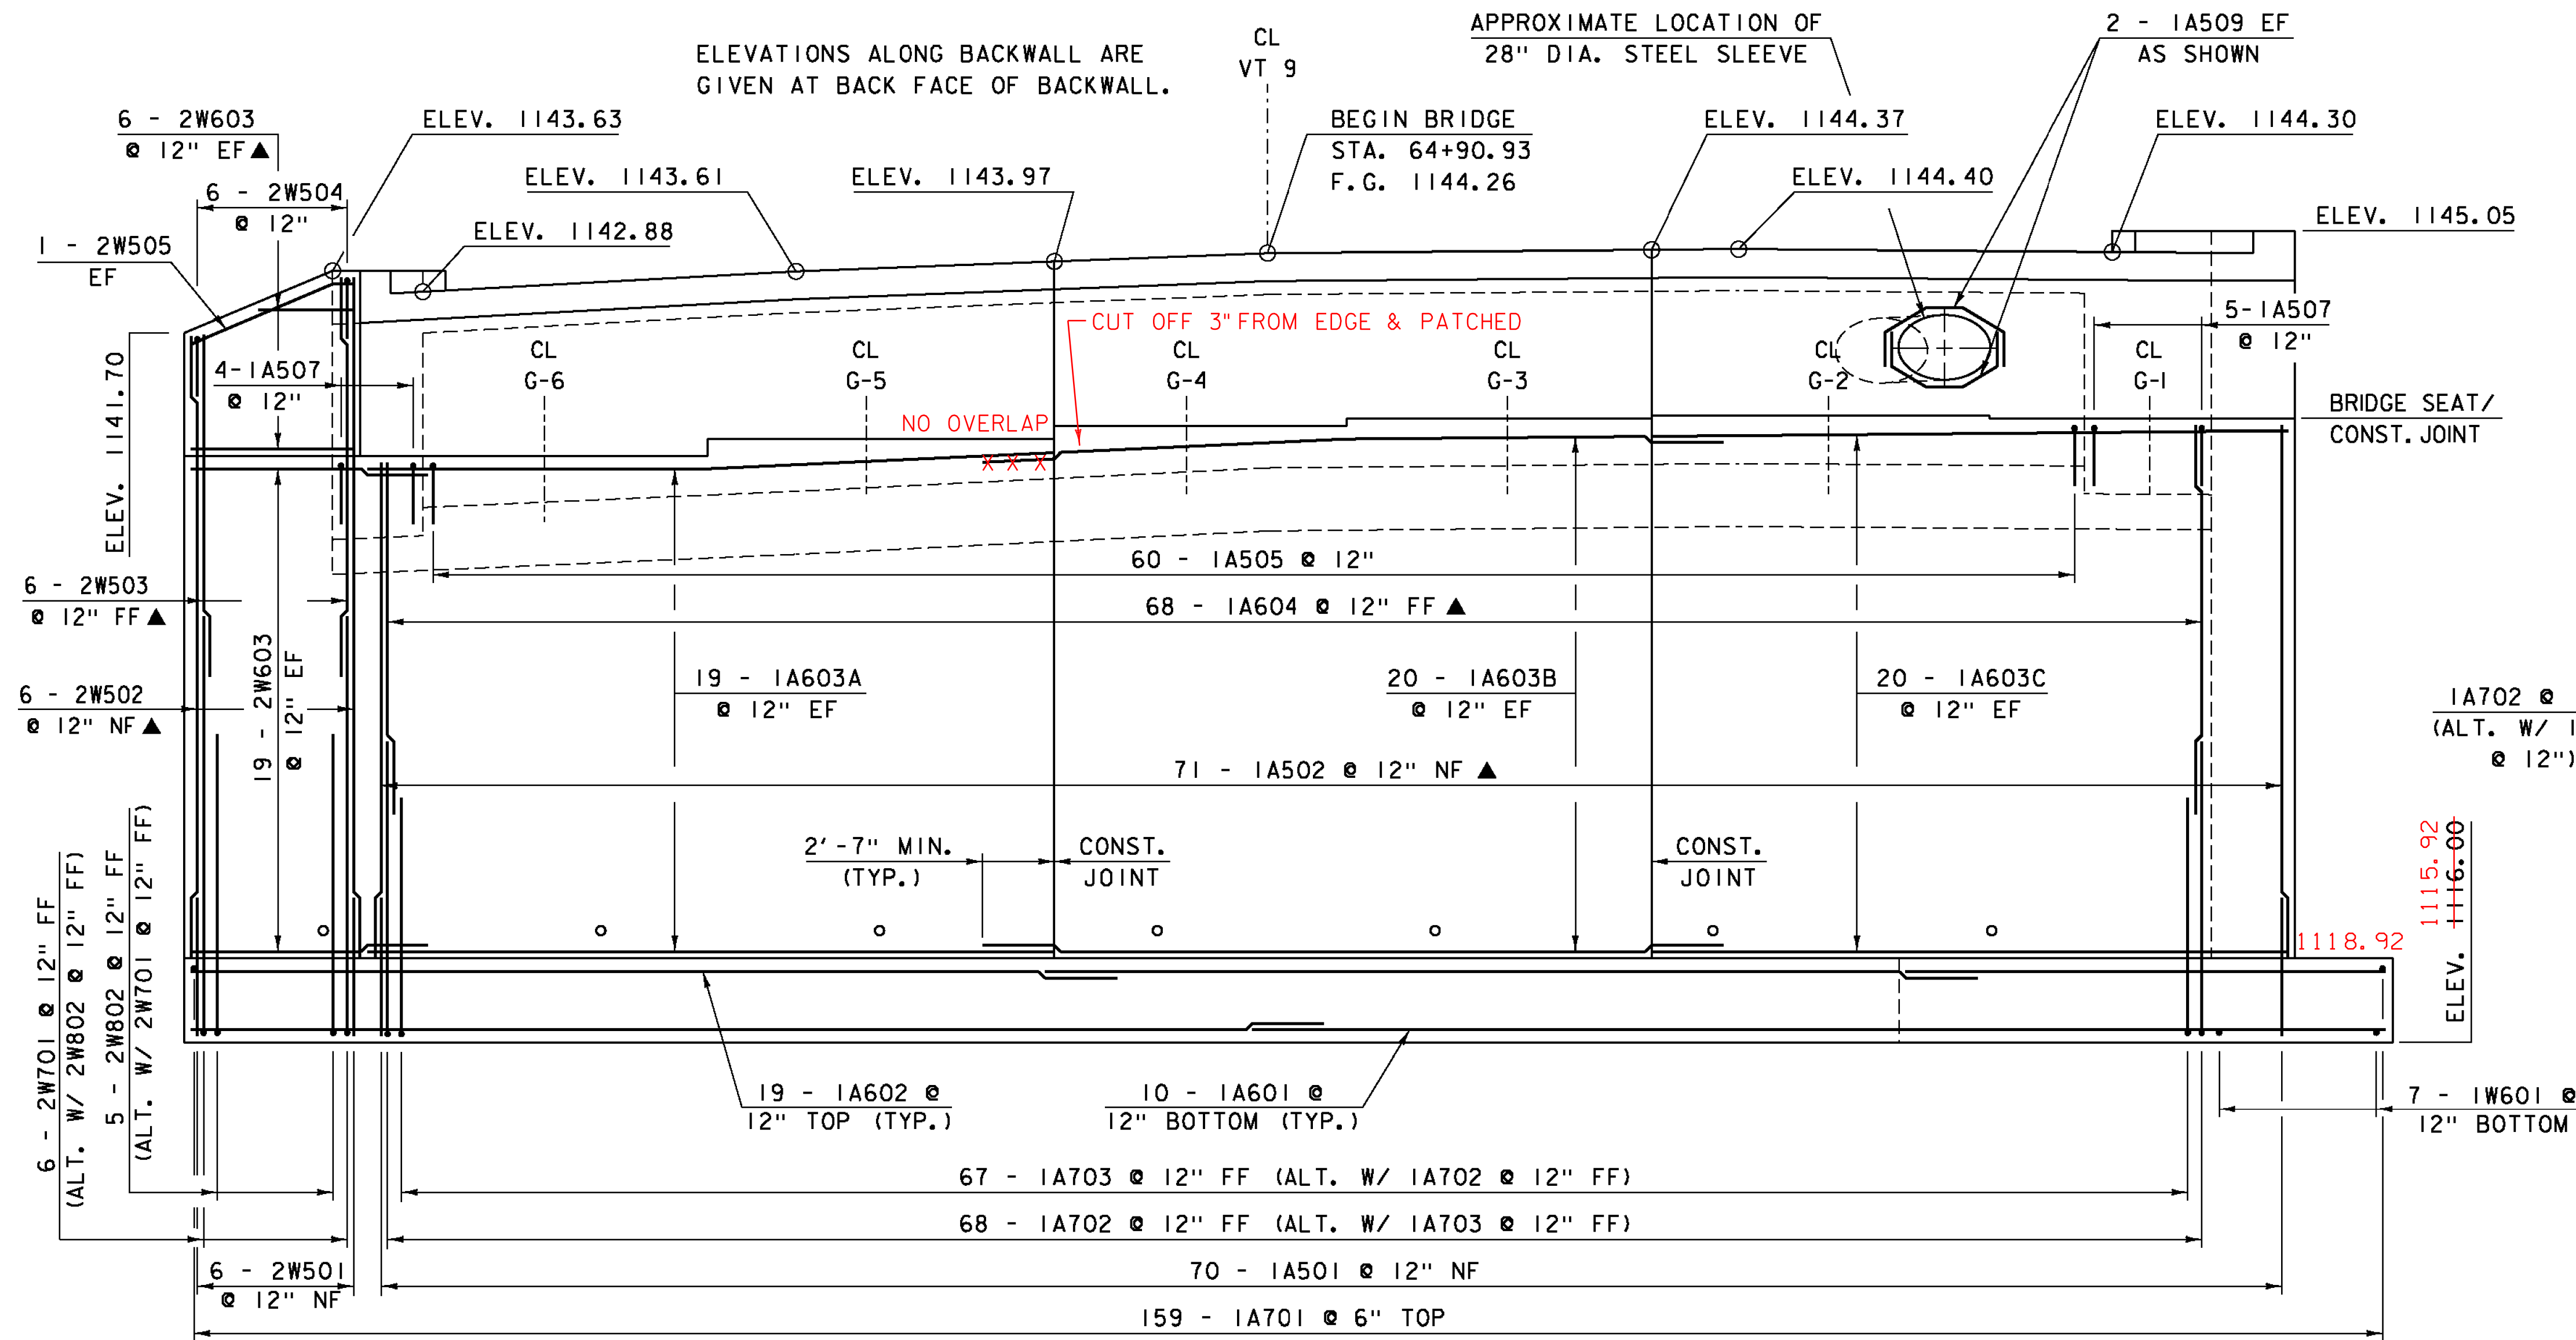


ABUTMENT I ELEVATION

SCALE 1/4" = 1'-0"

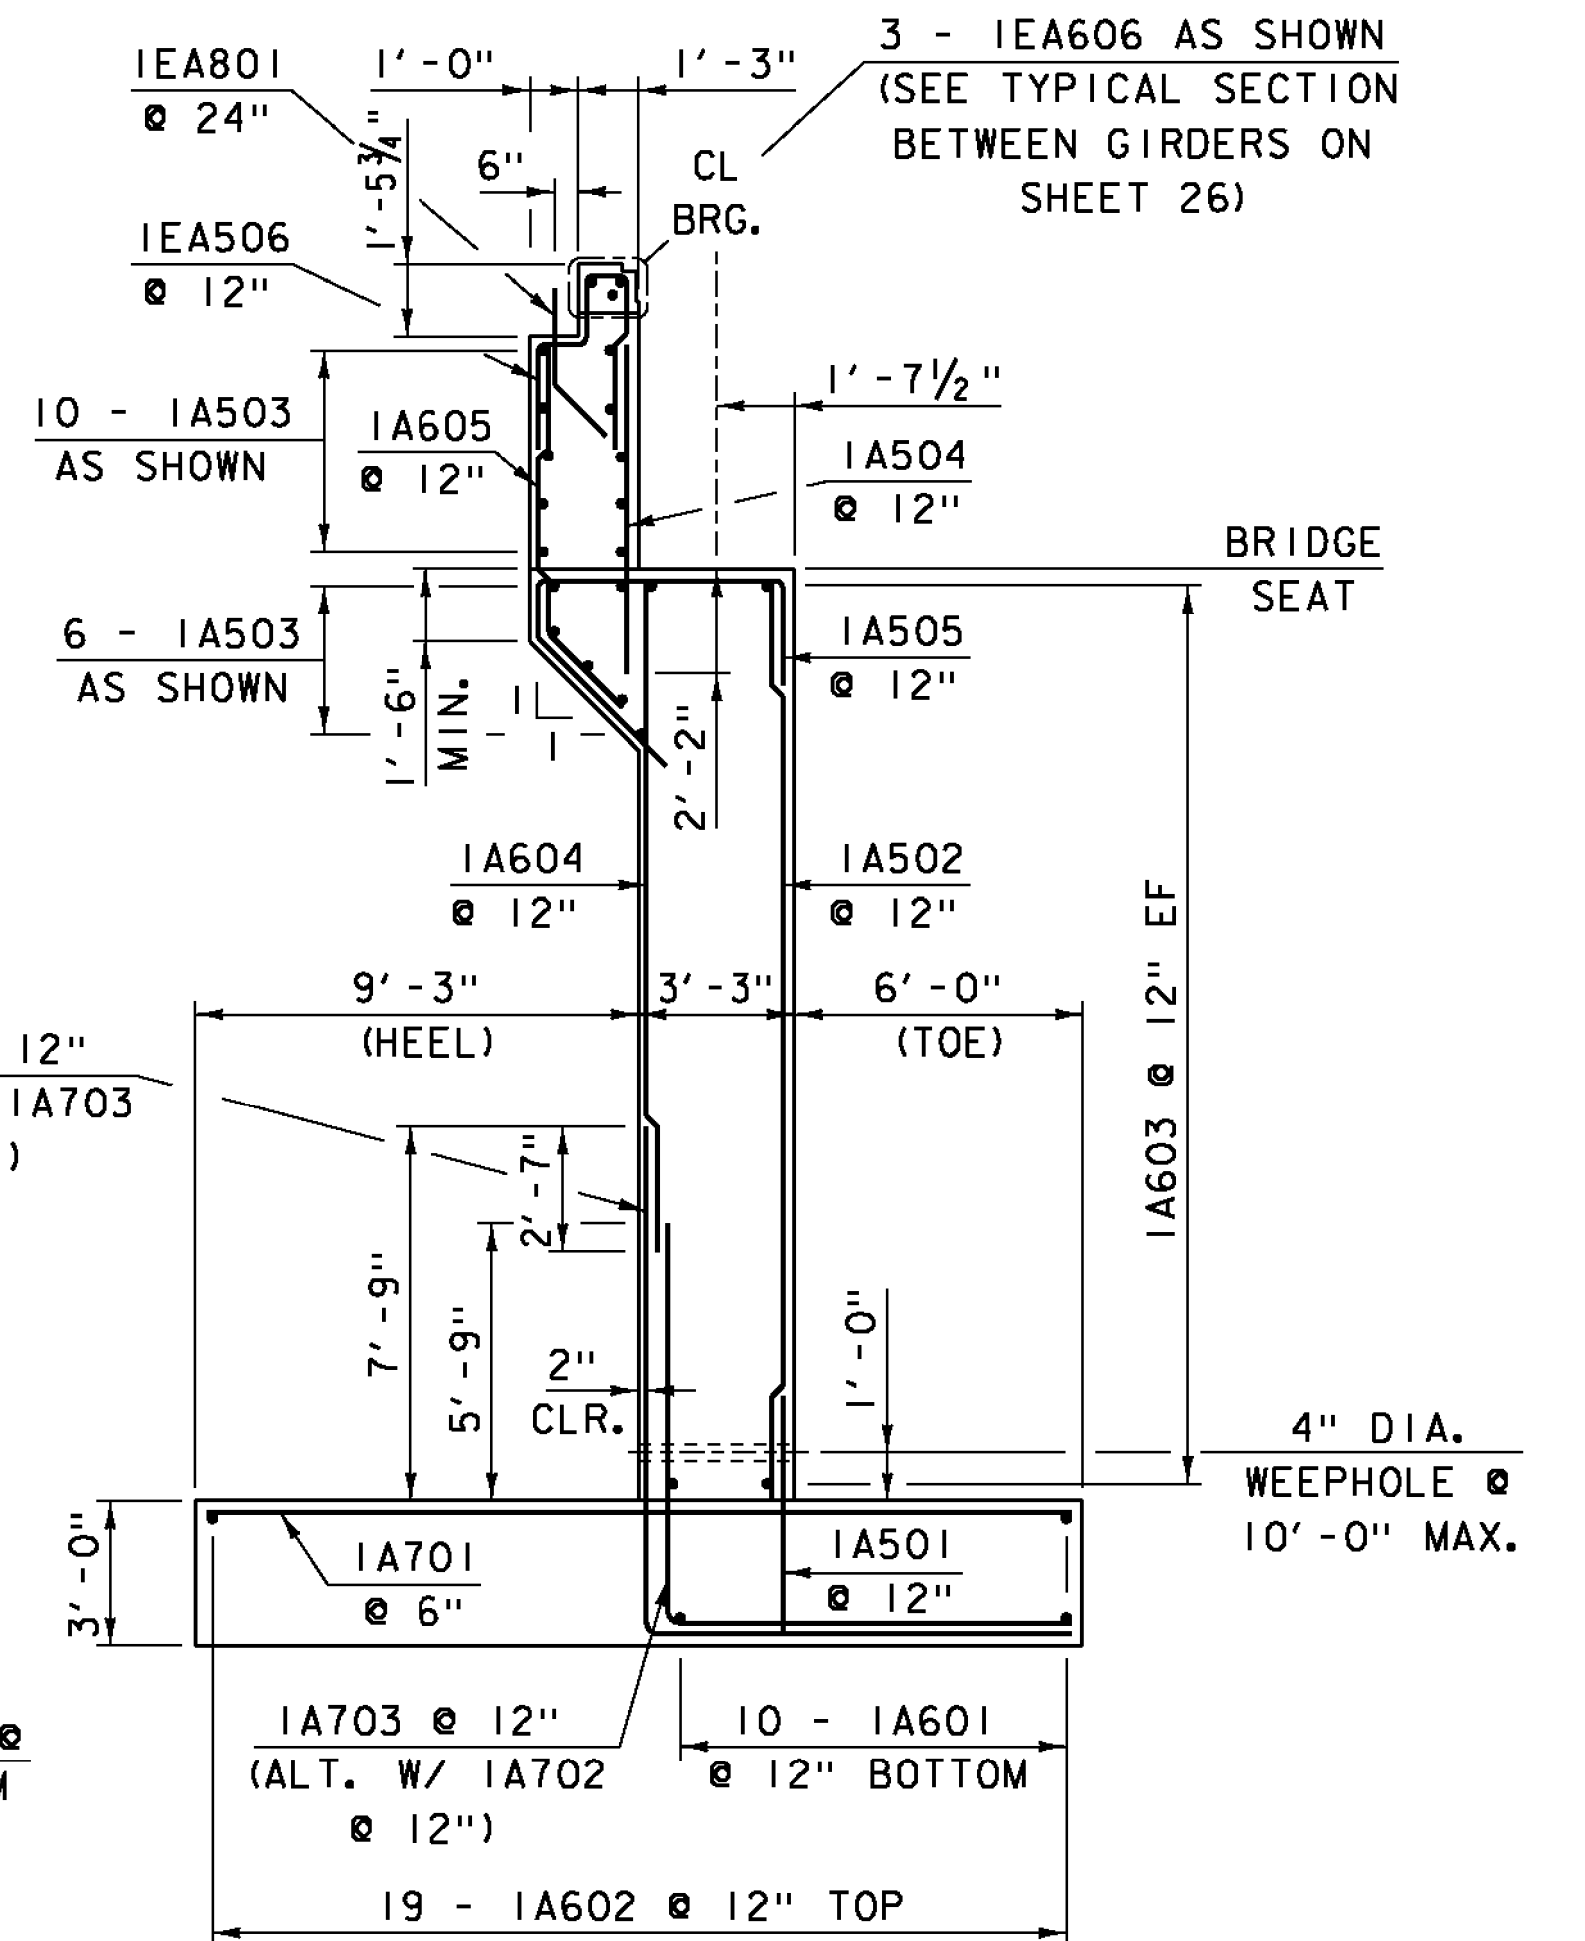

ABUTMENT I TYPICAL SECTION

SCALE 1/4" = 1'-0"

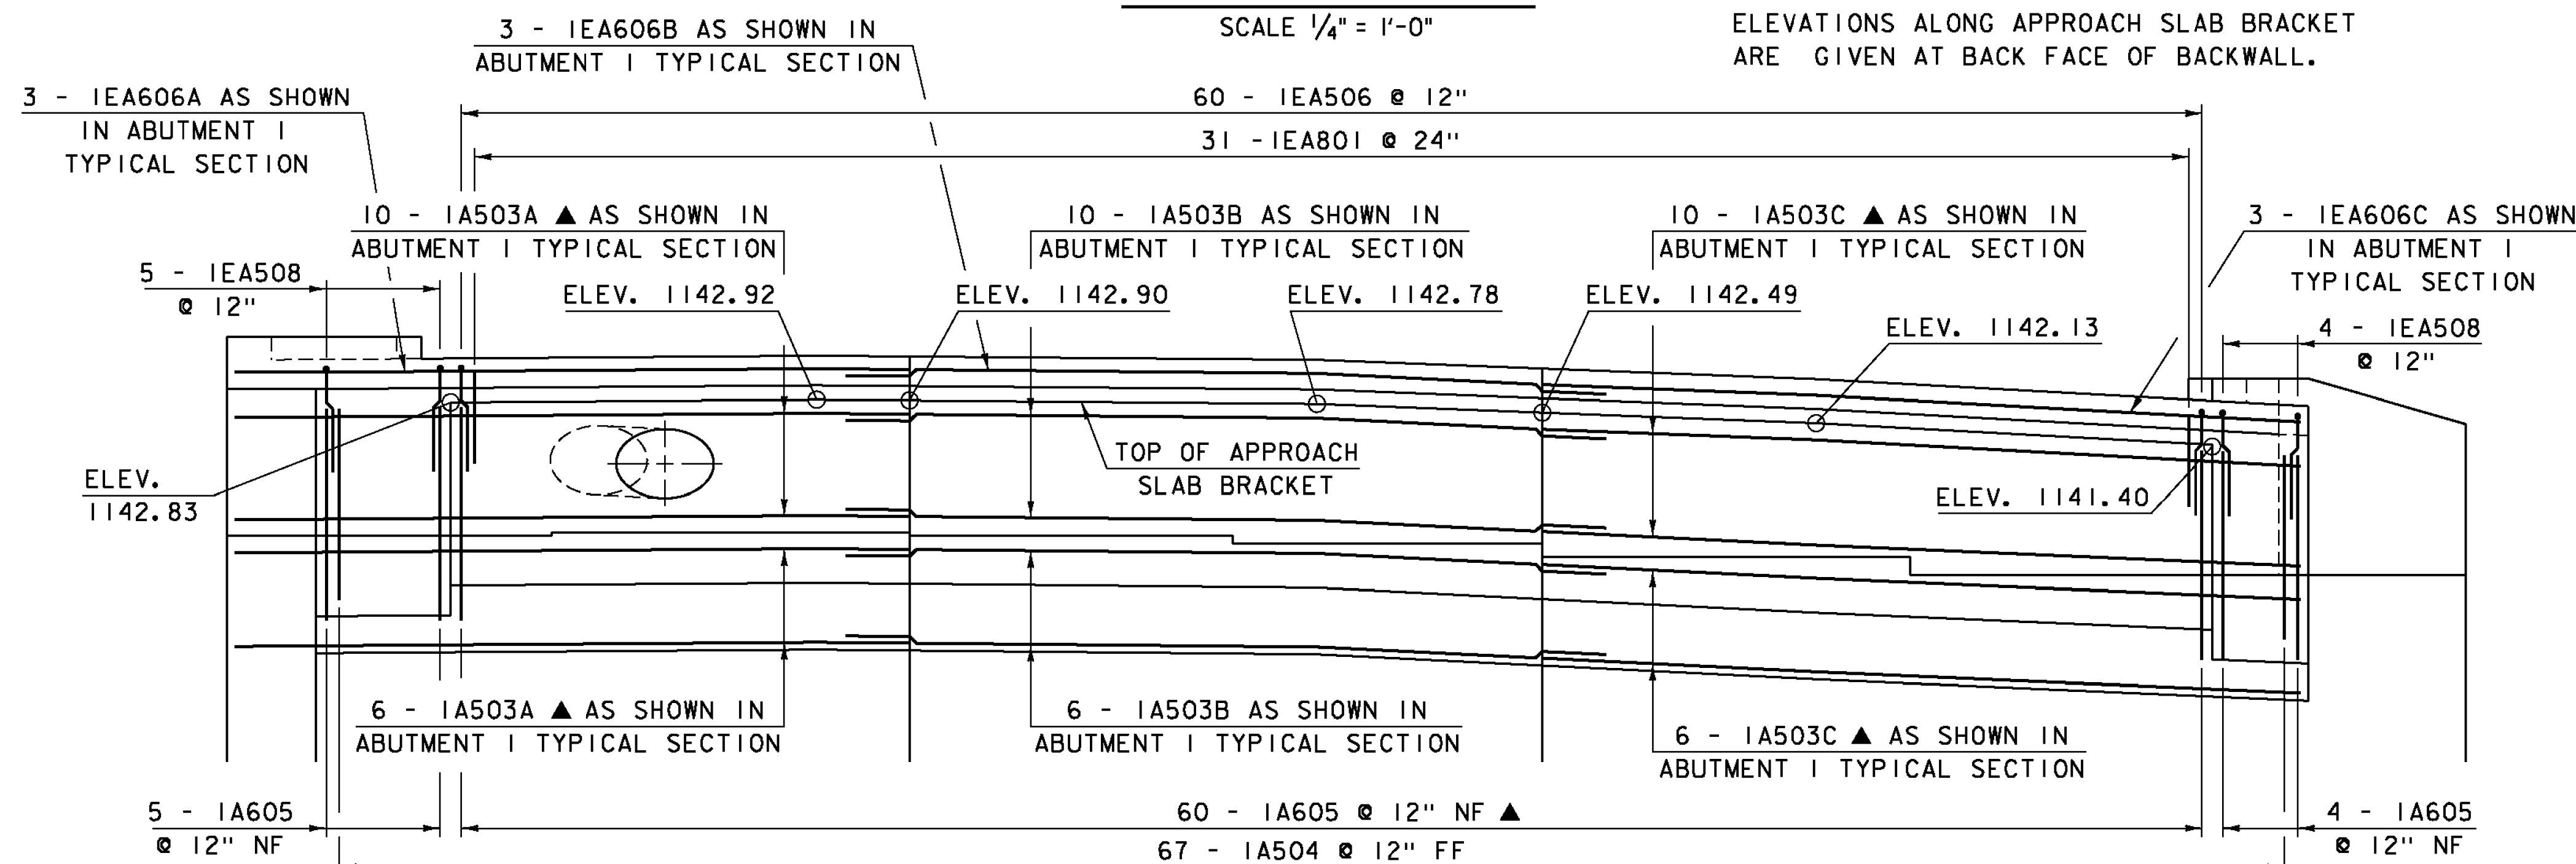

ABUTMENT I ELEVATION (LOOKING AT BACK OF ABUTMENT)

SCALE 1/4" = 1'-0"

BRIDGE SEAT	ELEVATION
SEAT 1	1138.33
SEAT 2	1138.42
SEAT 3	1138.33
SEAT 4	1138.06
SEAT 5	1137.61
SEAT 6	1136.99

NOTE:

NF = NEAR FACE
FF = FAR FACE
EF = EACH FACE
▲ = CUT TO FIT IN FIELD
3" CLEAR, UNLESS OTHERWISE SPECIFIED ON THE PLANS.
2'-2" BAR LAP UNLESS OTHERWISE SPECIFIED ON THE PLANS.

PROJECT NAME: WOODFORD
PROJECT NUMBER: ER BHF 010-(44)

FILE NAME: slb214sub.dgn
PROJECT LEADER: C. CARLSON
DESIGNED BY: M. EVANS-MONGEON
ABUTMENT I ELEVATION
PLOT DATE: 23-MAR-2012
DRAWN BY: G. ROY
CHECKED BY: M. EVANS-MONGEON
SHEET 32 OF 58