



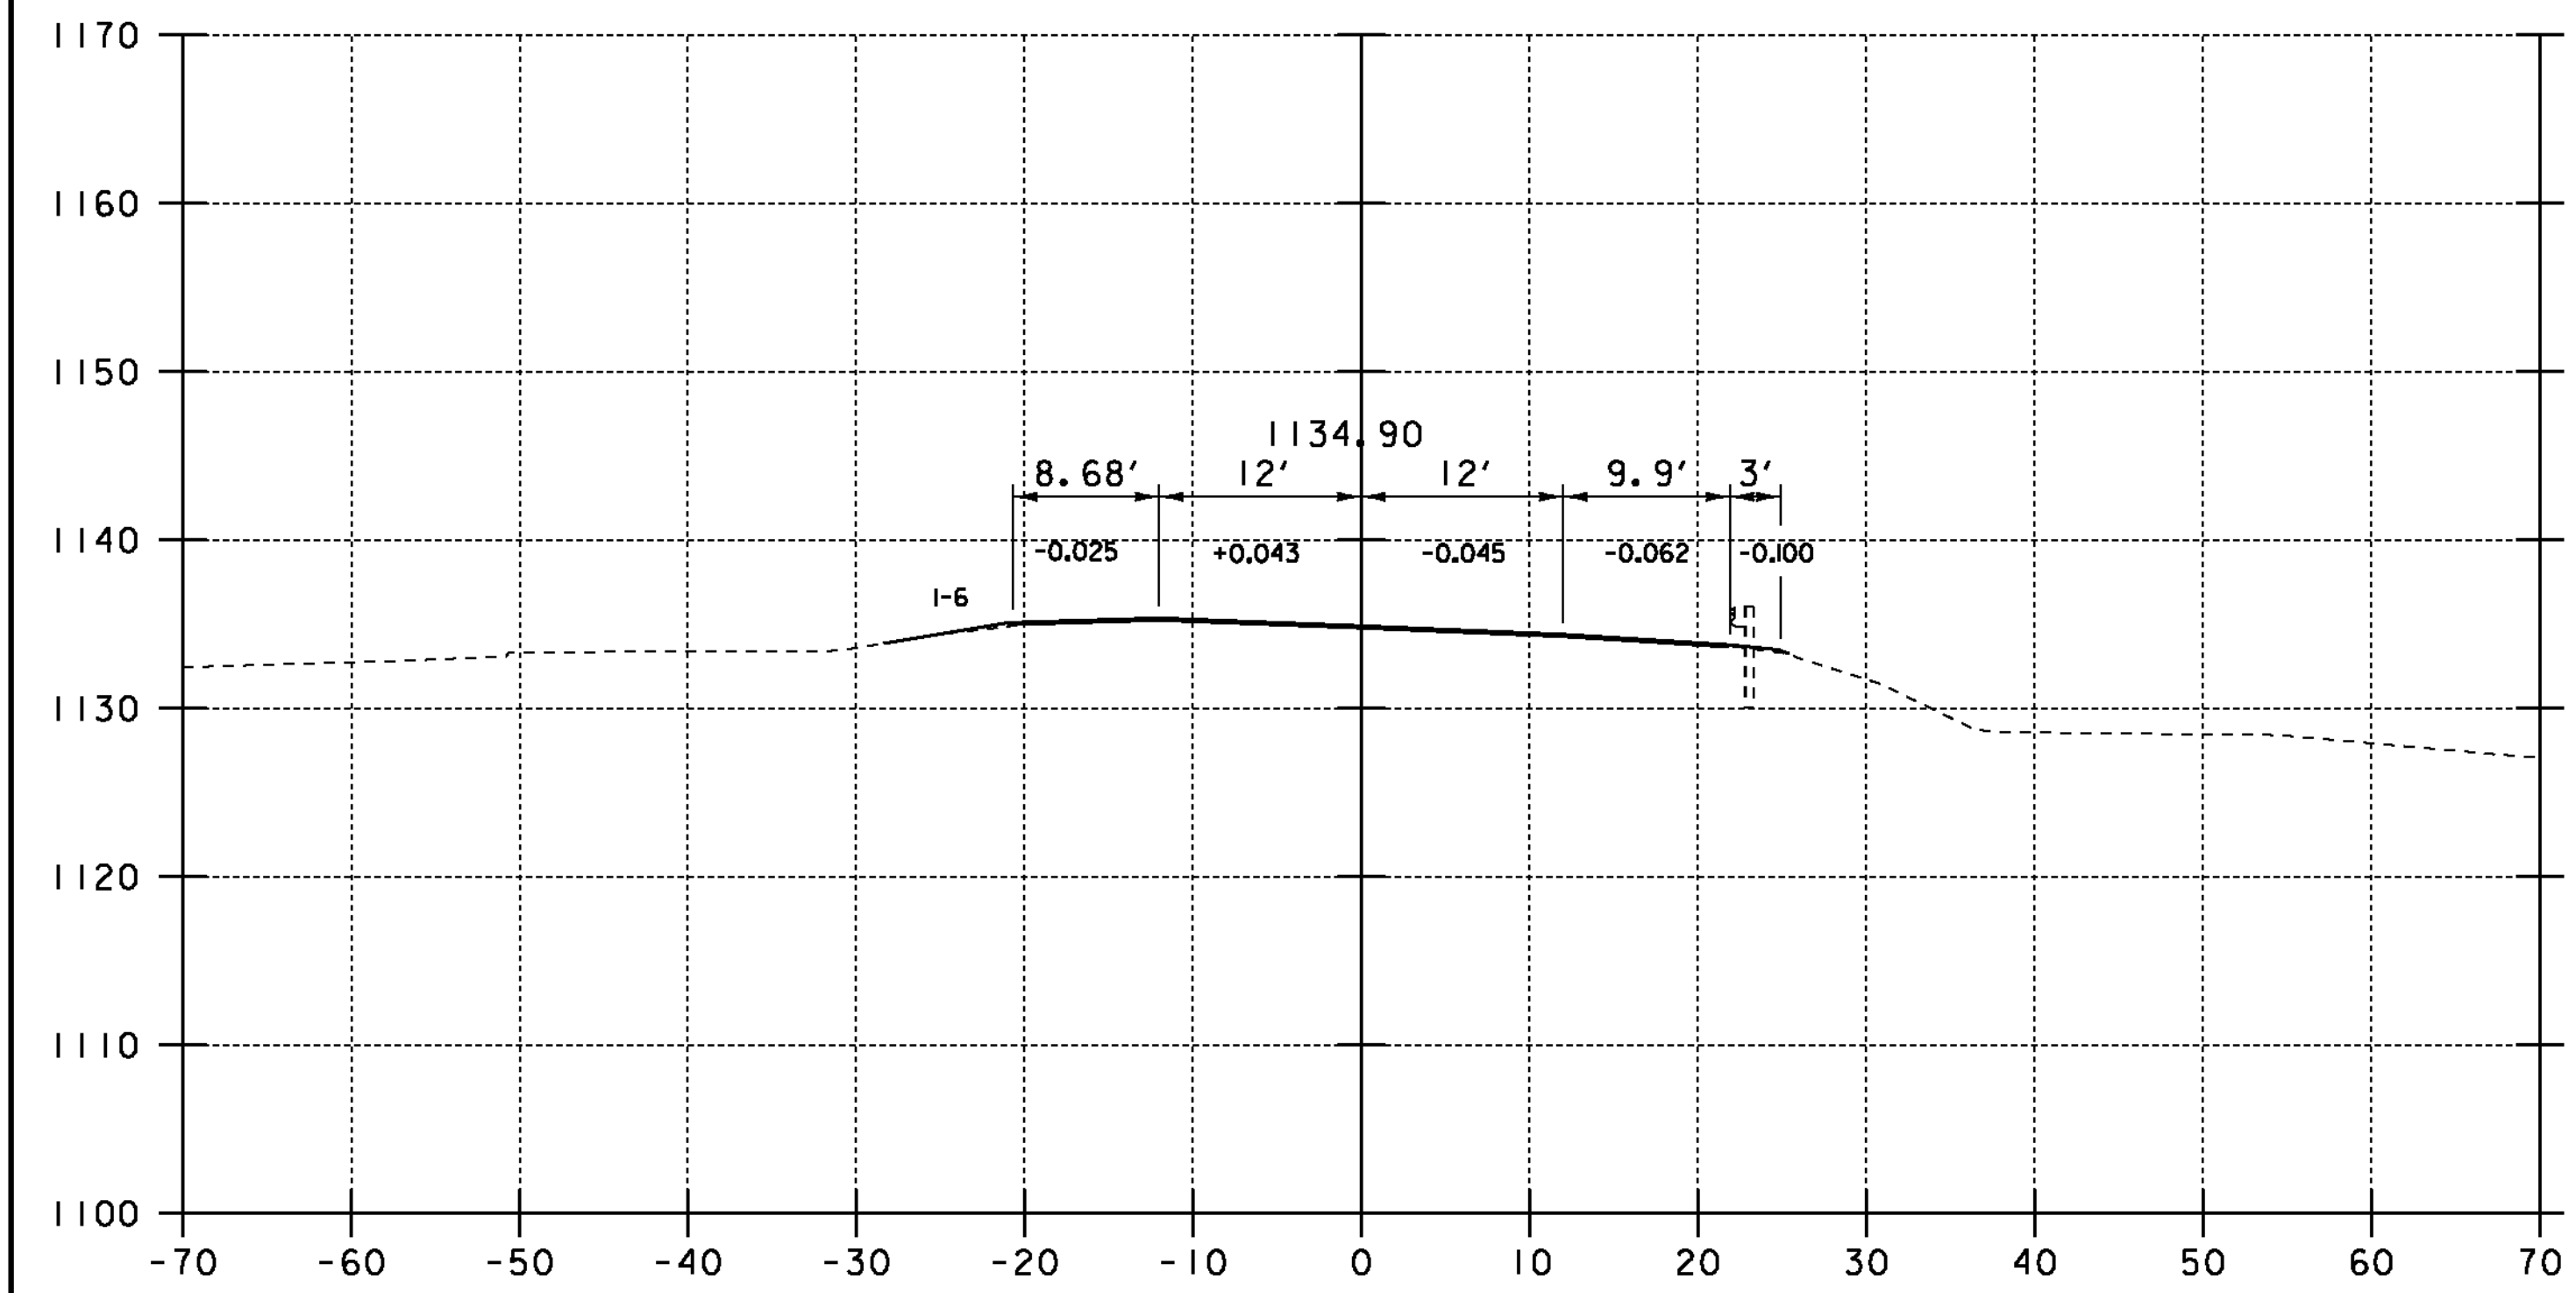


62+25.00
BEGIN APPROACH
MATCH EXISTING


62+50

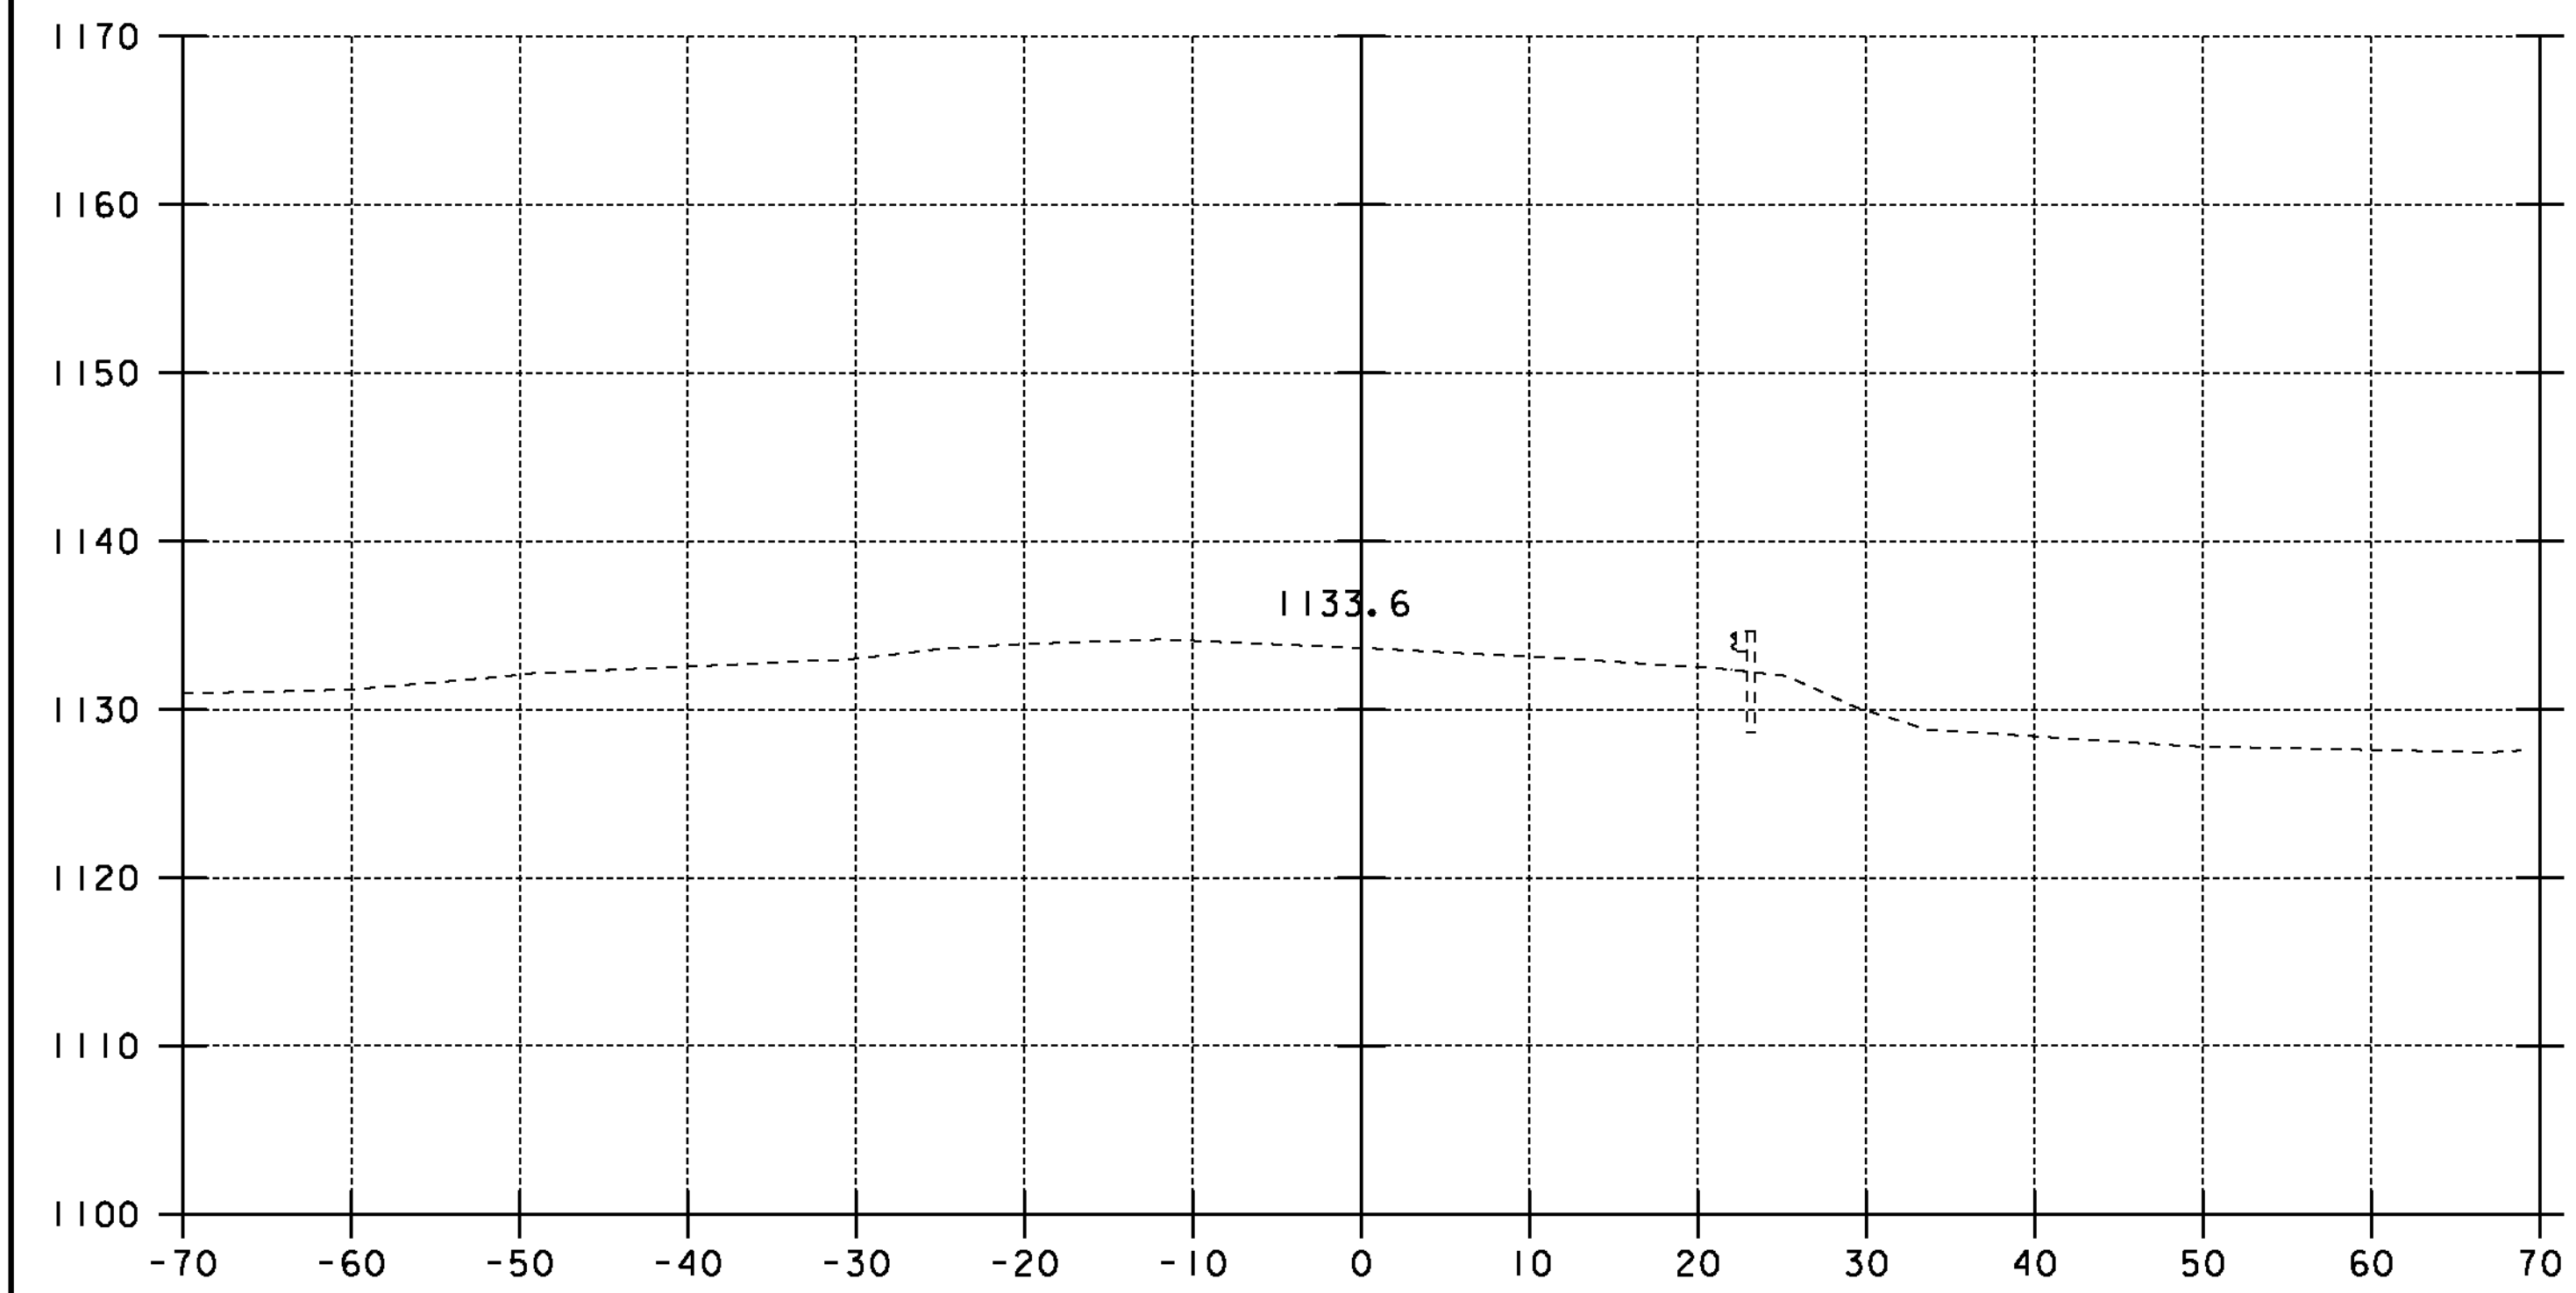

62+19

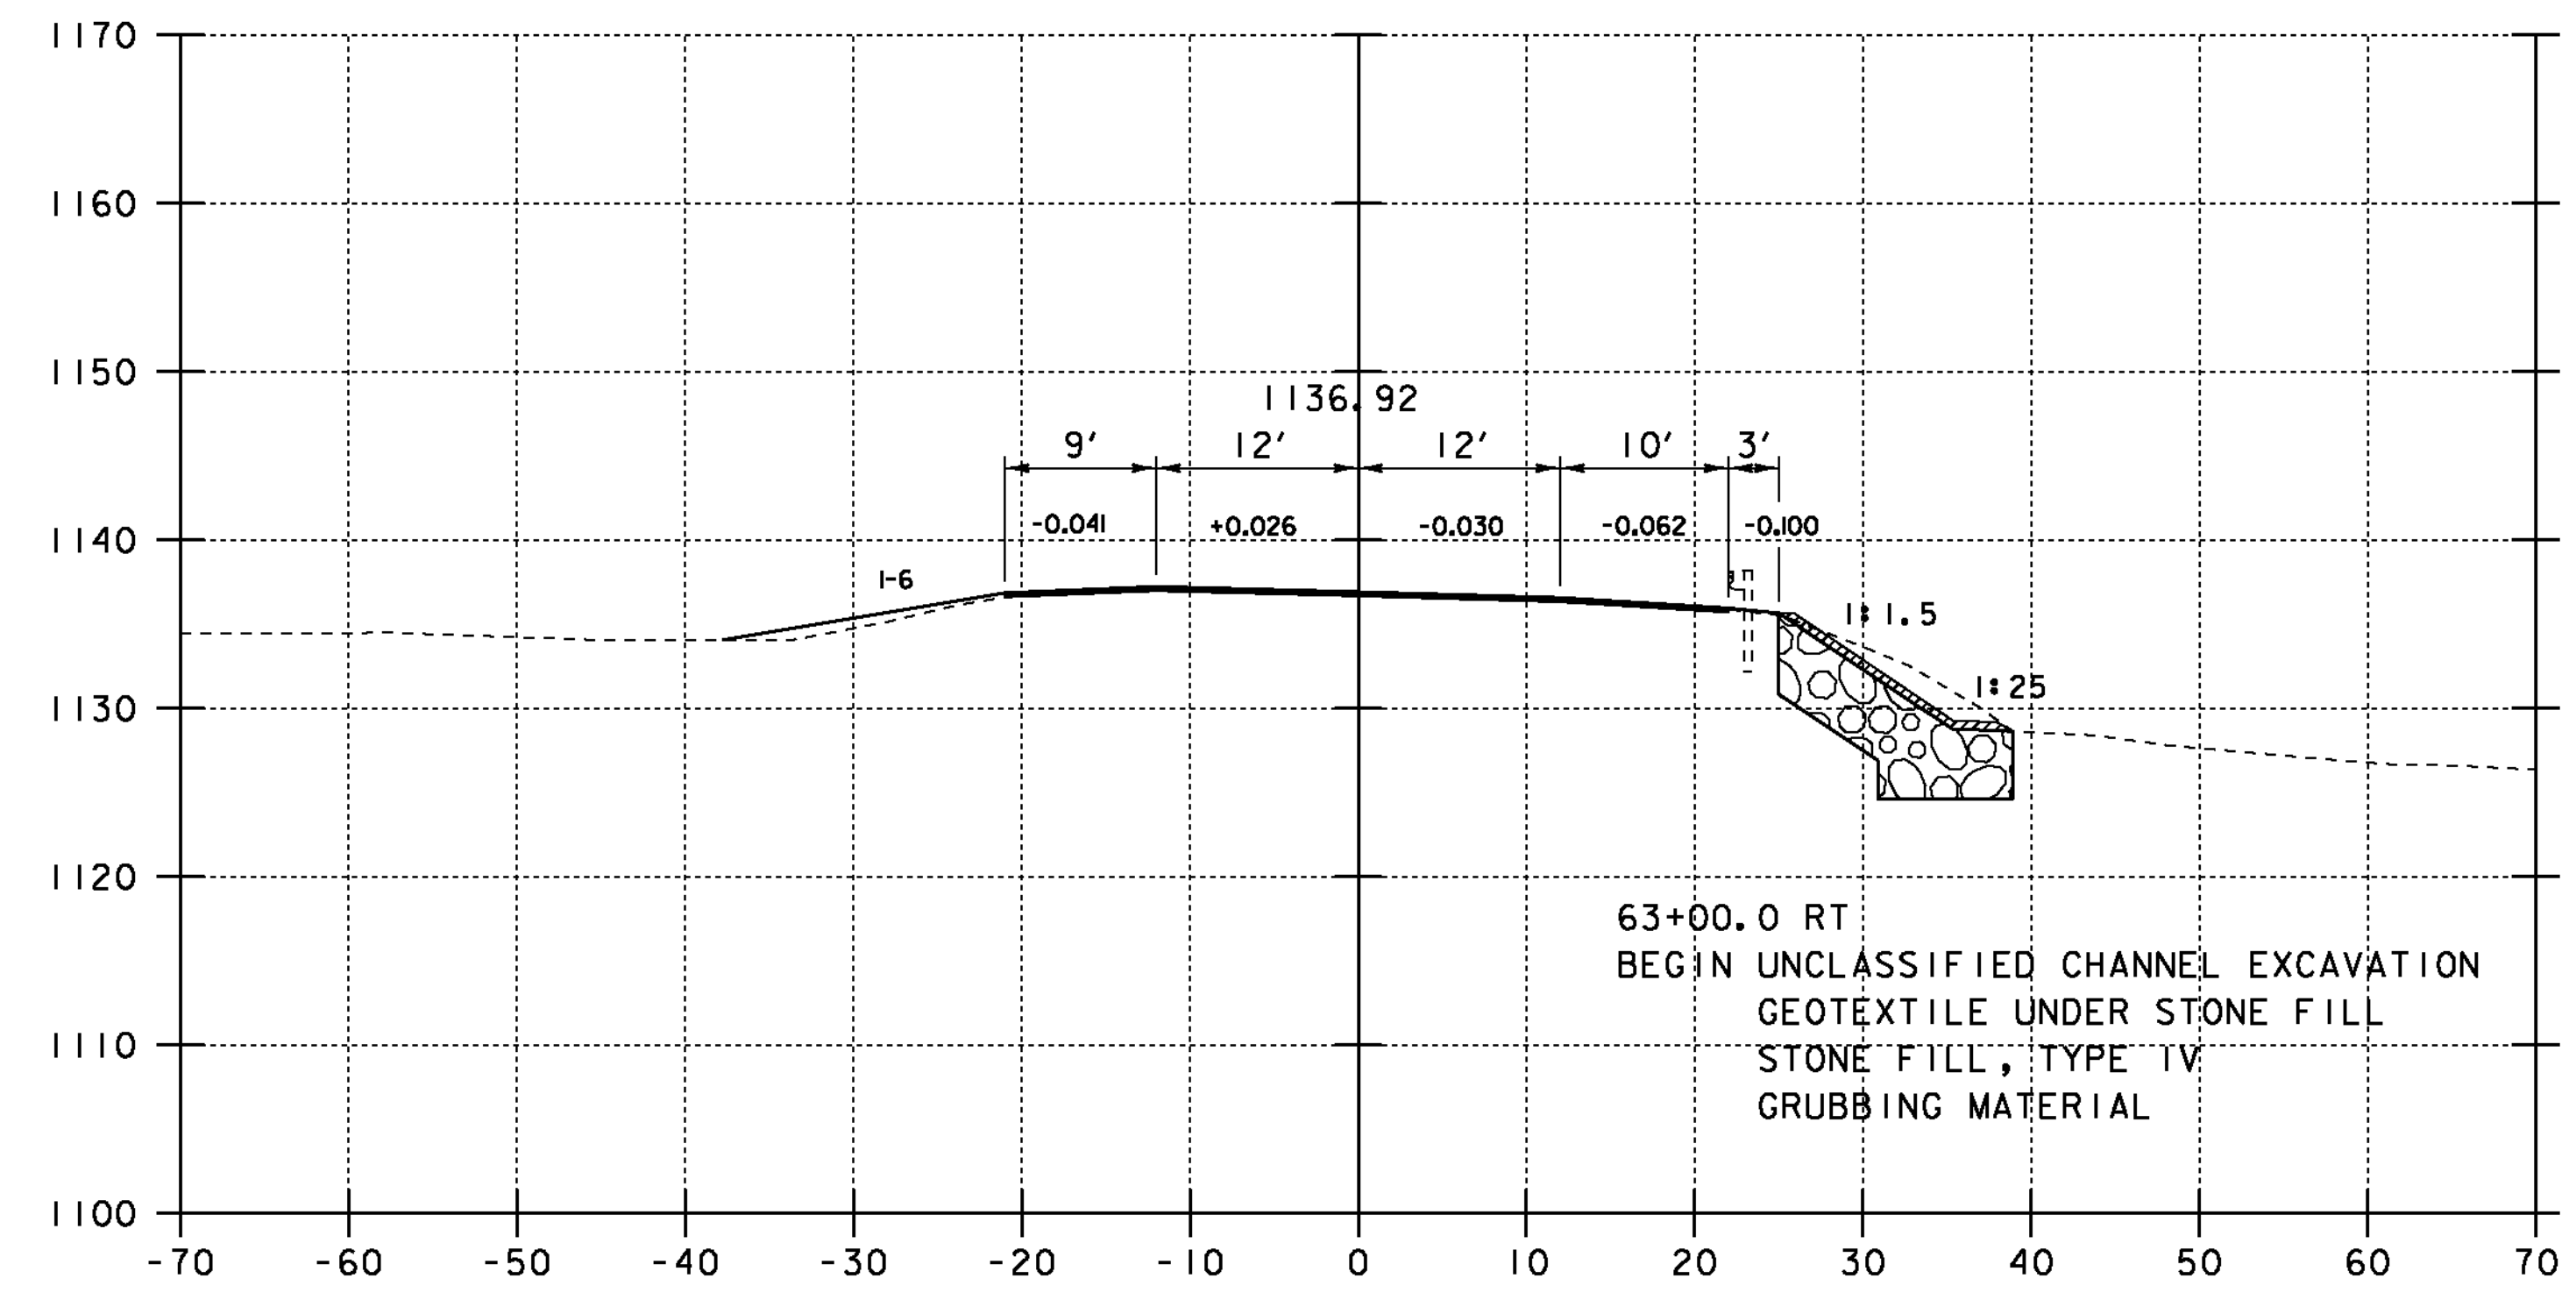

63+00

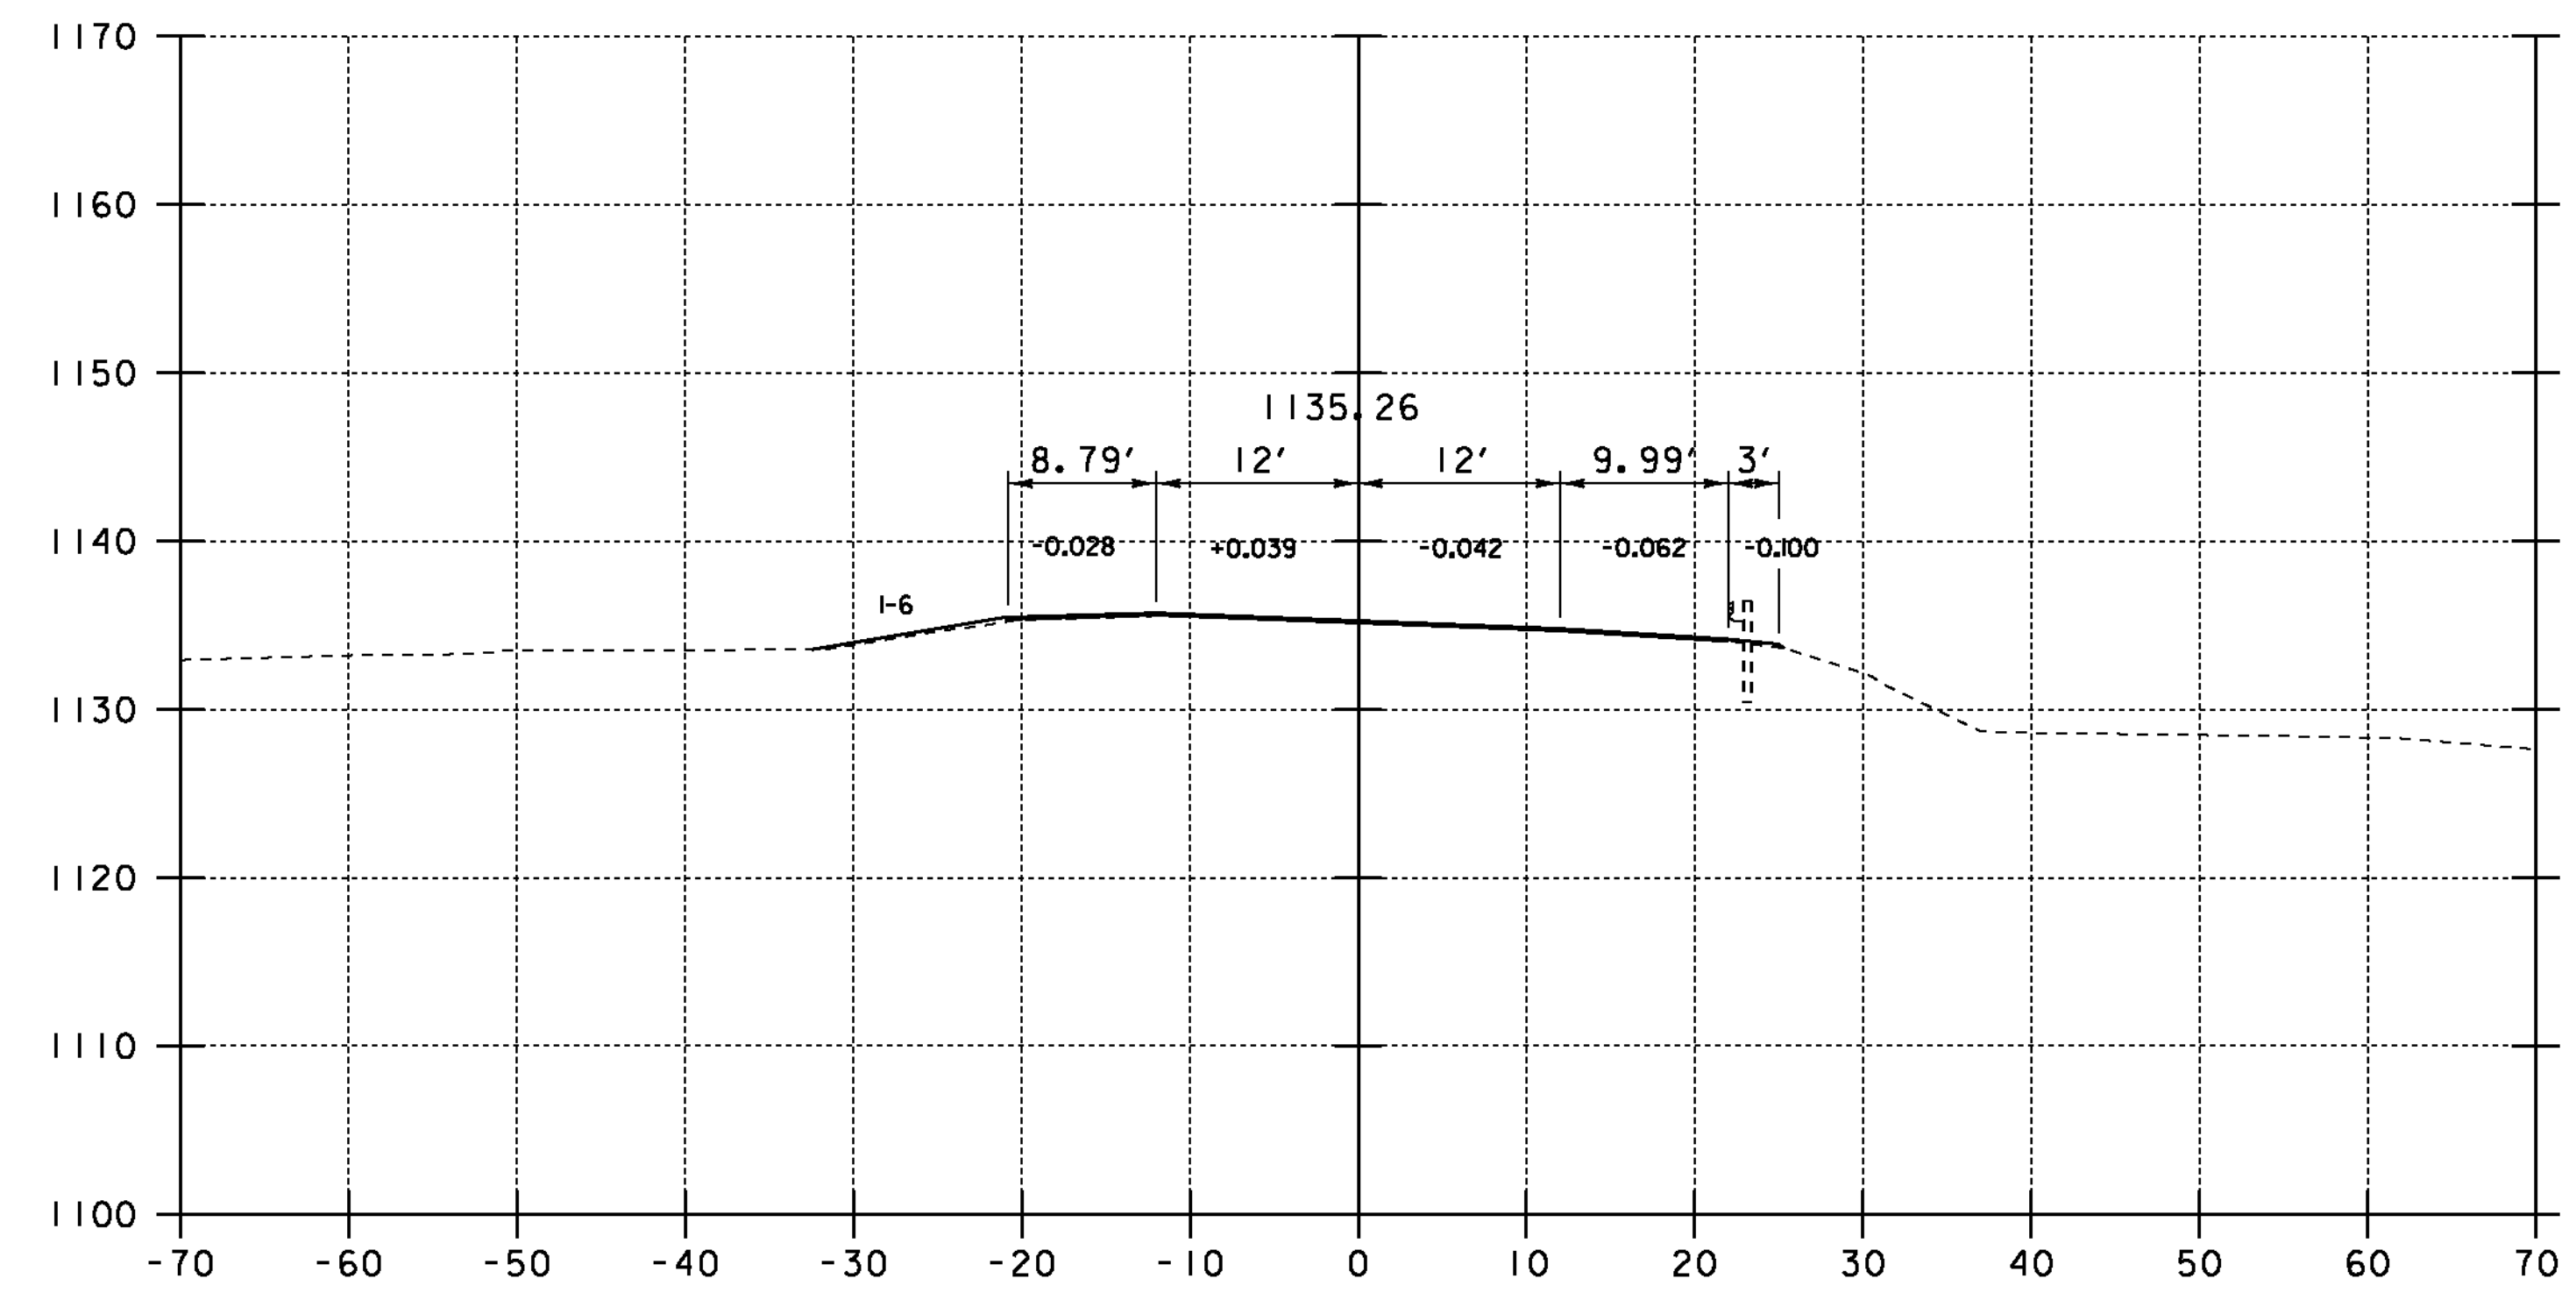

62+59

PROJECT NAME: WOODFORD	
PROJECT NUMBER: ER BHF 010-1(44)	
FILE NAME: s11b214xs.dgn	PLOT DATE: 23-MAR-2012
PROJECT LEADER: C. CARLSON	DRAWN BY: EVANS-MONGEON
DESIGNED BY: M.EVANS-MONGEON	CHECKED BY:
ROADWAY CROSS SECTIONS SHEET (1)	SHEET 36 OF 58