




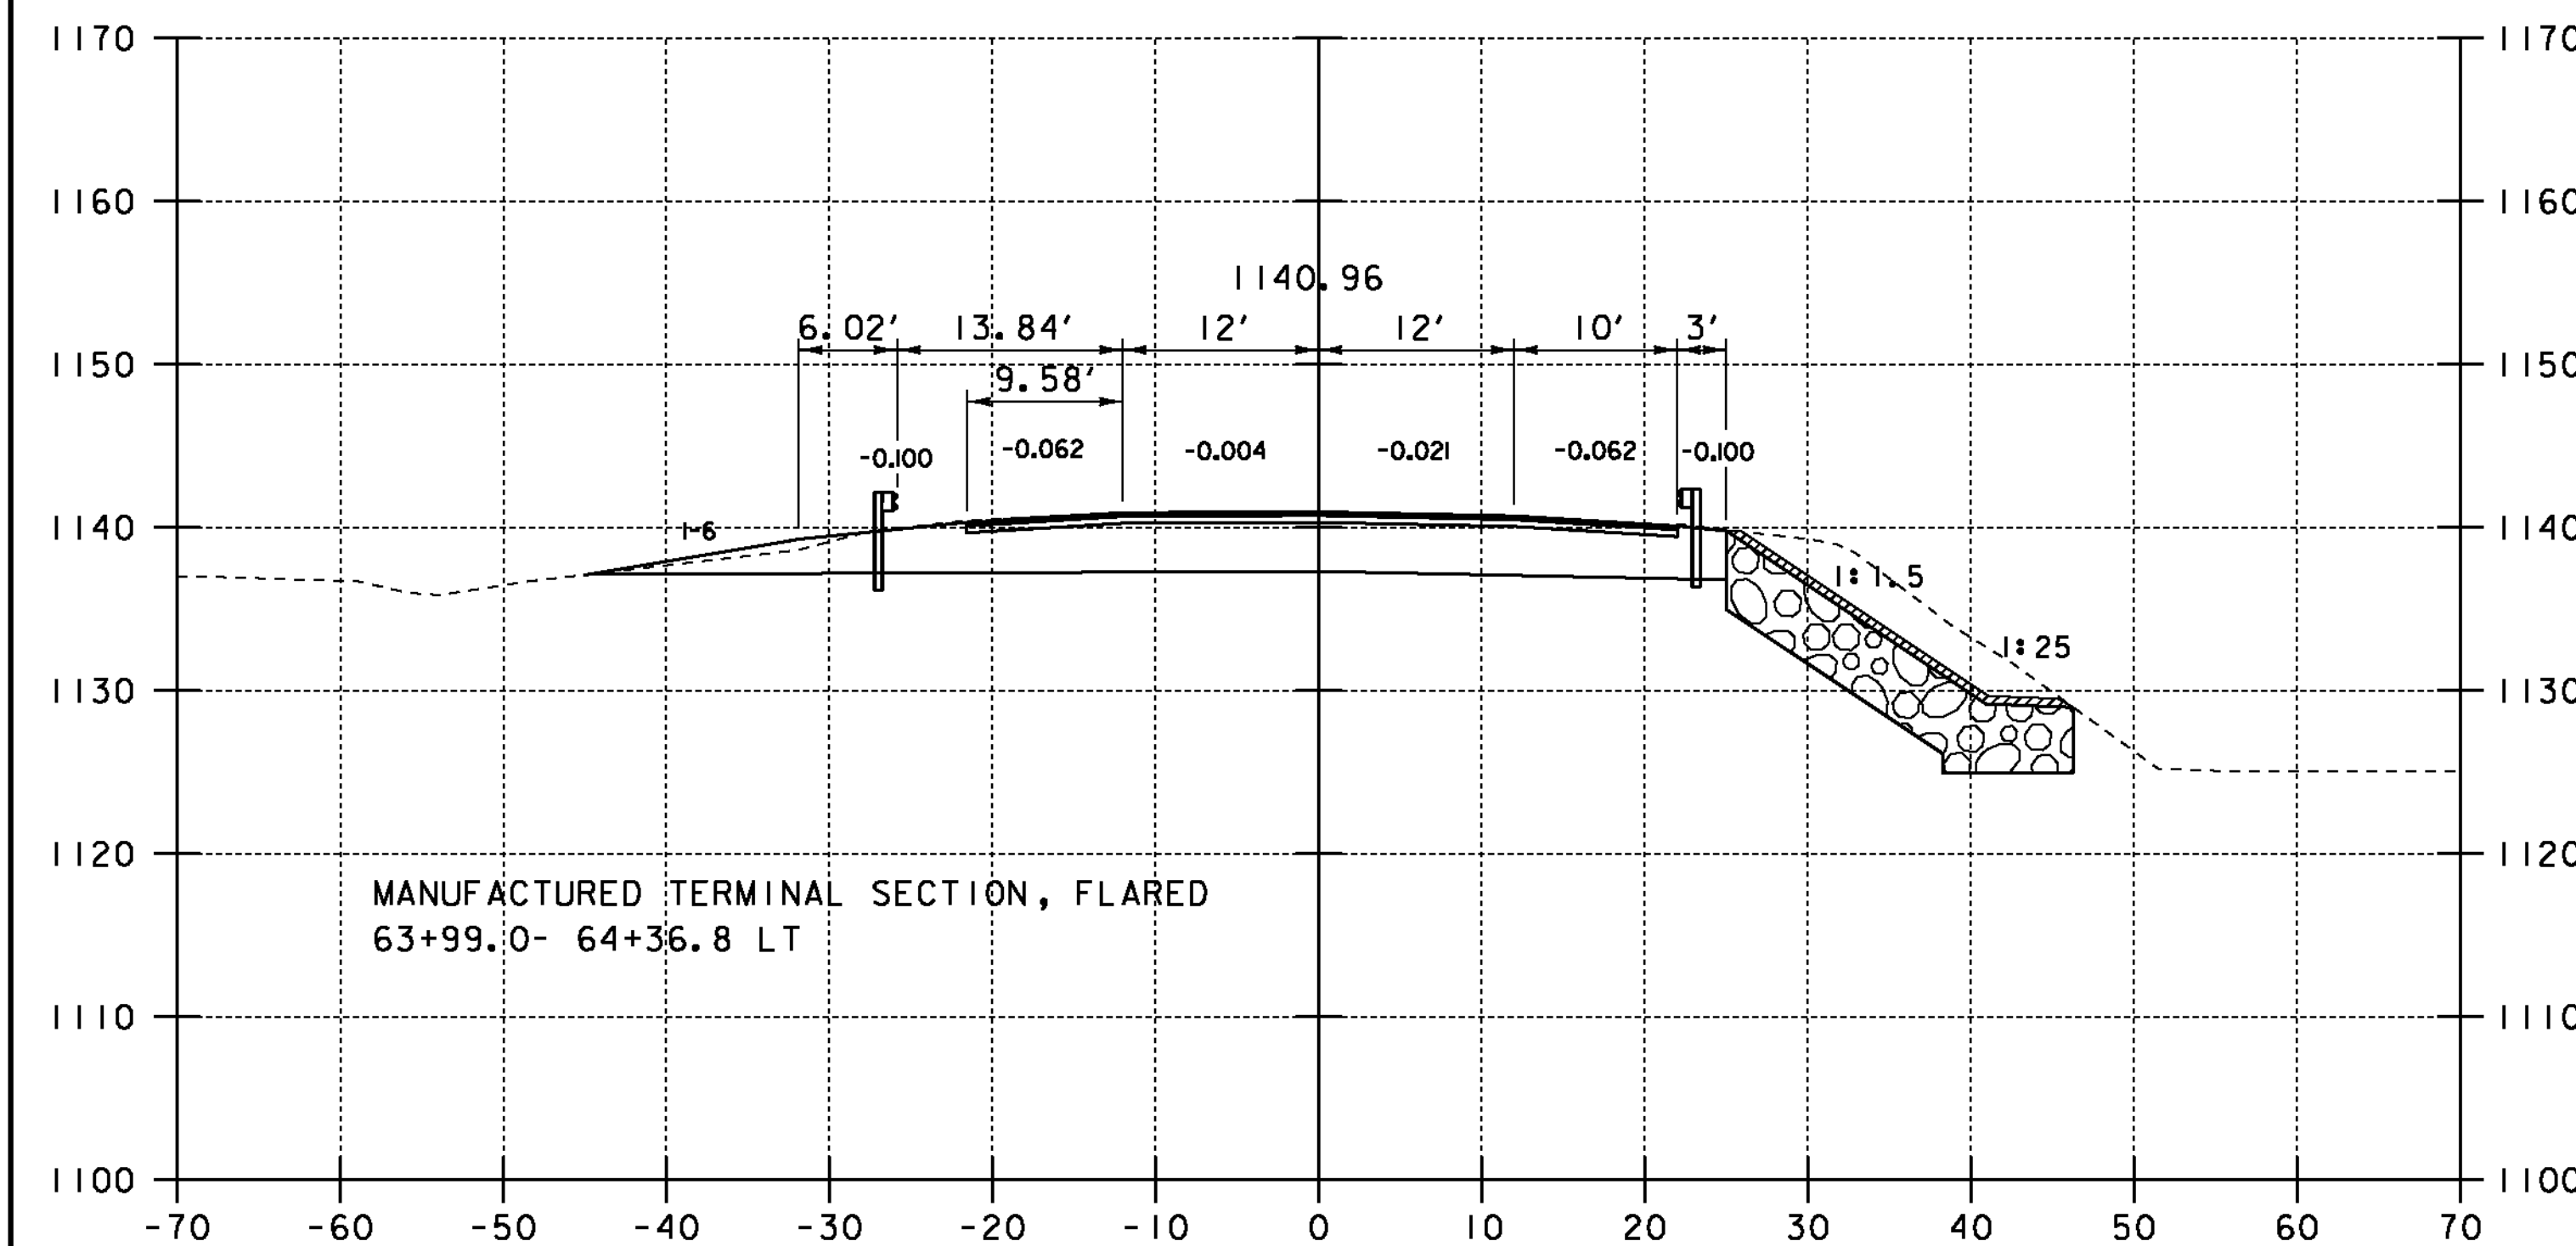


64+00.00
END APPROACH
BEGIN PROJECT

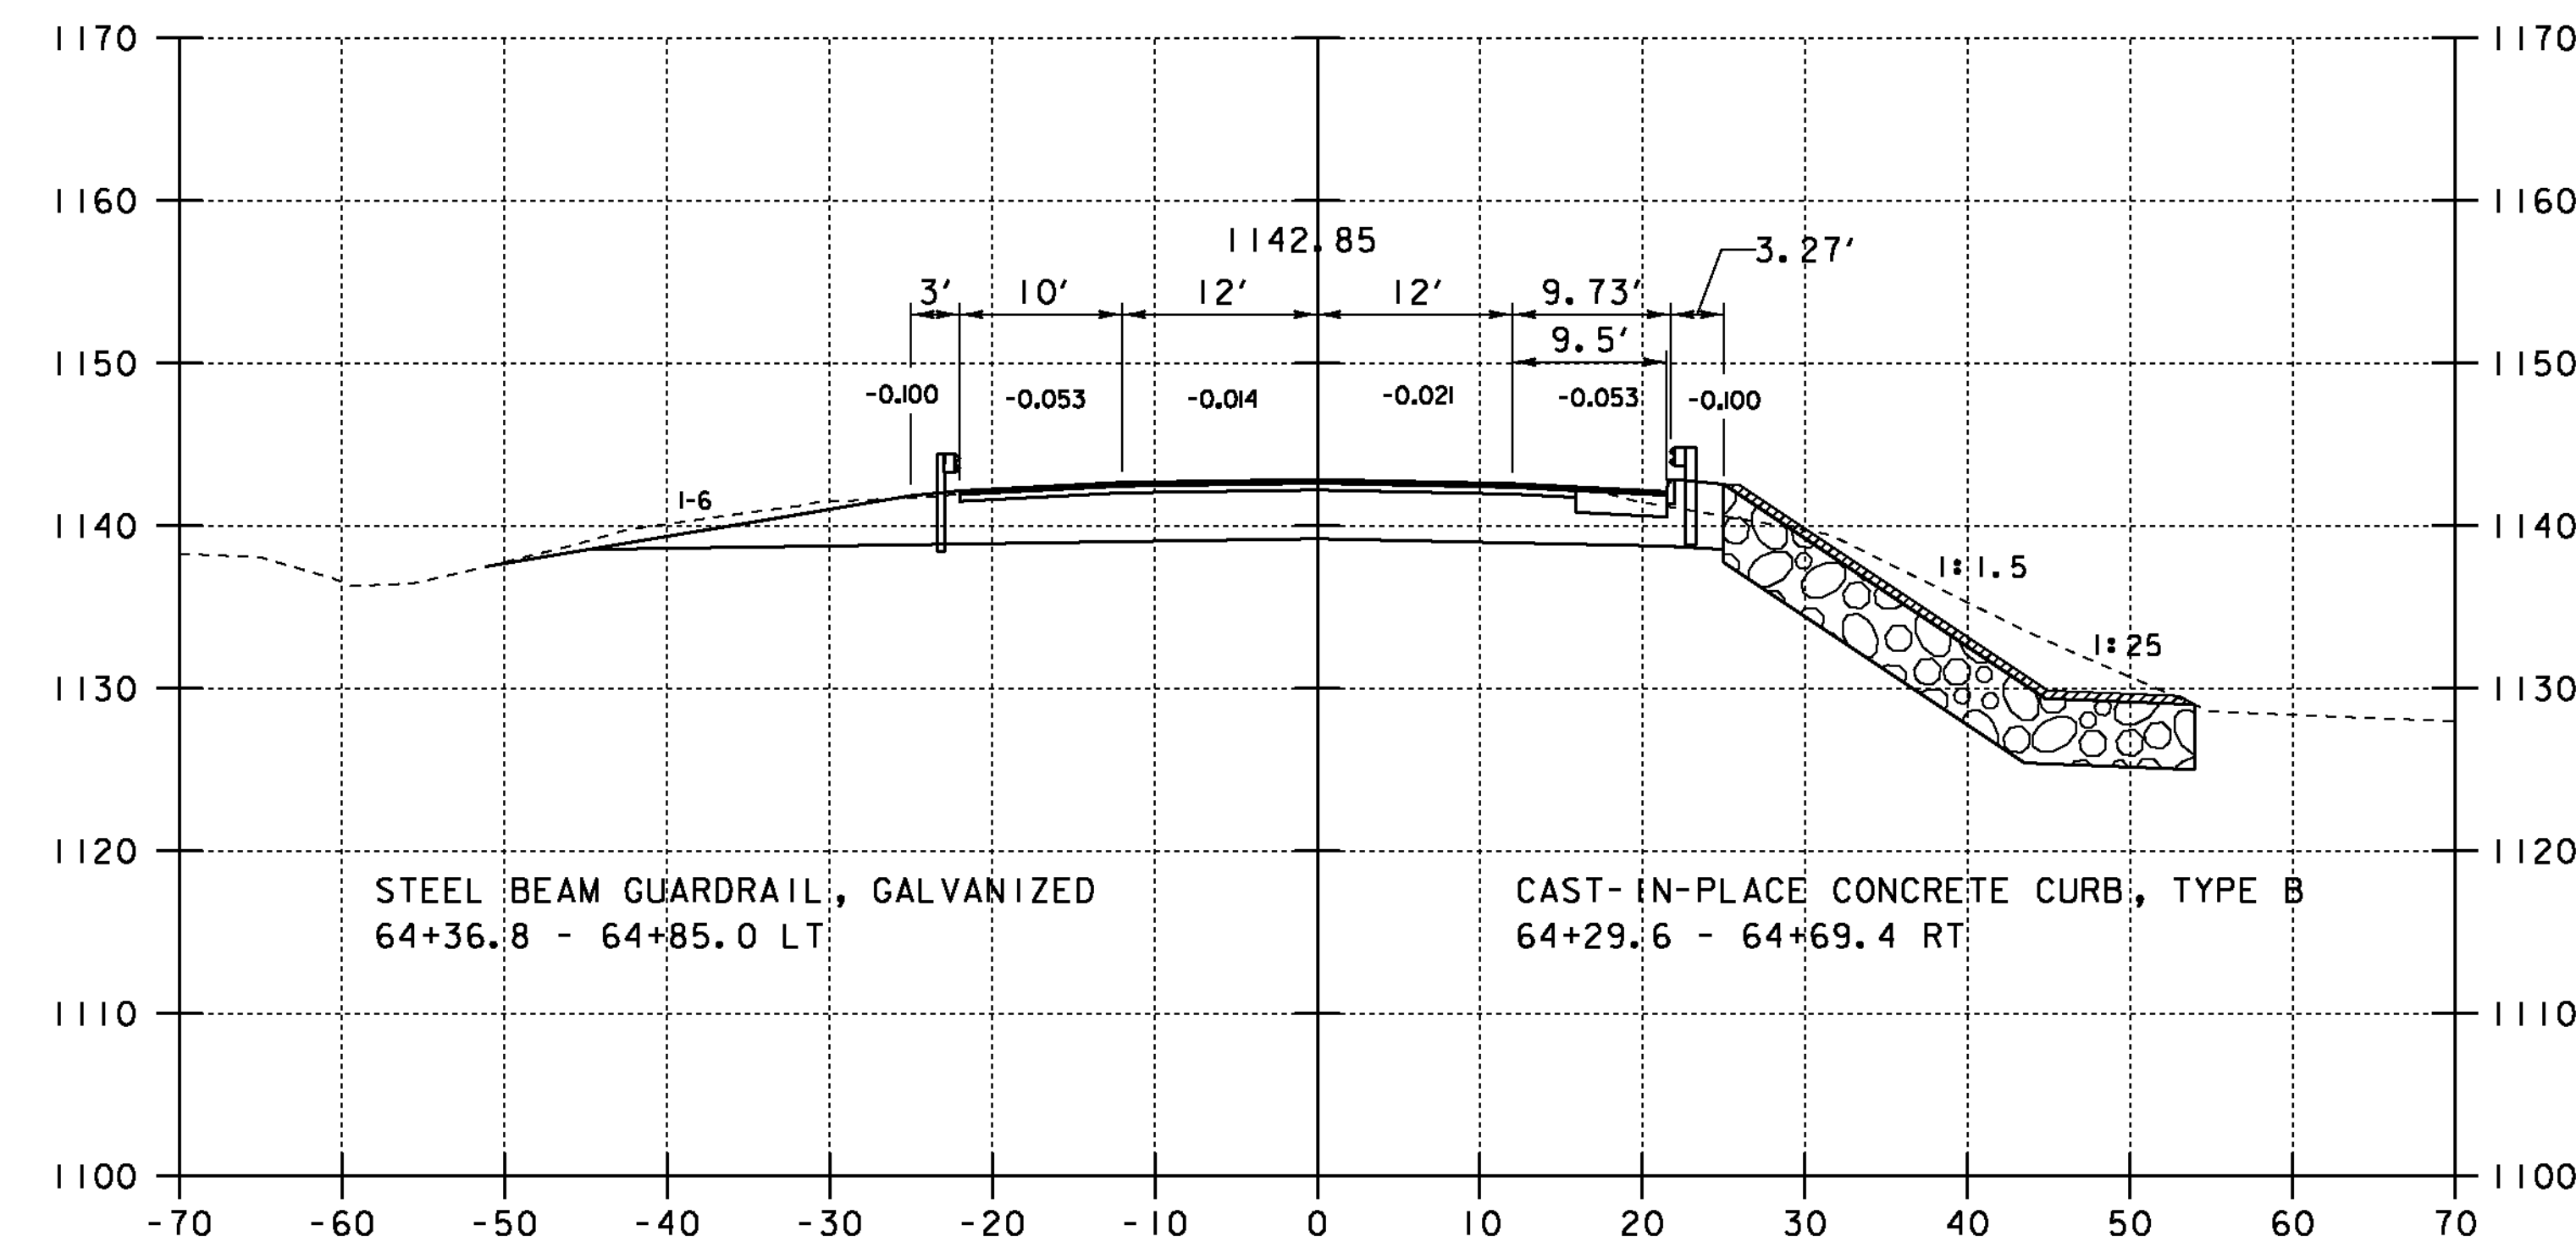

64+50

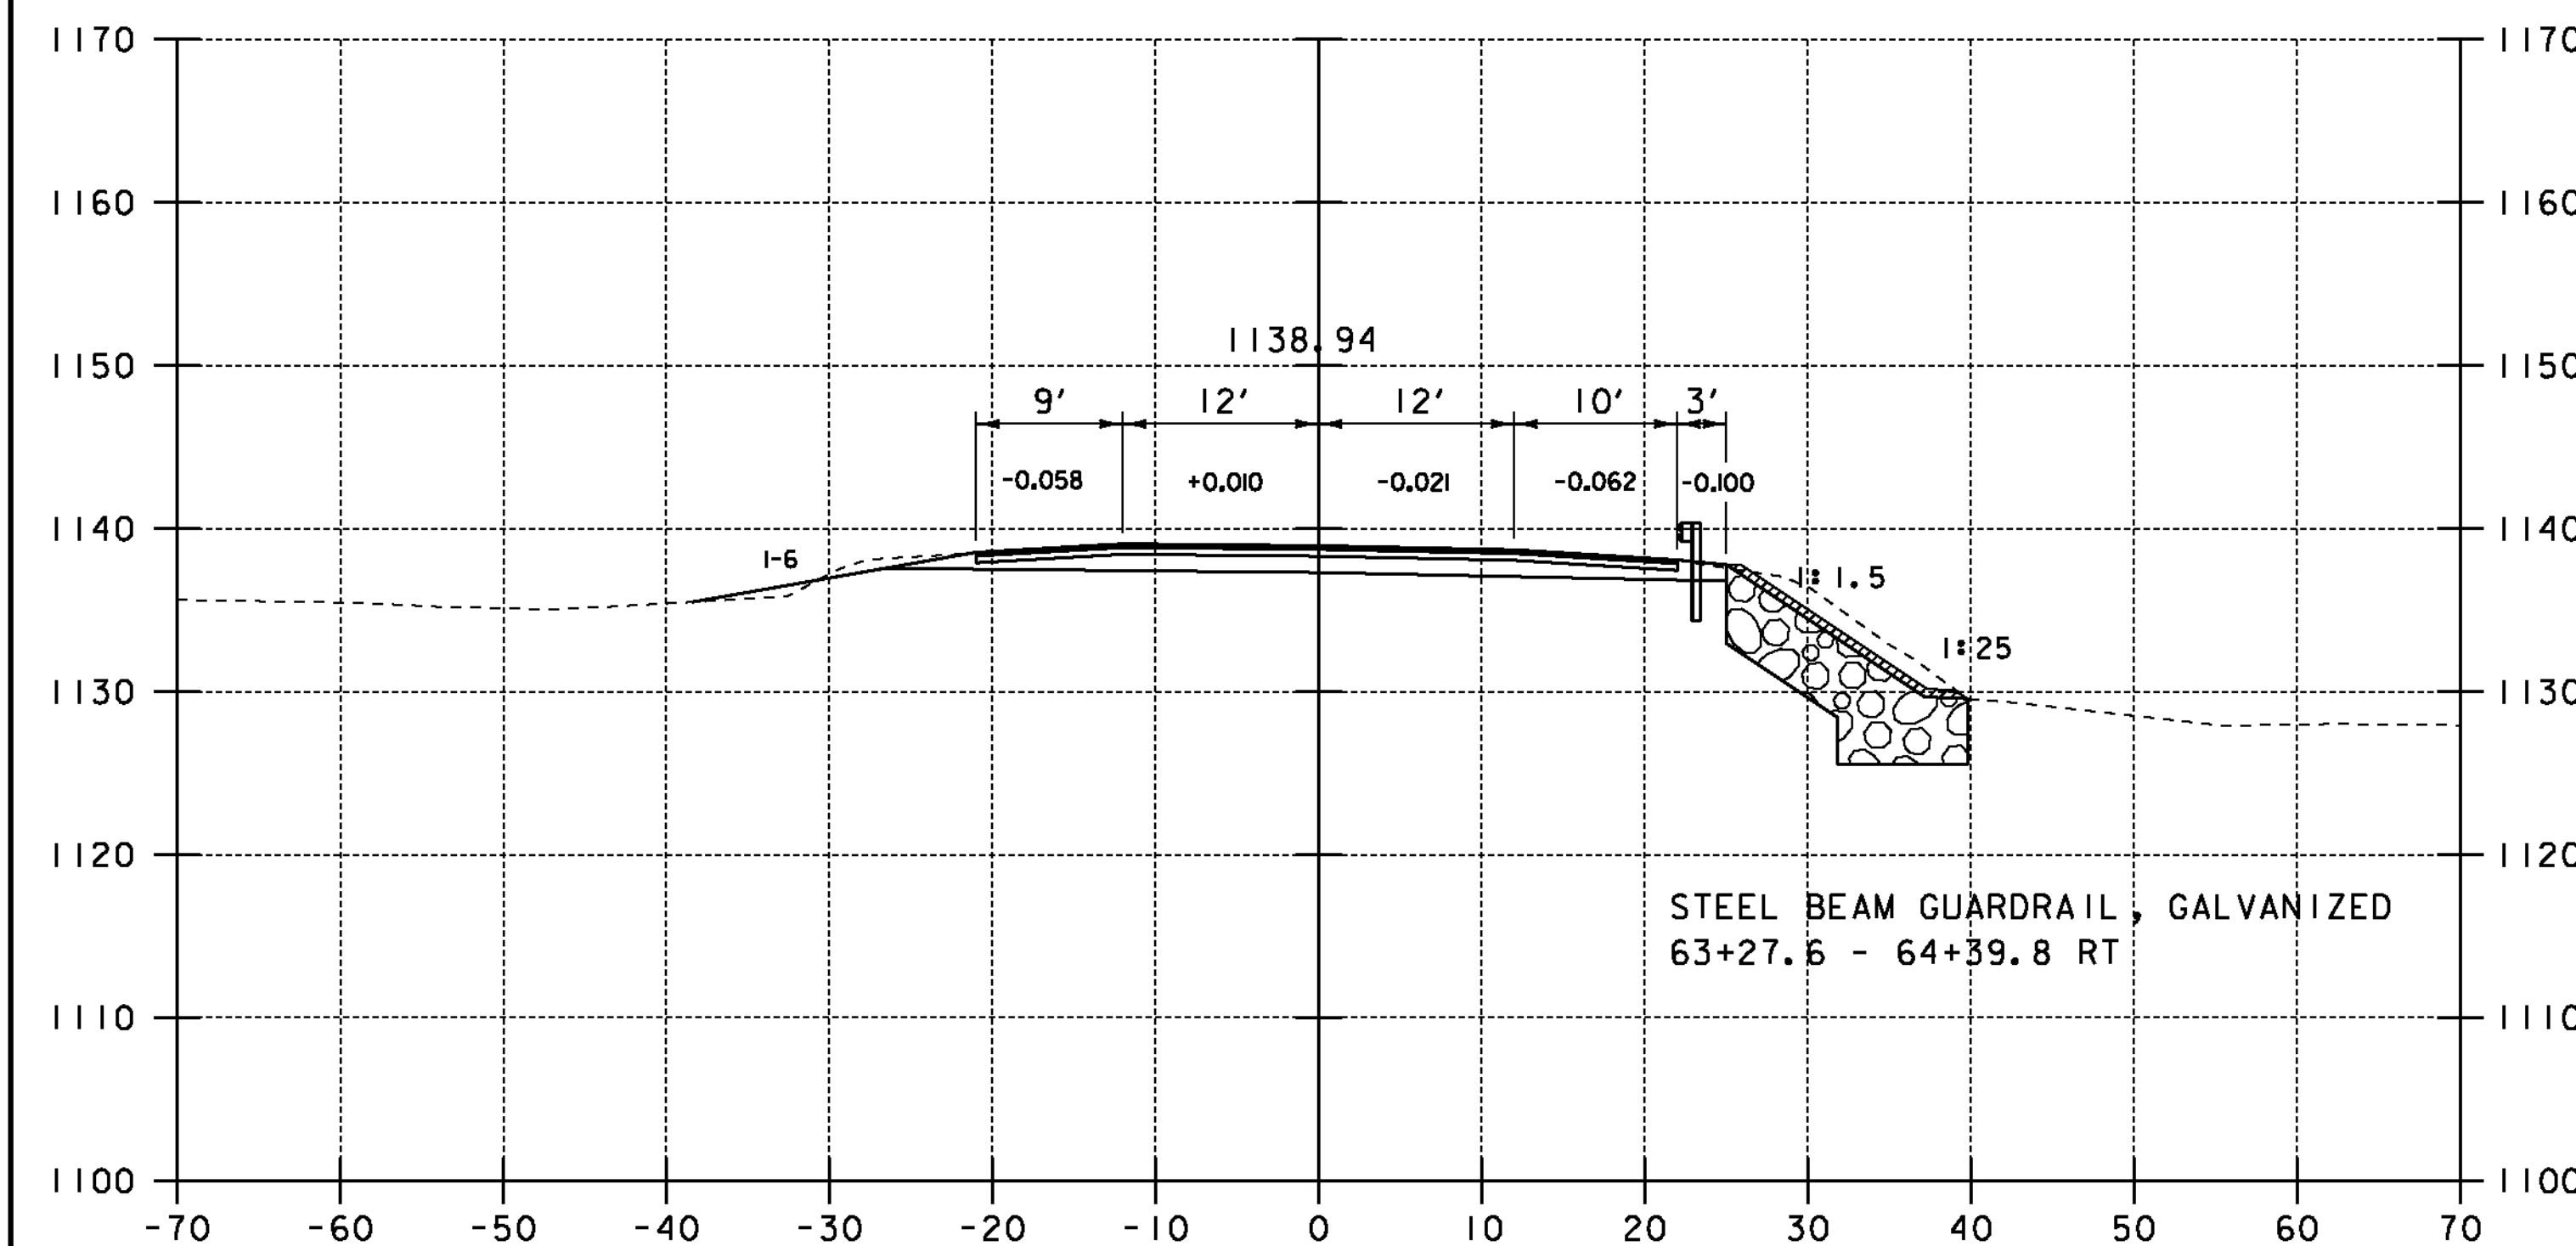

63+50

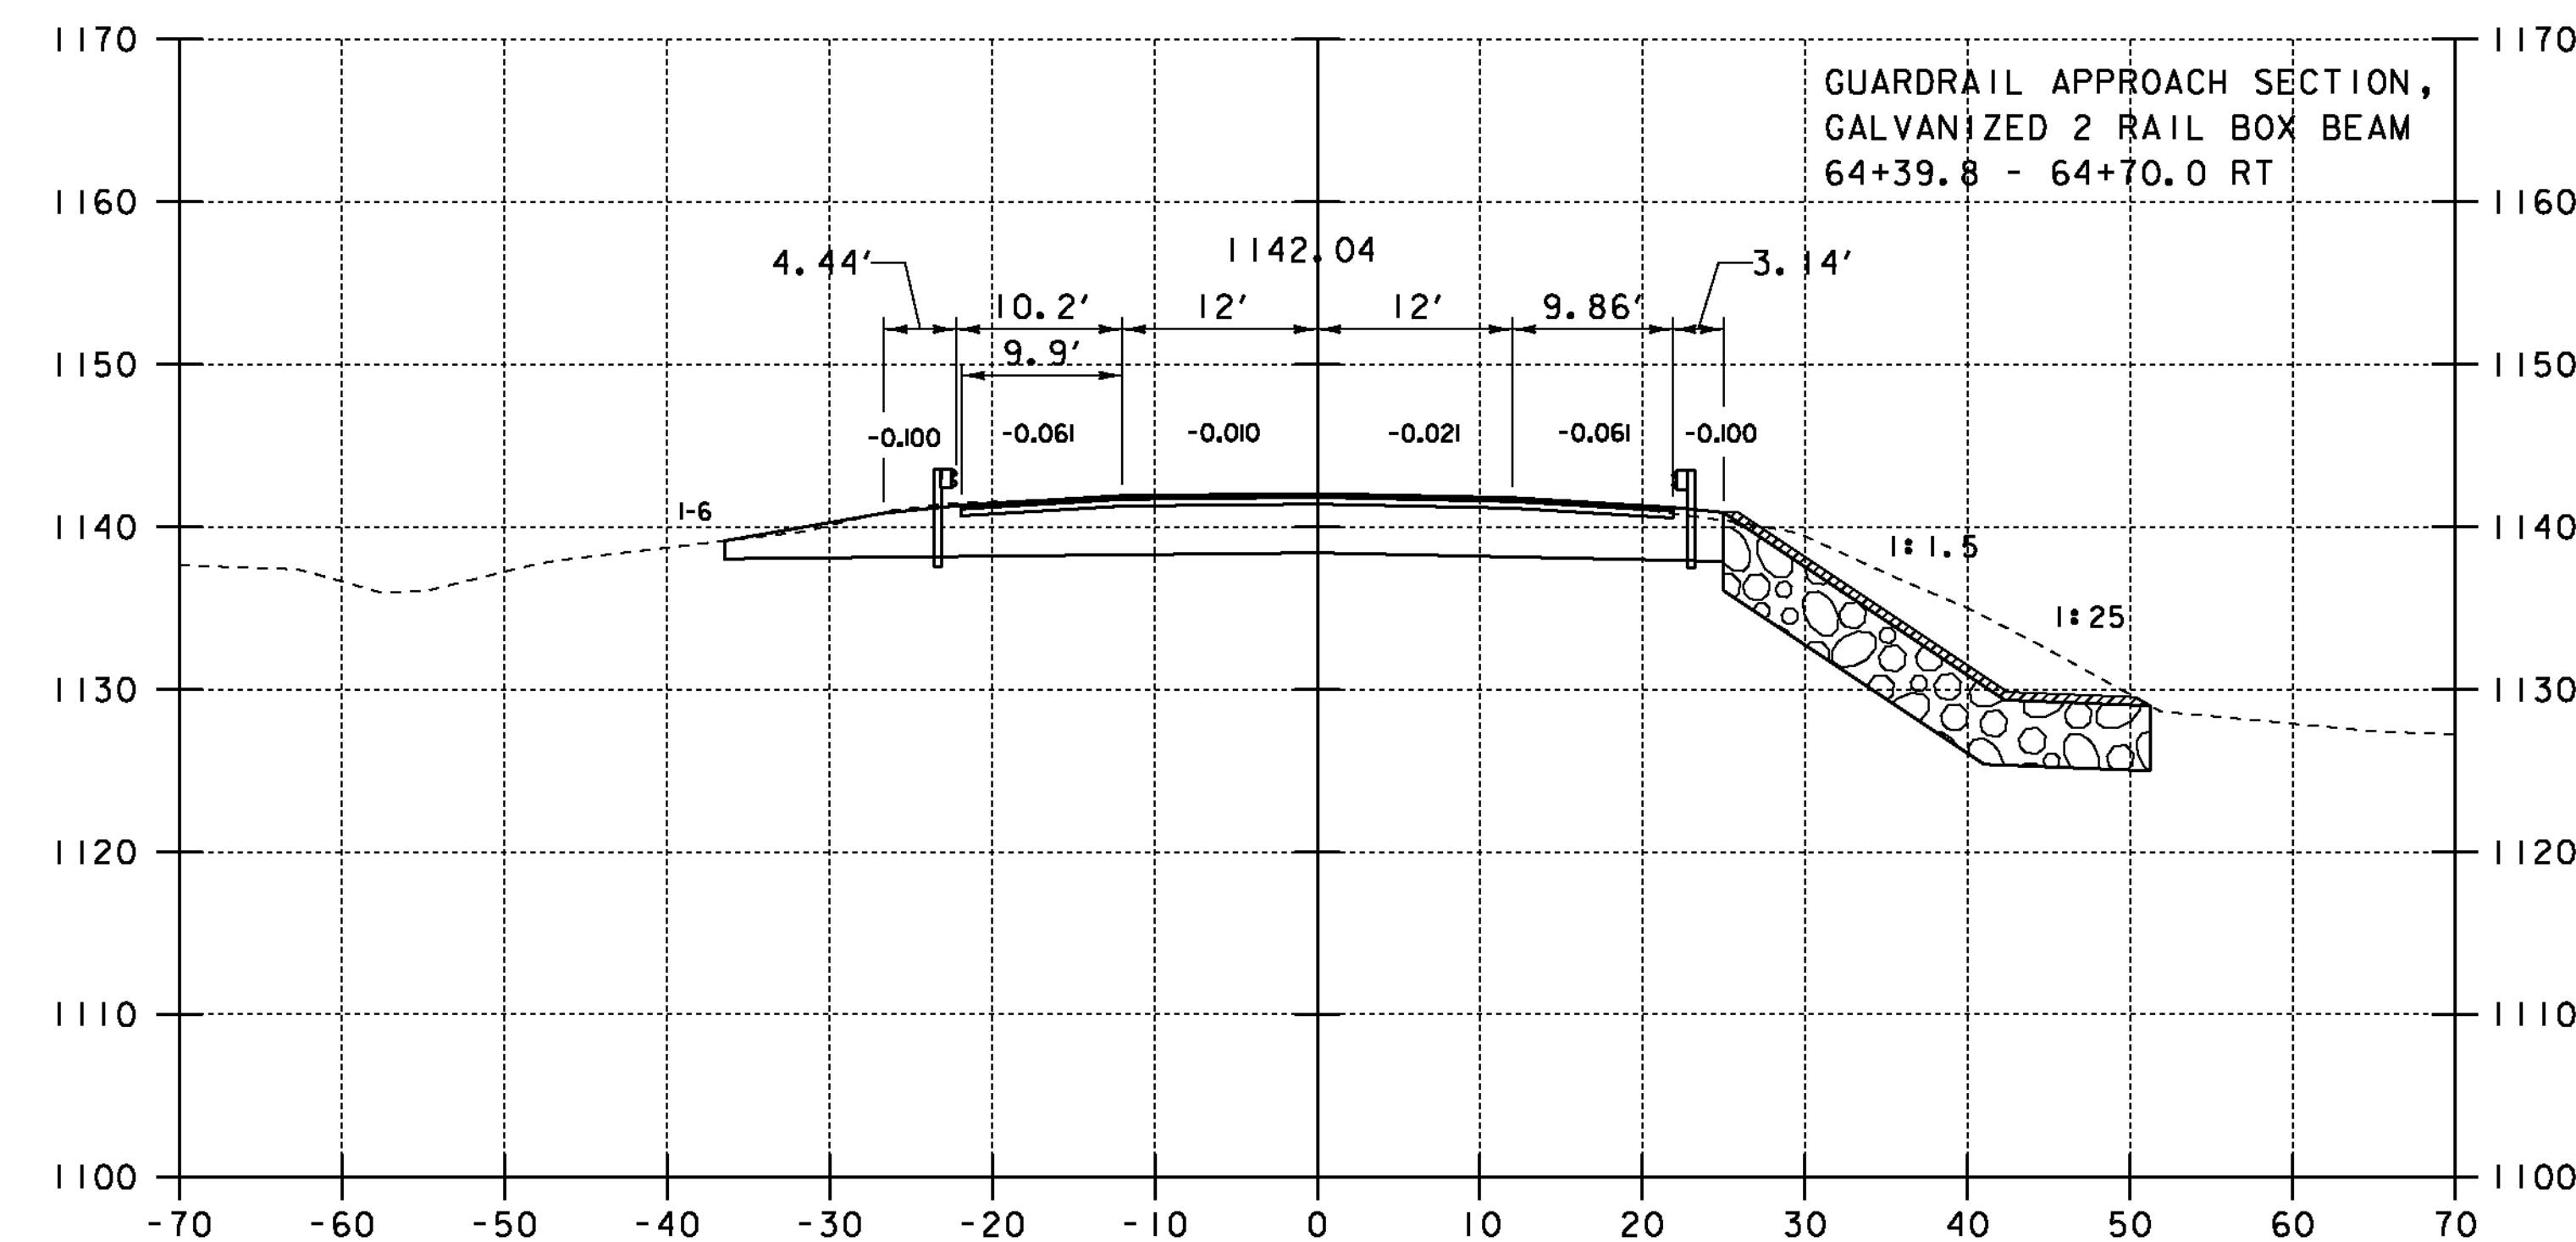

64+28

PROJECT NAME: WOODFORD	
PROJECT NUMBER: ER BHF 010-1(44)	
FILE NAME: s11b214xs.dgn	PLOT DATE: 23-MAR-2012
PROJECT LEADER: C. CARLSON	DRAWN BY: EVANS-MONGEON
DESIGNED BY: M.EVANS-MONGEON	CHECKED BY:
ROADWAY CROSS SECTIONS SHEET (2)	SHEET 37 OF 58