
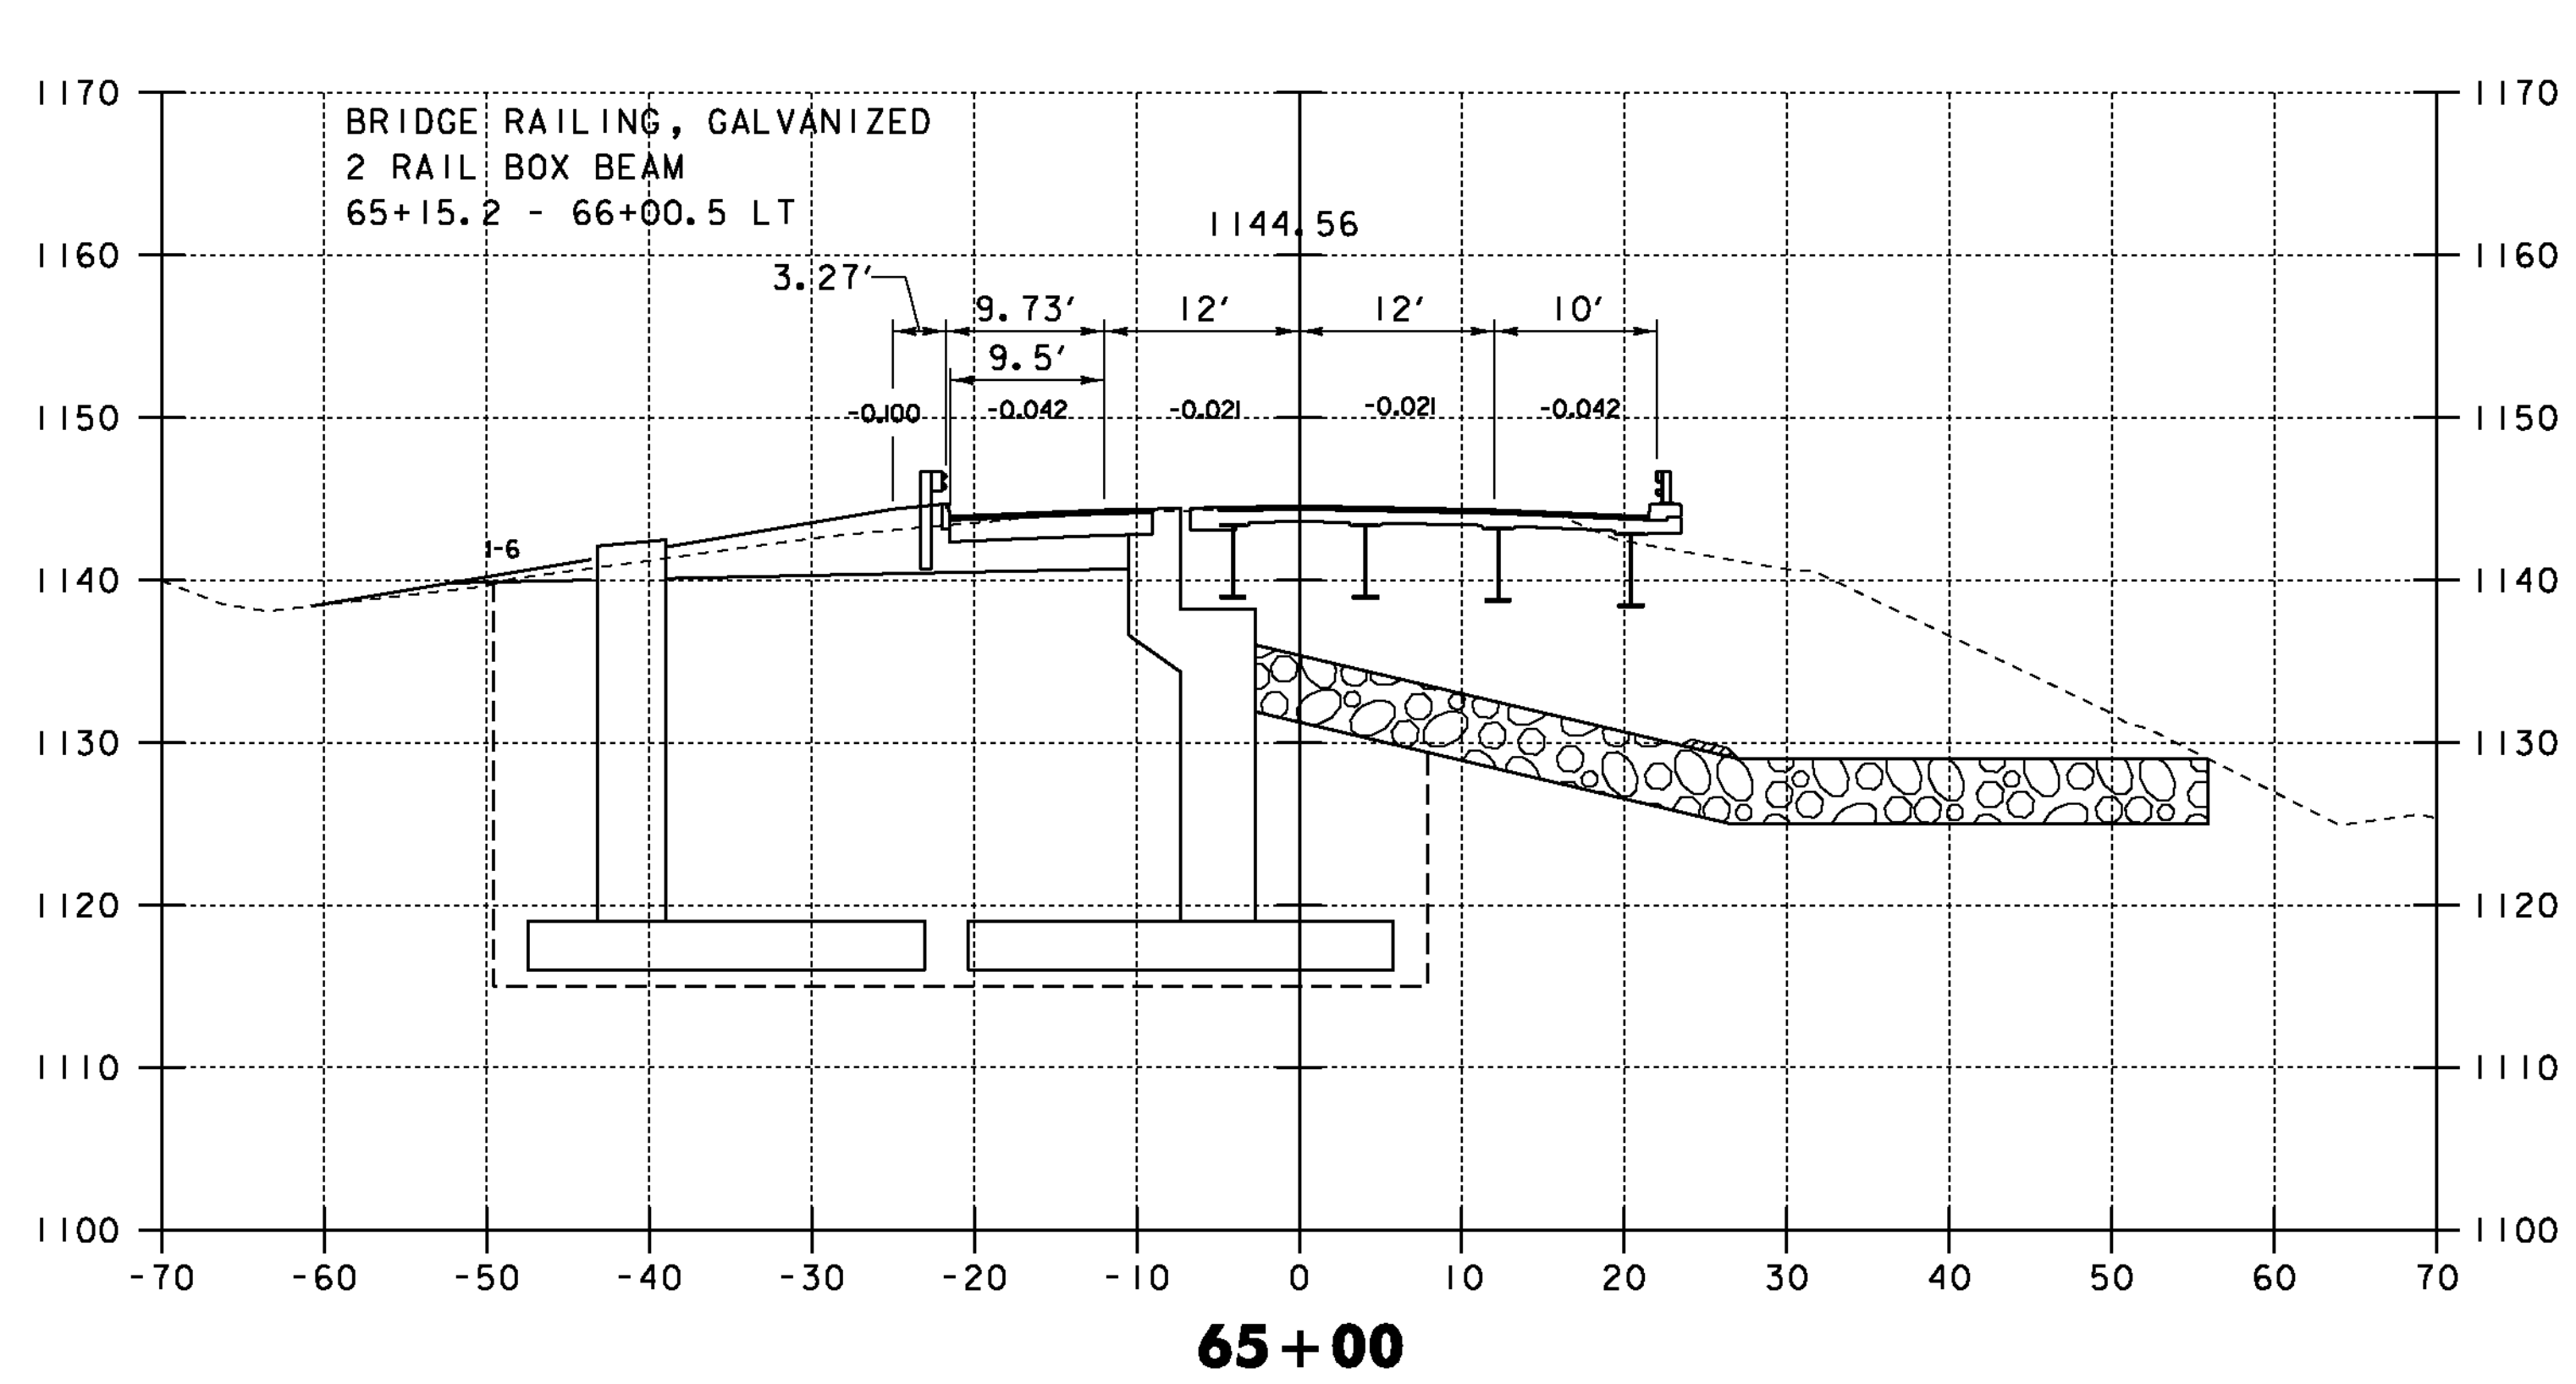
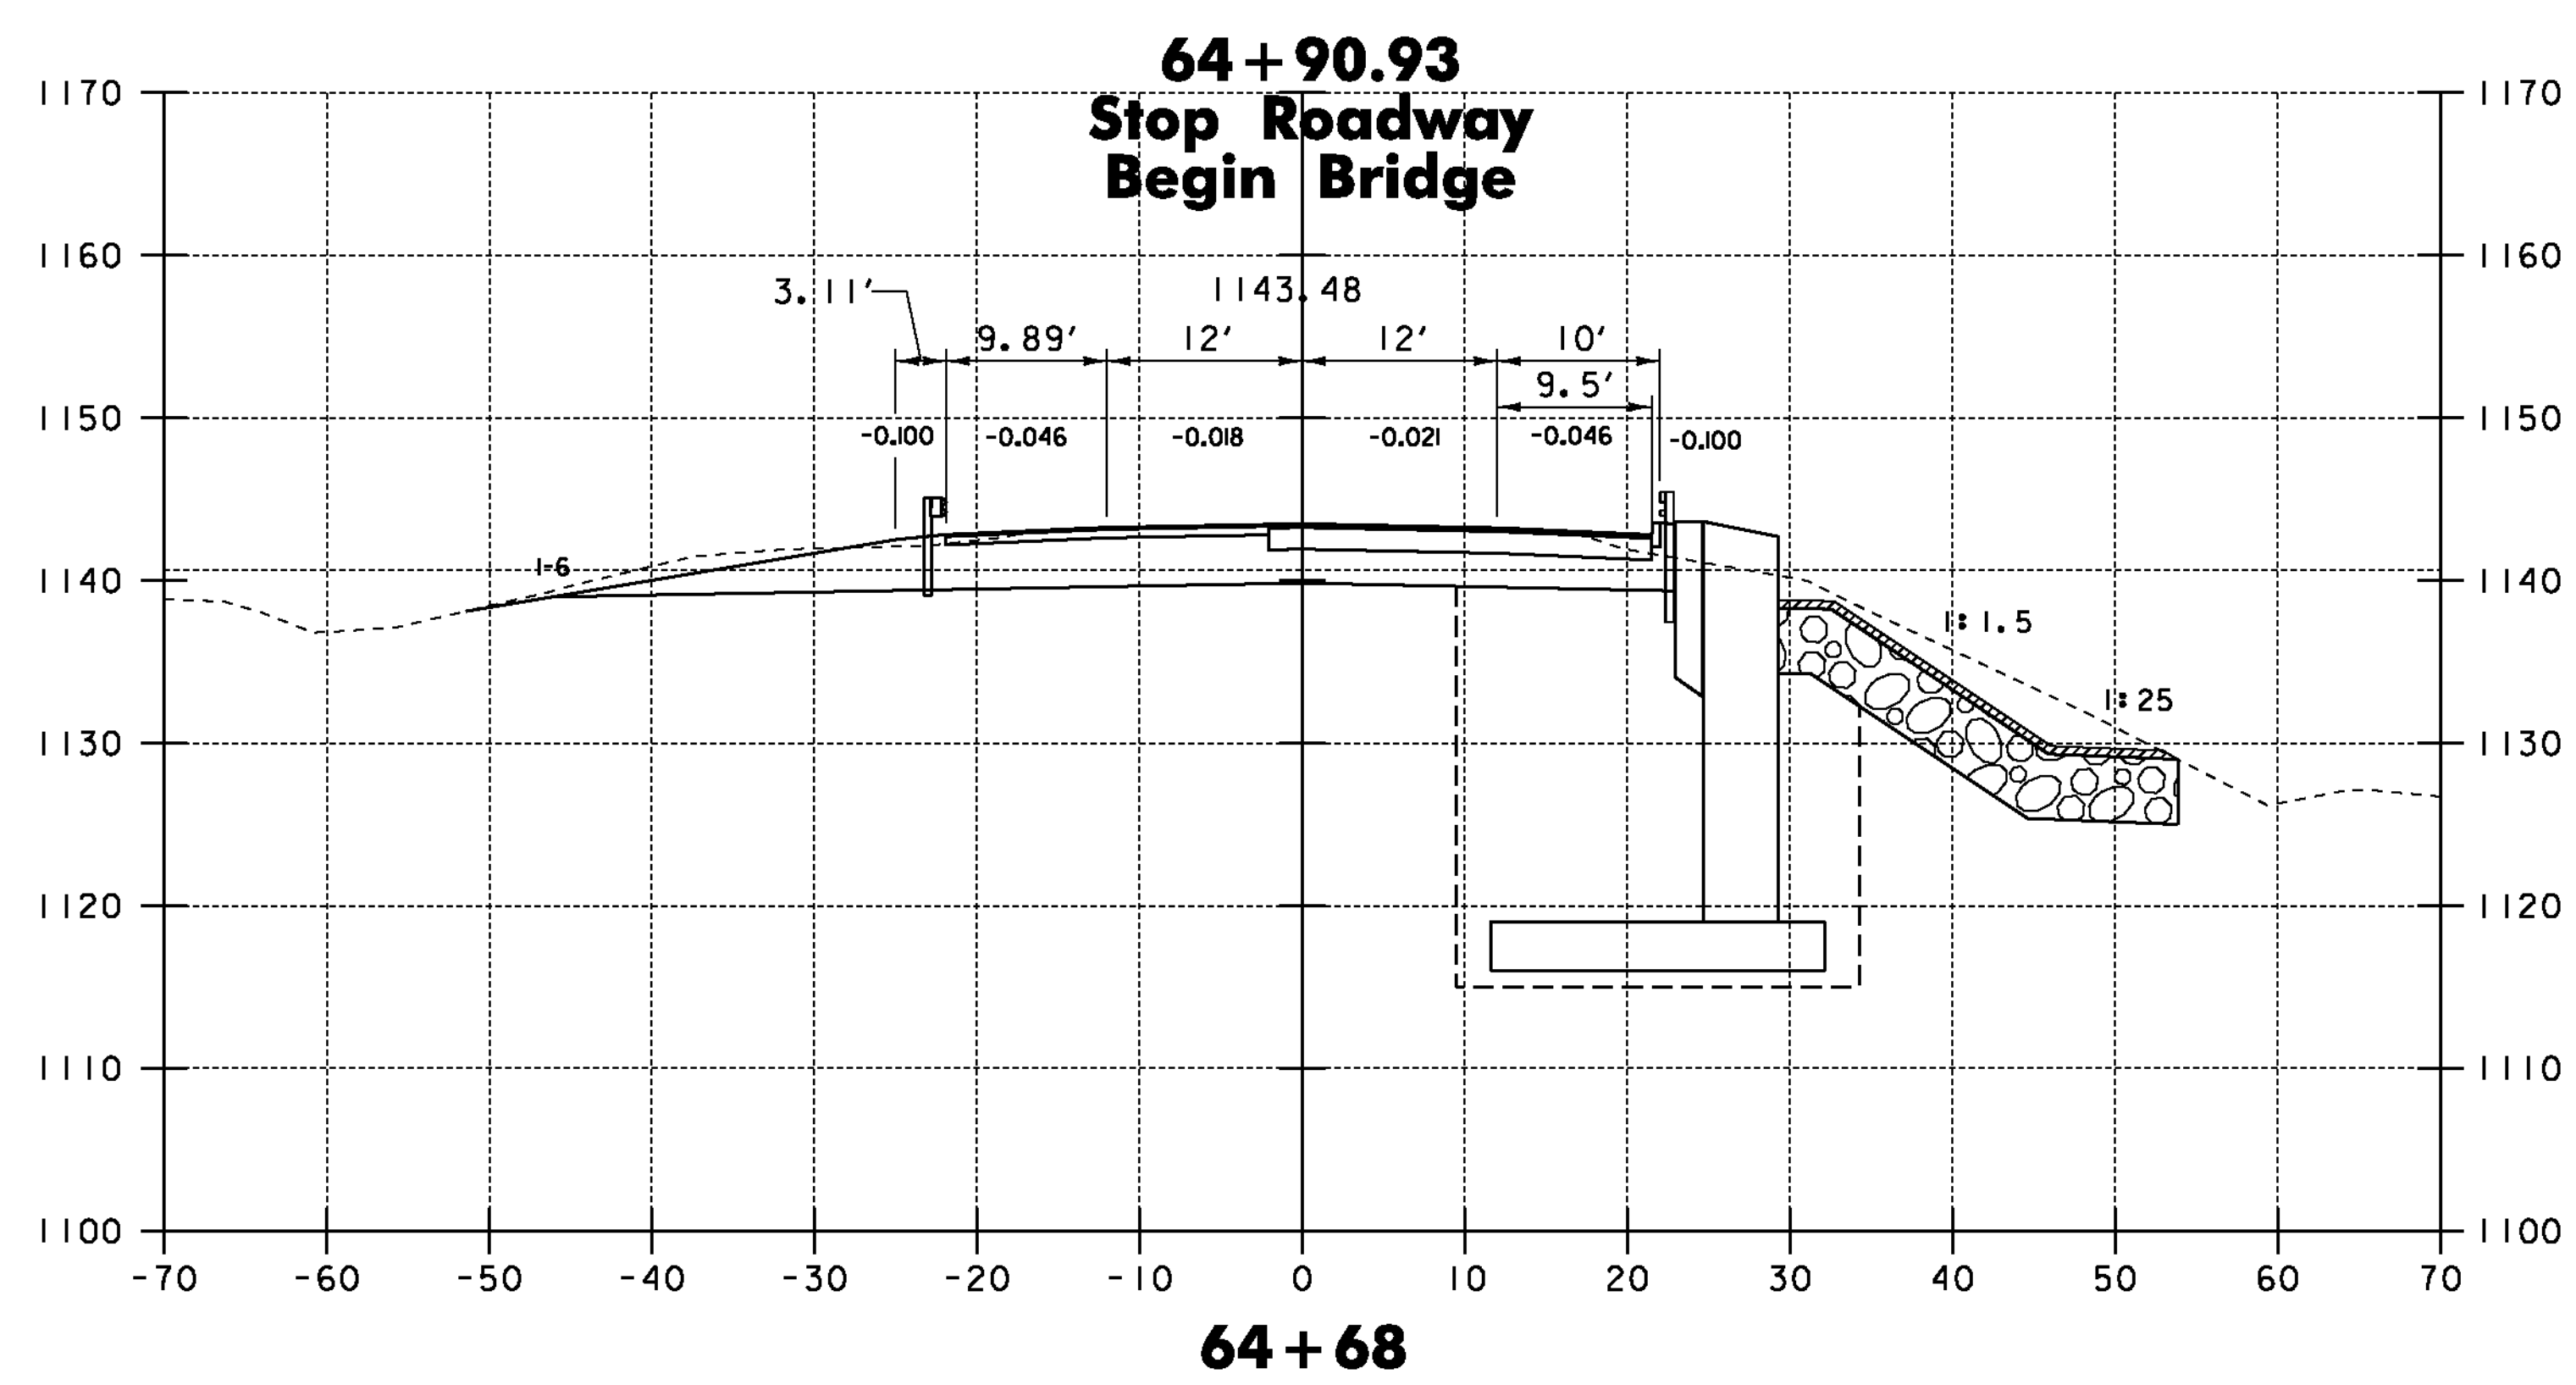
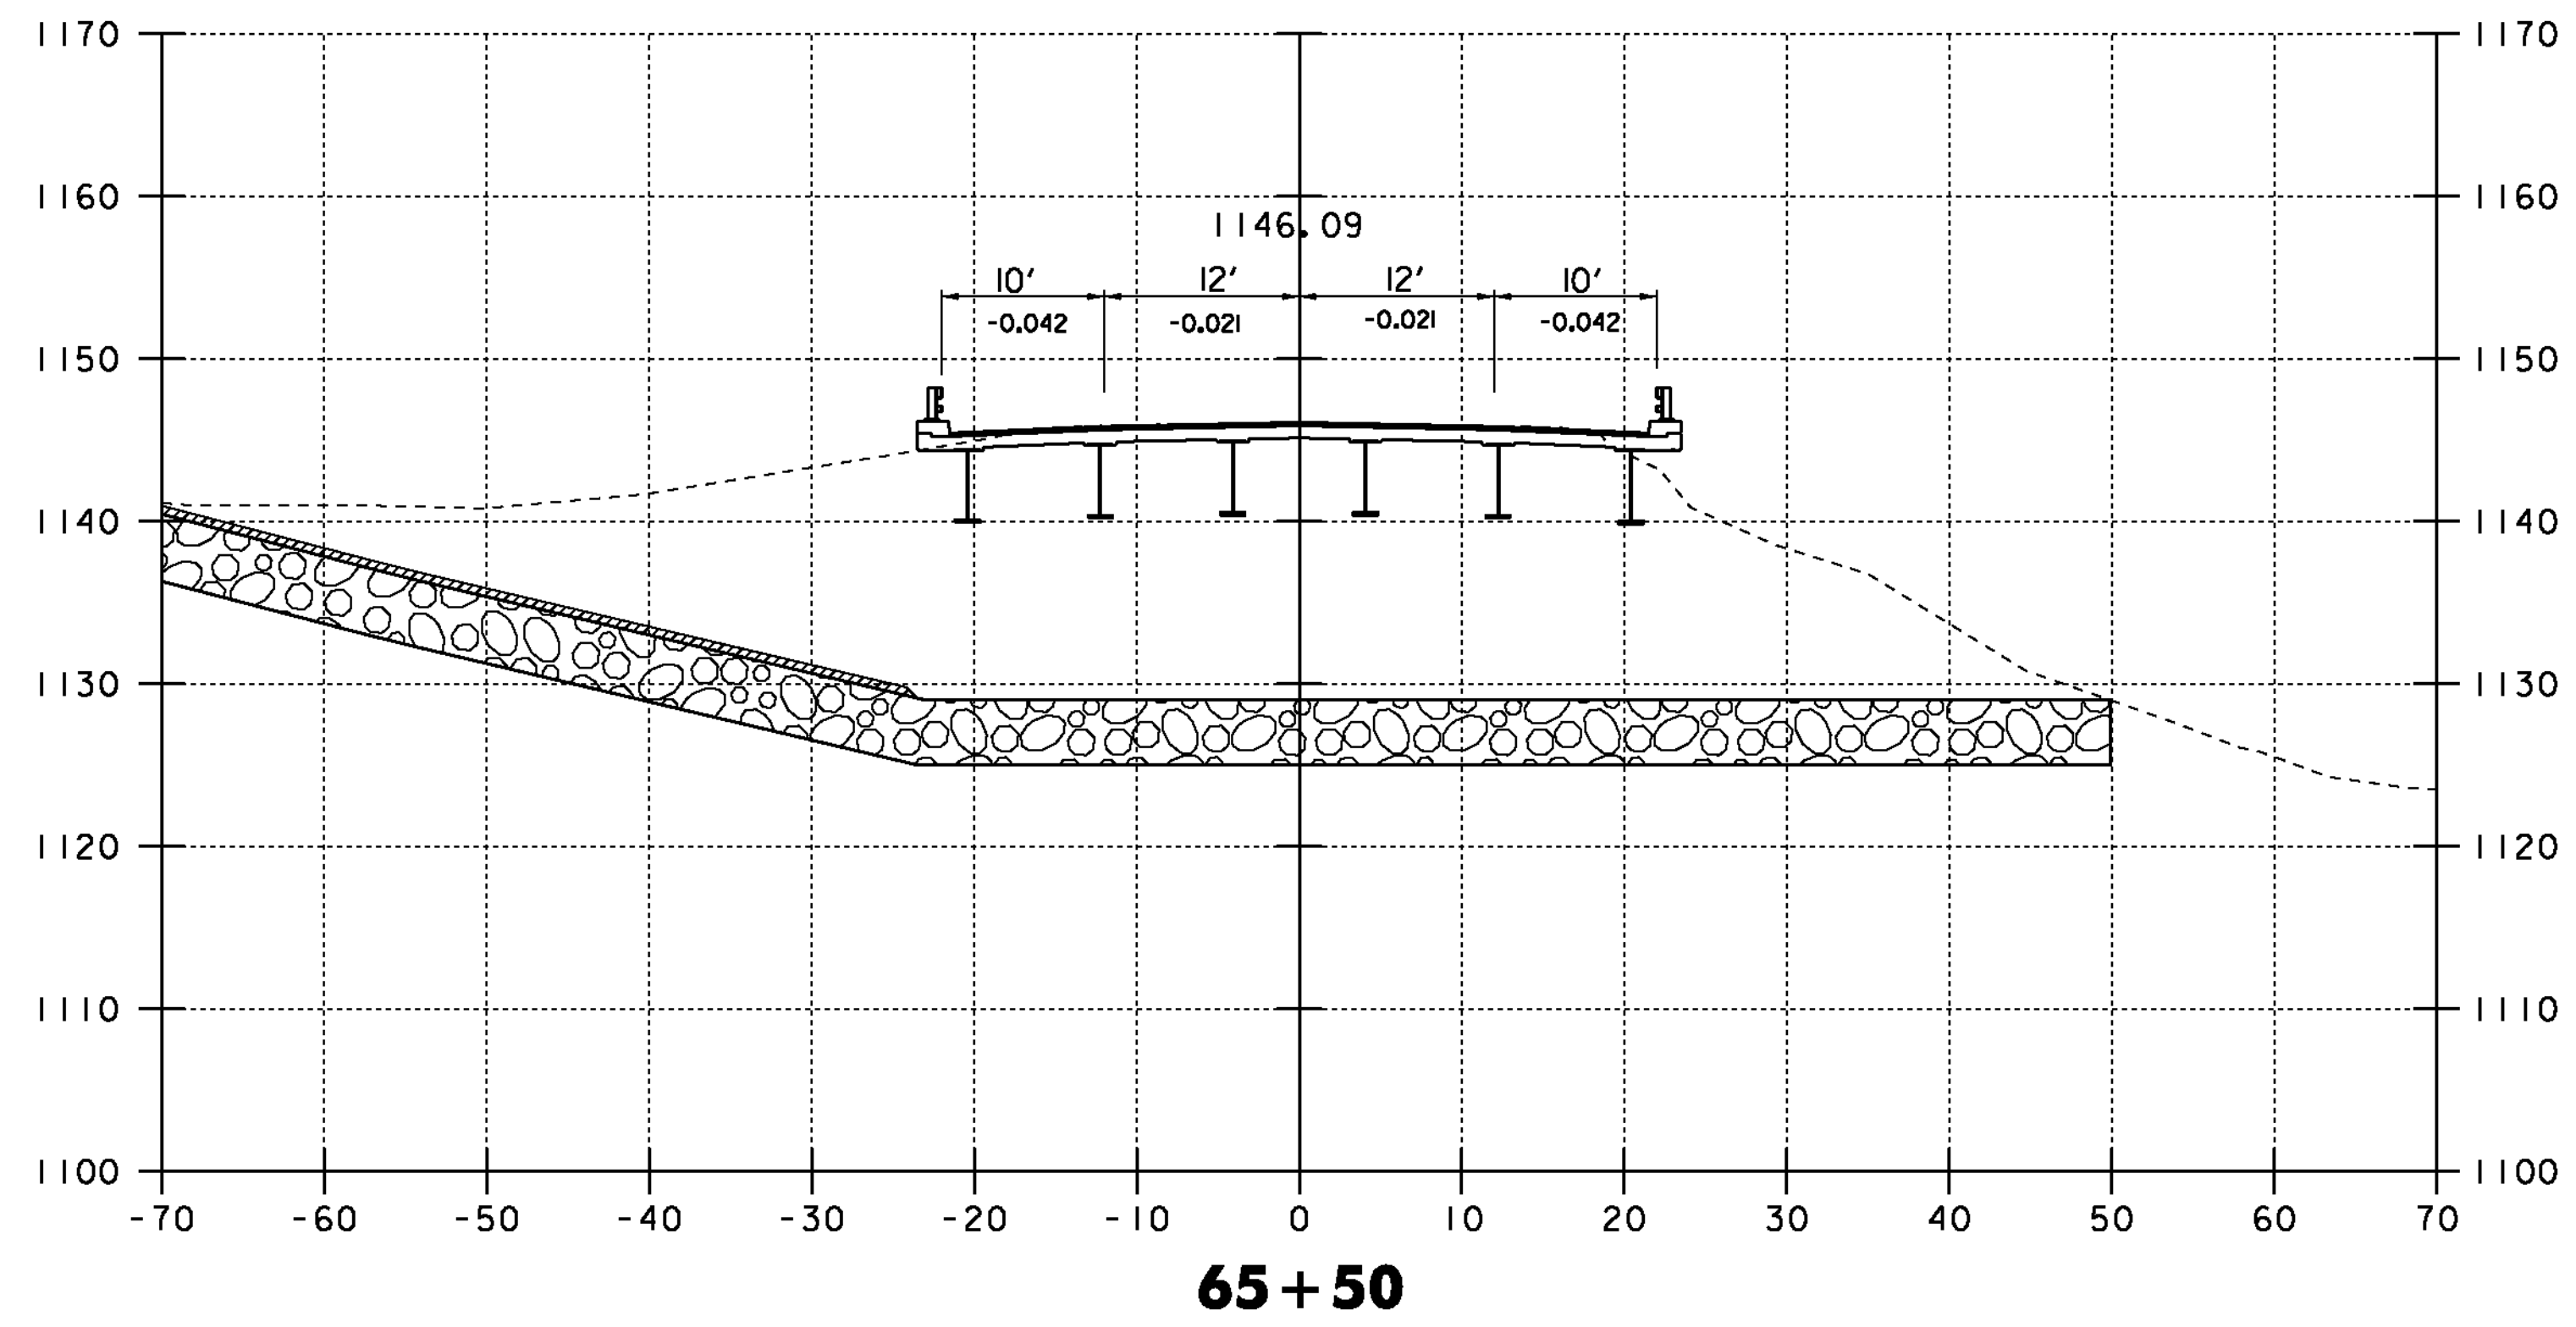


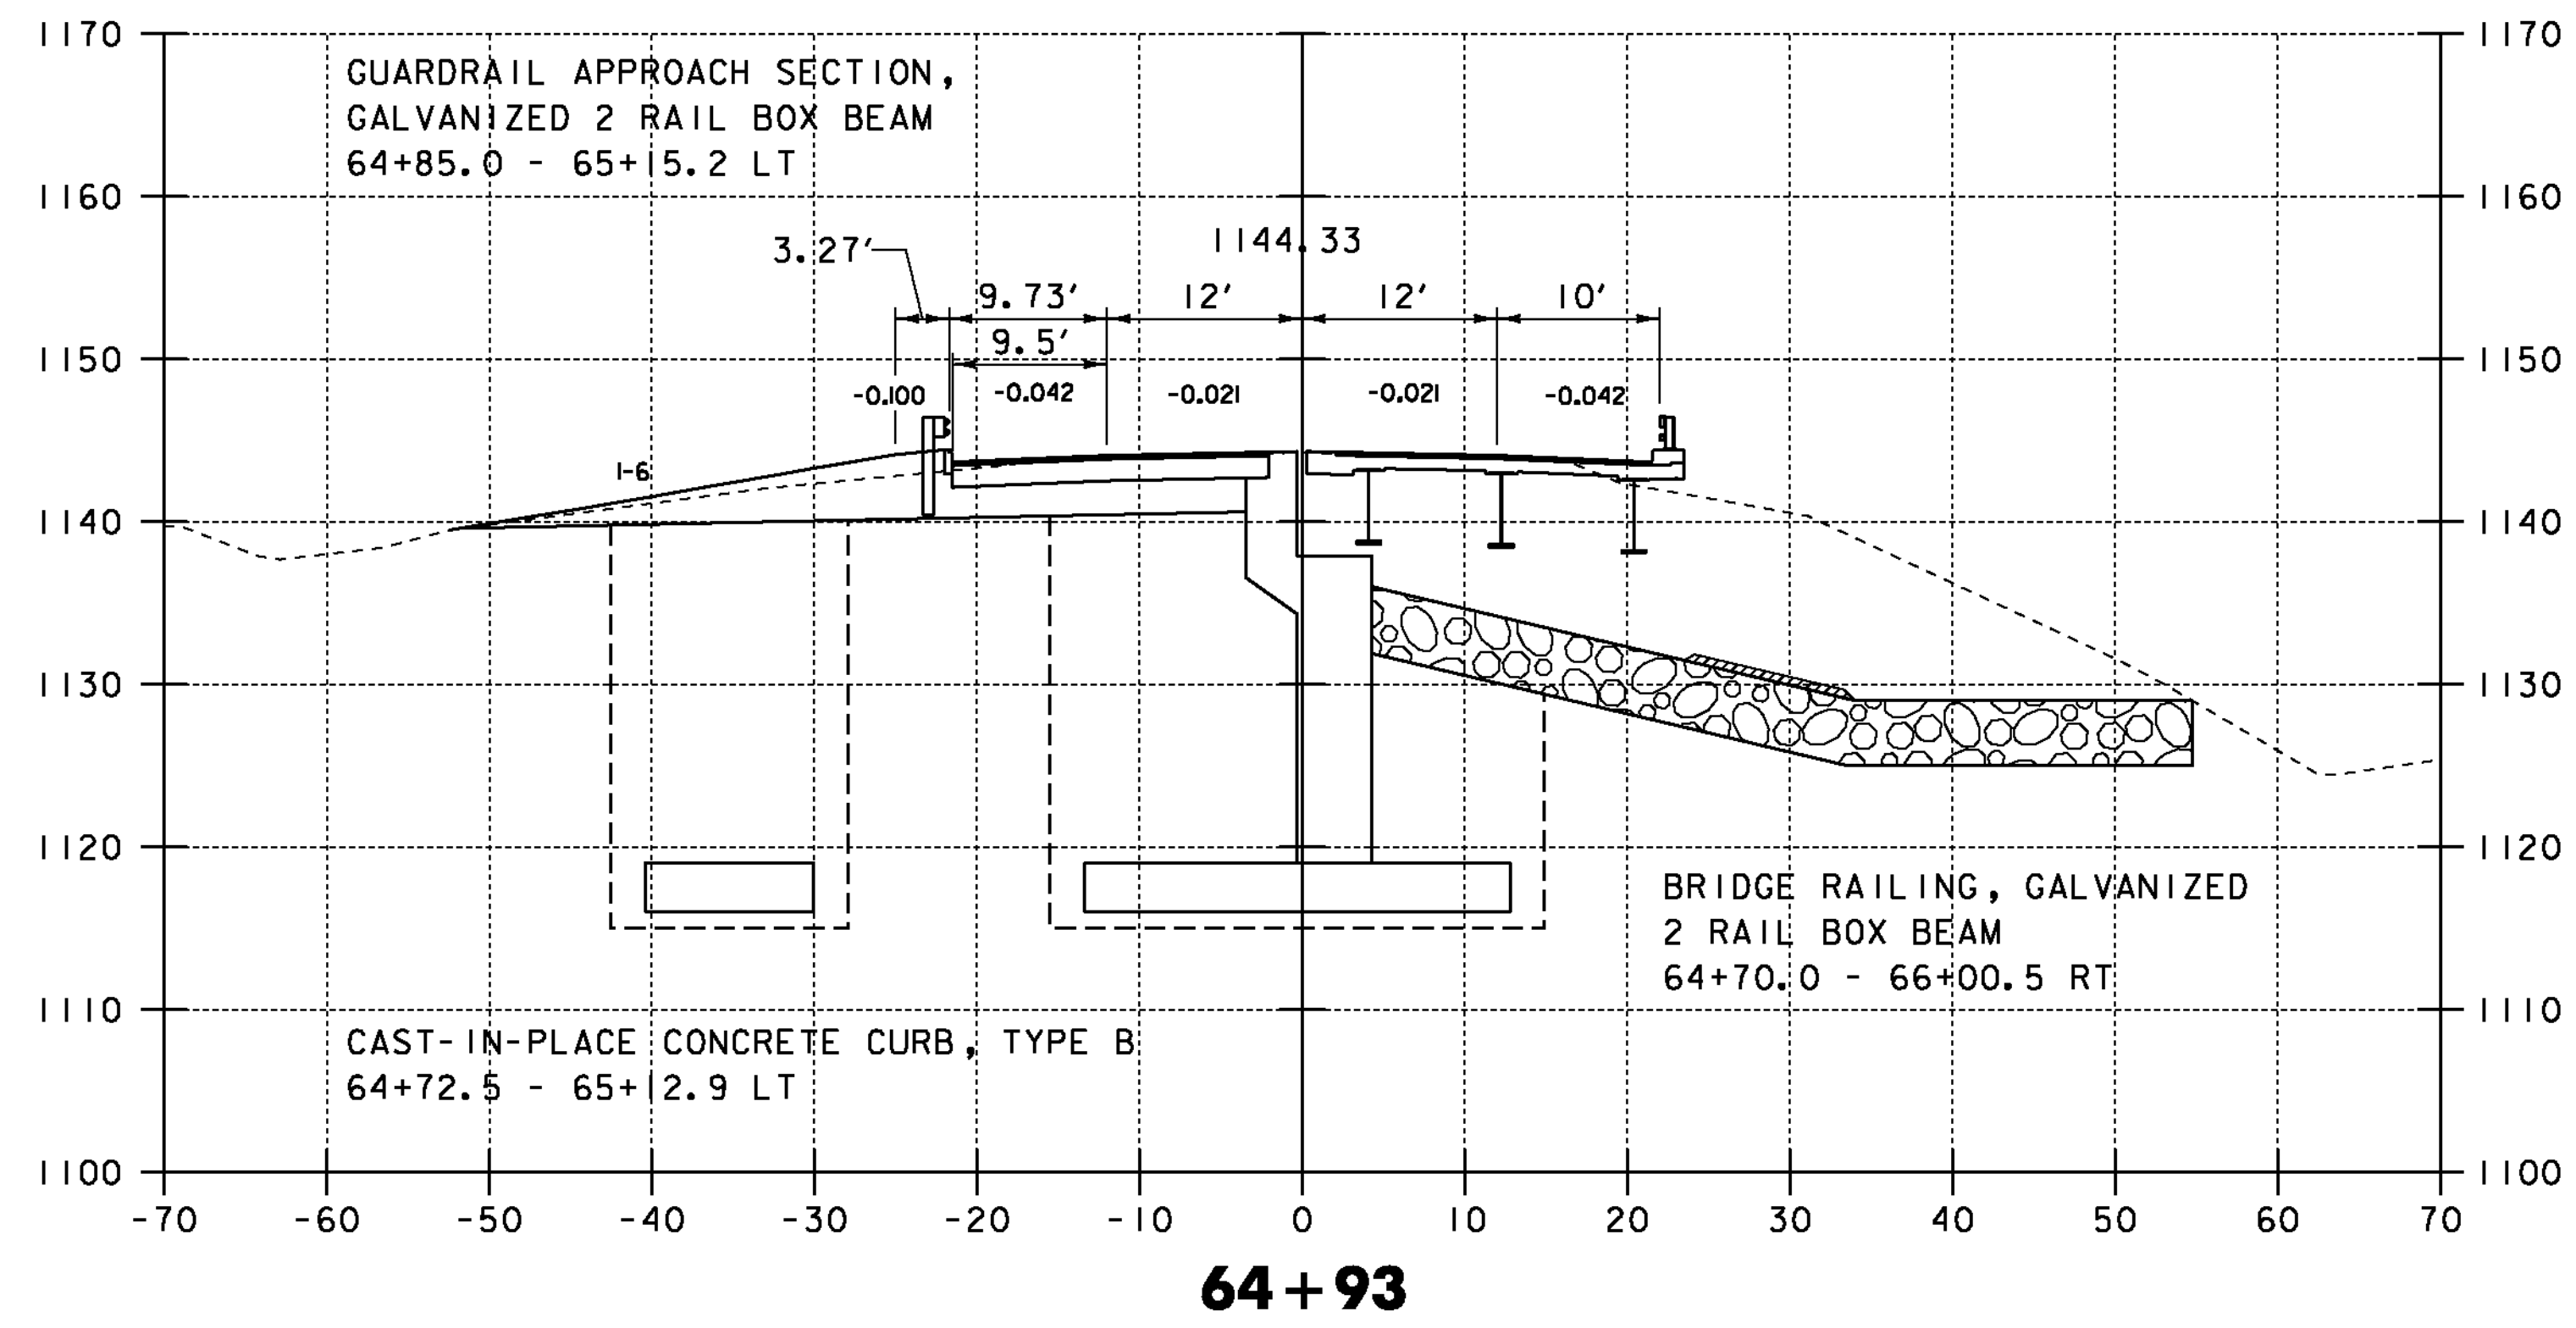

PROJECT NAME: WOODFORD	
PROJECT NUMBER: ER BHF 010-1(44)	
FILE NAME: slb214xs.dgn	PLOT DATE: 23-MAR-2012
PROJECT LEADER: C. CARLSON	DRAWN BY: EVANS-MONGEON
DESIGNED BY: M. EVANS-MONGEON	CHECKED BY:
ROADWAY CROSS SECTIONS SHEET (3)	SHEET 38 OF 58