




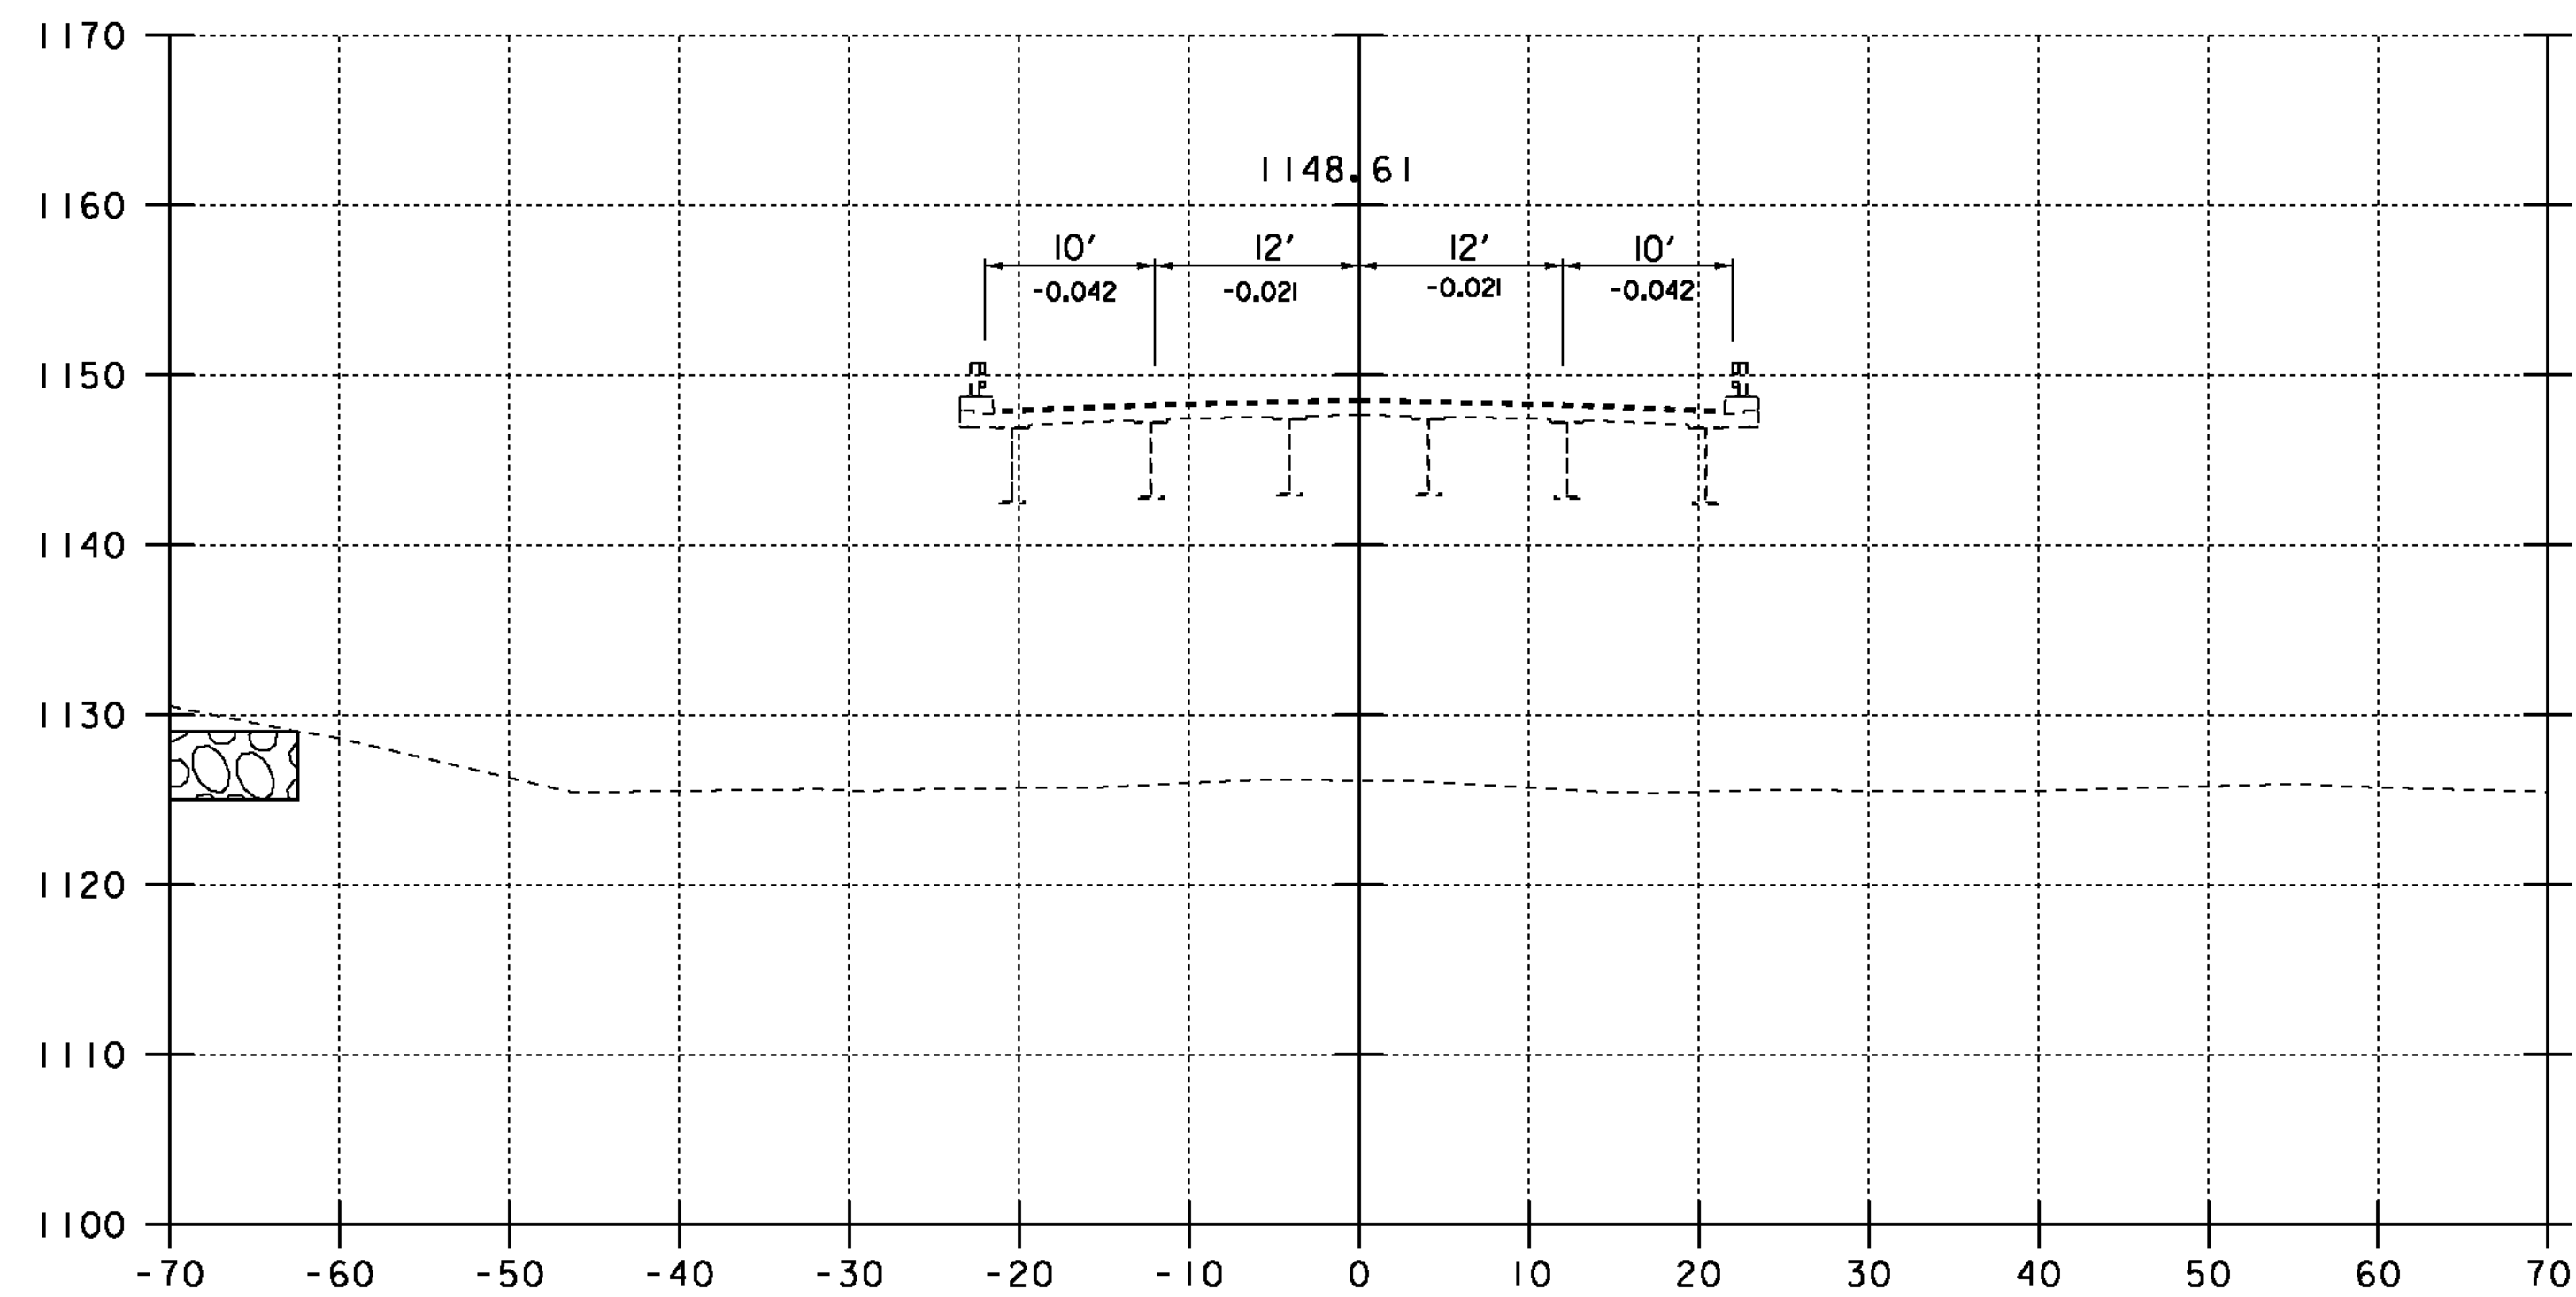


66+25.00
END APPROACH
MATCH EXISTING

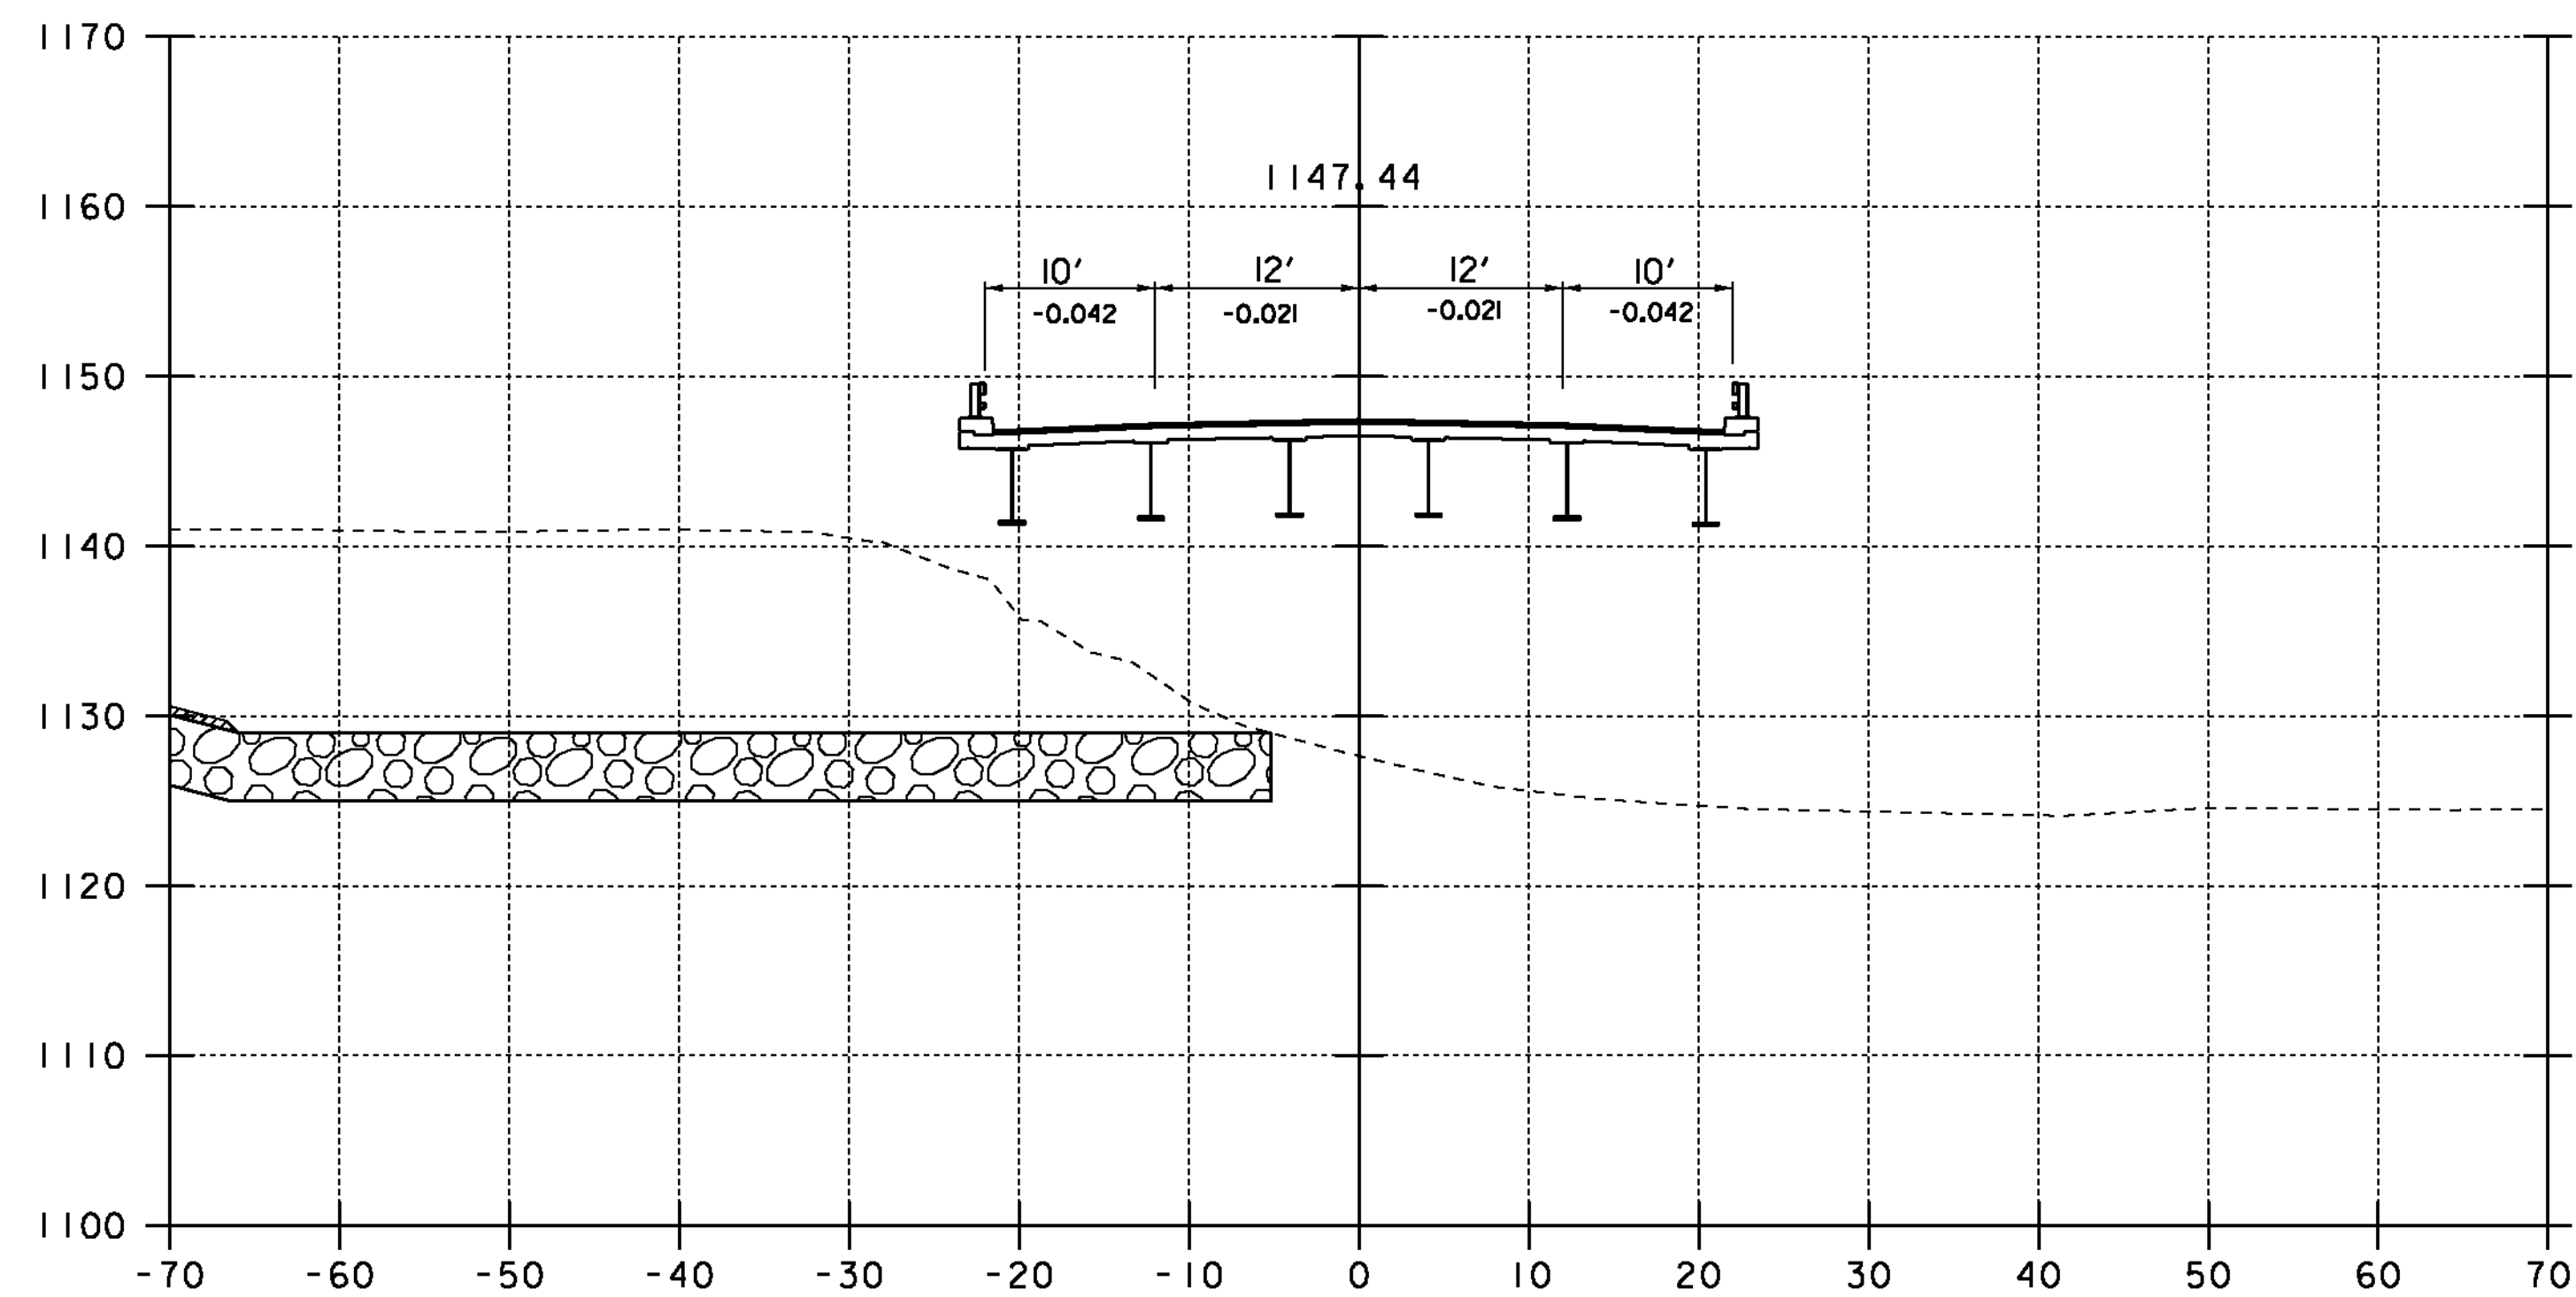

66+00.50
END BRIDGE WORK
END PROJECT
BEGIN APPROACH

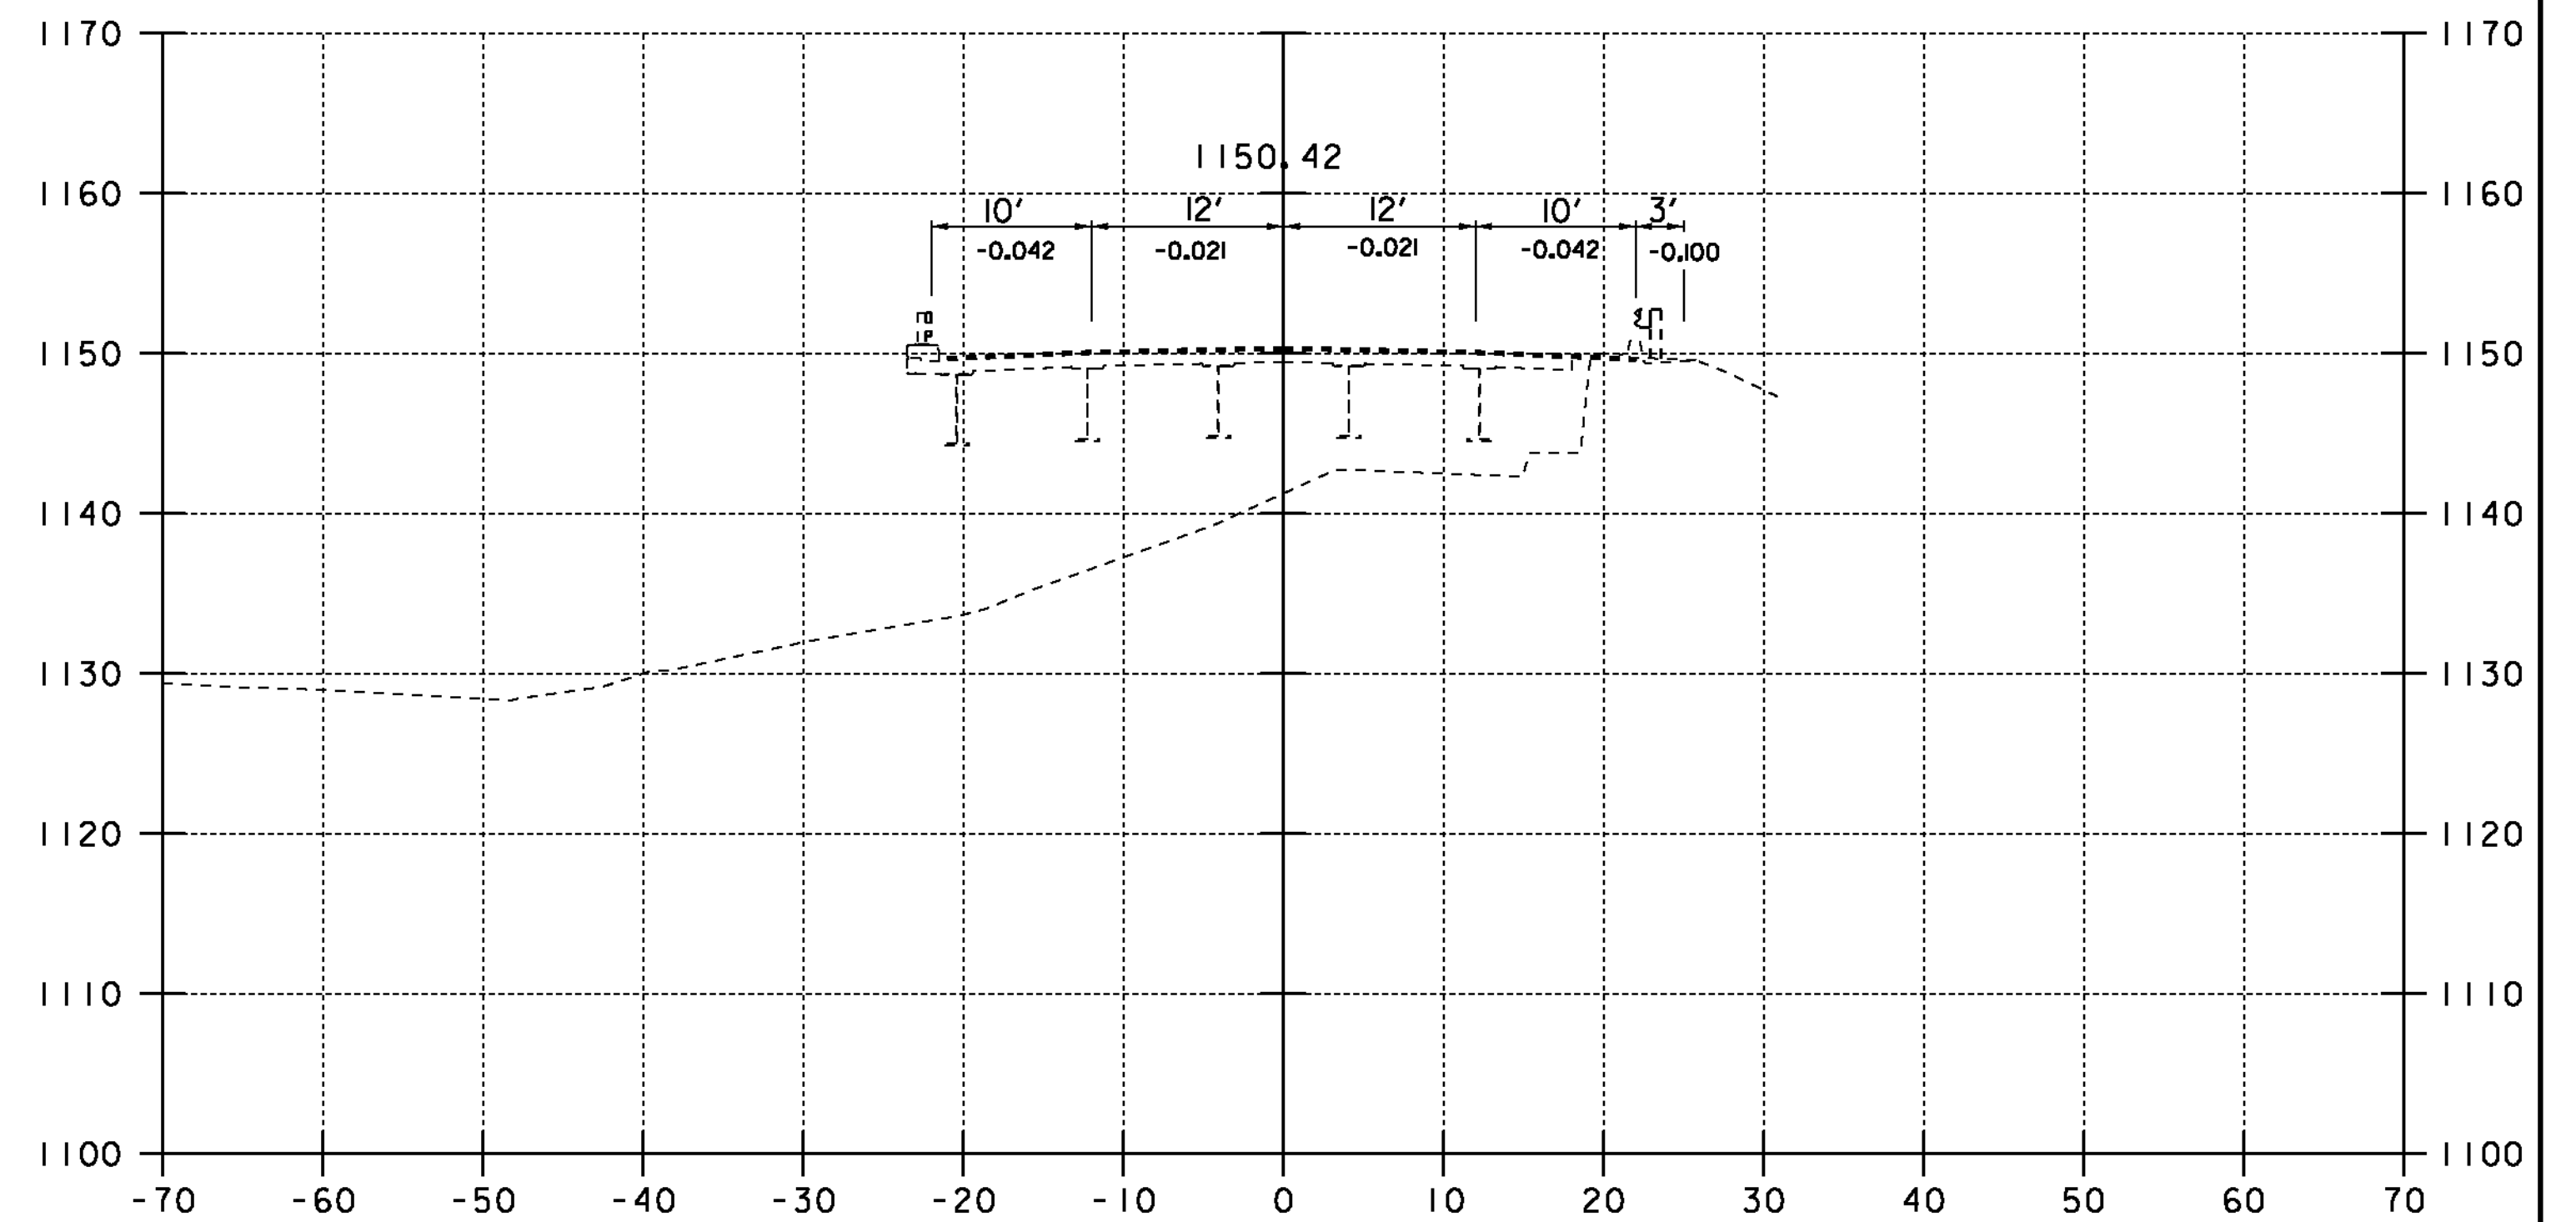

67+50

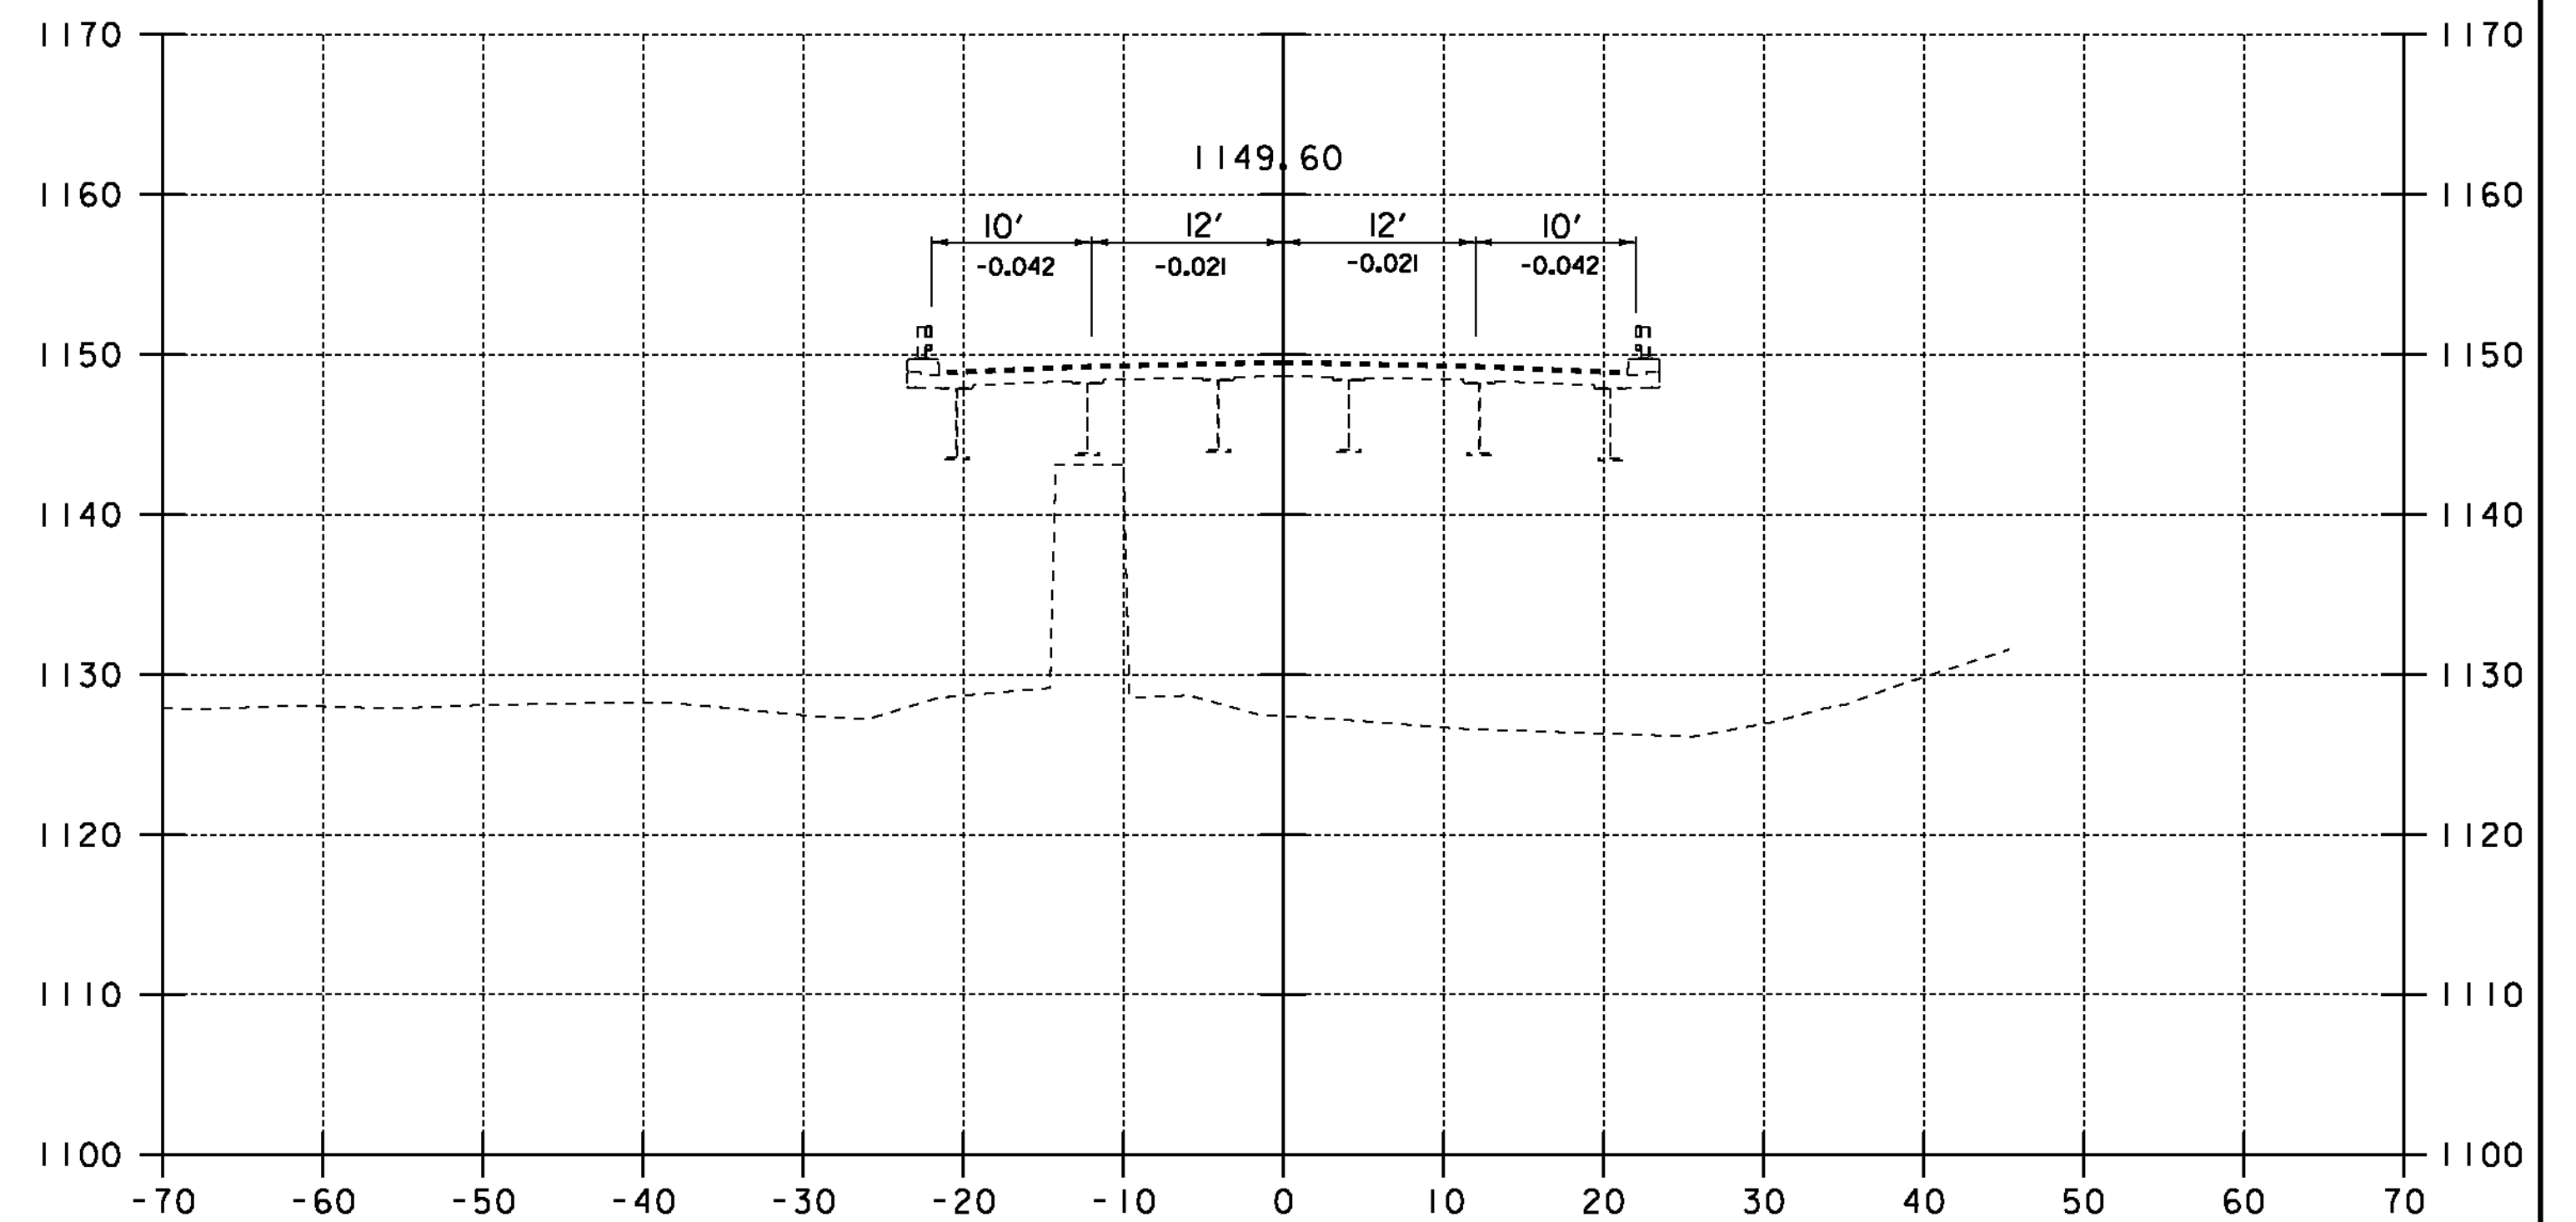

67+00

PROJECT NAME: WOODFORD	
PROJECT NUMBER: ER BHF 010-1(44)	
FILE NAME: slb214xs.dgn	PLOT DATE: 23-MAR-2012
PROJECT LEADER: C. CARLSON	DRAWN BY: EVANS-MONGEON
DESIGNED BY: M.EVANS-MONGEON	CHECKED BY:
ROADWAY CROSS SECTIONS SHEET (4)	SHEET 39 OF 58