


SOIL INFORMATION
BERKSHIRE FINE LOAMY SAND
HYDRO GROUP B
HIGHLY ERODIBLE

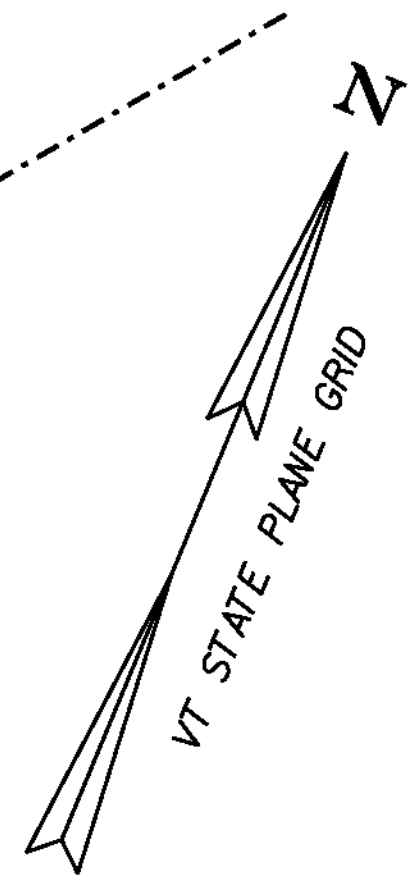

SOIL INFORMATION
UDIPSAMMENTS AND UDORTHENTS
HYDRO GROUP NOT RATED

STA. 63+00
MATCH LINE A-A

----- SOIL BOUNDARY

PROJECT NAME: WOODFORD	
PROJECT NUMBER: ER BHF 010-1(44)	
FILE NAME: s11b214EPSC bdr.dgn	PLOT DATE: 23-MAR-2012
PROJECT LEADER: C. CARLSON	DRAWN BY: EVANS-MONGEON
DESIGNED BY: M.EVANS-MONGEON	CHECKED BY: G. ROY
EPSC EXISTING CONDITION (1)	SHEET 48 OF 58

SCALE 1" = 20'-0"
20 0 20

