

Highway Safety Corporation

Glastonbury, CT

Welding Procedure Specification

Material specification ASTM A500 gr B

Welding process Gas Metal Arc Welding (GMAW)

Manual, semi-automatic, or automatic Semi-Automatic

Position of welding Flat (1F) or Horizontal (2F)

Filler metal specification AWS A5.18

Filler metal classification ER70S-6

Electrode and manufacturer Lincoln Electric Lincoln Weld L-56

Flux and manufacturer N/A

Shielding gas 86% Argon / 14% CO2 Flow rate 35-45 CFM

Single or multiple pass Single

Single or multiple arc Single

Welding current DCEP

Polarity Reverse - electrode positive

Welding progression Stringers

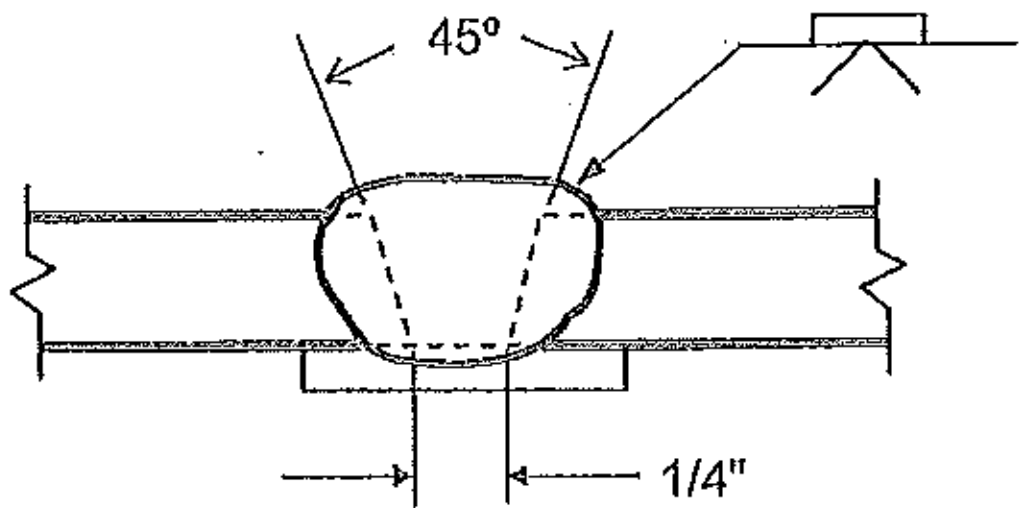
Root treatment clean base metal

Preheat and interpass temperature base metal up to 3/4" (50°F)

Postheat treatment None

Electrode extension 3/4" ± 1/4"

WELDING PROCEDURE

Weld size	Pass no.	Electrode size	Welding parameters		Travel speed	Joint detail
			Amperes	Volts		
	1	0.063"	300 A ± 30	29 V ± 2	15 ipm ± 2	B-U2a-GF 

Trans Received
CK'D BY: *JUC*

JUN 27 2012

Resubmit BY: *APPROVED*
DATE: *17/6/12*

This procedure may vary due to fabrication sequence, fit-up, pass size, etc. within the limitation of variables given in section 5 of latest edition AWS D1.1

WPS no. W-VGWBCK

Revision no. 0

Supporting PQR no. Pre-Qualified

Project Name Woodford, VT

Fabricator Highway Safety Corporation

Prepared By: Paul Radice

Date 5/31/12

Project Number ER BHF 010-1(44)

Paul A. Radice
CWI 98070221
QC1 EXP 7/1/201