



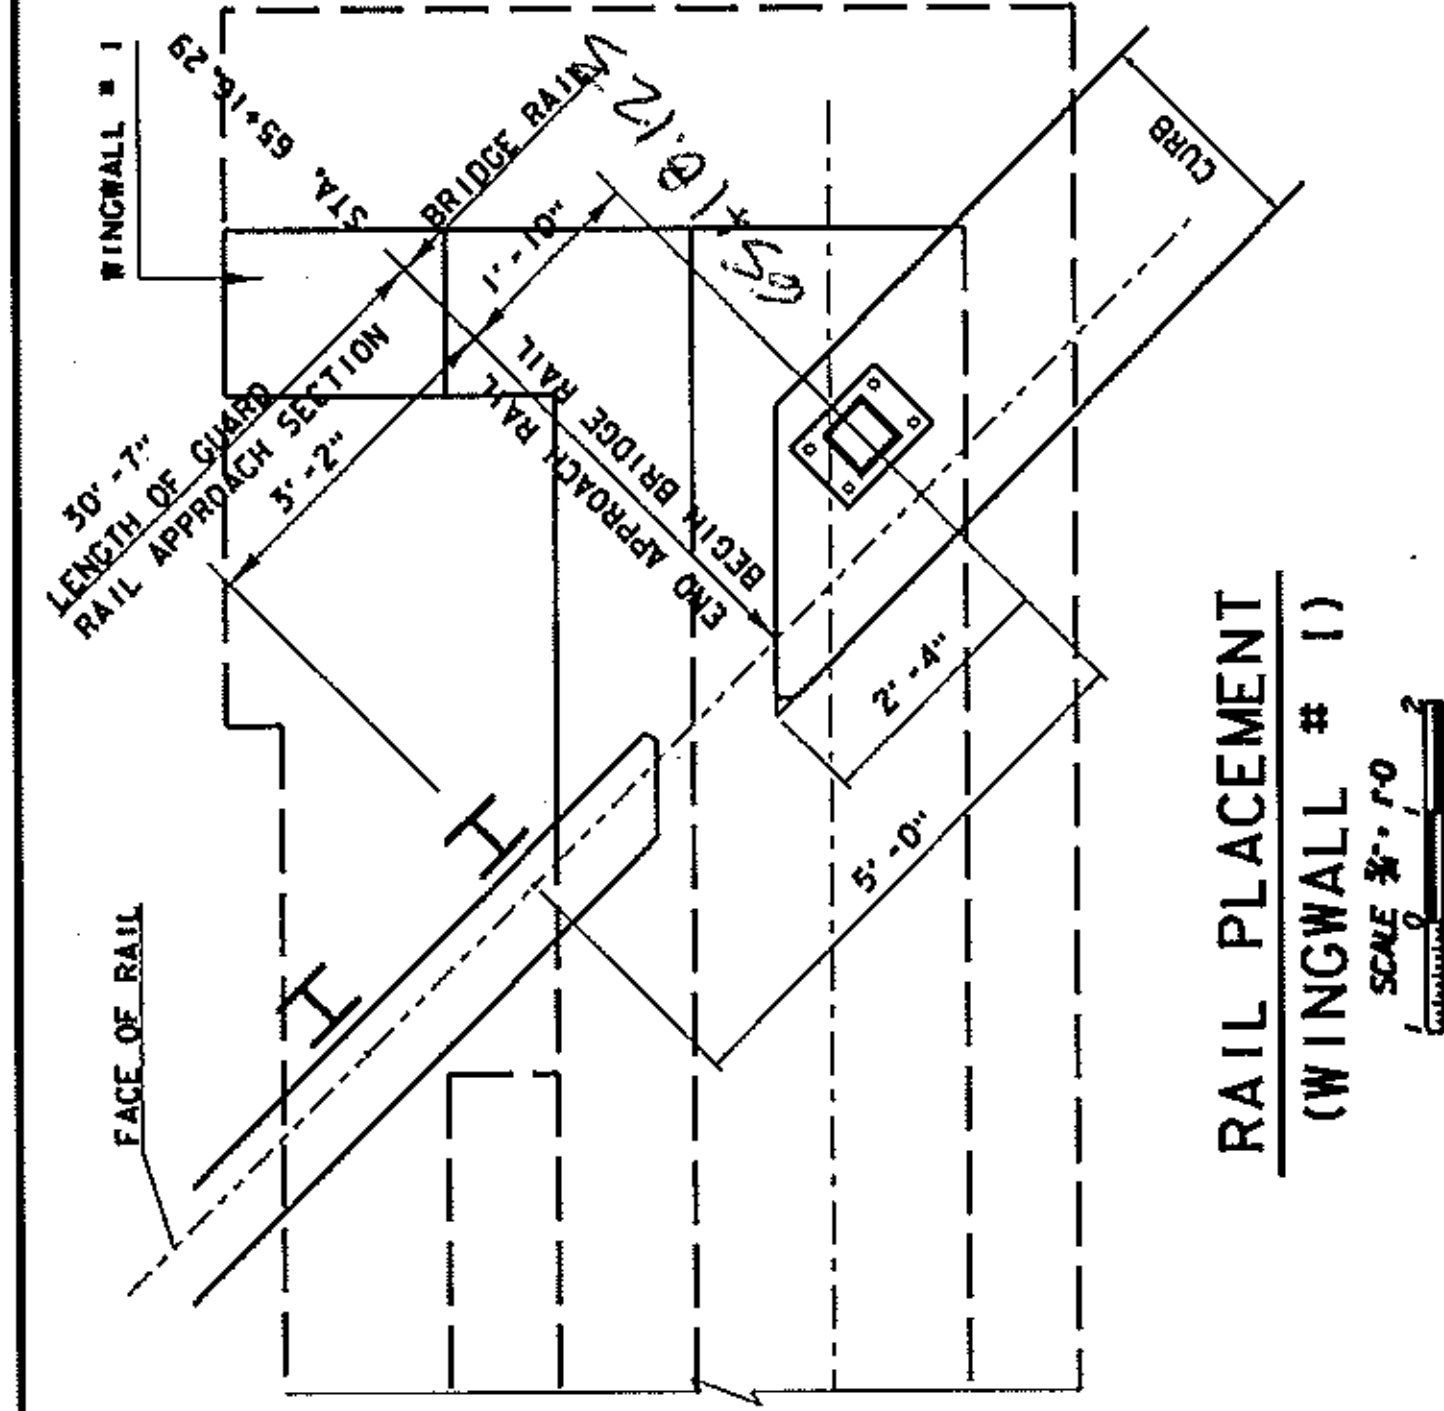


RAIL PLACEMENT
(WINGWALL # 1)

SCALE 3/4" = 1'-0"

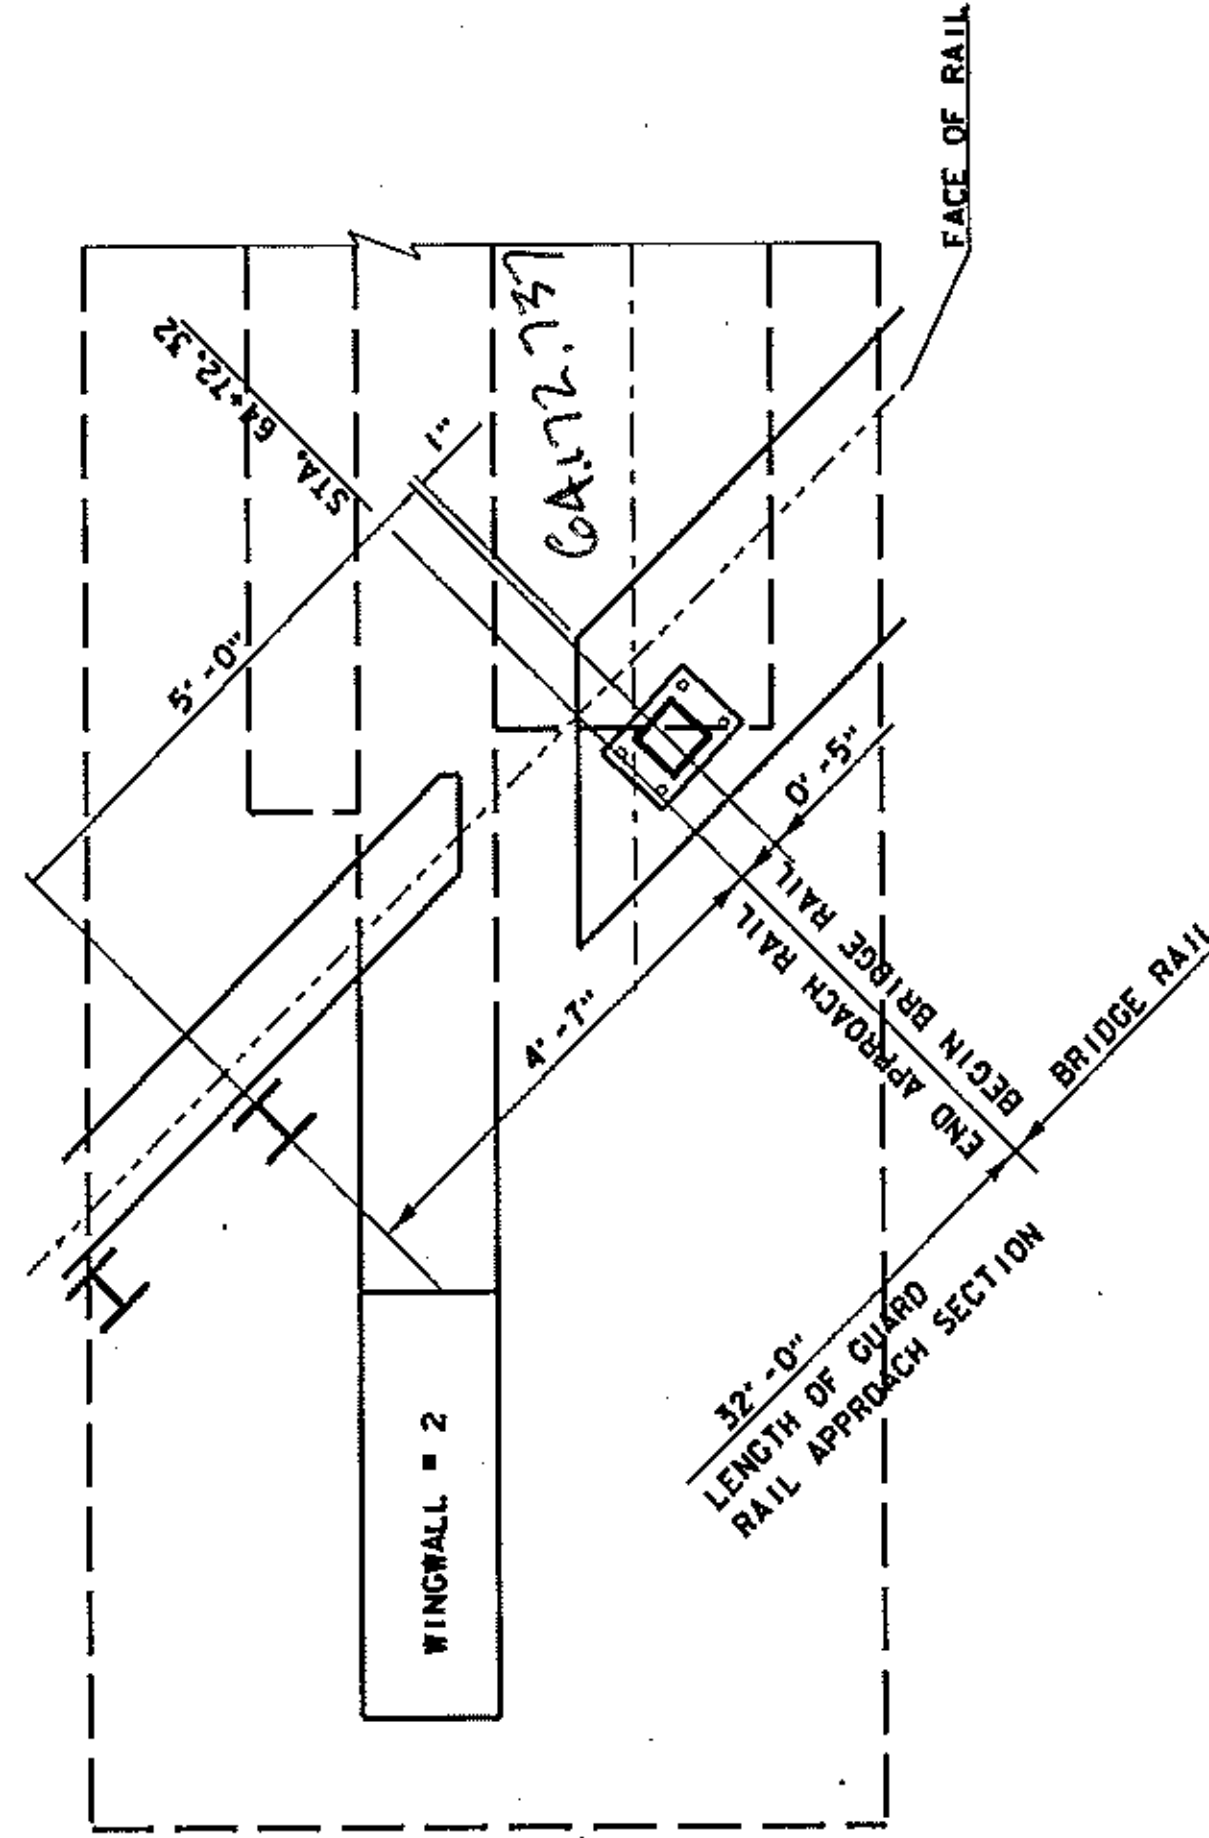


RAIL PLACEMENT
(WINGWALL # 2)

SCALE 3/4" = 1'-0"

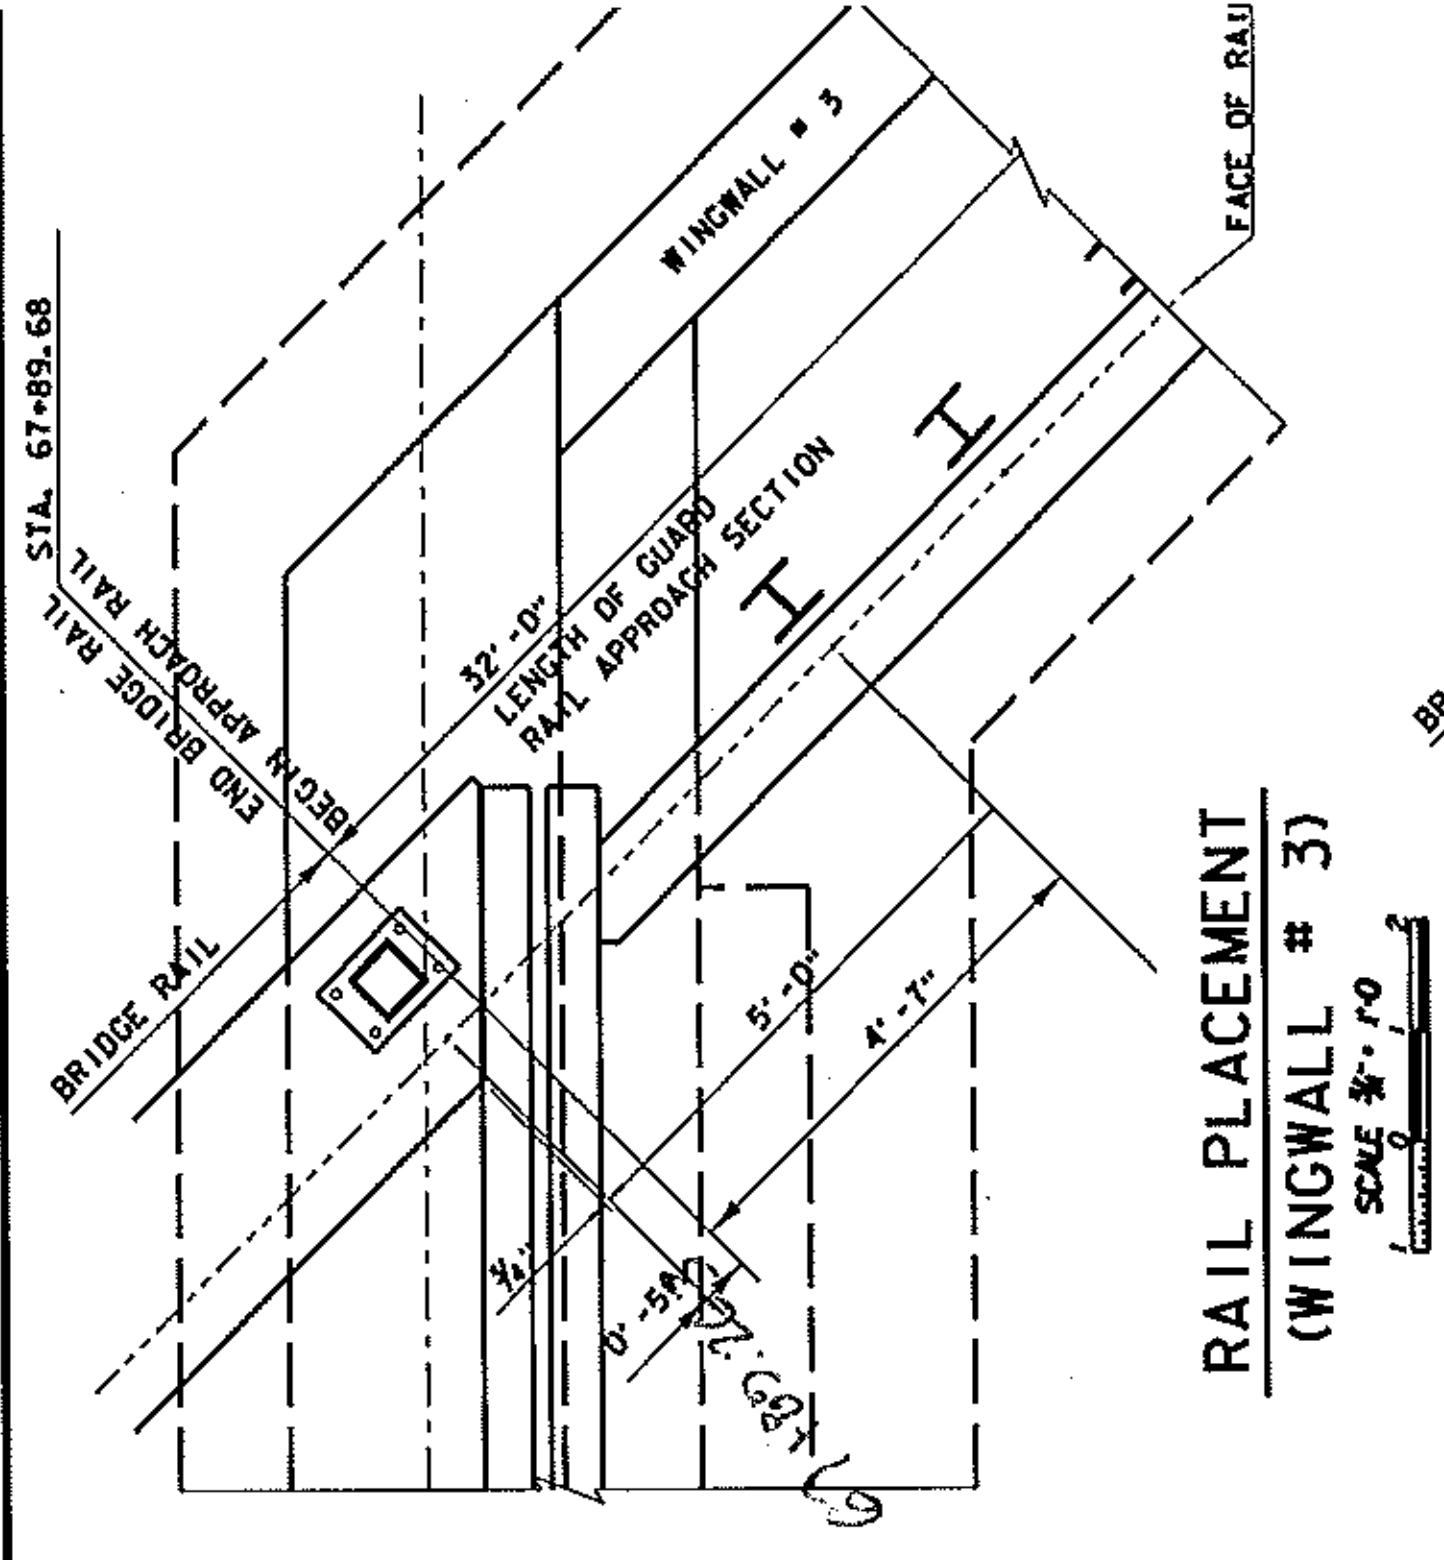

RAIL PLACEMENT
(WINGWALL # 3)

SCALE 3/4" = 1'-0"

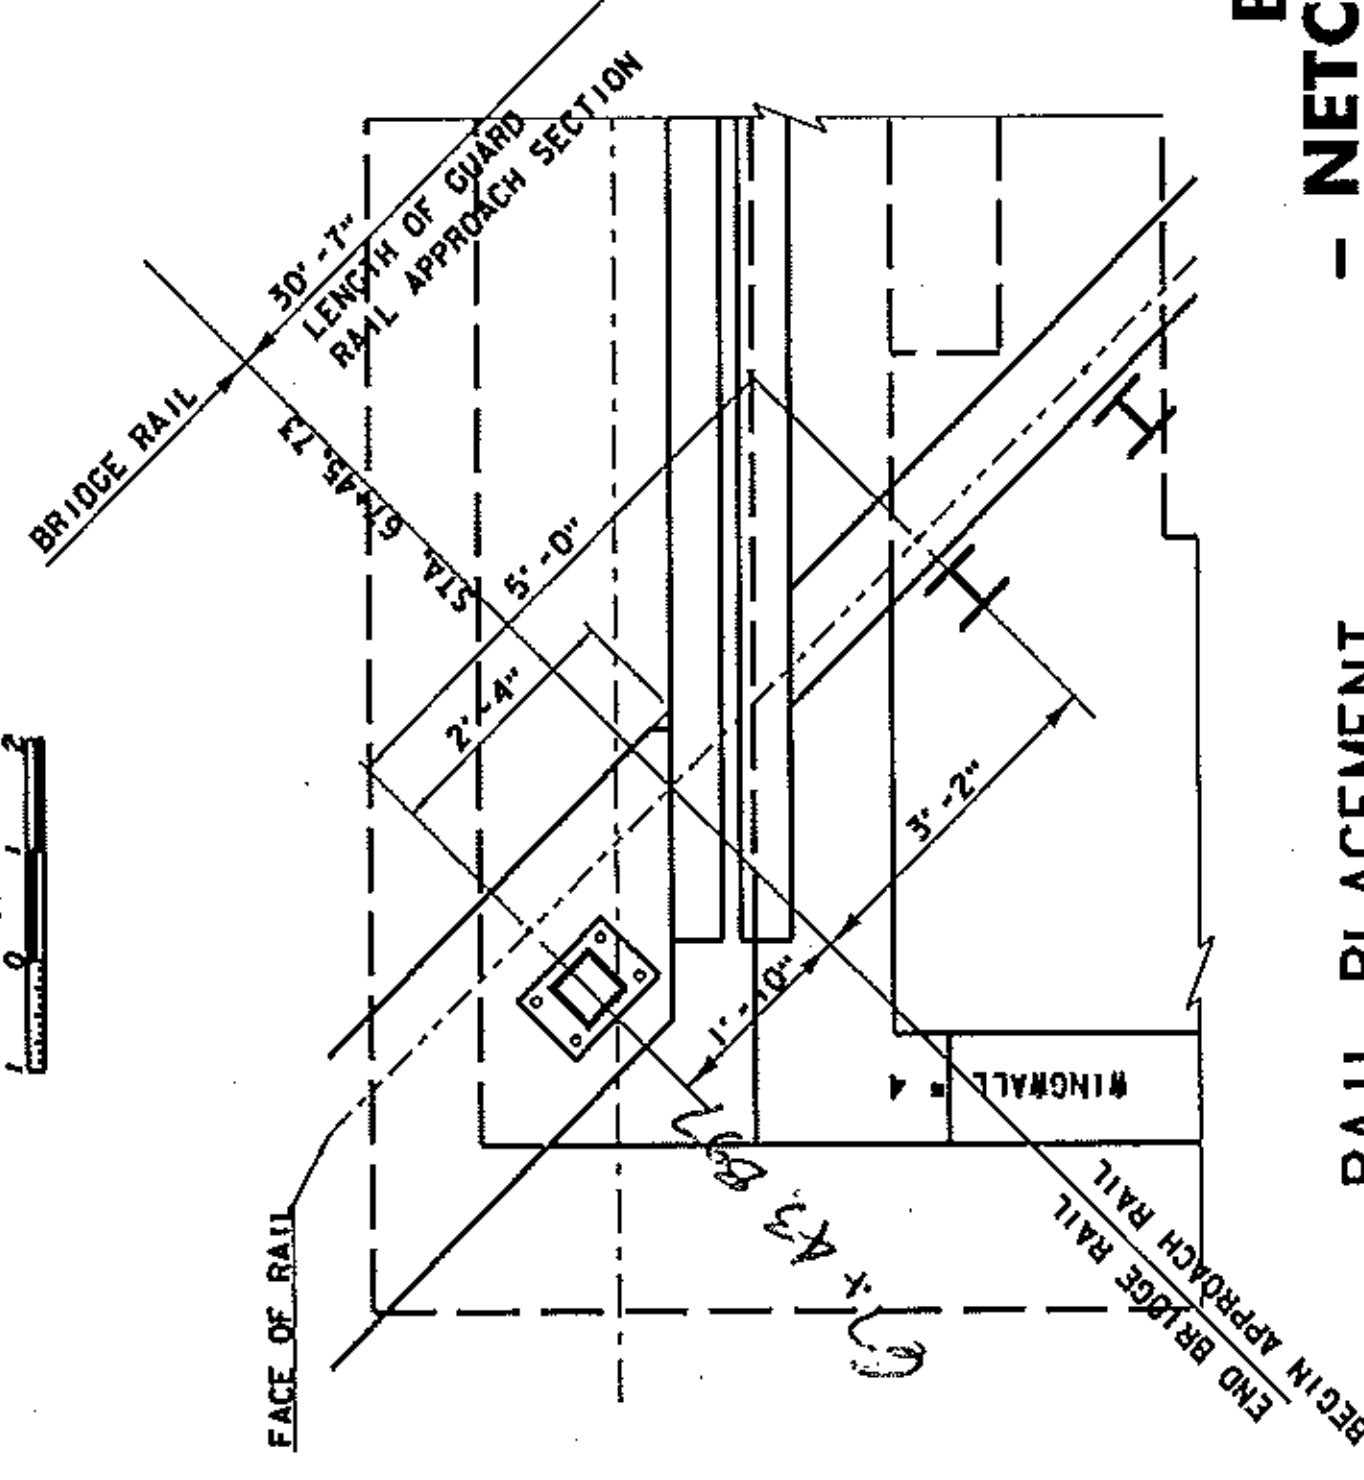

RAIL PLACEMENT
(WINGWALL # 4)

SCALE 3/4" = 1'-0"

BRIDGE
- NETC 2 R

PROJECT NAME: W
PROJECT NUMBER: B1
FILE NAME: /B400397.m
PROJECT LEADER: A. P.
DESIGNED BY: MEV