

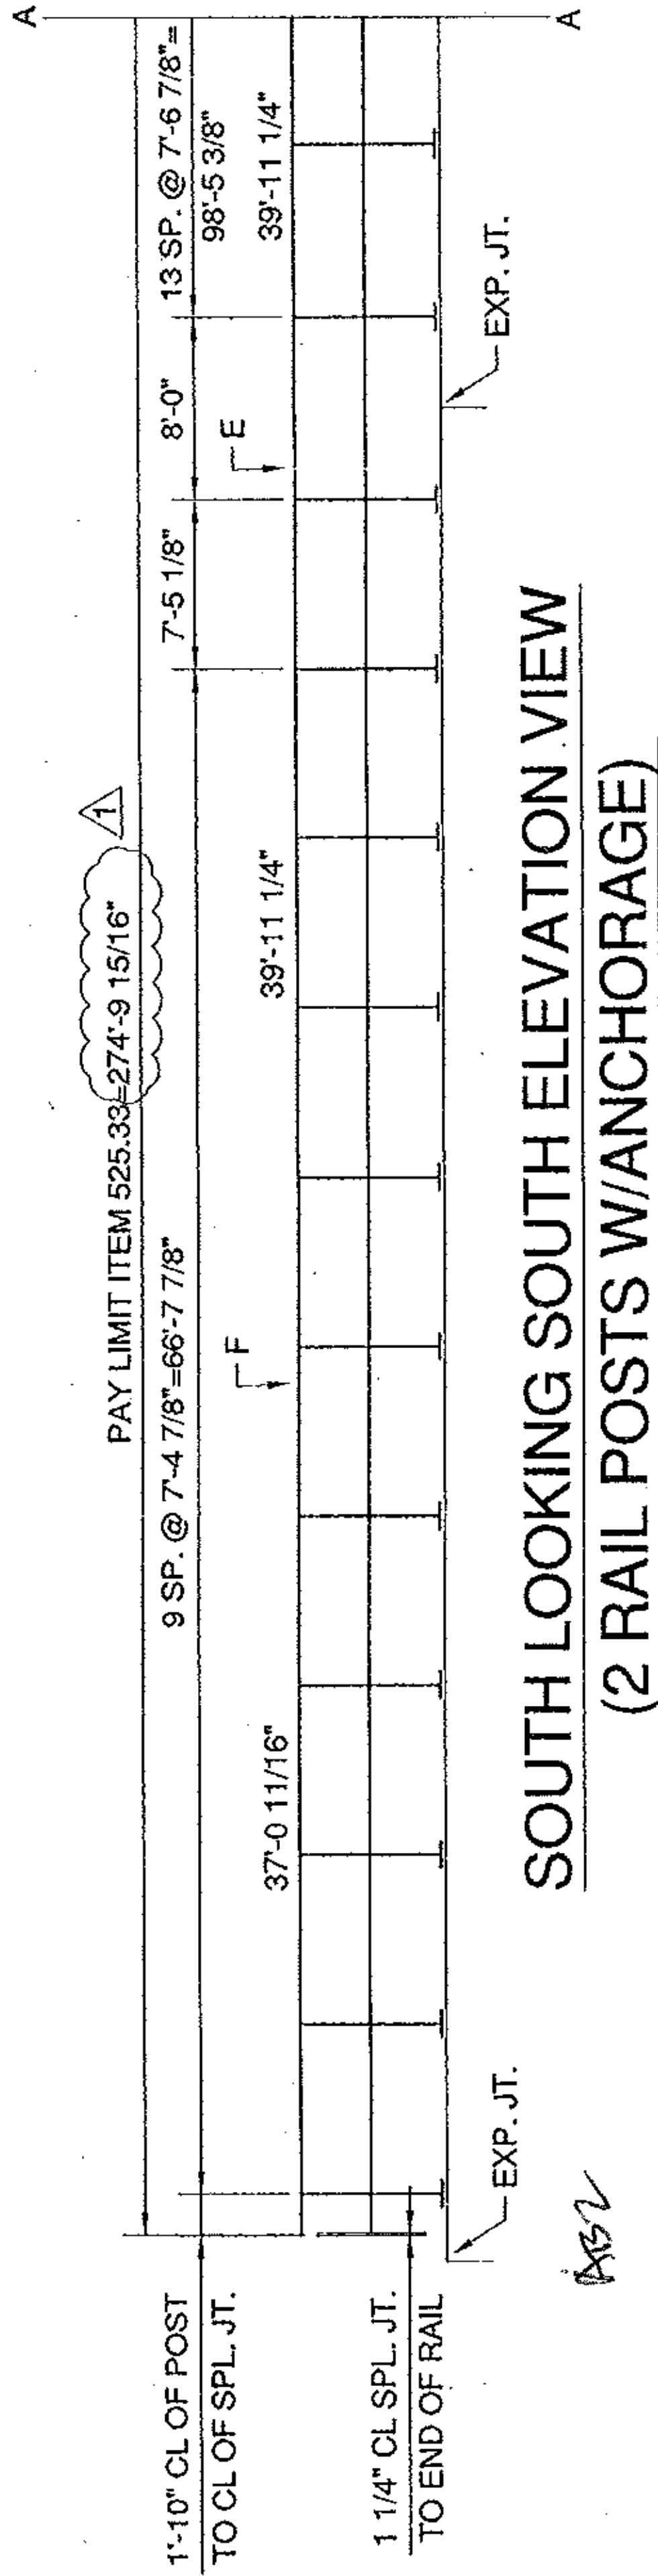


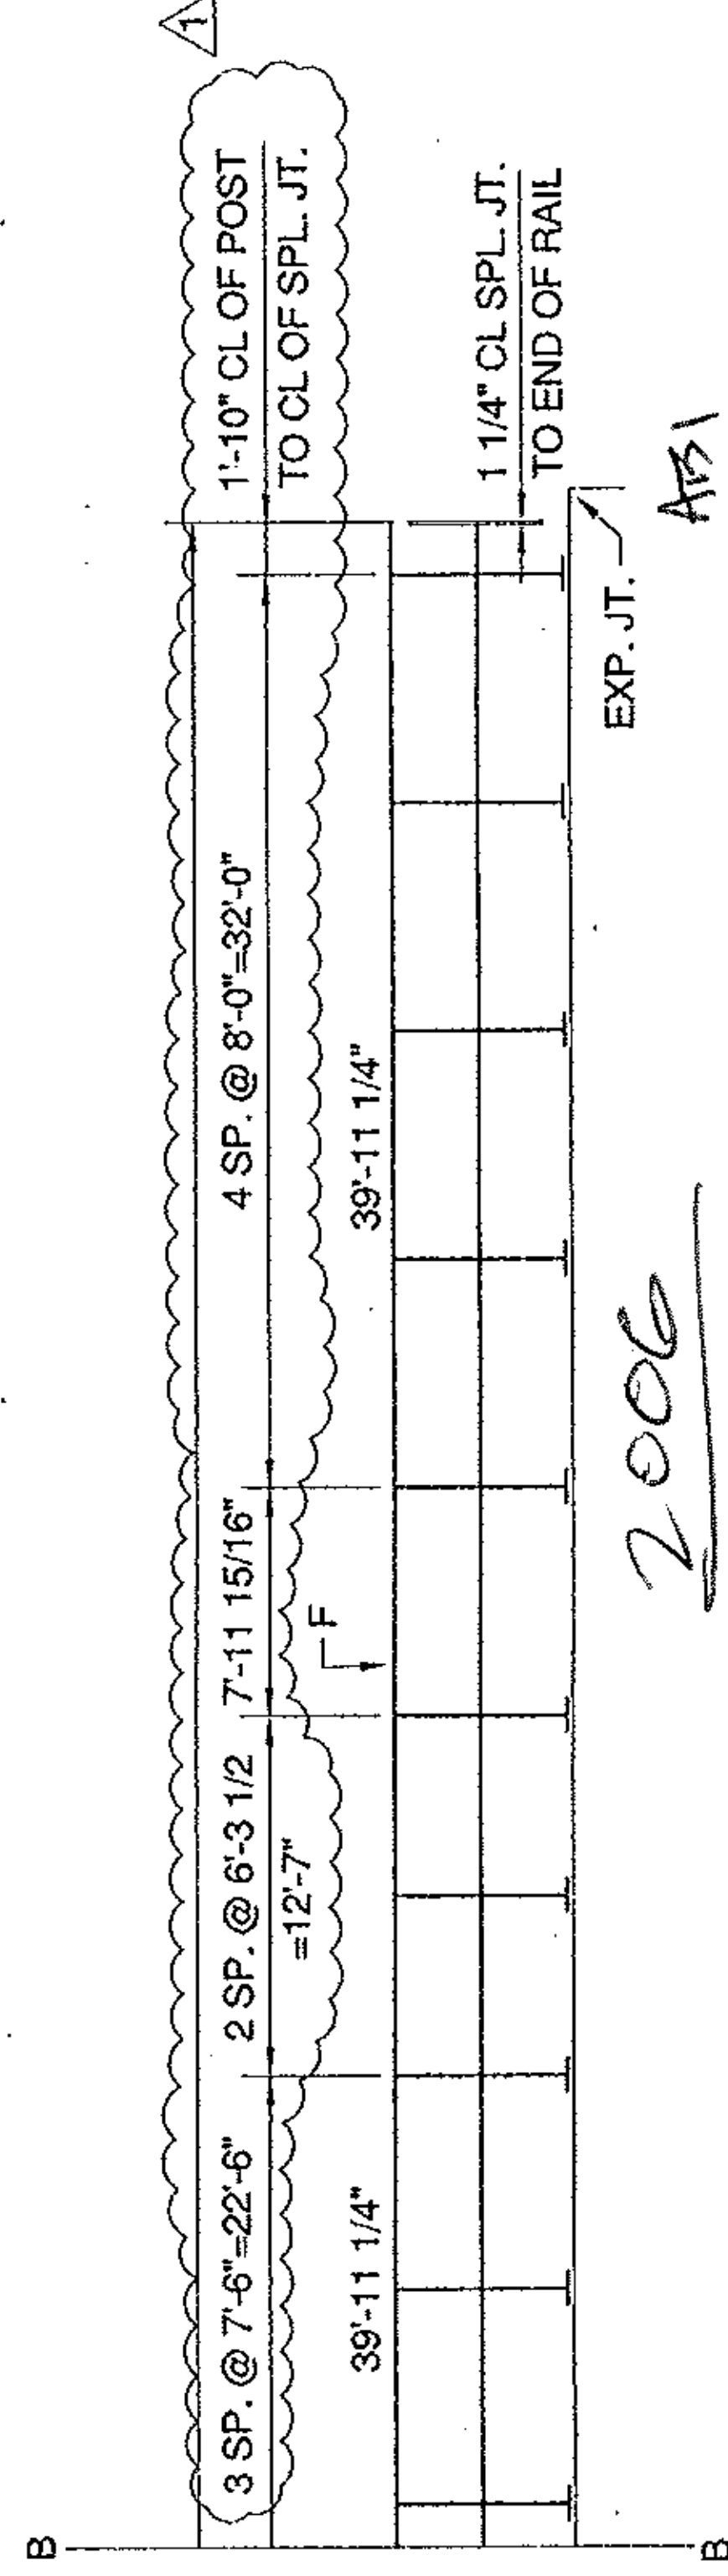

KEY
F=3/4" FXD. SPL. JT.
E=2 1/2" EXP. SPL. JT.

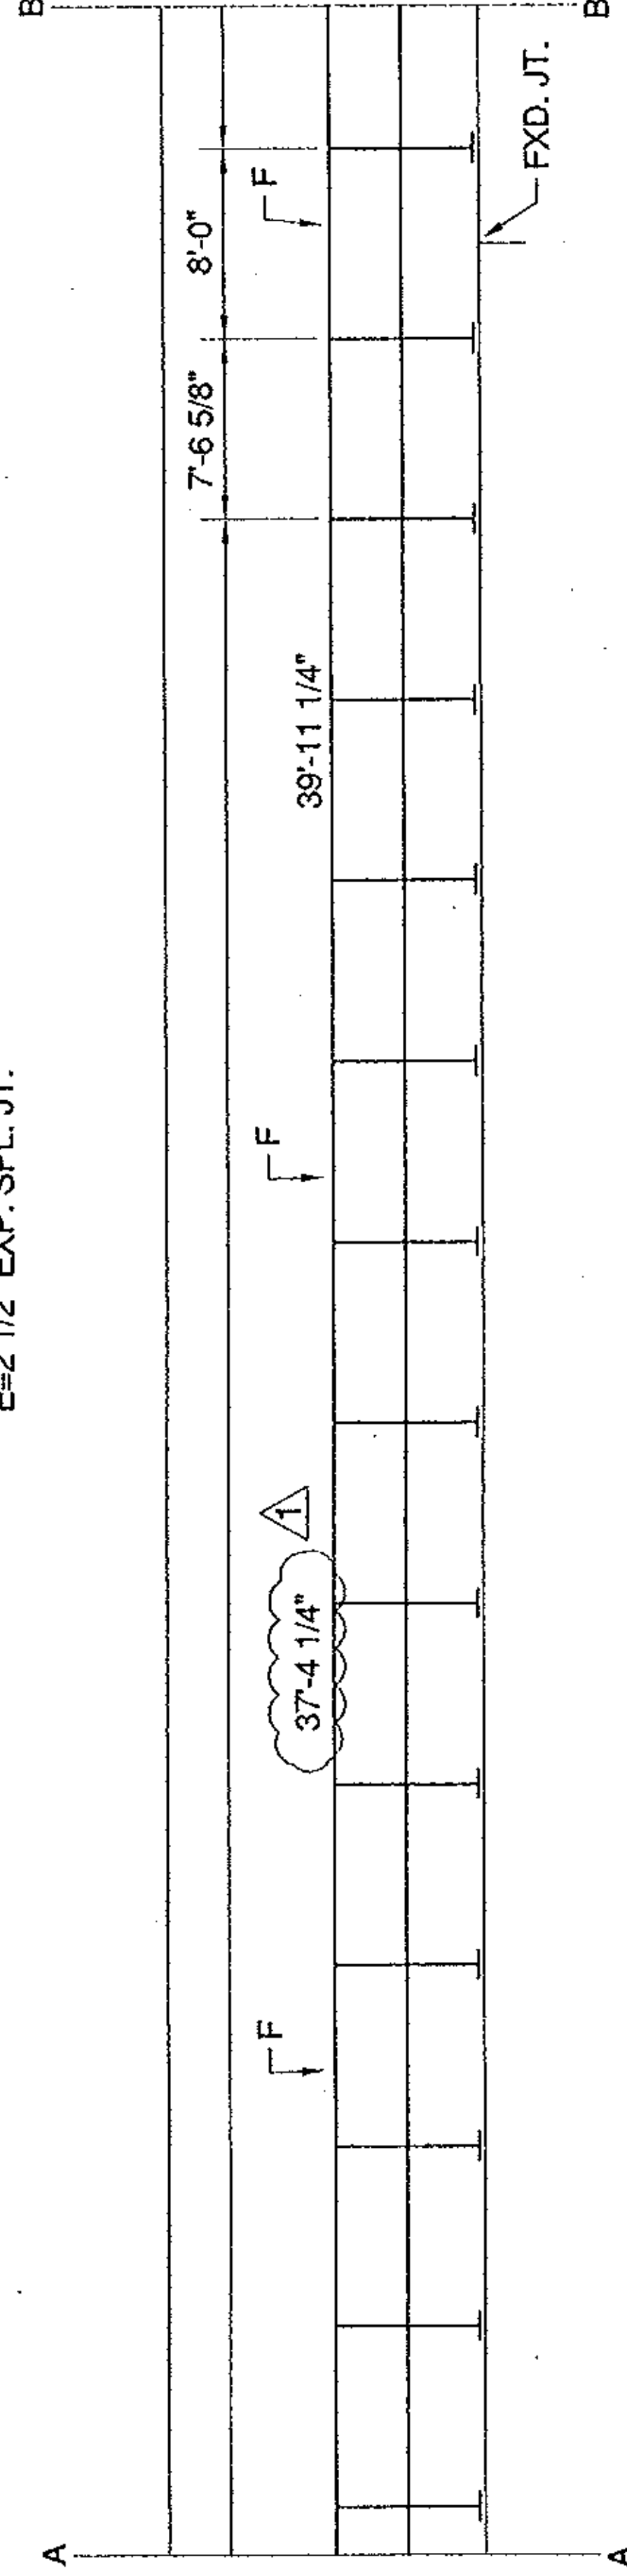

2006

AS1