



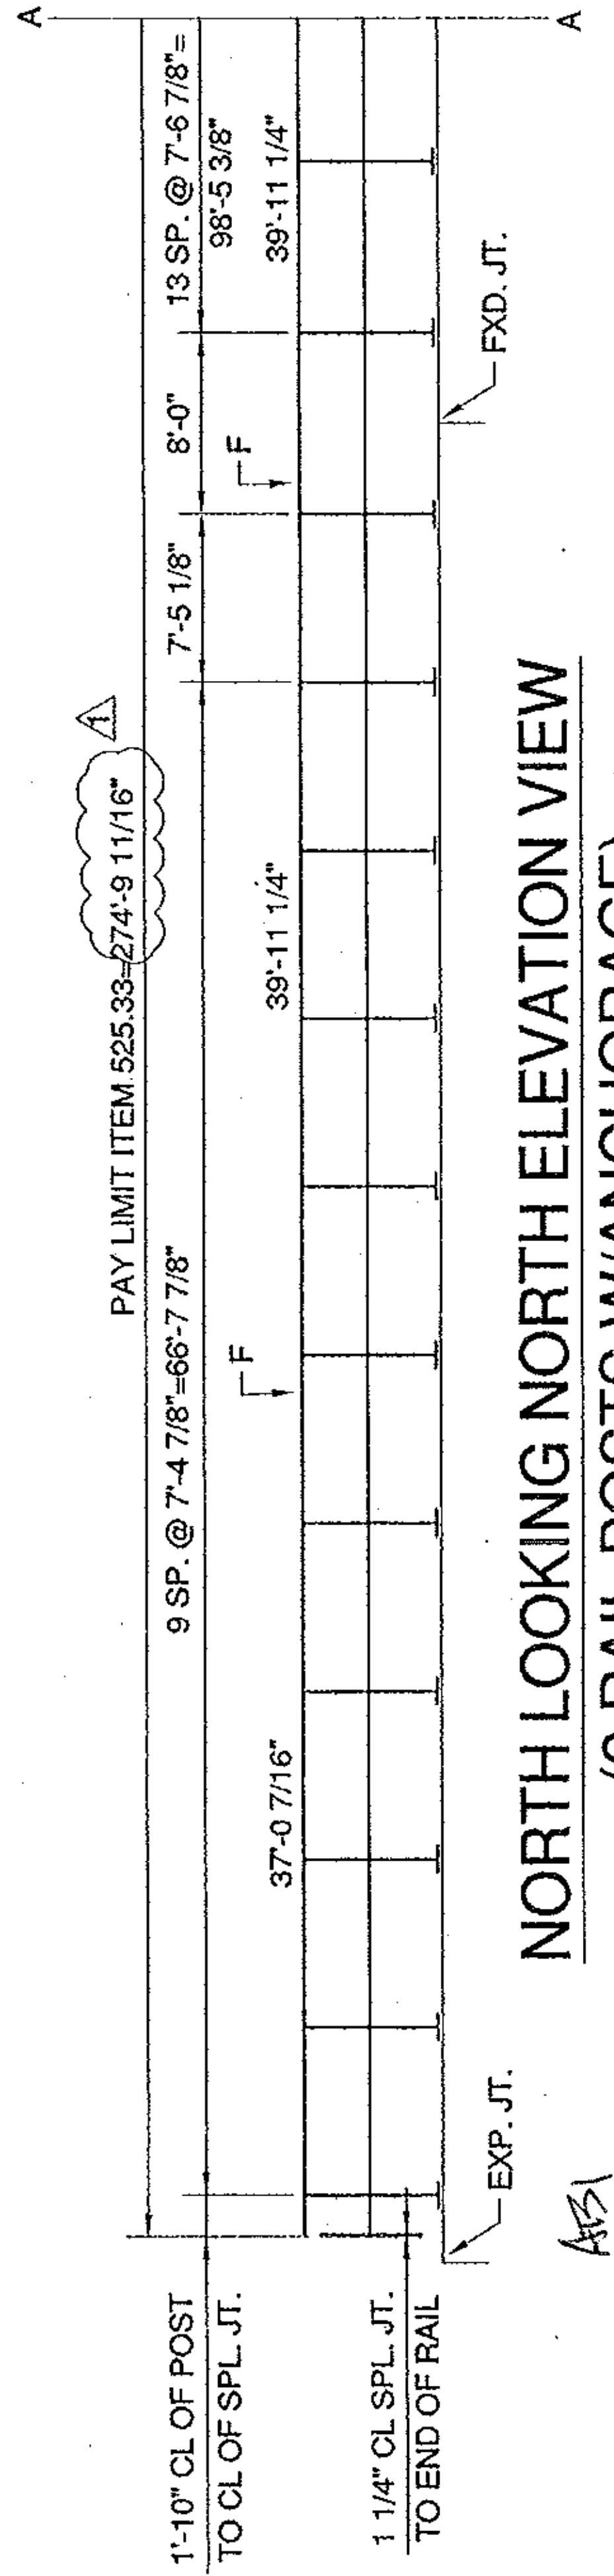

AB1

KEY
F=3/4" FXD. SPL. JT.
E=2 1/2" EXP. SPL. JT.

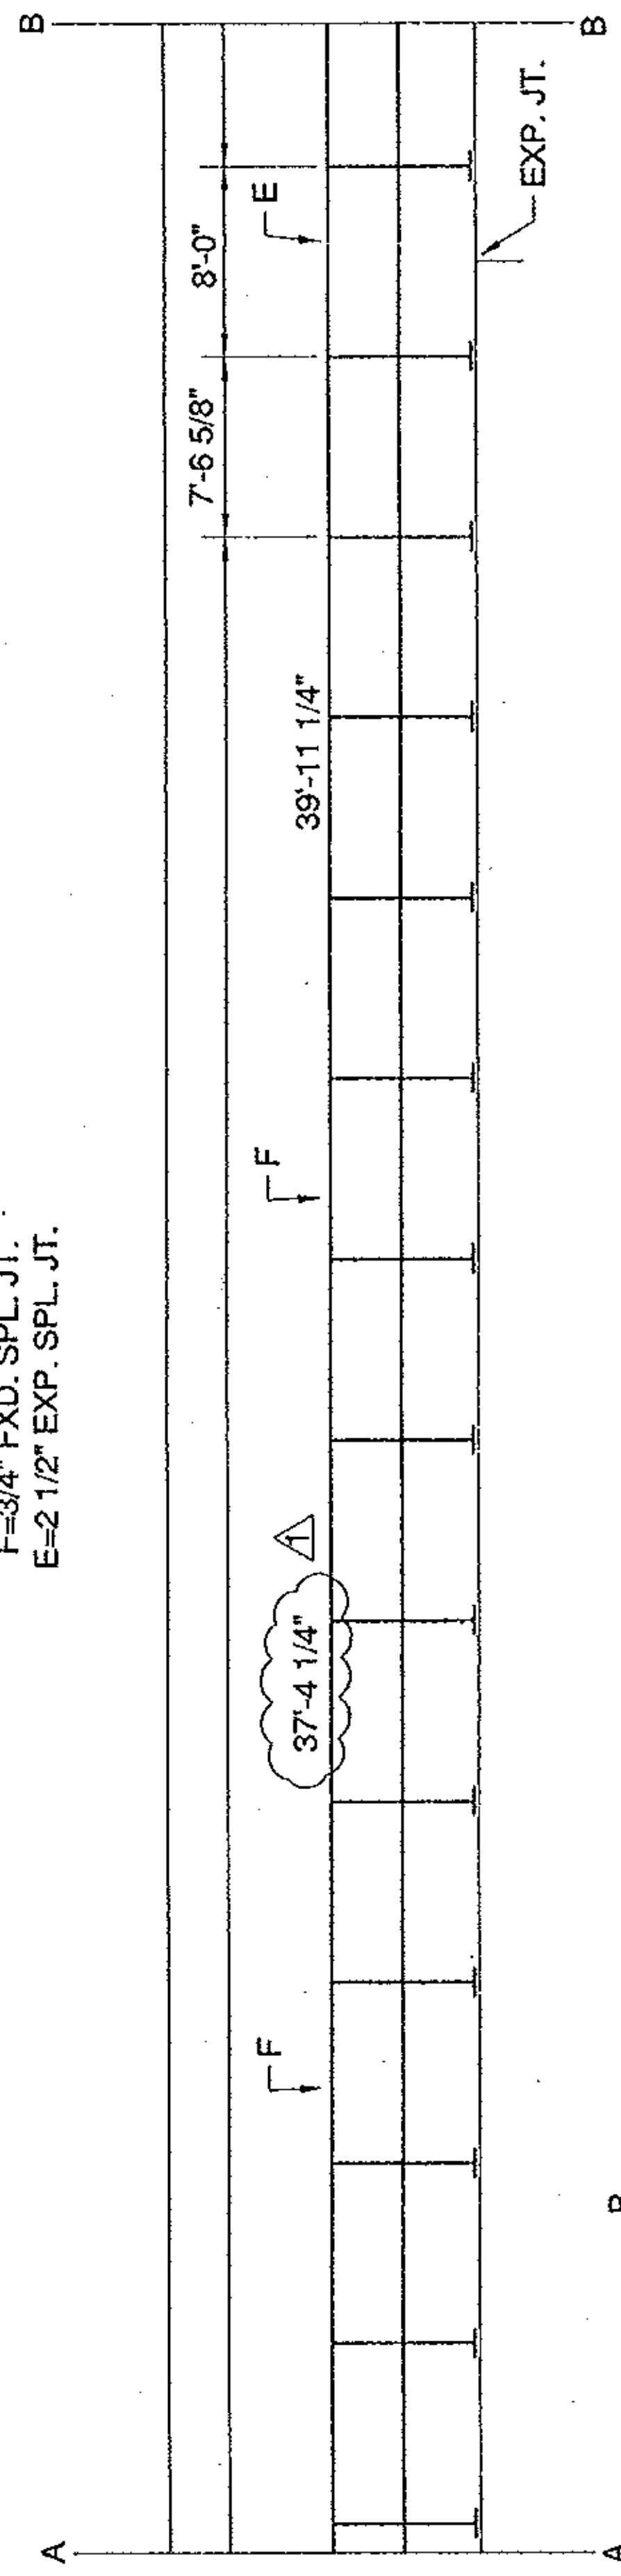


B

A

B

A

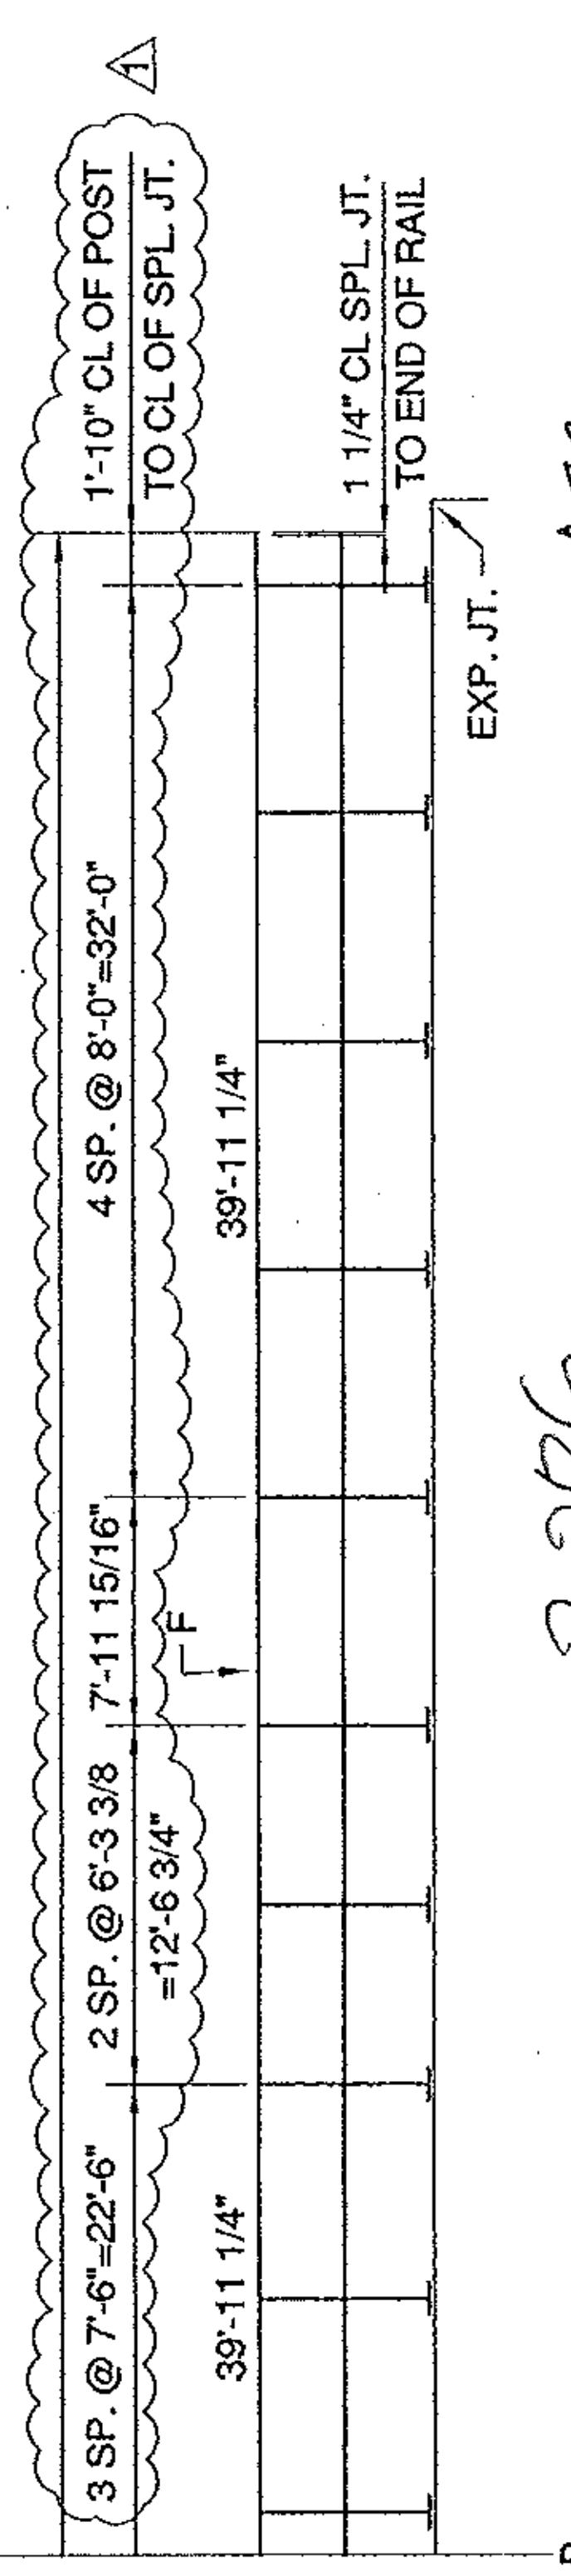

2006

AB2