


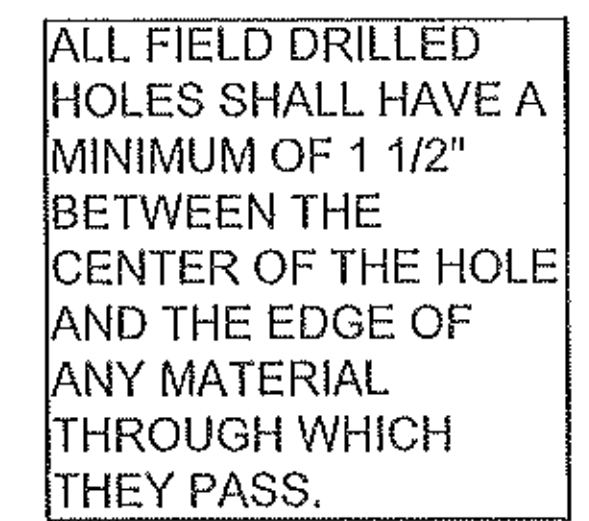

A technical line drawing showing a cross-section of a roof-to-wall connection. A sloped roof slab is shown intersecting a vertical wall. Two sets of bolts are used to secure the roof slab into the wall. Each set consists of a bolt passing through the roof slab and a nut and washer on the wall side. The roof slab has a dashed line indicating a break or continuation. The wall has a dashed line indicating a break or continuation. The text "TYPICAL BOLTING DETAIL" is written below the diagram.

APPROVED AS NOTED
DATE 01-29-2013

ISSUE BY BR	DATE JAN 2013	EXTRACT NO UN04260
ORDERED BY GG	DATE JAN 2013	ISSUE NO E104/0