




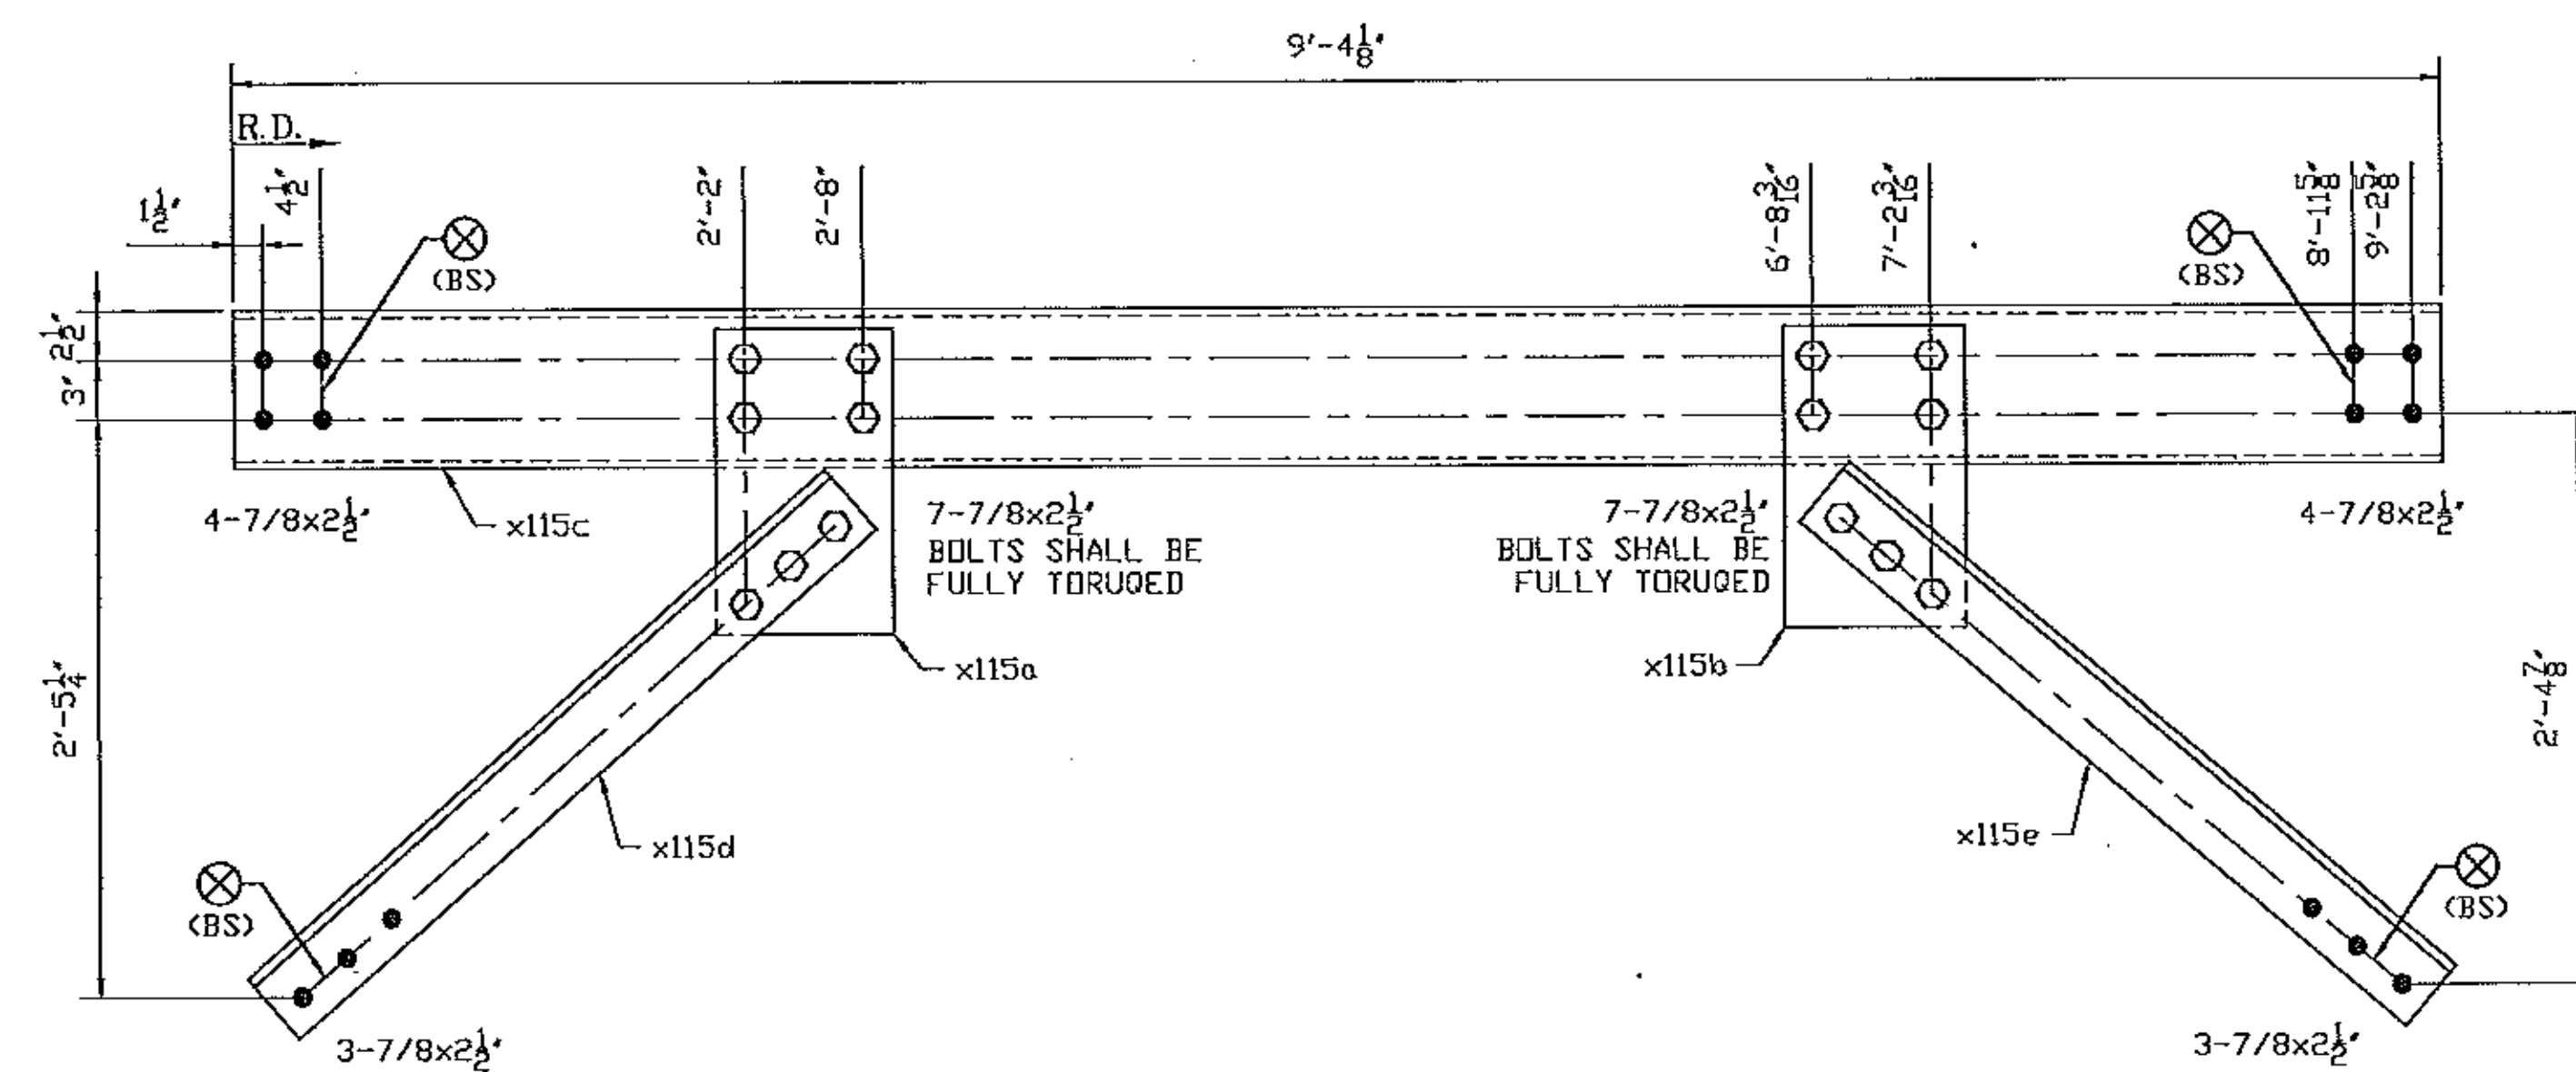


ONE - CROSS FRAME 115CF1
PAINTED

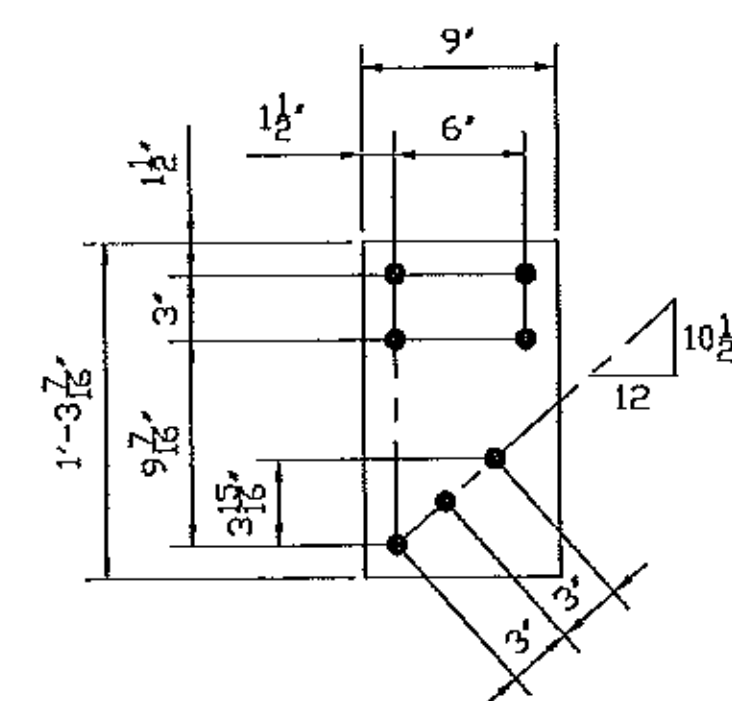


PL1/2x9x1-3 7/16 - x115a

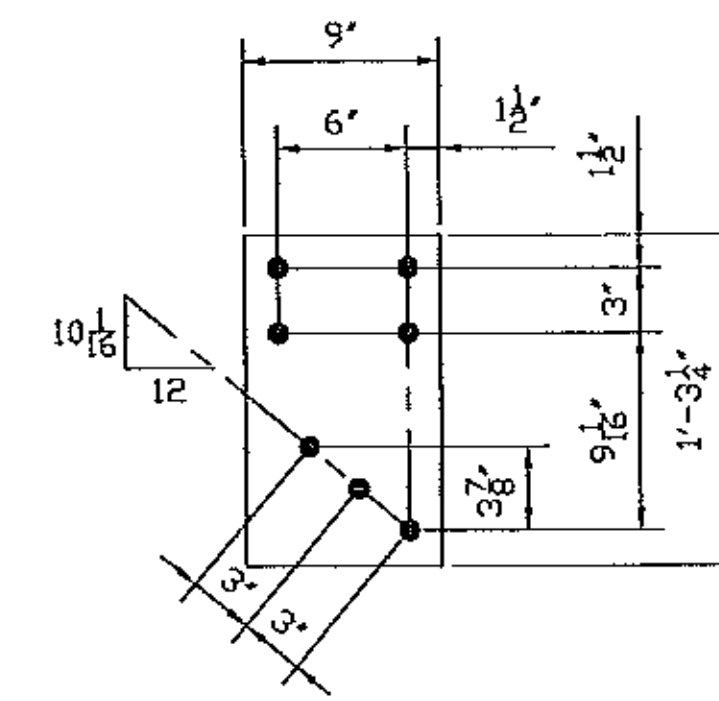

PL1/2x9x1-3 1/4 - x115b

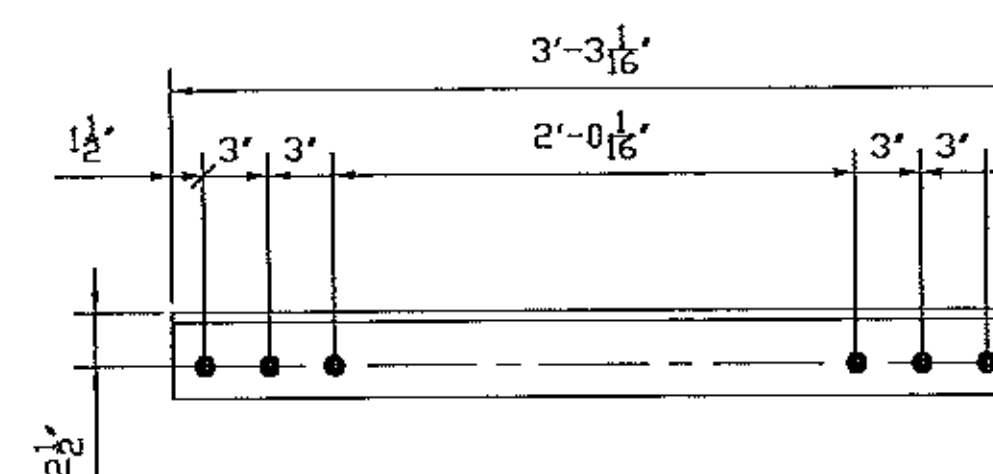

L4x4x1/2x3-3 1/16 - x115d

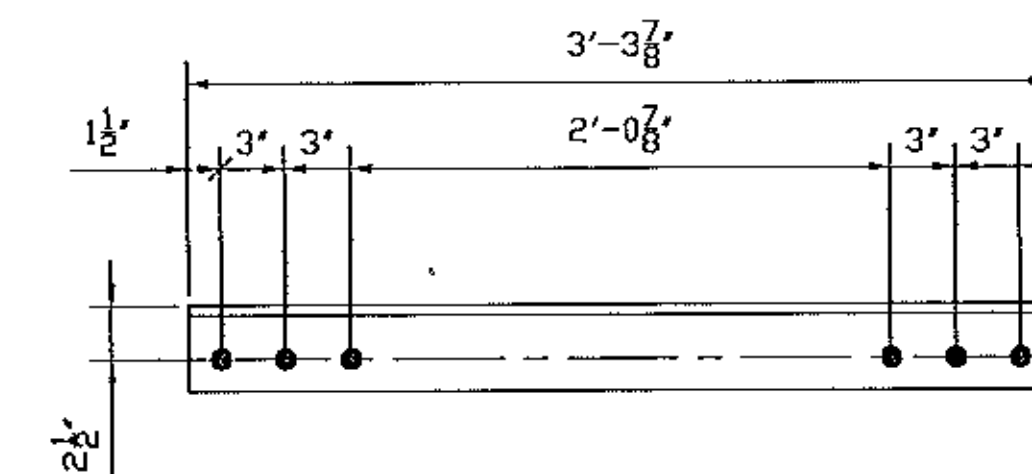

L4x4x1/2x3-3 7/8 - x115e

GENERAL NOTES: SEE GN100
HOLES: 15/16 (UN.)
CLEANING AND PAINTING: SEE SHEET P100 AND P101

PRIMER ONLY, NO PAINT
BOTH SIDES 75 MM DIA AROUND HOLE
WHERE NOTED WITH THIS SYMBOL
(BS)

337

BILL OF MATERIAL									
Mark	Qty.	Description	SU	Length	Remark	ABM	Total (lbs)	Seq	Qty
			Grd				Weight	/Seq	
115CF1	ONE	CROSS FRAME							
115CF1	1	CROSS FRAME		9-4 1/8	PAINT				
x115a	1	PL1/2x9	A70950W	1-3 7/16		104-5	20		
x115b	1	PL1/2x9	A70950W	1-3 1/4		104-5	19		
x115c	1	MC8x22.8	A70950W	9-4 1/8		104-1	213		
x115d	1	L4x4x1/2	A70950W	3-3 1/16		104-3	42		
x115e	1	L4x4x1/2	A70950W	3-3 7/8		104-3	43		
78S212	14	.7/8 Dia A325 TYP3		2 1/2	1FL WASH				
78F212	14	.7/8 Dia A325 TYP3		2 1/2	1FL WASH				

Vermont Agency of Transportation

RECEIVED

CK'D BY M.E.M. OK'D BY C.W.M.

Jan. 29, 2013

RESUBMIT APPROVED AS NOTED
BY C. CARLSON DATE 01-29-2013

NO	REVISION	DATE	PAR	VER.
1	CROSSFRAME MODIFIED	01/16/13	BR	GG
2	CROSSFRAME MODIFIED	09/17/12	BR	GG
3	FOR SHOP	08/03/12	SM	GG
4	FOR APPROVAL	07/06/12	BR	EG

NOTE: BOLT 1 WASHER: 1 WASHER UNDER NUT U.N.
BOLT 2 WASHER: 1 WASHER UNDER HEAD U.N.
1 WASHER UNDER HEAD U.N.



PROJECT: VT RT 9, BRIDGE NO. 11
TOWN OF WOODFORD, VT
OVER WALDOOMSAC RIVER

TITLE: ABUTMENT CROSS FRAME

REFERENCE: PROJECT NO. ER BHF 010-1 (44)

DESIGNED BY	BR	DATE	JULY 2012	CONTRACT NO.	UN04260
CHECKED BY	GG	DATE	JULY 2012	SHEET NO.	115/2