
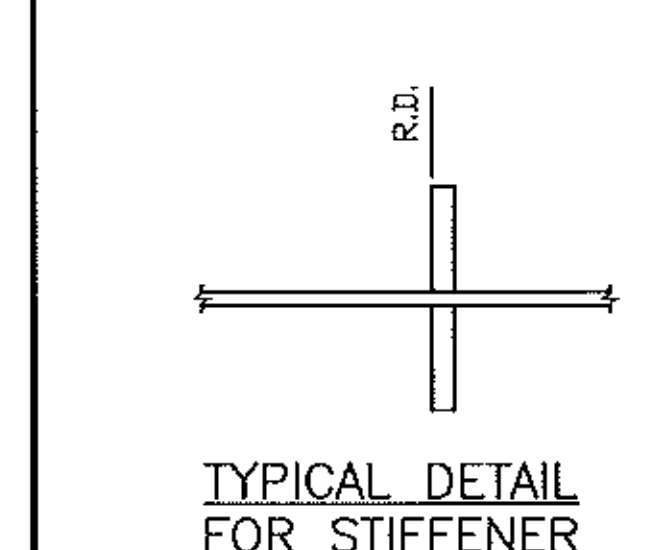
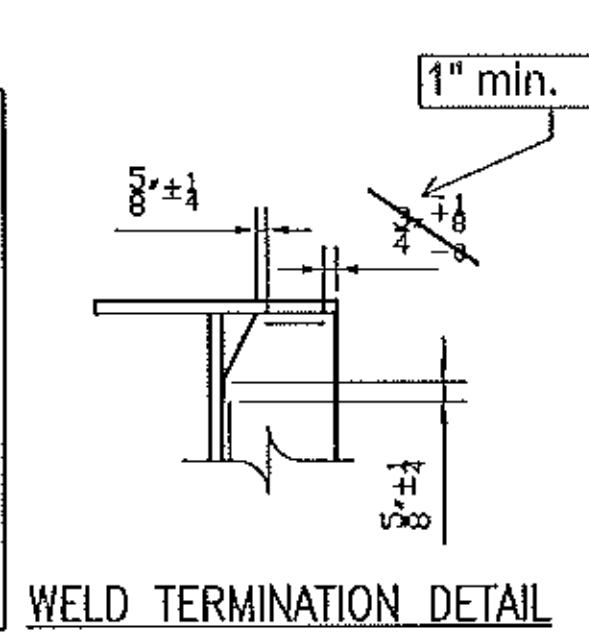
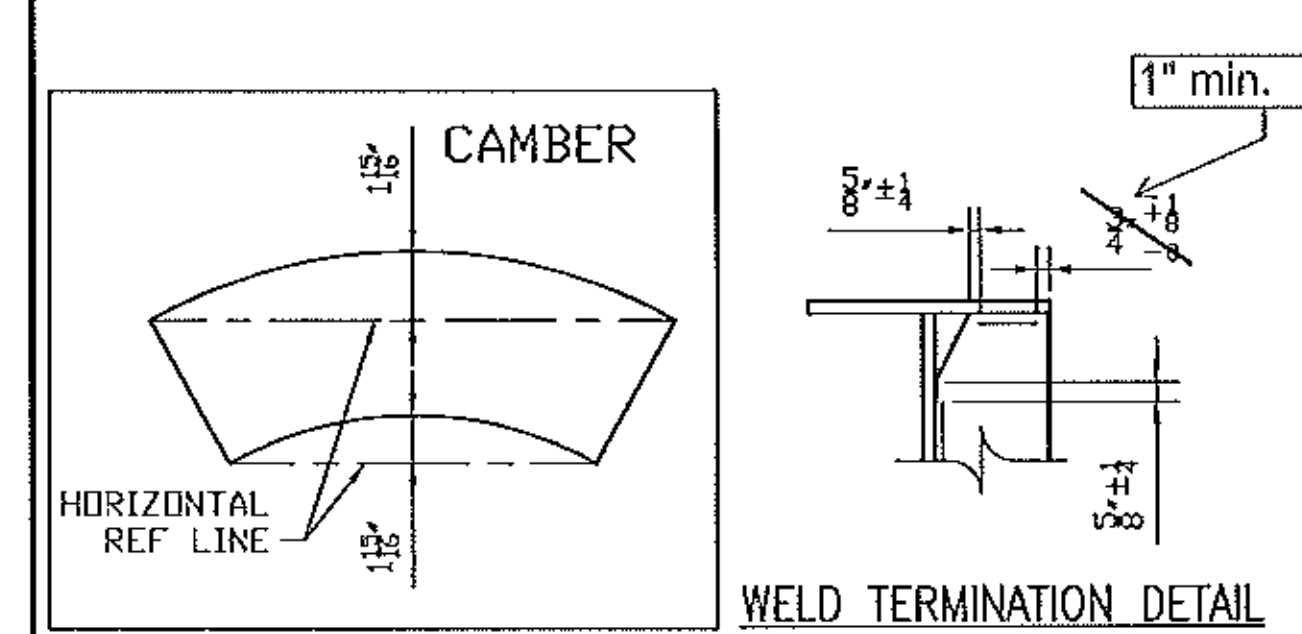


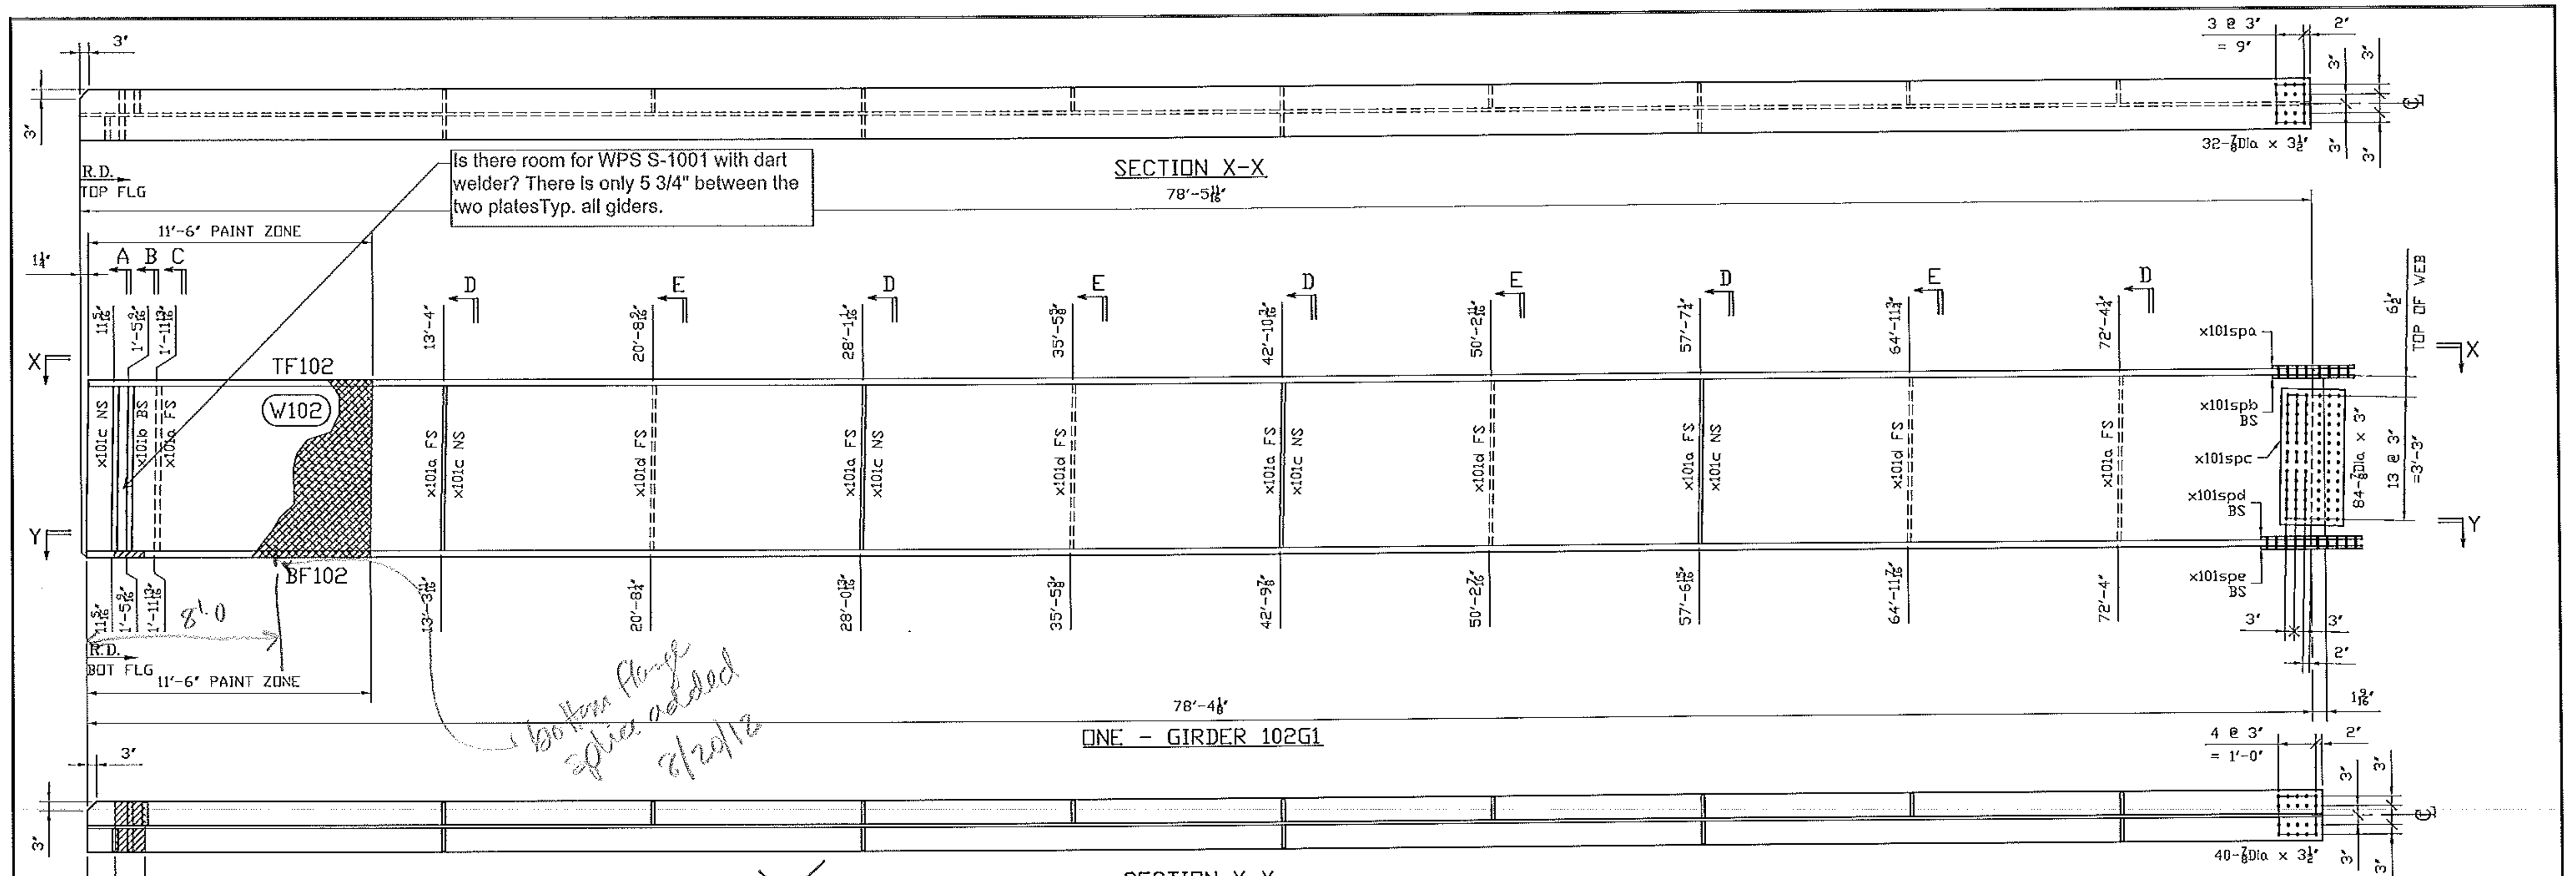

THE FIELD SPLICE PLATES MUST NOT EXCEED THE END OF GIRDER

NO PAINT NO PRIMER
Primer only
TYPICAL SECTION FOR MASKING ZONE AT SOLE PLATE

GENERAL NOTES: SEE GN100
HOLES: 15/16 (U.N.)
CLEANING AND PAINTING: SEE SHEET P100 AND P101

See standard specification 506.24(a)(9), no payment will be made for bolts, nuts, washers, they are considered to be incidental

BILL OF MATERIAL									
Mark	Qty.	Description	Stl	Length	Remark	ABM	Total Weight	Seq	Qty
102G1	ONE	GIRDER	Grd			16848	16973	1	
102G1	1	GIRDER		78-5 11/16					
TF102	1	PL1x16	A70950WT2	78-4 7/16		100-1	4267		
W102	1	PL1/2x52	A70950WT2	78-5 11/16		100-2	6943		
BF102	1	PL1x16	A70950WT2	78-4 1/8		100-1	4265		
x101a	6	PL1/2x7 1/2	A70950WT2	4-4		101-2	332		
x101b	2	PL7/8x7 1/2	A70950WT2	4-4	WB	101-1	194		
x101c	5	PL1/2x7 1/2	A70950WT2	4-4		101-2/3	276		
x101d	4	PL1/2x7 1/2	A70950WT2	4-4		101-3	221		
x101spa	1	PL1/2x16	A70950WT2	2-2 1/4		102-1	60		
x101spb	2	PL1/2x7	A70950WT2	2-2 1/4		102-2	52		
x101spc	2	PL1/2x43	A70950WT2	8 1/4		102-3	101		
x101spd	2	PL1/2x7	A70950WT2	2-8 1/4		102-4	64		
x101spe	1	PL1/2x16	A70950WT2	2-8 1/4		102-5	73		
FB		FIELD BOLTS							
78F3	84	.7/8 Dia A325 TYP3		3	1FL WASH		67		
78F312	72	.7/8 Dia A325 TYP3		3 1/2	1FL WASH		58		

Vermont Agency of Transportation
RECEIVED
CK'D BY M.E.M. OK'D BY C.W.M.
July 09, 2012
RESUBMIT APPROVED AS NOTED
BY C. CARLSON DATE 07-27-2012

FOR APPROVAL			
REVISION	DATE	PAR	VER.
1	07/06/12	BR	EG
NOTE: BOLT 1 WASHER: 1 WASHER UNDER NUT U.N. BOLT 2 WASHER: 1 WASHER UNDER HEAD U.N. 1 WASHER UNDER HEAD U.N.			
PROJECT: VT RT 9, BRIDGE NO. 11 TOWN OF WOODFORD, VT OVER WALDOOMSAC RIVER			
TITLE: GIRDER 102G1			
REFERENCE: PROJECT NO. ER BHF 010-1 (44)			
BR	JULY 2012	UN04260	
GG	JULY 2012	102-2	